



STATE OF NORTH CAROLINA
DEPARTMENT OF TRANSPORTATION

MICHAEL F. EASLEY
GOVERNOR

LYNDO TIPPETT
SECRETARY

August 11, 2005

NC Department of Environment and Natural Resources
Division of Water Quality-Stormwater Management
943 Washington Square Mall
Washington, NC 27889

Attention: Mr. Bill Moore


Subject: **Stormwater Permit Request for Improvements to US 17.** Improvements to US 17 from US 13-17 south of Windsor to the Chowan River. Bertie County. State Project No. 6019001T. USAID 200411606. TIP No. R-2404A; \$420.00 Debit WBS 34424.1.1.

The North Carolina Department of Transportation (NCDOT) proposes to improve US 17 in Bertie County, North Carolina. Bertie County falls under the jurisdiction of the Coastal Area Management Act (CAMA). The NCDOT is applying for a CAMA Major Development Permit, a Clean Water Act (CWA) §404 Department of the Army Permit, and a North Carolina CWA §401 Water Quality Certification.

A stormwater application form and one copy of the project permit drawings are provided with this request. Please review this project for authorization by your division.

Thank you for your assistance with this important matter. Any assistance you can provide in expediting the review of this project is greatly appreciated. If you have any questions concerning this project, please feel free to contact Mr. Chris Rivenbark at (919) 715-1460.

Sincerely,

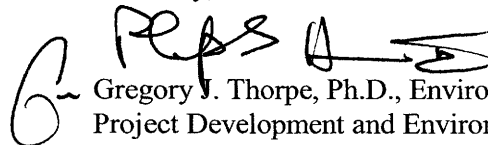

Gregory J. Thorpe, Ph.D., Environmental Management Director
Project Development and Environmental Analysis Branch

CC:

Mr. John Hennessy, DWQ Raleigh
Mr. Travis Wilson, NCWRC
Mr. Gary Jordan, USFWS
Mr. Jay Bennett, P.E., Roadway Design
Mr. Omar Sultan, Programming and TIP
Mr. Art McMillan, P.E., Highway Design
Dr. David Chang, P.E., Hydraulics
Mr. Greg Perfetti, P.E., Structure Design

Mr. Mark Staley, Roadside Environmental
Mr. John Sullivan, FHWA
Mr. Don Conner, P.E., Division Engineer
Mr. Clay Willis, DEO
Mr. David Franklin, USACE, Wilmington
Ms. Stacy Baldwin, P.E., Planning Engineer
Ms. Cathy Brittingham, DCM
Mr. Bill Arrington, DCM

OFFICE USE ONLY		
Date Received	Fee Paid	Permit Number

**State of North Carolina
Department of Environment and Natural Resources
Division of Water Quality**

STORMWATER MANAGEMENT PERMIT APPLICATION FORM

**NORTH CAROLINA DEPARTMENT OF TRANSPORTATION
LINEAR ROADWAY PROJECT**

This form may be photocopied for use as an original.

DWQ Stormwater Management Plan Review:

A complete stormwater management plan submittal includes this application form, a supplement form for each BMP proposed (see Section V), design calculations, and plans and specifications showing all road and BMP details.

I. PROJECT INFORMATION

NCDOT Project Number: C 201236 County: BERTIE

Project Name: R-2404 A WINDSOR BYPASS

Project Location: WINDSOR

Contact Person: JONATHAN HENDERSON Phone: (919) 785-1118 Fax: (919) 785-1187

Receiving Stream Name: CASHIE RIVER River Basin: ROANOKE Class: C

Proposed linear feet of project: 50,656 ft (9.59 mi)

Proposed Structural BMP and Road Station (*attach a list of station and BMP type if more room is needed*):

Type of proposed project: (*check all that apply*):

- New
 Widening
 2 lane*
 4 lane*
 Curb and Gutter
 Bridge Replacement
 Other (*Describe*) _____

**2 lane and 4 lane imply that roadside ditches are used unless Curb and Gutter is also checked.*

II. REQUIRED ITEMS CHECKLIST

Initial in the space provided below to indicate the following design requirements have been met and supporting documentation is attached. Supporting documentation shall, at a minimum, consist of a brief narrative description including (1) the scope of the project, (2) how the items below are met, (3) how the proposed best management practices minimize water quality impacts, and (4) any significant constraints and/or justification for not meeting a, b, c and d to the maximum extent practicable.

Designer's Initials

- JRH a. The amount of impervious surface has been minimized as much as possible.
JRH b. The runoff from the impervious areas has been diverted away from surface waters as much as possible.
JRH c. Best Management Practices are employed which minimize water quality impacts.
JRH d. Vegetated roadside ditches are 3:1 slope or flatter.

III. OPERATION AND MAINTENANCE AGREEMENT

I acknowledge and agree by my initials below that the North Carolina Department of Transportation is responsible for the implementation of the four maintenance items listed. I agree to notify DWQ of any operational problems with the BMP's that would impact water quality or prior to making any changes to the system or responsible party.

Maintenance Engineer's Initials

- SAP a. BMP's shall be inspected and maintained in good working order.
SAP b. Eroded areas shall be repaired and reseeded as needed.
SAP c. Stormwater collection systems, including piping, inlets, and outlets, shall be maintained to insure proper functioning.

Maintenance Engineer's Name: STERLING D. Baker
Title: DIVISION MAINTENANCE ENGINEER

IV. APPLICATION CERTIFICATION

I, (print or type name) Gregory J. Thorpe of PD & EA Branch, certify that the information included on this permit application form is, to the best of my knowledge, correct and that the project will be constructed in conformance with the approved plans and that the proposed project complies with the requirements of 15A NCAC 2H .1000.

Title: Environmental Management Director
Address: 1598 Mail Service Center, Raleigh NC 27699-1598
Signature: [Signature] Date: 8/11/05

V. SUPPLEMENT FORMS

The applicable state stormwater management permit supplement form(s) listed below must be submitted for each BMP specified for this project. Contact the Stormwater and General Permits Unit at (919) 733-5083 for the status and availability of these forms.

- Form SWU-102 Wet Detention Basin Supplement
- Form SWU-103 Infiltration Basin Supplement
- Form SWU-104 Low Density Supplement
- Form SWU-105 Curb Outlet System Supplement
- Form SWU-106 Off-Site System Supplement
- Form SWU-107 Underground Infiltration Trench Supplement
- Form SWU-108 Neuse River Basin Supplement
- Form SWU-109 Innovative Best Management Practice Supplement
- Form SWU-110 Extended Dry Detention Basin Supplement

Pre Formed Scour Holes (PSH)

41+25 -L-
172+85 -L- X 2
342+38 -L-
380+50 -L-
339+25 -L-
458+50 -L-
473+50 -L-
28+05 -Y4RPB-

45+00 -L-
196+00 -L-
371+00 -L-
428+00 -L-
444+00 -L-
464+50 -L-
28+10 -Y6-

154+64 -L- X 2
301+00 -L-
375+48 -L-
433+00 -L-
452+50 -L-
470+50 -L-
33+14 -Y6-

Dry Detention Basin

4+00 -Y4LPD-

STORMWATER MANAGEMENT PLAN

WINDSOR BYPASS

R-2404A

1.0 PURPOSE

The purpose of this Stormwater Management Plan (SMP) is to document the design process used to develop the stormwater management for the Windsor Bypass (R-2404A) for the North Carolina Department of Transportation (NCDOT). This SMP describes the stormwater management and control features included in the hydraulic design for the Project. This Plan and the associated design have been prepared in general accordance with NCDOT Standards and the North Carolina Department of Environment and Natural Resources (NCDENR) Stormwater Best Management Practices manual.

2.0 CONTACT INFORMATION

Contractor: The Contractor of the site and the person to contact for construction issues is:

Barnhill Contracting Company
Attn.: Allen Barnhill, P.E.
P.O. Box 1529
Tarboro, NC 27886
Telephone: (252) 823-1021
FAX: (252) 823-0137

Engineer: For questions regarding this Plan, please contact the following:

HDR Engineering, Inc. of the Carolinas
Attn.: Jonathan Henderson, P.E.
3733 National Drive, Suite 207
Raleigh, NC 27612
Telephone: (919) 785-1118
FAX: (919) 785-1187

3.0 PROJECT DESCRIPTION

The project consists of constructing the Windsor Bypass (R-2404A) from the US 13/17 intersection southwest of Windsor, North Carolina to the beginning of the 5-lane section of US 17 northeast of Windsor. Project work includes grading, paving, structures, ramps, loop, drainage components, and shoulder construction. The project includes 2.3 miles of existing road widening and 7.3 miles of new alignment, including a 1700 foot bridge over the Cashie River and its adjacent wetlands and interchanges with US 13 and Wakelon Road.

4.0 SITE BACKGROUND INFORMATION

The Windsor Bypass is located in the Inner Coastal Plain Physiographic Region within the Roanoke River Basin. The topography is relatively flat throughout most of the project area. From the beginning of the project through the Cashie River bridges the topography is generally shallow slopes and ridges grading down to streams and the flood plain of the Cashie River. From the Cashie River to the end of the project, the terrain becomes primarily flat pine plantations.

The major environmental feature on the project is the Cashie River and its adjacent flood plain and extensive bottomland wetland system. This large wetland spans almost the entire flood plain of the river. In addition to this crossing, a culvert will be extended along an unnamed tributary of the Cashie River near the beginning of the project. One other feature, a small perennial stream, will be piped through the US 13 interchange.

The Windsor Bypass will be constructed through residential and commercial areas, managed pine plantations and wetlands, and the environmentally sensitive areas described above. All streams within the Project area are classified as Class C by NCDENR. The Cashie River is listed on the 2004 draft 303(d) list due to mercury contamination in fish. Bertie County is also one of the twenty coastal counties under jurisdiction of CAMA. Therefore, a State Stormwater permit is required for this project.

The following commitments related to stormwater management have been made based on the Record of Decision for the Environmental Impact Statement for this project and the requirements of the scope of work:

- The Cashie River and the adjacent bottomland wetlands will be bridged entirely.
- Roadway grades will be set in order to avoid using roadway drainage ditches in designated wetlands.

These commitments are in addition to the standard commitments for Coastal Area Management Act and Clean Water Act Section 404 permits and 401 certification conditions.

5.0 BMP Evaluation Criteria

Best management practices (BMPs) were evaluated at all outfall locations in order to limit any impacts from the increase in stormwater from the project. NCDCM and NCDENR regulations for stormwater management were followed during design. During the evaluation, the following conditions were considered:

- The proximity of the location to surface waters and wetlands.
- The slope and consistency of the topography between the outfall and the environmentally sensitive area.
- The pre- and post-project stormwater flow at the outfall location.
- The proximity of the BMP to the roadway and any potential safety hazards involved.
- Access and maintenance issues critical to the continued operation and success of the BMP.
- Existence of natural, non-jurisdictional channels or structures for use in routing stormwater flows.

6.0 BMP EVALUATION

The following steps were followed to determine the applicability of using BMPs at each location:

- All ditches and medians were designed to comply with NCDENR grass swale design criteria if possible.
- Determine if there is a significant change in pre- and post-project stormwater flows.
- BMPs were evaluated in the following sequence:
 - Infiltration
 - Wet detention
 - Dry detention
 - Level spreader with vegetative buffer
- For low flow outlets and small pipes (15” or 18”), the use of a pre-formed scour hole was evaluated based on topography and flows.

Based on this evaluation, BMPs were chosen for each environmentally sensitive location, as well as across the entire Project as described in Section 7.

7.0 Pre- and Post-construction Stormwater Analysis

The pre- and post-construction runoff rates were analyzed for major outfall locations where the outlet channel receives the runoff in close proximity to the project. The US 13/17 interchange was analyzed because it met these criteria and the additional impervious surfaces created by the interchange warranted additional analysis. Initial analysis revealed a slight increase in post construction runoff. As a result of this increase, and in an effort to reduce environmental impacts, a dry detention basin was added inside loop A at the US 13/17 interchange. The addition of this dry detention basin, as well as maintaining

wetlands internal to the interchange, actually resulted in a decrease in the post construction runoff by approximately seven percent. The Wakelon Road interchange, which is located in an area dominated by wetlands, was not analyzed since there is no common receiving channel and stormwater will flow into these existing wetlands, which provide natural storage and infiltration.

The existing character of the basins throughout the project are primarily wetlands. These wetland areas have been maintained to the maximum extent practical, such as retaining them internal to the interchanges. This provides both pre- and post-construction storage for runoff. The project area consists of large drainage basins and the addition of two or four lanes of impervious pavement does not significantly impact post-construction discharges or velocities.

8.0 DESIGN DETAILS

The following sections describe the BMPs used at each environmentally sensitive area along the Project. The entire stormwater drainage system was designed to outlet frequently at relatively low velocities in order to avoid indirect impacts on the aquatic environment. BMPs were evaluated at each outfall location based on the criteria described in Section 6.0.

8.1 General BMP Design

Throughout the Project, median and roadside ditches have been designed to meet the grass-swale design criteria described in the NCDENR Stormwater Manual. Only two ditches do not meet these criteria due to site constraints such as topography or right-of-way not allowing for the minimum 3:1 side-slopes. Off-site stormwater is passed through the Project without treatment.

On-site stormwater was treated by grass swale, dry detention, and pre-formed scour holes. In general, preformed scour holes were used in areas of flat topography and adjacent to wetlands where the flows were

relatively low. The following sections address specific areas where BMP design differed from the general approach.

8.2 Site 1 - Culvert Extension @ Sta 44+55 -L-

This is the location of the culvert extension on the unnamed tributary of the Cashie River. In addition, two ponds adjacent and within the roadway widening will be drained for the construction of the project. These ponds will not be filled, and therefore will provide some detention of off-site stormwater prior to it entering this UT. No on-site stormwater will be routed through this area. Rather, it will outlet into a preformed scour hole on the downstream side of the road in order to obtain sheet flow prior to entering the adjacent wetland.

8.3 Site 4 - Interchange with US 13

This location has the greatest amount of impervious surface on the project due to the ramps and loops associated with the routing of traffic from US 13 and US 17. A slight increase in post-construction runoff compared to pre-construction was calculated for this site. Therefore, the area within Loop D was evaluated for BMP implementation. Due to the relatively low water table compared to the rest of the site, along with the clay loam soils in the area, it was determined that the area could be used as a dry detention basin. The stormwater from most of the interchange and the entire bridge is routed to the detention basin and then discharged to the stream channel at low velocity. Maintenance access is provided from King Street (-Y4-) located adjacent to the basin. Infiltration and wet detention were evaluated for this site, however the soil conditions and adjacent roadway would not allow for these BMPs. Wet detention internal to the interchange increases hazards to the traveling public.

8.4 Site 6 - Cashie River Bridges

The dual structures over the Cashie River and adjacent wetlands are 1700 feet long. Deck drains are required for this length of bridge in order to


prevent water from spreading into the lanes during the design storm event. The deck drains have been designed to discharge into the forested wetlands at least 100 feet from the 30-foot CAMA buffer on the Cashie River. This will allow adequate treatment of the deck drain discharge prior to entering a surface water feature. Four inch diameter deck drains have been spaced at 6-foot intervals which to reduce discharge during a storm event. The remainder of the bridge stormwater will be collected on the southwest end and discharged into preformed scour holes located on either side of the approach to the bridge. The scour holes will discharge into a vegetated filter strip equidistant from the adjacent waters.

8.5 Managed Pine Farm Wetlands

Throughout the extensive managed pine wetlands, on-site stormwater has been routed through wetland equalizer pipes that are designed to retain the hydrology of the existing wetlands. These pipes will be 36 inches in diameter and embedded 1 foot into the existing ground. Stormwater entering these pipes will flow in both directions and outlet on both sides of the road at extremely low velocities. The onsite stormwater will have already been treated through grass swales in the roadway median.

9.0 CONCLUSION

The proposed stormwater management system is designed to be an integrated approach of appropriate BMPs that effectively control and treat on-site stormwater for this facility. This plan is consistent with both Federal and State regulations and NCDOT guidance. More details regarding the individual stormwater structures and BMPs are provided in the attached computations, including dry detention basins design.

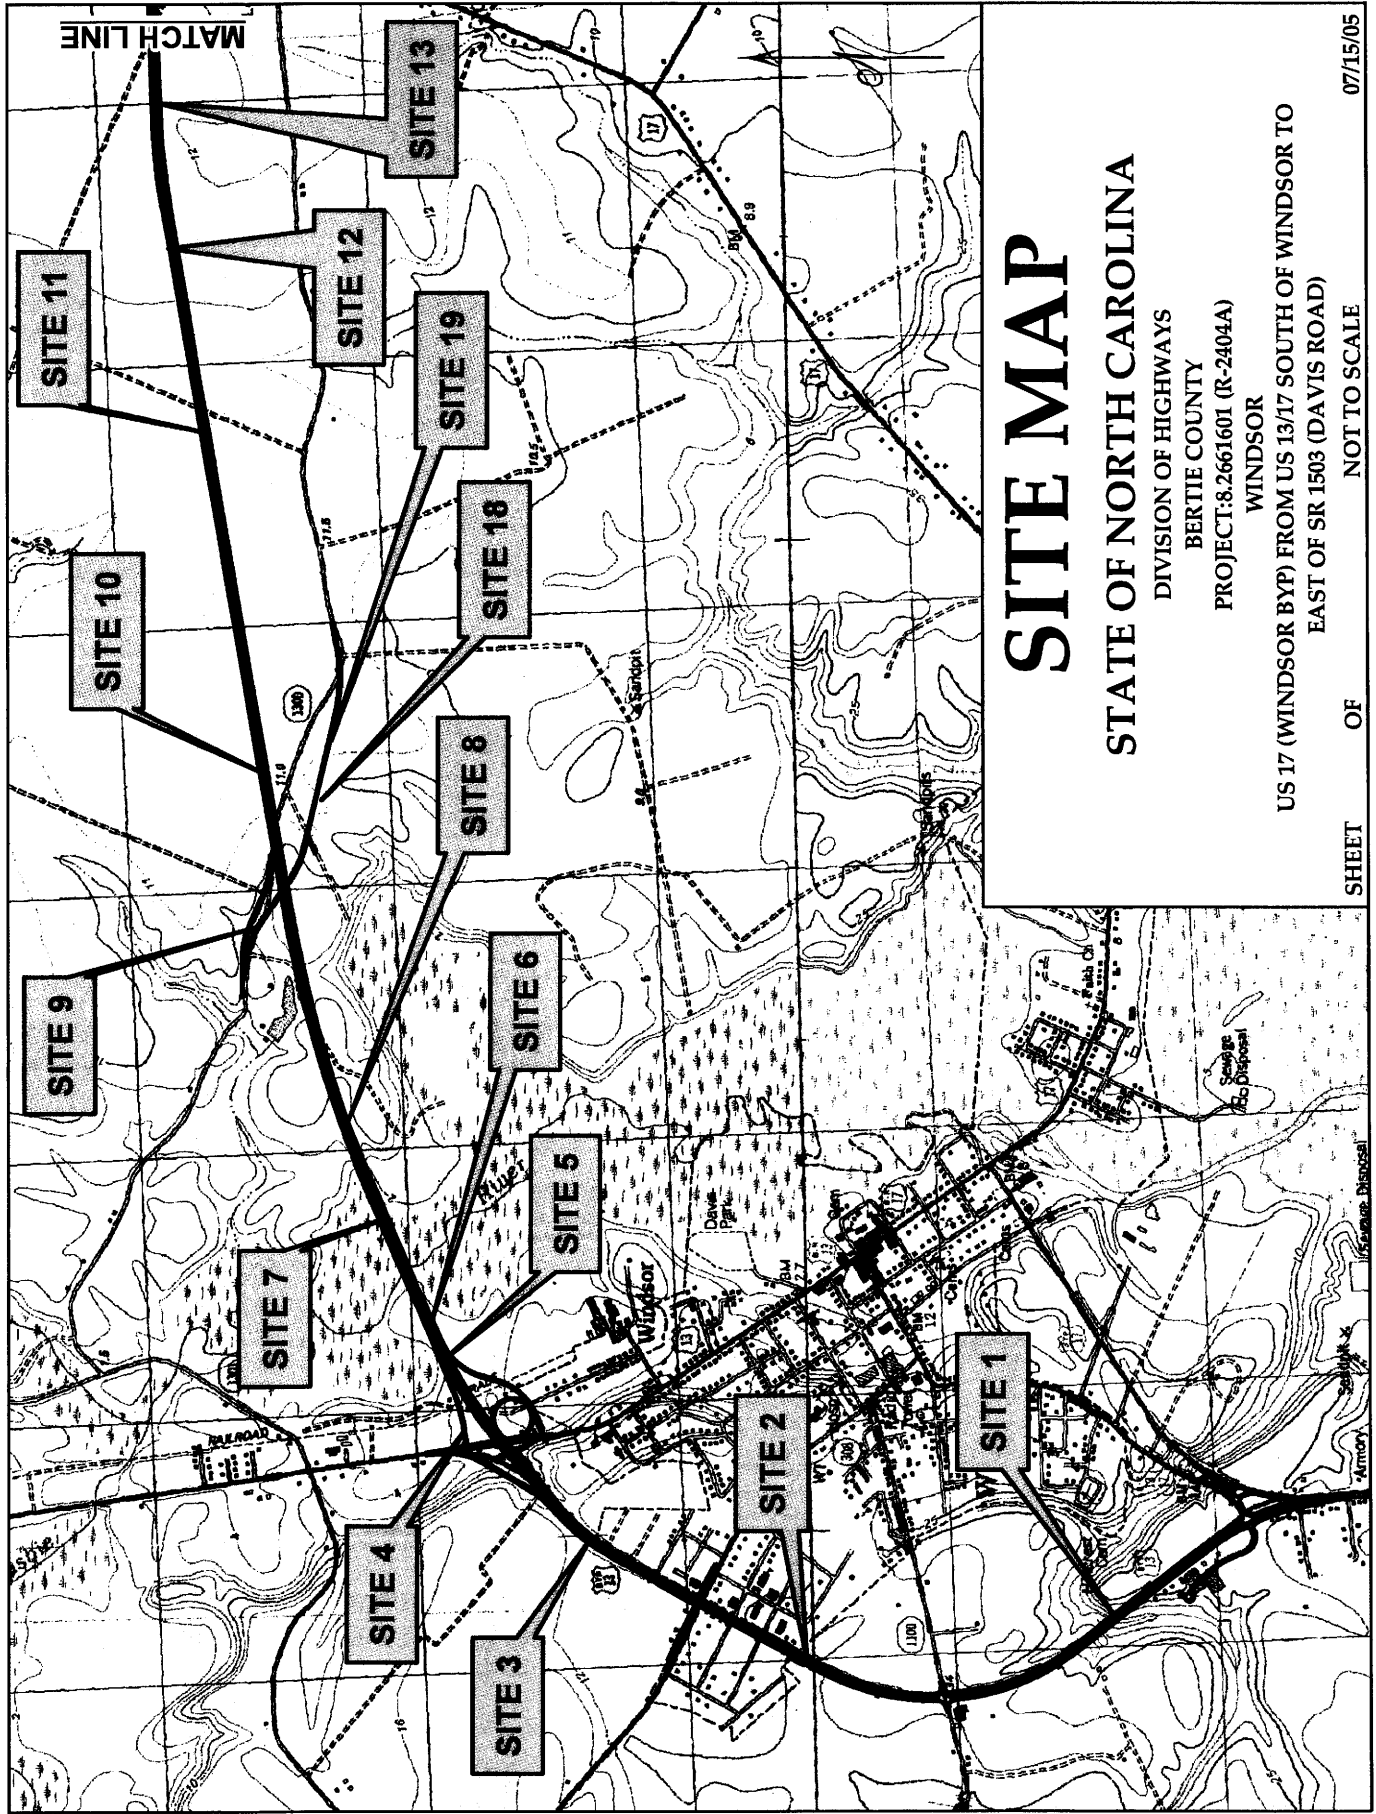

SITE MAP

STATE OF NORTH CAROLINA

DIVISION OF HIGHWAYS

BERTIE COUNTY

PROJECT: 8.2661601 (R-2404A)

WINDSOR


US 17 (WINDSOR BYP) FROM US 13/17 SOUTH OF WINDSOR TO
EAST OF SR 1503 (DAVIS ROAD)

07/15/05

NOT TO SCALE

OF

SHEET

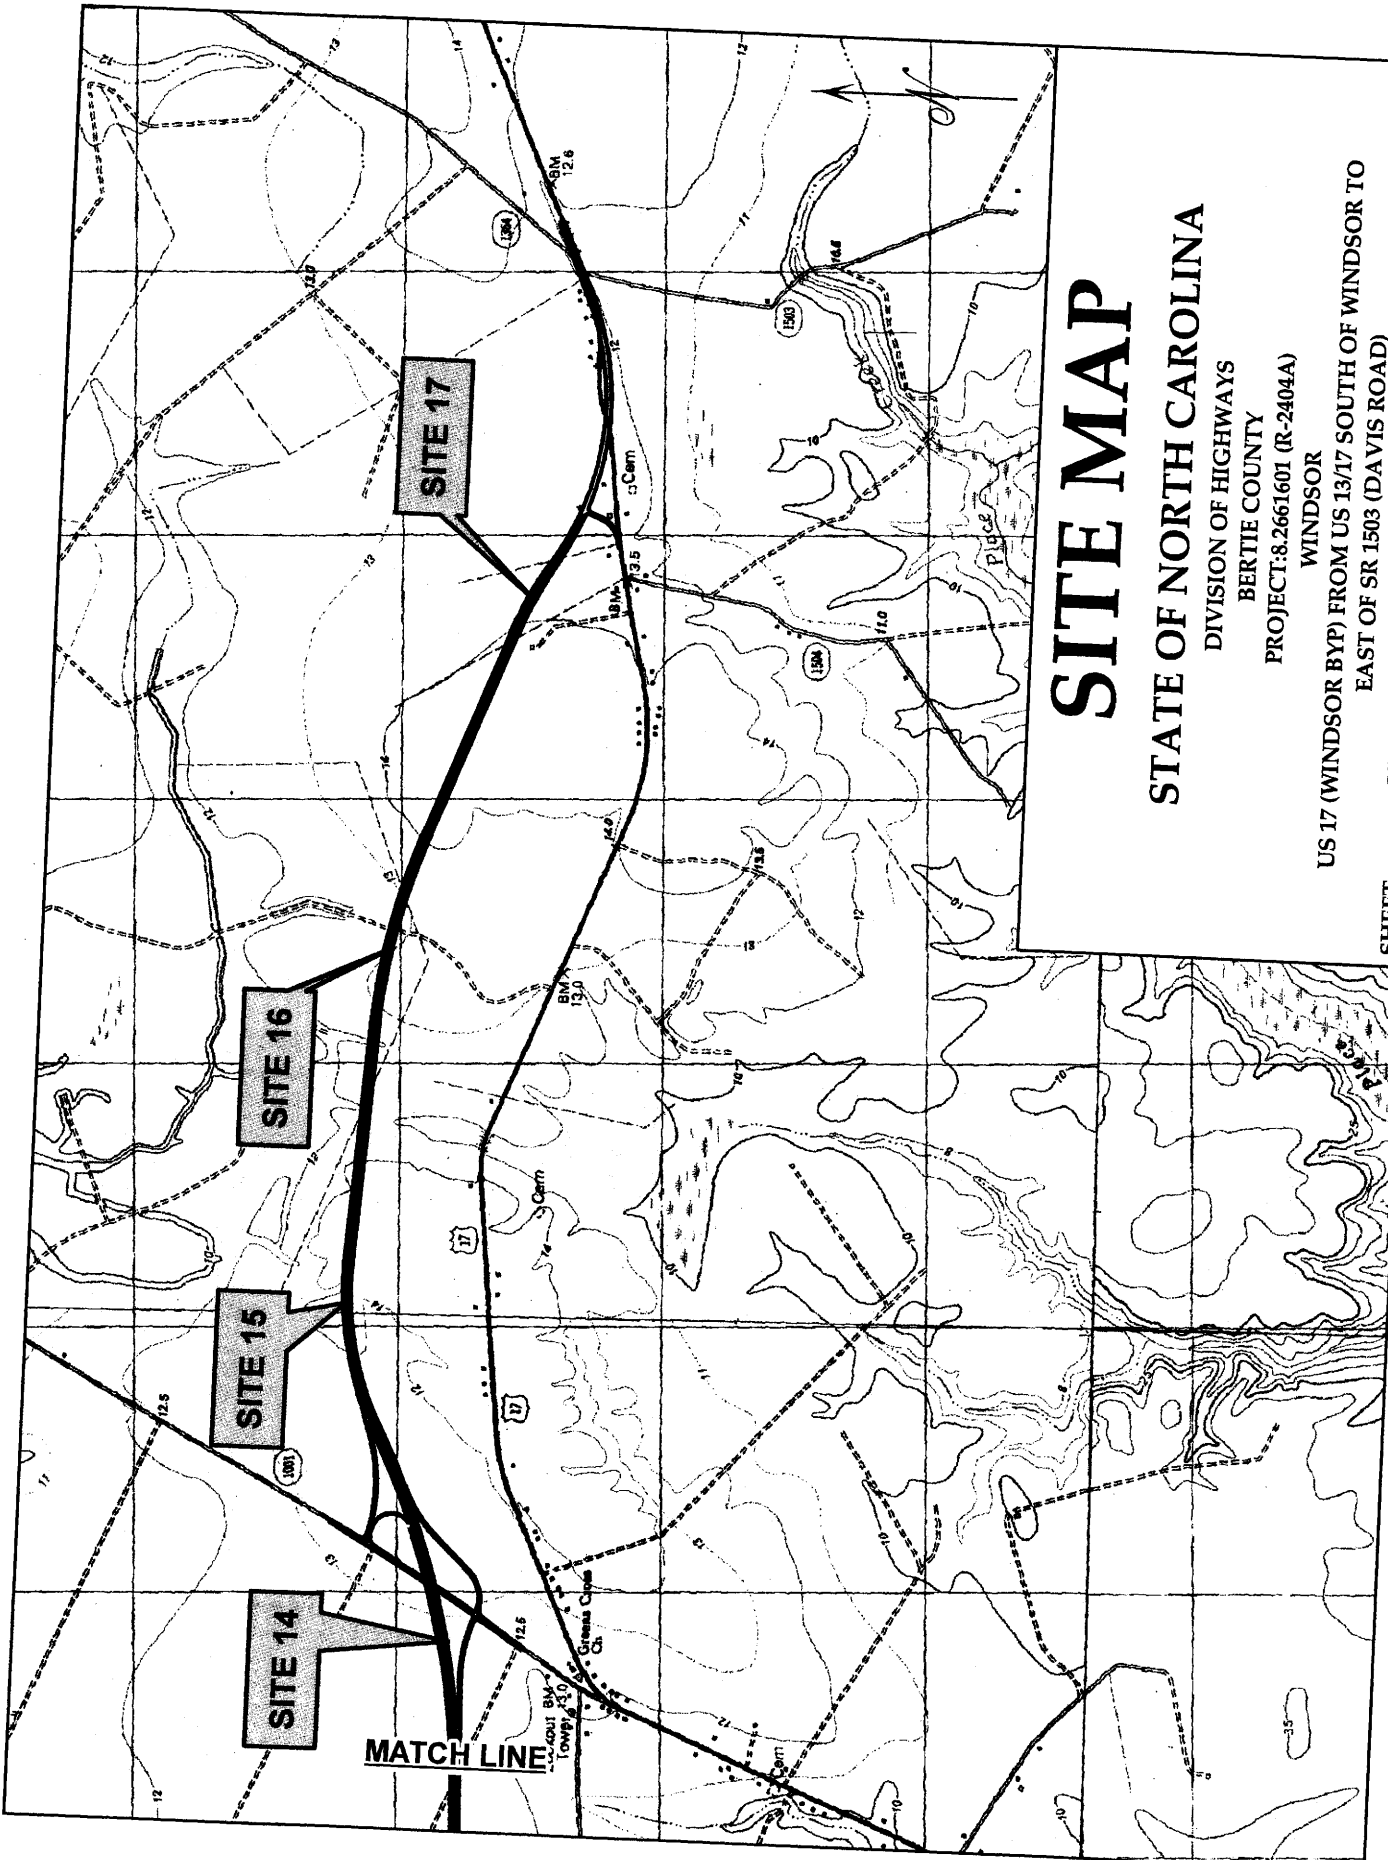

SITE MAP

STATE OF NORTH CAROLINA

DIVISION OF HIGHWAYS

BERTIE COUNTY

PROJECT: 8.2661601 (R-2404A)

WINDSOR



US 17 (WINDSOR BYP) FROM US 13/17 SOUTH OF WINDSOR TO
EAST OF SR 1503 (DAVIS ROAD)












SHEET OF

NOT TO SCALE

07/15/05

REVISIONS

PROJECT REFERENCE NO. R-2404A	SHEET NO. DETAILS
RW SHEET NO.	
ROADWAY DESIGN ENGINEER	HYDRAULICS ENGINEER
PRELIMINARY PLANS DO NOT USE FOR CONSTRUCTION	
 HDR HDR Engineering, Inc. of the Carolinas 3723 National Drive, Suite 207 Raleigh, N.C. 27612	
 BARNHILL CONTRACTING COMPANY	

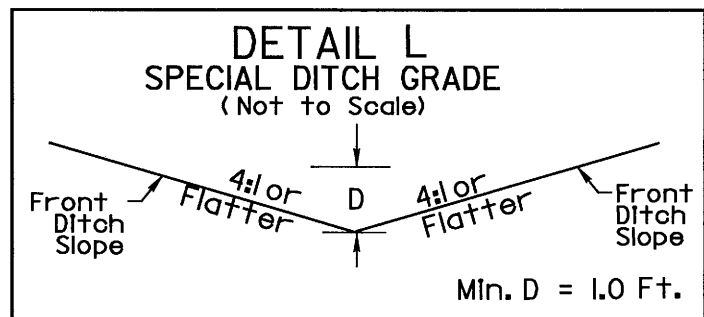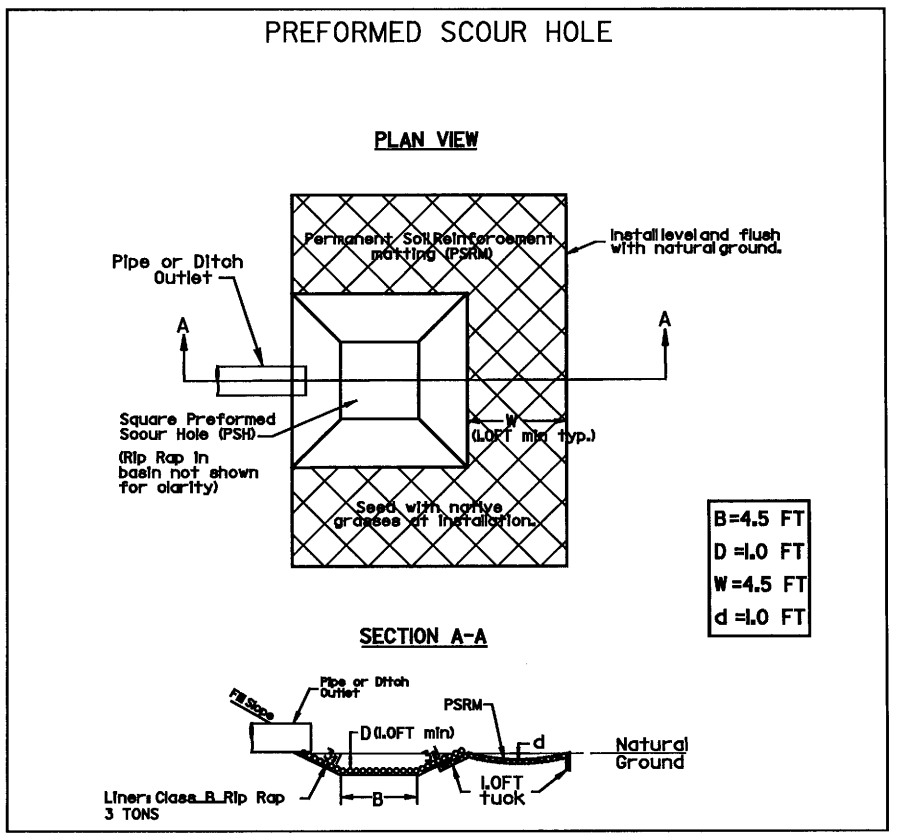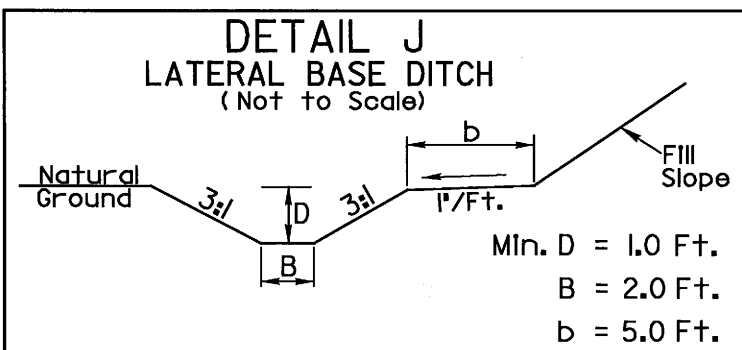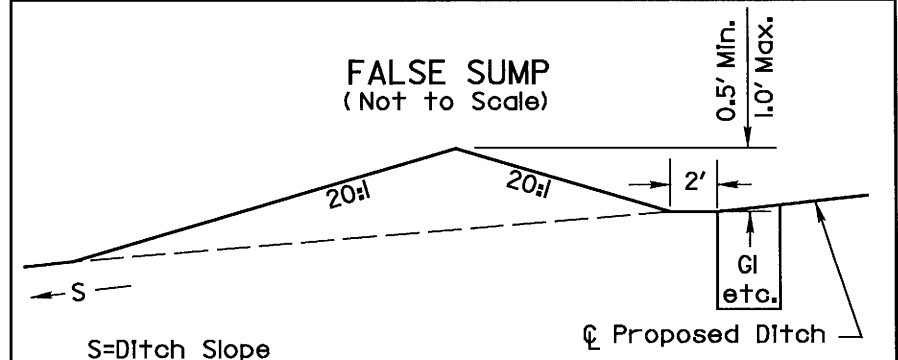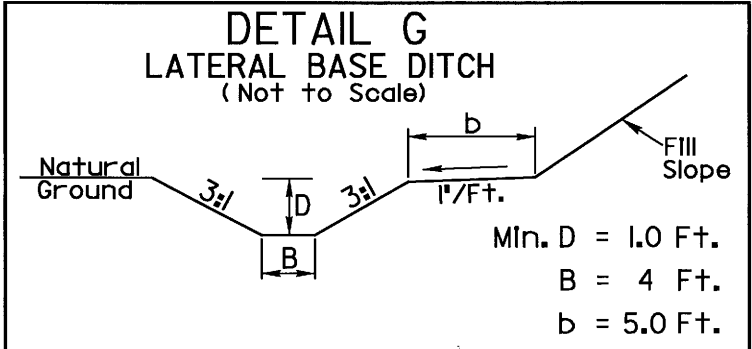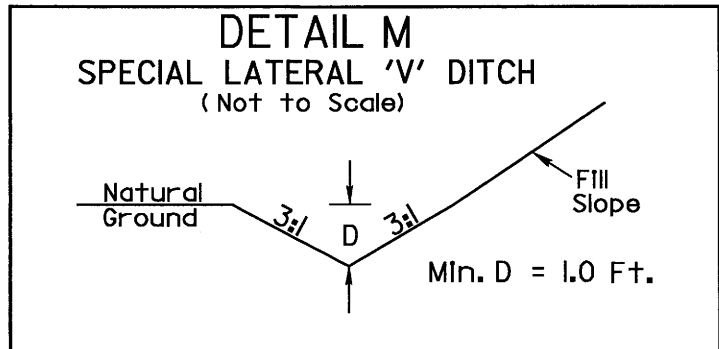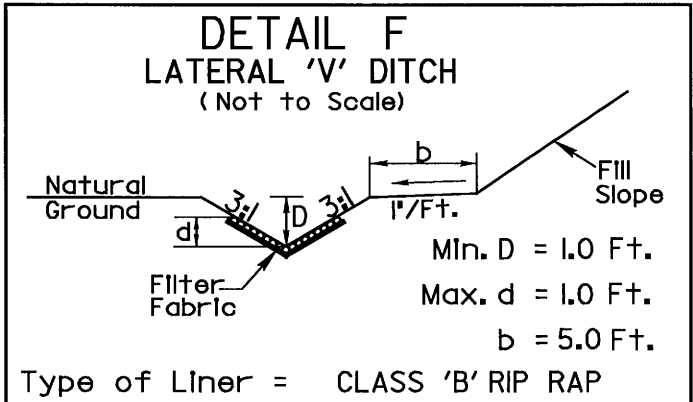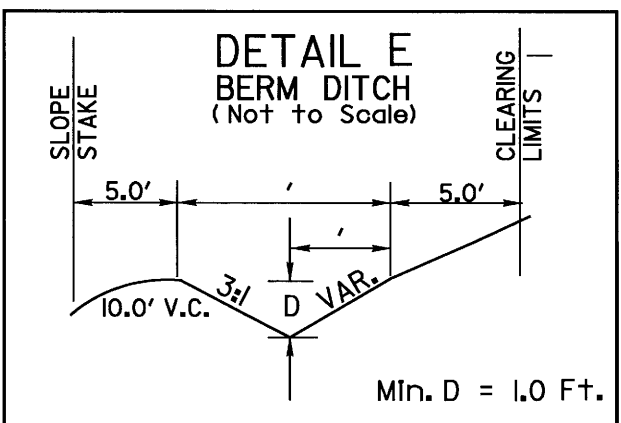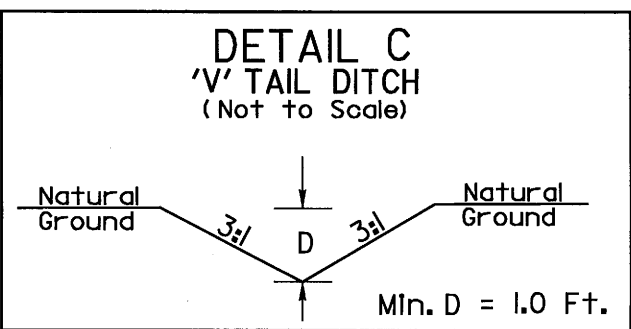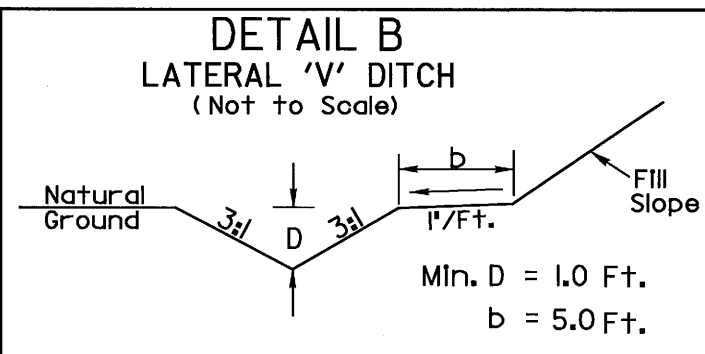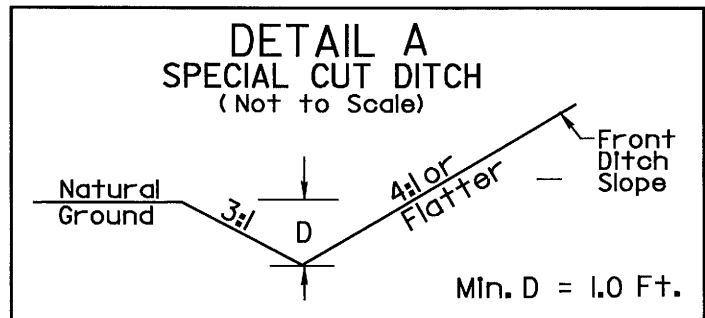

8/1/2005 11:02:19 AM R:\N-2404a\hydro\N2404A_hy\Drainagedetails_psh.dgn

DRAINAGE AREA

7+00 -LPD- OUTLET = 0.39 AC
 11+85 -LPD- OUTLET = 1.57 AC
 31+50 -Y4- OUTLET = 7.19 AC
 133+30 -L- OUTLET = 0.17 AC
 LOOP = 4.16 AC

TOTAL PA = 13.48 AC

IMPERVIOUS AREA

LOOP D PAVEMENT = 0.85 AC
 Y4 PAVEMENT = 0.27 AC
 L- PAVEMENT = 0.41 AC

TOTAL IMPERVIOUS AREA = 1.53 AC

% IMPERVIOUS

$$1.53 \text{ AC} / 13.48 \text{ AC} = 0.1135 = 11.4\%$$

RUNOFF VOLUME ("SIMPLE METHOD" - SCHVEGLER (1987))

$$R_v = 0.05 + 0.009(I)$$

$$= 0.05 + 0.009(11.4)$$

$$= 0.152$$

$R_v = \text{RUNOFF COEFFICIENT}$ $\frac{\text{STORM RUNOFF}}{\text{STORM RAINFALL}}$
 $I = \text{PERCENT IMPERVIOUS}$

VOLUME TO BE CONTAINED

$$\text{VOLUME} = (\text{DESIGN RAINFALL})(R_v)(\text{DA})$$

$$= (1 \text{ IN}) \left(\frac{1}{12} \frac{\text{ft}}{\text{IN}} \right) (0.152)(13.48 \text{ AC})$$

$$= 0.171 \text{ AC-ft} = 7,437 \text{ ft}^3$$

$$= (7437)(1.20) \quad (\text{SEDIMENT STORAGE})$$

$$= 8924 \text{ ft}^3$$

STORAGE VOLUME REQUIRED = 9,000 ft ³

CALCULATION OF Q_P (RATIONAL)

$$Q_p = CIA$$

RATIONAL C VALUE

$$1.53 \text{ AC} \times 0.9 = 1.38$$

$$11.95 \text{ AC} \times 0.35 = 4.18$$

$$\frac{1.38 + 4.18}{13.48} = 0.41 \Rightarrow C = 0.41$$

INTENSITY (I)

$$10\text{-YR INTENSITY FOR WILMINGTON} = 5.9 \text{ IN/HR}$$

$$Q_p = (0.41)(5.9)(13.48)$$

$$Q_p = 32.6 \text{ CFS}$$

CALCULATION OF T_P

$$P = 4.16 \text{ IN (10-YR, 6-HR PRECIPITATION)}$$

$$CN = 70$$

$$S = \frac{1000}{CN} - 10 \text{ (STORAGE)}$$

$$= \frac{1000}{70} - 10$$

$$= 4.23$$

$$Q^* = \left(\frac{P - 0.2(S)}{P + 0.8(S)} \right)^2 \text{ (DEPTH OF RUNOFF)}$$

$$P + 0.8(S)$$

$$= \left(\frac{4.16 - 0.2(4.23)}{4.16 + 0.8(4.23)} \right)^2$$

$$4.16 + 0.8(4.23)$$

$$Q^* = 1.44 \text{ IN}$$

$$T_p = \text{VOL} / 1.39 Q_p$$

$$= \frac{(1.44 \text{ IN})(13.48 \text{ AC})}{(1.39)(32.6 \text{ CFS})} \cdot \frac{1 \text{ FT}}{12 \text{ IN}} \cdot \frac{43560 \text{ FT}^2}{1 \text{ AC}} \cdot \frac{1 \text{ MIN}}{60 \text{ SEC}}$$

$$T_p = 26 \text{ MIN}$$

R-2404A - Proposed Dry Detention Basin -Y4LPD-

April 2005 JRR

Reservoir Routing Hydrograph
Inflow Hydrograph:

Qp(cfs)=	32.6
Tp(min)=	26
dT(min)=	2
Stage- Storage	
Ks=	15371
b=	1.74

Required Storage: (Includes 20% sediment storage)
9000 cubic feet at 0.62 above invert of pond

Outflow Devices:

Culvert:

NN=	1
D(in)=	3
Cd=	0.6
Inv(ft)=	0

Weir1:

L(ft)=	2
Zcr(ft)=	2.50
Cw=	3

Weir3:

L(ft)=	300
Zcr(ft)=	4
Cw=	3

Initial Stage

(ft)	0
------	---

Results of Storm on Reservoir

Norm surf. Area(ac.)=	0.00
Max surf. Area(ac.)=	0.47
Peak Stage(ft)=	3.22
Rise(ft)=	3.22
Peak Outflow(cfs)=	7.25
Treatment Storage (cf)=	43536
Max storage (cf)=	58093

Drawdown Time:

Stage after 2 days	0.38
Stage after 5 days	0.01

Weir2:

L(ft)=	10
Zcr(ft)=	5.00
Cw=	3

Barrel:

N=	1
Db(in)=	18
Cd=	0.6

Head above barrel	1
Driving Q (cfs)	13

RESERVOIR #1

TIME (min)	INFLOW (cfs)	STORAGE (cu ft)	STAGE (ft)	OUTFLOW (cfs)
0	0	0.0	0.00	0.0
2	0	0.0	0.00	0.0
4	2	56.8	0.01	0.0
6	4	280.6	0.03	0.0
8	7	772.0	0.07	0.0
10	11	1615.7	0.14	0.0
12	14	2875.4	0.23	0.0
14	18	4590.1	0.35	0.1
16	22	6771.4	0.49	0.1
18	26	9405.9	0.65	0.1
20	28	12454.3	0.83	0.2
22	31	15852.3	1.03	0.2
24	32	19515.2	1.23	0.2
26	33	23342.8	1.44	0.2
28	32	27224.9	1.65	0.3
30	31	31048.4	1.86	0.3
32	29	34703.0	2.05	0.3
34	26	38088.3	2.22	0.3
36	23	41150.7	2.38	0.3
38	21	43916.1	2.52	0.4
40	19	46413.0	2.64	0.4
42	17	48665.0	2.76	0.7
44	16	50659.4	2.86	1.2
46	14	52400.7	2.94	1.7
48	13	53902.7	3.02	2.2
50	12	55183.1	3.08	2.7
52	11	56252.9	3.13	3.7
54	10	57065.7	3.17	4.9
56	9	57621.7	3.20	5.9
58	8	57950.2	3.22	6.6
60	7	58092.7	3.22	7.0
62	6	58092.1	3.22	7.2
64	6	57987.0	3.22	7.2
66	5	57809.3	3.21	7.1
68	5	57583.4	3.20	6.9
70	4	57327.6	3.19	6.5
72	4	57054.8	3.17	6.2
74	3	56774.0	3.16	5.9
76	3	56491.6	3.14	5.5
78	3	56211.5	3.13	5.2
80	3	55936.5	3.12	4.8
82	2	55668.2	3.10	4.5
84	2	55407.5	3.09	4.2
86	2	55154.9	3.08	4.0
88	2	54910.4	3.07	3.7
90	2	54673.9	3.06	3.5
92	1	54444.9	3.04	3.3

OUTFLOWS:

CULVERT1 (cfs)	WEIR1 (cfs)	WEIR2 (cfs)	WEIR3 (cfs)	TOTAL WEIR (cfs)	BARREL (cfs)	Rbspwy (cfs)
0.00	0.0	0.0	0.0	0.0	0.0	0.0
0.00	0.0	0.0	0.0	0.0	0.0	0.0
0.00	0.0	0.0	0.0	0.0	0.0	0.0
0.00	0.0	0.0	0.0	0.0	0.0	0.0
0.01	0.0	0.0	0.0	0.0	0.0	0.0
0.03	0.0	0.0	0.0	0.0	0.0	0.0
0.07	0.0	0.0	0.0	0.1	0.1	0.1
0.11	0.0	0.0	0.0	0.1	0.1	0.1
0.14	0.0	0.0	0.0	0.1	0.1	0.1
0.17	0.0	0.0	0.0	0.2	0.2	0.2
0.20	0.0	0.0	0.0	0.2	0.2	0.2
0.22	0.0	0.0	0.0	0.2	0.2	0.2
0.25	0.0	0.0	0.0	0.2	0.2	0.2
0.27	0.0	0.0	0.0	0.3	0.3	0.3
0.29	0.0	0.0	0.0	0.3	0.3	0.3
0.31	0.0	0.0	0.0	0.3	0.3	0.3
0.33	0.0	0.0	0.0	0.3	0.3	0.3
0.34	0.0	0.0	0.0	0.3	0.3	0.3
0.35	0.0	0.0	0.0	0.4	0.4	0.4
0.37	0.0	0.0	0.0	0.4	0.4	0.4
0.37	0.3	0.0	0.0	0.7	0.7	0.7
0.38	0.8	0.0	0.0	1.2	1.2	1.2
0.39	1.3	0.0	0.0	1.7	1.7	1.7
0.40	1.8	0.0	0.0	2.2	2.2	2.2
0.40	2.2	0.1	0.0	2.7	2.7	2.7
0.41	2.7	0.7	0.0	3.7	3.7	3.7
0.41	3.0	1.4	0.0	4.9	4.9	4.9
0.41	3.3	2.1	0.0	5.9	5.9	5.9
0.41	3.5	2.7	0.0	6.6	6.6	6.6
0.41	3.6	3.0	0.0	7.0	7.0	7.0
0.42	3.7	3.1	0.0	7.2	7.2	7.2
0.42	3.7	3.1	0.0	7.2	7.2	7.2
0.41	3.6	3.0	0.0	7.1	7.1	7.1
0.41	3.6	2.9	0.0	6.9	6.9	6.9
0.41	3.5	2.6	0.0	6.5	6.5	6.5
0.41	3.4	2.4	0.0	6.2	6.2	6.2
0.41	3.3	2.1	0.0	5.9	5.9	5.9
0.41	3.2	1.9	0.0	5.5	5.5	5.5
0.41	3.1	1.6	0.0	5.2	5.2	5.2
0.41	3.0	1.4	0.0	4.8	4.8	4.8
0.41	2.9	1.2	0.0	4.5	4.5	4.5
0.41	2.8	1.0	0.0	4.2	4.2	4.2
0.41	2.7	0.8	0.0	4.0	4.0	4.0
0.41	2.6	0.7	0.0	3.7	3.7	3.7
0.40	2.6	0.5	0.0	3.5	3.5	3.5
0.40	2.5	0.4	0.0	3.3	3.3	3.3
0.40	2.4	0.3	0.0	3.1	3.1	3.1

94	1	54222.9	3.03	3.1
96	1	54007.3	3.02	2.9
98	1	53797.3	3.01	2.8
100	1	53592.0	3.00	2.6
102	1	53389.9	2.99	2.5
104	1	53189.3	2.98	2.5
106	1	52986.7	2.97	2.4
108	1	52782.7	2.96	2.3
110	1	52578.2	2.95	2.3
112	1	52373.9	2.94	2.2
114	0	52170.5	2.93	2.2
116	0	51968.5	2.92	2.1
118	0	51768.4	2.91	2.0
120	0	51570.4	2.90	2.0
122	0	51375.1	2.89	1.9
124	0	51182.6	2.88	1.9
126	0	50993.1	2.87	1.8
128	0	50806.8	2.86	1.8
130	0	50623.9	2.85	1.7
132	0	50444.4	2.85	1.7
134	0	50268.5	2.84	1.6
136	0	50096.1	2.83	1.6
138	0	49927.4	2.82	1.5
140	0	49762.2	2.81	1.5
142	0	49600.7	2.80	1.4
144	0	49442.7	2.80	1.4
146	0	49288.3	2.79	1.4
148	0	49137.4	2.78	1.3
150	0	48990.0	2.77	1.3
152	0	48846.0	2.77	1.2
154	0	48705.3	2.76	1.2
156	0	48567.9	2.75	1.2
158	0	48433.7	2.75	1.1
160	0	48302.7	2.74	1.1
162	0	48174.7	2.73	1.1
164	0	48049.8	2.73	1.1
166	0	47927.7	2.72	1.0
168	0	47808.5	2.71	1.0
170	0	47692.1	2.71	1.0
172	0	47578.3	2.70	1.0
174	0	47467.2	2.70	0.9
176	0	47358.6	2.69	0.9
178	0	47252.4	2.69	0.9
180	0	47148.7	2.68	0.9
182	0	47047.3	2.68	0.8
184	0	46948.1	2.67	0.8
186	0	46851.2	2.67	0.8
188	0	46756.3	2.66	0.8
190	0	46663.5	2.66	0.8
192	0	46572.7	2.65	0.8
194	0	46483.8	2.65	0.7
196	0	46396.8	2.64	0.7
198	0	46311.6	2.64	0.7
200	0	46228.1	2.64	0.7
202	0	46146.4	2.63	0.7
204	0	46066.3	2.63	0.7
206	0	45987.7	2.62	0.6
208	0	45910.8	2.62	0.6
210	0	45835.3	2.62	0.6
212	0	45761.2	2.61	0.6
214	0	45688.5	2.61	0.6
216	0	45617.2	2.60	0.6
218	0	45547.2	2.60	0.6
220	0	45478.5	2.60	0.6
222	0	45411.0	2.59	0.6
224	0	45344.6	2.59	0.5
226	0	45279.4	2.59	0.5
228	0	45215.3	2.58	0.5
230	0	45152.3	2.58	0.5
232	0	45090.3	2.58	0.5
234	0	45029.3	2.58	0.5
236	0	44969.3	2.57	0.5
238	0	44910.2	2.57	0.5
240	0	44852.0	2.57	0.5
242	0	44794.7	2.56	0.5
244	0	44738.3	2.56	0.5
246	0	44682.6	2.56	0.5
248	0	44627.7	2.56	0.5
250	0	44573.6	2.55	0.4

0.40	2.3	0.2	0.0	2.9	2.9	2.9
0.40	2.3	0.1	0.0	2.8	2.8	2.8
0.40	2.2	0.0	0.0	2.6	2.6	2.6
0.40	2.1	0.0	0.0	2.5	2.5	2.5
0.40	2.1	0.0	0.0	2.5	2.5	2.5
0.40	2.0	0.0	0.0	2.4	2.4	2.4
0.40	1.9	0.0	0.0	2.3	2.3	2.3
0.40	1.9	0.0	0.0	2.3	2.3	2.3
0.40	1.8	0.0	0.0	2.2	2.2	2.2
0.40	1.8	0.0	0.0	2.2	2.2	2.2
0.40	1.7	0.0	0.0	2.1	2.1	2.1
0.39	1.6	0.0	0.0	2.0	2.0	2.0
0.39	1.6	0.0	0.0	2.0	2.0	2.0
0.39	1.5	0.0	0.0	1.9	1.9	1.9
0.39	1.5	0.0	0.0	1.9	1.9	1.9
0.39	1.4	0.0	0.0	1.8	1.8	1.8
0.39	1.4	0.0	0.0	1.8	1.8	1.8
0.39	1.3	0.0	0.0	1.7	1.7	1.7
0.39	1.3	0.0	0.0	1.7	1.7	1.7
0.39	1.2	0.0	0.0	1.6	1.6	1.6
0.39	1.2	0.0	0.0	1.6	1.6	1.6
0.39	1.1	0.0	0.0	1.5	1.5	1.5
0.39	1.1	0.0	0.0	1.5	1.5	1.5
0.39	1.0	0.0	0.0	1.4	1.4	1.4
0.39	1.0	0.0	0.0	1.4	1.4	1.4
0.39	1.0	0.0	0.0	1.4	1.4	1.4
0.39	0.9	0.0	0.0	1.3	1.3	1.3
0.38	0.9	0.0	0.0	1.3	1.3	1.3
0.38	0.9	0.0	0.0	1.2	1.2	1.2
0.38	0.8	0.0	0.0	1.2	1.2	1.2
0.38	0.8	0.0	0.0	1.2	1.2	1.2
0.38	0.8	0.0	0.0	1.1	1.1	1.1
0.38	0.7	0.0	0.0	1.1	1.1	1.1
0.37	0.1	0.0	0.0	0.4	0.4	0.4

DRAINAGE AREA

7+00 -LPD- OUTLET = 0.39 AC
 11+85 -LPD- OUTLET = 1.57 AC
 31+50 -Y4- OUTLET = 7.19 AC
 135+30 -L- OUTLET = 0.17 AC
 LOOP = 4.16 AC

TOTAL DA = 13.48 AC

IMPERVIOUS AREA

LOOP D PAVEMENT = 0.85 AC
 Y4 PAVEMENT = 0.27 AC
 L- PAVEMENT = 0.41 AC

TOTAL IMPERVIOUS AREA = 1.53 AC

% IMPERVIOUS

$$1.53 \text{ AC} / 13.48 \text{ AC} = 0.1135 = 11.4\%$$

RUNOFF VOLUME ("SIMPLE METHOD" - SCHVELER (1987))

$$\begin{aligned} R_v &= 0.05 + 0.009(I) \\ &= 0.05 + 0.009(11.4) \\ &= 0.152 \end{aligned}$$

$R_v = \text{RUNOFF COEFFICIENT}$ $\frac{\text{STORM RUNOFF}}{\text{STORM RAINFALL}}$
 $I = \text{PERCENT IMPERVIOUS}$

VOLUME TO BE CONTAINED

$$\begin{aligned} \text{VOLUME} &= (\text{DESIGN RAINFALL})(R_v)(DA) \\ &= (1 \text{ IN}) \left(\frac{1}{12} \frac{\text{ft}}{\text{IN}}\right) (0.152)(13.48 \text{ AC}) \\ &= 0.171 \text{ AC-ft} = 7,437 \text{ ft}^3 \\ &= (7437)(1.20) \quad (\text{SEDIMENT STORAGE}) \\ &= 8924 \text{ ft}^3 \end{aligned}$$

STORAGE VOLUME REQUIRED = 9,000 ft ³

CALCULATION OF Q_P (RATIONAL)

$$Q_p = CIA$$

RATIONAL C VALUE

$$1.53 \text{ AC} \times 0.9 = 1.38$$

$$11.95 \text{ AC} \times 0.35 = 4.18$$

$$\frac{1.38 + 4.18}{13.48} = 0.41 \Rightarrow C = 0.41$$

INTENSITY (I)

10-YR INTENSITY FOR WILMINGTON = 5.9 in/hr

$$Q_p = (0.41)(5.9)(13.48)$$

$$Q_p = 32.6 \text{ CFS}$$

CALCULATION OF T_P

P = 4.16 in (10-YR, 6-HR PRECIPITATION)

$$CN = 70$$

$$S = \frac{1000}{CN} - 10 \text{ (STORAGE)}$$

$$= \frac{1000}{70} - 10$$

$$= 4.28$$

$$Q^* = \left(\frac{P - 0.2(S)}{P + 0.8(S)} \right)^2 \text{ (DEPTH OF RUNOFF)}$$

$$= \left(\frac{4.16 - 0.2(4.28)}{4.16 + 0.8(4.28)} \right)^2$$

$$Q^* = 1.44 \text{ in}$$

$$T_p = \text{VOL} / 1.39 Q_p$$

$$= \frac{(1.44 \text{ in})(13.48 \text{ AC})}{(1.39)(32.6 \text{ CFS})} \cdot \frac{1 \text{ FT}}{12 \text{ in}} \cdot \frac{43560 \text{ ft}^2}{1 \text{ AC}} \cdot \frac{1 \text{ MIN}}{60 \text{ SEC}}$$

$$T_p = 26 \text{ MIN}$$

R-2404A - Proposed Dry Detention Basin -Y4LPD-

April 2005 JRR

Reservoir Routing Hydrograph

Inflow Hydrograph:

Qp(cfs)=	32.6
Tp(min)=	26
dT(min.)=	2

Stage- Storage

Ks=	15371
b=	1.14

Initial Stage

(ft)	0
------	---

Results of Storm on Reservoir

Results of Storm on Reservoir	
Norm surf. Area(ac.)=	0.00
Max surf. Area(ac.)=	0.47
Peak Stage(ft)=	3.22
Rise(ft)=	3.22
Peak Outflow(cfs)=	7.25
Treatment Storage (cf)=	43536
Max storage (cf)=	58093

Required Storage: (Includes 20% sediment storage)

9000 cubic feet at 0.62 above invert of pond

Outflow Devices:

Culvert:

NN=	1
D(in)=	3
Cd=	0.6
Inv(ft)=	0

Weir1:

L(ft)=	2
Zcr(ft)=	2.30
Cw=	3

Weir3:

L(ft)=	300
Zcr(ft)=	4
Cw=	3

Weir2:

L(ft)=	10
Zcr(ft)=	3.00
Cw=	3

Barrel:

N=	1
Db(in)=	18
Cd=	0.6

Drawdown Time:

Stage after 2 days	0.38
Stage after 5 days	0.01

Head above barrel	1
Driving Q (cfs)	13

RESERVOIR #1

TIME (min)	INFLOW (cfs)	STORAGE (cu ft)	STAGE (ft)	OUTFLOW (cfs)
0	0	0.0	0.00	0.0
2	0	0.0	0.00	0.0
4	2	56.8	0.01	0.0
6	4	280.6	0.03	0.0
8	7	772.0	0.07	0.0
10	11	1615.7	0.14	0.0
12	14	2875.4	0.23	0.0
14	18	4590.1	0.35	0.1
16	22	6771.4	0.49	0.1
18	26	9405.9	0.65	0.1
20	28	12454.3	0.83	0.2
22	31	15852.3	1.03	0.2
24	32	19515.2	1.23	0.2
26	33	23342.8	1.44	0.2
28	32	27224.9	1.65	0.3
30	31	31048.4	1.86	0.3
32	29	34703.0	2.05	0.3
34	26	38088.3	2.22	0.3
36	23	41150.7	2.38	0.3
38	21	43916.1	2.52	0.4
40	19	46413.0	2.64	0.4
42	17	48665.0	2.76	0.7
44	16	50659.4	2.86	1.2
46	14	52400.7	2.94	1.7
48	13	53902.7	3.02	2.2
50	12	55183.1	3.08	2.7
52	11	56252.9	3.13	3.7
54	10	57065.7	3.17	4.9
56	9	57621.7	3.20	5.9
58	8	57950.2	3.22	6.6
60	7	58092.7	3.22	7.0
62	6	58092.1	3.22	7.2
64	6	57987.0	3.22	7.2
66	5	57809.3	3.21	7.1
68	5	57583.4	3.20	6.9
70	4	57327.6	3.19	6.5
72	4	57054.8	3.17	6.2
74	3	56774.0	3.16	5.9
76	3	56491.6	3.14	5.5
78	3	56211.5	3.13	5.2
80	3	55936.5	3.12	4.8
82	2	55668.2	3.10	4.5
84	2	55407.5	3.09	4.2
86	2	55154.9	3.08	4.0
88	2	54910.4	3.07	3.7
90	2	54673.9	3.06	3.5
92	1	54444.9	3.04	3.3



OUTFLOWS:


CULVERT (cfs)	WEIR1 (cfs)	WEIR2 (cfs)	WEIR3 (cfs)	TOTAL WEIR (cfs)	BARREL (cfs)	Rbspwy (cfs)
0.00	0.0	0.0	0.0	0.0	0.0	0.0
0.00	0.0	0.0	0.0	0.0	0.0	0.0
0.00	0.0	0.0	0.0	0.0	0.0	0.0
0.00	0.0	0.0	0.0	0.0	0.0	0.0
0.01	0.0	0.0	0.0	0.0	0.0	0.0
0.03	0.0	0.0	0.0	0.0	0.0	0.0
0.07	0.0	0.0	0.0	0.1	0.1	0.1
0.11	0.0	0.0	0.0	0.1	0.1	0.1
0.14	0.0	0.0	0.0	0.1	0.1	0.1
0.17	0.0	0.0	0.0	0.2	0.2	0.2
0.20	0.0	0.0	0.0	0.2	0.2	0.2
0.22	0.0	0.0	0.0	0.2	0.2	0.2
0.25	0.0	0.0	0.0	0.2	0.2	0.2
0.27	0.0	0.0	0.0	0.3	0.3	0.3
0.29	0.0	0.0	0.0	0.3	0.3	0.3
0.31	0.0	0.0	0.0	0.3	0.3	0.3
0.33	0.0	0.0	0.0	0.3	0.3	0.3
0.34	0.0	0.0	0.0	0.3	0.3	0.3
0.35	0.0	0.0	0.0	0.4	0.4	0.4
0.37	0.0	0.0	0.0	0.4	0.4	0.4
0.37	0.3	0.0	0.0	0.7	0.7	0.7
0.38	0.8	0.0	0.0	1.2	1.2	1.2
0.39	1.3	0.0	0.0	1.7	1.7	1.7
0.40	1.8	0.0	0.0	2.2	2.2	2.2
0.40	2.2	0.1	0.0	2.7	2.7	2.7
0.41	2.7	0.7	0.0	3.7	3.7	3.7
0.41	3.0	1.4	0.0	4.9	4.9	4.9
0.41	3.3	2.1	0.0	5.9	5.9	5.9
0.41	3.5	2.7	0.0	6.6	6.6	6.6
0.41	3.6	3.0	0.0	7.0	7.0	7.0
0.42	3.7	3.1	0.0	7.2	7.2	7.2
0.42	3.7	3.1	0.0	7.2	7.2	7.2
0.41	3.6	3.0	0.0	7.1	7.1	7.1
0.41	3.6	2.9	0.0	6.9	6.9	6.9
0.41	3.5	2.6	0.0	6.5	6.5	6.5
0.41	3.4	2.4	0.0	6.2	6.2	6.2
0.41	3.3	2.1	0.0	5.9	5.9	5.9
0.41	3.2	1.9	0.0	5.5	5.5	5.5
0.41	3.1	1.6	0.0	5.2	5.2	5.2
0.41	3.0	1.4	0.0	4.8	4.8	4.8
0.41	2.9	1.2	0.0	4.5	4.5	4.5
0.41	2.8	1.0	0.0	4.2	4.2	4.2
0.41	2.7	0.8	0.0	4.0	4.0	4.0
0.41	2.6	0.7	0.0	3.7	3.7	3.7
0.40	2.6	0.5	0.0	3.5	3.5	3.5
0.40	2.5	0.4	0.0	3.3	3.3	3.3
0.40	2.4	0.3	0.0	3.1	3.1	3.1

94	1	54222.9	3.03	3.1
96	1	54007.3	3.02	2.9
98	1	53797.3	3.01	2.8
100	1	53592.0	3.00	2.6
102	1	53389.9	2.99	2.5
104	1	53189.3	2.98	2.5
106	1	52986.7	2.97	2.4
108	1	52782.7	2.96	2.3
110	1	52578.2	2.95	2.3
112	1	52373.9	2.94	2.2
114	0	52170.5	2.93	2.2
116	0	51968.5	2.92	2.1
118	0	51768.4	2.91	2.0
120	0	51570.4	2.90	2.0
122	0	51375.1	2.89	1.9
124	0	51182.6	2.88	1.9
126	0	50993.1	2.87	1.8
128	0	50806.8	2.86	1.8
130	0	50623.9	2.85	1.7
132	0	50444.4	2.85	1.7
134	0	50268.5	2.84	1.6
136	0	50096.1	2.83	1.6
138	0	49927.4	2.82	1.5
140	0	49762.2	2.81	1.5
142	0	49600.7	2.80	1.4
144	0	49442.7	2.80	1.4
146	0	49288.3	2.79	1.4
148	0	49137.4	2.78	1.3
150	0	48990.0	2.77	1.3
152	0	48846.0	2.77	1.2
154	0	48705.3	2.76	1.2
156	0	48567.9	2.75	1.2
158	0	48433.7	2.75	1.1
160	0	48302.7	2.74	1.1
162	0	48174.7	2.73	1.1
164	0	48049.8	2.73	1.1
166	0	47927.7	2.72	1.0
168	0	47808.5	2.71	1.0
170	0	47692.1	2.71	1.0
172	0	47578.3	2.70	1.0
174	0	47467.2	2.70	0.9
176	0	47358.6	2.69	0.9
178	0	47252.4	2.69	0.9
180	0	47148.7	2.68	0.9
182	0	47047.3	2.68	0.8
184	0	46948.1	2.67	0.8
186	0	46851.2	2.67	0.8
188	0	46756.3	2.66	0.8
190	0	46663.5	2.66	0.8
192	0	46572.7	2.65	0.8
194	0	46483.8	2.65	0.7
196	0	46396.8	2.64	0.7
198	0	46311.6	2.64	0.7
200	0	46228.1	2.64	0.7
202	0	46146.4	2.63	0.7
204	0	46066.3	2.63	0.7
206	0	45987.7	2.62	0.6
208	0	45910.8	2.62	0.6
210	0	45835.3	2.62	0.6
212	0	45761.2	2.61	0.6
214	0	45688.5	2.61	0.6
216	0	45617.2	2.60	0.6
218	0	45547.2	2.60	0.6
220	0	45478.5	2.60	0.6
222	0	45411.0	2.59	0.6
224	0	45344.6	2.59	0.5
226	0	45279.4	2.59	0.5
228	0	45215.3	2.58	0.5
230	0	45152.3	2.58	0.5
232	0	45090.3	2.58	0.5
234	0	45029.3	2.58	0.5
236	0	44969.3	2.57	0.5
238	0	44910.2	2.57	0.5
240	0	44852.0	2.57	0.5
242	0	44794.7	2.56	0.5
244	0	44738.3	2.56	0.5
246	0	44682.6	2.56	0.5
248	0	44627.7	2.56	0.5
250	0	44573.6	2.55	0.4

0.40	2.3	0.2	0.0	2.9	2.9	2.9
0.40	2.3	0.1	0.0	2.8	2.8	2.8
0.40	2.2	0.0	0.0	2.6	2.6	2.6
0.40	2.1	0.0	0.0	2.5	2.5	2.5
0.40	2.1	0.0	0.0	2.5	2.5	2.5
0.40	2.0	0.0	0.0	2.4	2.4	2.4
0.40	1.9	0.0	0.0	2.3	2.3	2.3
0.40	1.9	0.0	0.0	2.3	2.3	2.3
0.40	1.8	0.0	0.0	2.2	2.2	2.2
0.40	1.8	0.0	0.0	2.2	2.2	2.2
0.40	1.7	0.0	0.0	2.1	2.1	2.1
0.39	1.6	0.0	0.0	2.0	2.0	2.0
0.39	1.6	0.0	0.0	2.0	2.0	2.0
0.39	1.5	0.0	0.0	1.9	1.9	1.9
0.39	1.5	0.0	0.0	1.9	1.9	1.9
0.39	1.4	0.0	0.0	1.8	1.8	1.8
0.39	1.4	0.0	0.0	1.8	1.8	1.8
0.39	1.3	0.0	0.0	1.7	1.7	1.7
0.39	1.3	0.0	0.0	1.7	1.7	1.7
0.39	1.2	0.0	0.0	1.6	1.6	1.6
0.39	1.2	0.0	0.0	1.6	1.6	1.6
0.39	1.1	0.0	0.0	1.5	1.5	1.5
0.39	1.1	0.0	0.0	1.5	1.5	1.5
0.39	1.0	0.0	0.0	1.4	1.4	1.4
0.39	1.0	0.0	0.0	1.4	1.4	1.4
0.39	1.0	0.0	0.0	1.4	1.4	1.4
0.39	0.9	0.0	0.0	1.3	1.3	1.3
0.38	0.9	0.0	0.0	1.3	1.3	1.3
0.38	0.9	0.0	0.0	1.2	1.2	1.2
0.38	0.8	0.0	0.0	1.2	1.2	1.2
0.38	0.8	0.0	0.0	1.2	1.2	1.2
0.38	0.8	0.0	0.0	1.1	1.1	1.1
0.38	0.7	0.0	0.0	1.1	1.1	1.1
0.38	0.7	0.0	0.0	1.1	1.1	1.1
0.38	0.7	0.0	0.0	1.1	1.1	1.1
0.38	0.6	0.0	0.0	1.0	1.0	1.0
0.38	0.6	0.0	0.0	1.0	1.0	1.0
0.38	0.6	0.0	0.0	1.0	1.0	1.0
0.38	0.6	0.0	0.0	1.0	1.0	1.0
0.38	0.5	0.0	0.0	0.9	0.9	0.9
0.38	0.5	0.0	0.0	0.9	0.9	0.9
PRELIMINARY PLANS DO NOT USE FOR CONSTRUCTION	
 HDR HDR Engineering, Inc. of the Carolinas 3733 National Drive, Suite 207 Raleigh, N.C. 27612	
 BARNHILL CONTRACTING COMPANY	

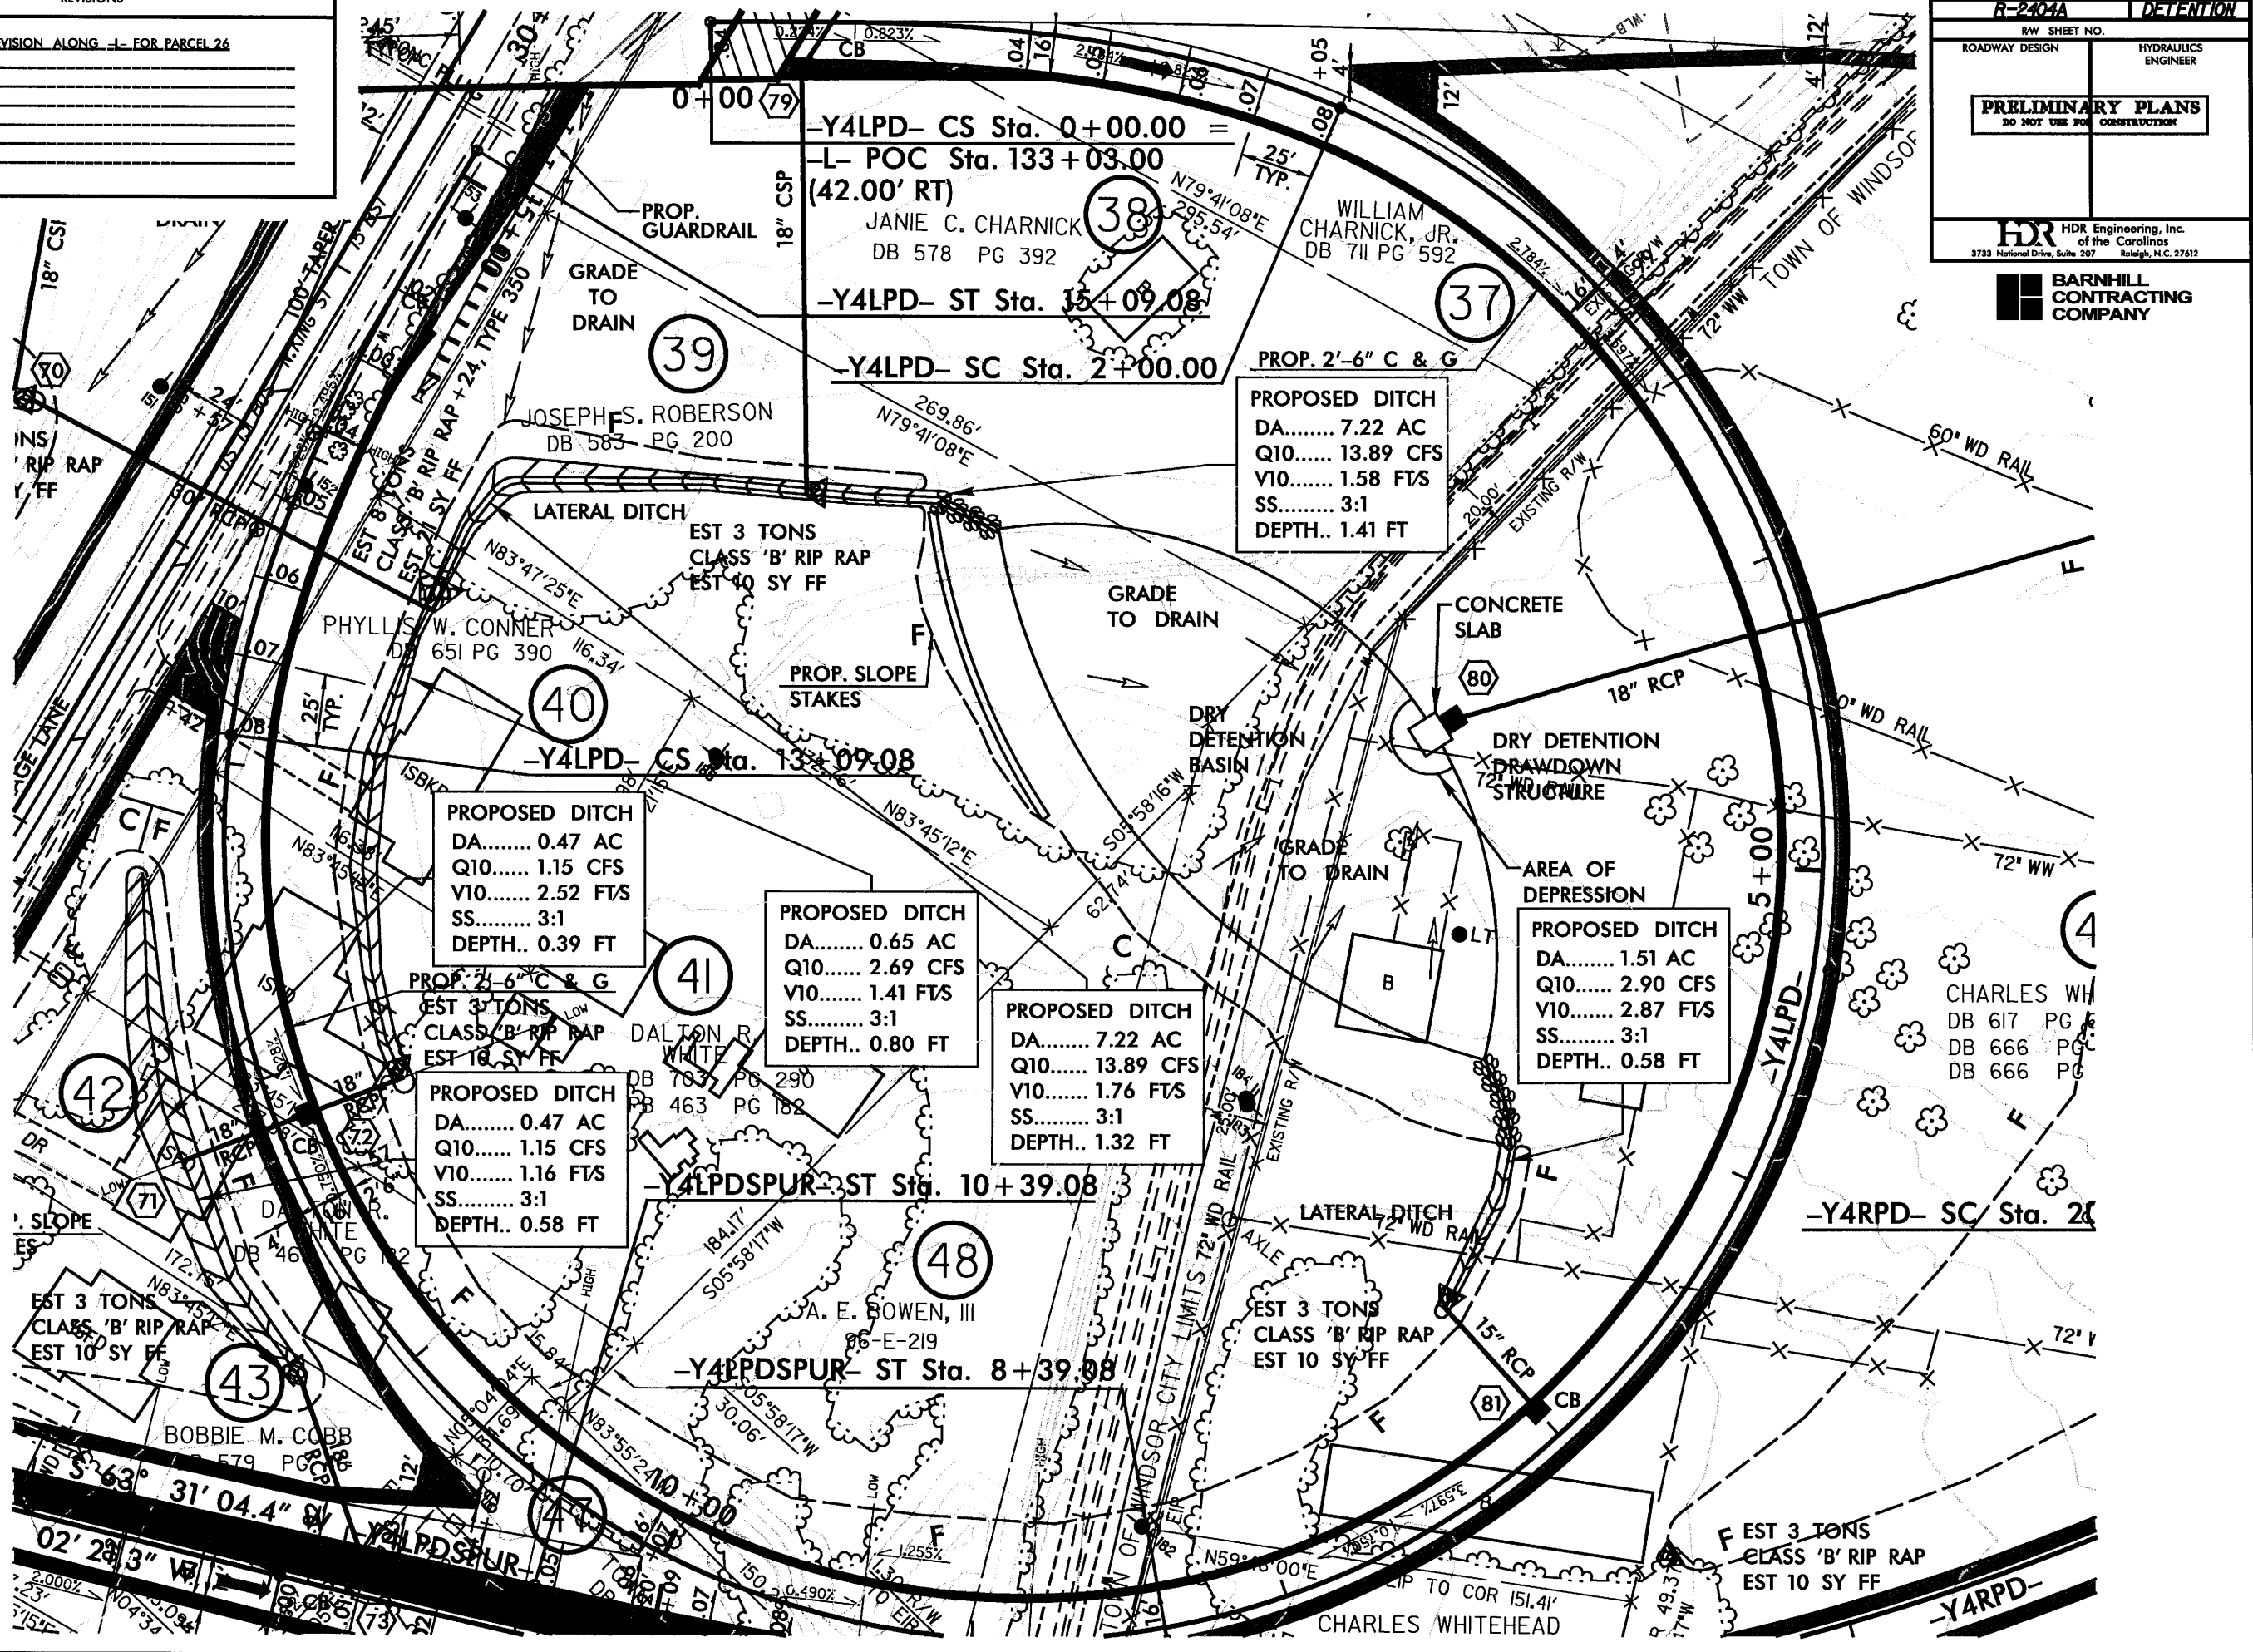


B/C/2005 9:45 AM 2404A.dwg


BARNHILL CONTRACTING COMPANY

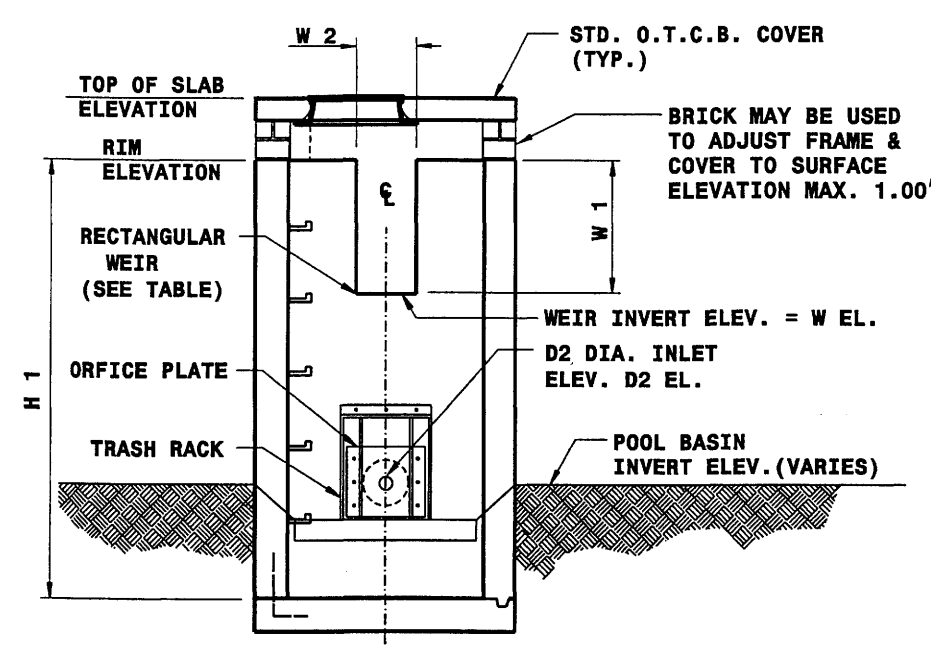

ELEVATION OF STRUCTURE SIDE 1

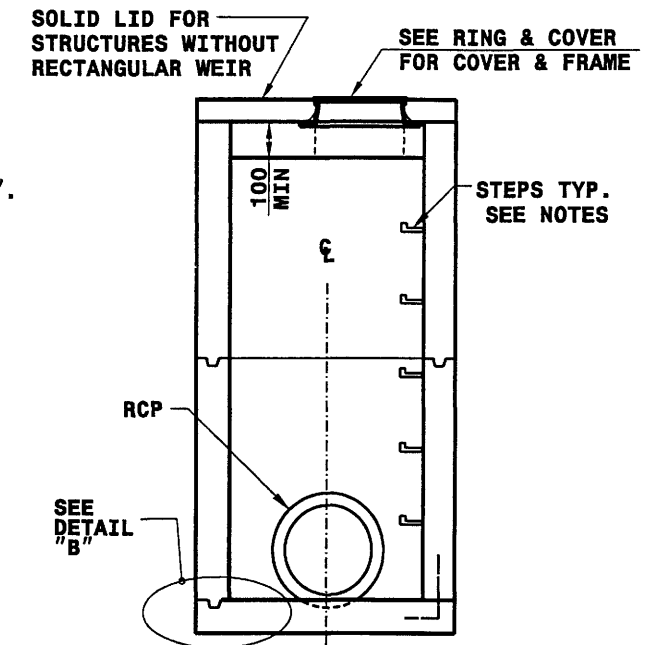


ELEVATION OF STRUCTURE SIDE 2

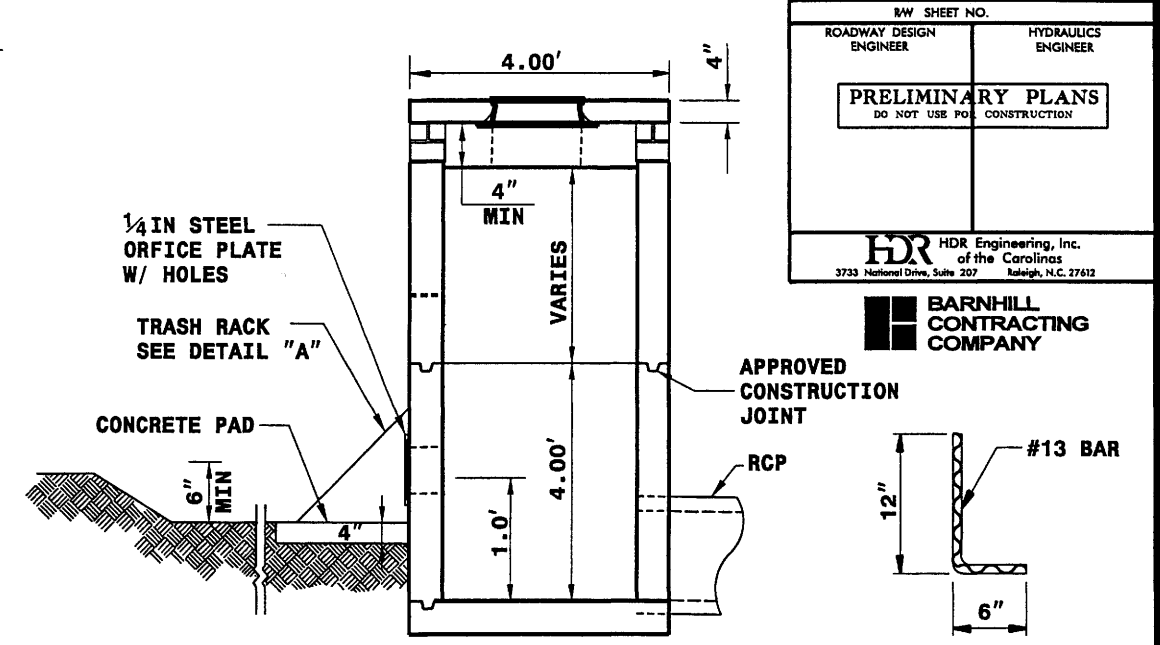


ELEVATION OF STRUCTURE SIDE 3

MINIMUM DIMENSIONS FOR DRY DETENTION BASIN DRAWDOWN STRUCTURE													
QUANTITIES FOR CONCRETE DETERMINED FROM NCDOT STANDARD 840.04													
STATION	PIPE D	OUTLET BOX		RIM ELEVATION	TOP OF SLAB ELEV.	REMARKS	WEIR DIMENSIONS			DRAWDOWN ORFICE		POOL BASIN INVERT INV. EL.	
		PIPE INVERT	PIPE HEIGHT H1				W1	W2	W EL.	D2	NO. OF HOLES		D2 EL.
-Y4LPD-	18"	8.00	4.00	12.00	8.50	OTCB	0.50'	2.00'	11.50	3"	1	9.00	9.00

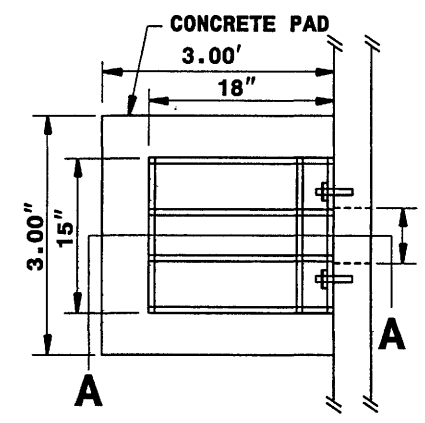

PLAN VIEW

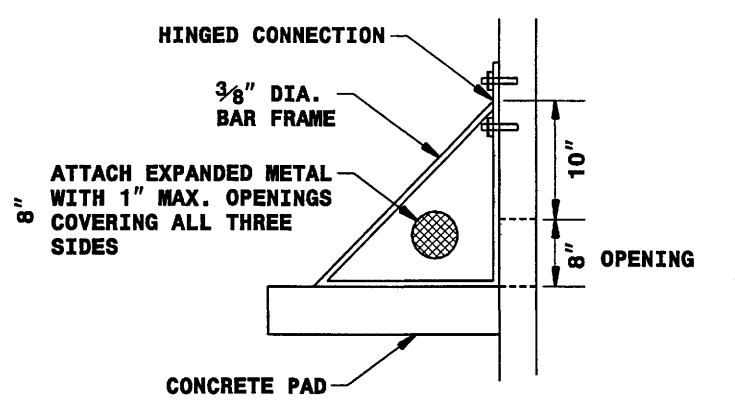


SECTION A-A


DETAIL A - EXTENDED DETENTION TRASH RACK

GENERAL NOTES:


- * CLASS 'B' CONCRETE TO BE USED THROUGHOUT. PRECAST CONCRETE STRUCTURES TO BE SUBMITTED FOR APPROVAL.
- * OPTIONAL CONSTRUCTION - MONOLITHIC POUR, 2" KEYWAY, OR #13 BAR DOWELS AT 12" CENTERS, AS DIRECTED BY ENGINEER.
- * FORMS ARE TO BE USED FOR THE CONSTRUCTION OF THE BOTTOM SLAB.
- * IF REINFORCED CONCRETE PIPE IS SET IN BASE SLAB OF BOX, ADD TO BASE AS SHOWN ON STANDARD 840.00.
- * ALL DRAWDOWN STRUCTURES OVER 3' IN DEPTH TO BE PROVIDED WITH STEPS 14" ON CENTERS. STEPS SHALL BE INSTALLED IN ACCORDANCE WITH STANDARD 840.66.
- * FOR 8.0' IN HEIGHT OR LESS USE 6" WALLS AND BOTTOM SLAB. OVER 8.0' TO 16.0' IN HEIGHT USE 8" WALLS AND BOTTOM SLAB. ADJUST QUANTITIES ACCORDINGLY.

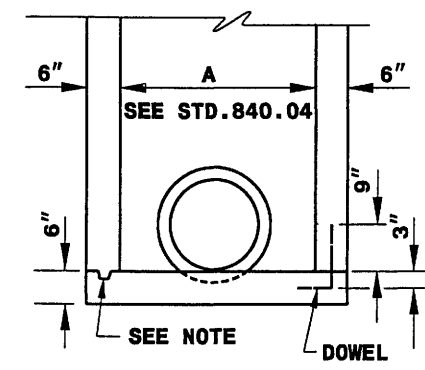


DETAIL 'B'

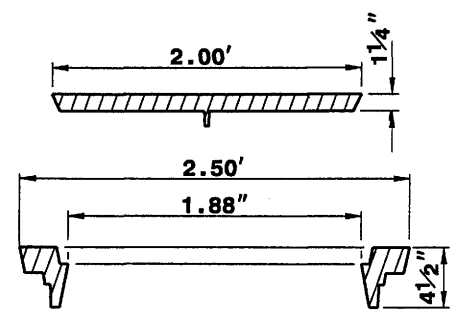

RING & COVER

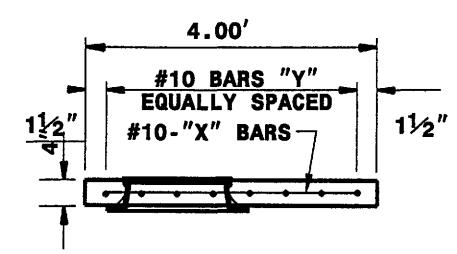

TOP SLAB

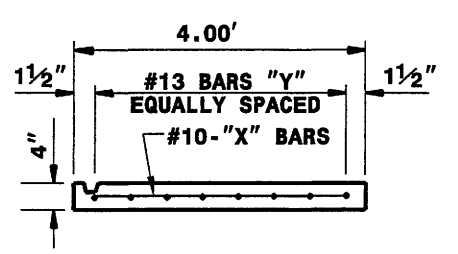

BOTTOM SLAB

7/5/2005 9:44:47 AM \\s2466\vol\asst\157402A.cdw\ash.draft\action.dgn



PROJECT NO. 34424.1.1		ID. R-2404A		COUNTY BERTIE		GEOLOGIST Charles Ray								
SITE DESCRIPTION US 17 (Windsor Bypass) from US 13-17 TO EAST OF SR 1503 (Davis Drive)							GROUND WATER (ft)							
BORING NO. CB-80		BORING LOCATION 12+00		OFFSET 0ft CL		ALIGNMENT -Y4LPD-								
COLLAR ELEV. 10.7 ft		NORTHING 829,117		EASTING 2,605,341		0 HR. 3.7								
TOTAL DEPTH 40.5 ft		DRILL MACHINE CME 45B ATV		DRILL METHOD Mud Rotary		HAMMER TYPE Manual								
DATE STARTED 7/6/04		COMPLETED 7/6/04		CORE BARREL TYPE N/A		SURFACE WATER DEPTH N/A								
ELEV. (ft)	DEPTH (ft)	BLOW COUNT			BLOWS PER FOOT					SAMP. NO.	LOG	SOIL AND ROCK DESCRIPTION		
		0.5ft	0.5ft	0.5ft	0	20	40	60	80	100				
		Land Surface											10.7	0.00
9.7	1.0	2	3	2						5	M	Brown, SILTY, v.f. to f. SAND w/organics. Loose. Yorktown Formation.		
7.2	3.5	3	4	7						11	W	Tan, poorly graded, v.f. SAND w/trace silt. Med. dense.		
4.7	6.0	7	8	10						18	W			
2.2	8.5	3	3	1						4	W	Tan, well graded, v.f. to cse. SAND w/gravel. Loose.		
-3.3	14.0	2	1	1						2	M			
-8.3	19.0	2	2	4						6	M	Green, SILTY, v.f. to f. SANDY CLAY w/med. to high plasticity. Soft to stiff. Shell fragments in lower portion of strata.		
-13.3	24.0	2	3	4						7	M			
-18.3	29.0	3	4	6						10	M			

14-049 WINDSOR BYPASS-CATLIN.GPJ NC_DOT.GDT 8/24/04



PROJECT NO. 34424.1.1		ID. R-2404A		COUNTY BERTIE		GEOLOGIST Charles Ray								
SITE DESCRIPTION US 17 (Windsor Bypass) from US 13-17 TO EAST OF SR 1503 (Davis Drive)							GROUND WATER (ft)							
BORING NO. CB-80		BORING LOCATION 12+00		OFFSET 0ft CL		ALIGNMENT -Y4LPD-								
COLLAR ELEV. 10.7 ft		NORTHING 829,117		EASTING 2,605,341		0 HR. 3.7								
TOTAL DEPTH 40.5 ft		DRILL MACHINE CME 45B ATV		DRILL METHOD Mud Rotary		HAMMER TYPE Manual								
DATE STARTED 7/6/04		COMPLETED 7/6/04		CORE BARREL TYPE N/A		SURFACE WATER DEPTH N/A								
ELEV. (ft)	DEPTH (ft)	BLOW COUNT			BLOWS PER FOOT					SAMP. NO.	LOG	SOIL AND ROCK DESCRIPTION		
		0.5ft	0.5ft	0.5ft	0	20	40	60	80	100				
		CONTINUED FROM PREVIOUS PAGE												
-23.3	34.0	3	3	5						8	M	Green, SILTY, v.f. to f. SANDY CLAY w/med. to high plasticity. Soft to stiff. Shell fragments in lower portion of strata.		
-28.3	39.0	4	5	7						12	M			
		Boring Terminated at Elevation -29.8 ft in SILTY, v.f. to f. SANDY CLAY. Yorktown Formation											-29.8	40.5



PROJECT NO. 34424.1.1		ID. R-2404A		COUNTY BERTIE		GEOLOGIST Tom Stetler								
SITE DESCRIPTION US 17 (Windsor Bypass) from US 13-17 TO EAST OF SR 1503 (Davis Drive)							GROUND WATER (ft)							
BORING NO. CB-85		BORING LOCATION 22+00		OFFSET 0ft CL		ALIGNMENT -Y4RPD-								
COLLAR ELEV. 16.6 ft		NORTHING 828,763		EASTING 2,605,691		0 HR. 5.4								
TOTAL DEPTH 10.0 ft		DRILL MACHINE Hand Auger		DRILL METHOD Hand Auger		HAMMER TYPE N/A								
DATE STARTED 6/23/04		COMPLETED 6/23/04		CORE BARREL TYPE N/A		SURFACE WATER DEPTH N/A								
ELEV. (ft)	DEPTH (ft)	BLOW COUNT			BLOWS PER FOOT					SAMP. NO.	LOG MOI	LOG	SOIL AND ROCK DESCRIPTION	
		0.5ft	0.5ft	0.5ft	0	20	40	60	80					100
														Land Surface
														16.6 0.00
														16.1 Topsoil. 0.5
	14.6	2.0												14.6 Dark brown, SILTY, f. to v.f. SAND, moderately organic. Loose. Well graded. Moist. 2.0
											CS-43			
														Light brownish gray, SILTY, f. to v.f. SAND. Trace clay. Med. stiff. Moist. Yorktown Formation.
														11.6 5.0
														Light brown to tan, f. to v.f. SAND. Poorly graded. Minor iron oxide staining. Loose. Sat. @ 6ft..
														6.6 10.0
														Boring Terminated at Elevation 6.6 ft in poorly graded, v.f. to f. SAND. Yorktown Formation



PROJECT NO. 34424.1.1		ID. R-2404A		COUNTY BERTIE		GEOLOGIST Tom Stetler								
SITE DESCRIPTION US 17 (Windsor Bypass) from US 13-17 TO EAST OF SR 1503 (Davis Drive)							GROUND WATER (ft)							
BORING NO. CB-86		BORING LOCATION 20+00		OFFSET 0ft CL		ALIGNMENT -Y4RPD-								
COLLAR ELEV. 15.7 ft		NORTHING 828,920		EASTING 2,605,813		0 HR. 5.1								
TOTAL DEPTH 10.0 ft		DRILL MACHINE Hand Auger		DRILL METHOD Hand Auger		HAMMER TYPE NA/								
DATE STARTED 6/23/04		COMPLETED 6/23/04		CORE BARREL TYPE N/A		SURFACE WATER DEPTH N/A								
ELEV. (ft)	DEPTH (ft)	BLOW COUNT			BLOWS PER FOOT					SAMP. NO.	LOG MOI	LOG	SOIL AND ROCK DESCRIPTION	
		0.5ft	0.5ft	0.5ft	0	20	40	60	80					100
														Land Surface
														15.7 0.00
														15.2 Topsoil. 0.5
	11.7	4.0												
											CS-44			
														Dark brown grading to orange tan, f. to v.f. SAND. Poorly graded. Some zones w/trace silt and cse. sand. Loose. Moist to Sat. at 5ft. Yorktown Formation.
														5.7 10.0
														Boring Terminated at Elevation 5.7 ft in poorly graded, v.f. to f. SAND. Yorktown Formation

STATE	STATE PROJECT REFERENCE NO.	SHEET NO.	TOTAL SHEETS
N.C.	R-2404A	1	
STATE PROJ. NO.	F.A. PROJ. NO.	DESCRIPTION	
C201236		CONTRACT NO.	
6.01900IT & 34424.1.1		PLANNING & PE	
34424.3.7		CONST.	


See Sheet 1-A For Index of Sheets

STATE OF NORTH CAROLINA
DIVISION OF HIGHWAYS


BERTIE COUNTY

LOCATION: US 17 (WINDSOR BYPASS) FROM US 1317, SOUTH OF WINDSOR, TO EAST OF SR 1503 (DAVIS ROAD)

TYPE OF WORK: DESIGN-BUILD AS SPECIFIED IN THE SCOPES OF WORK CONTAINED IN THE DESIGN-BUILD PACKAGE

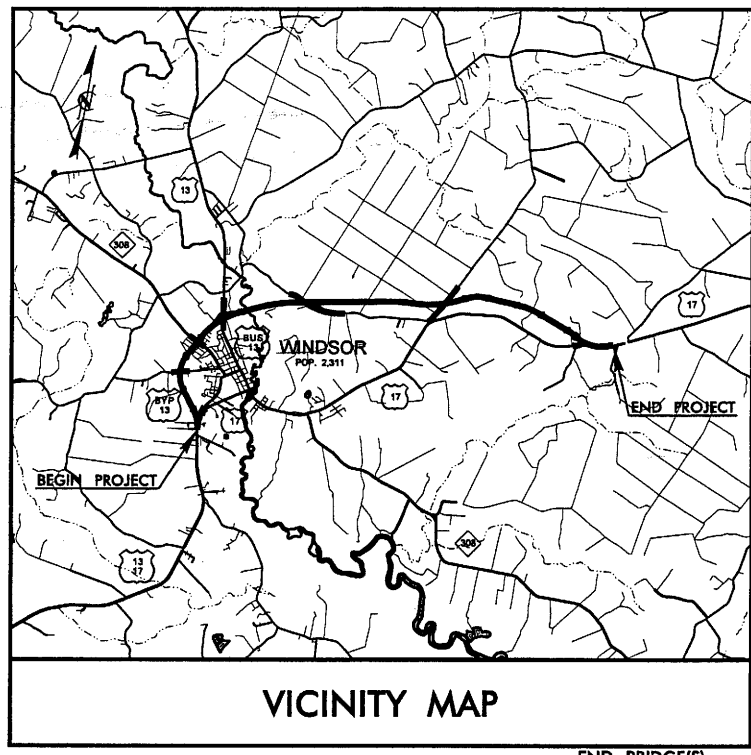

VICINITY MAP

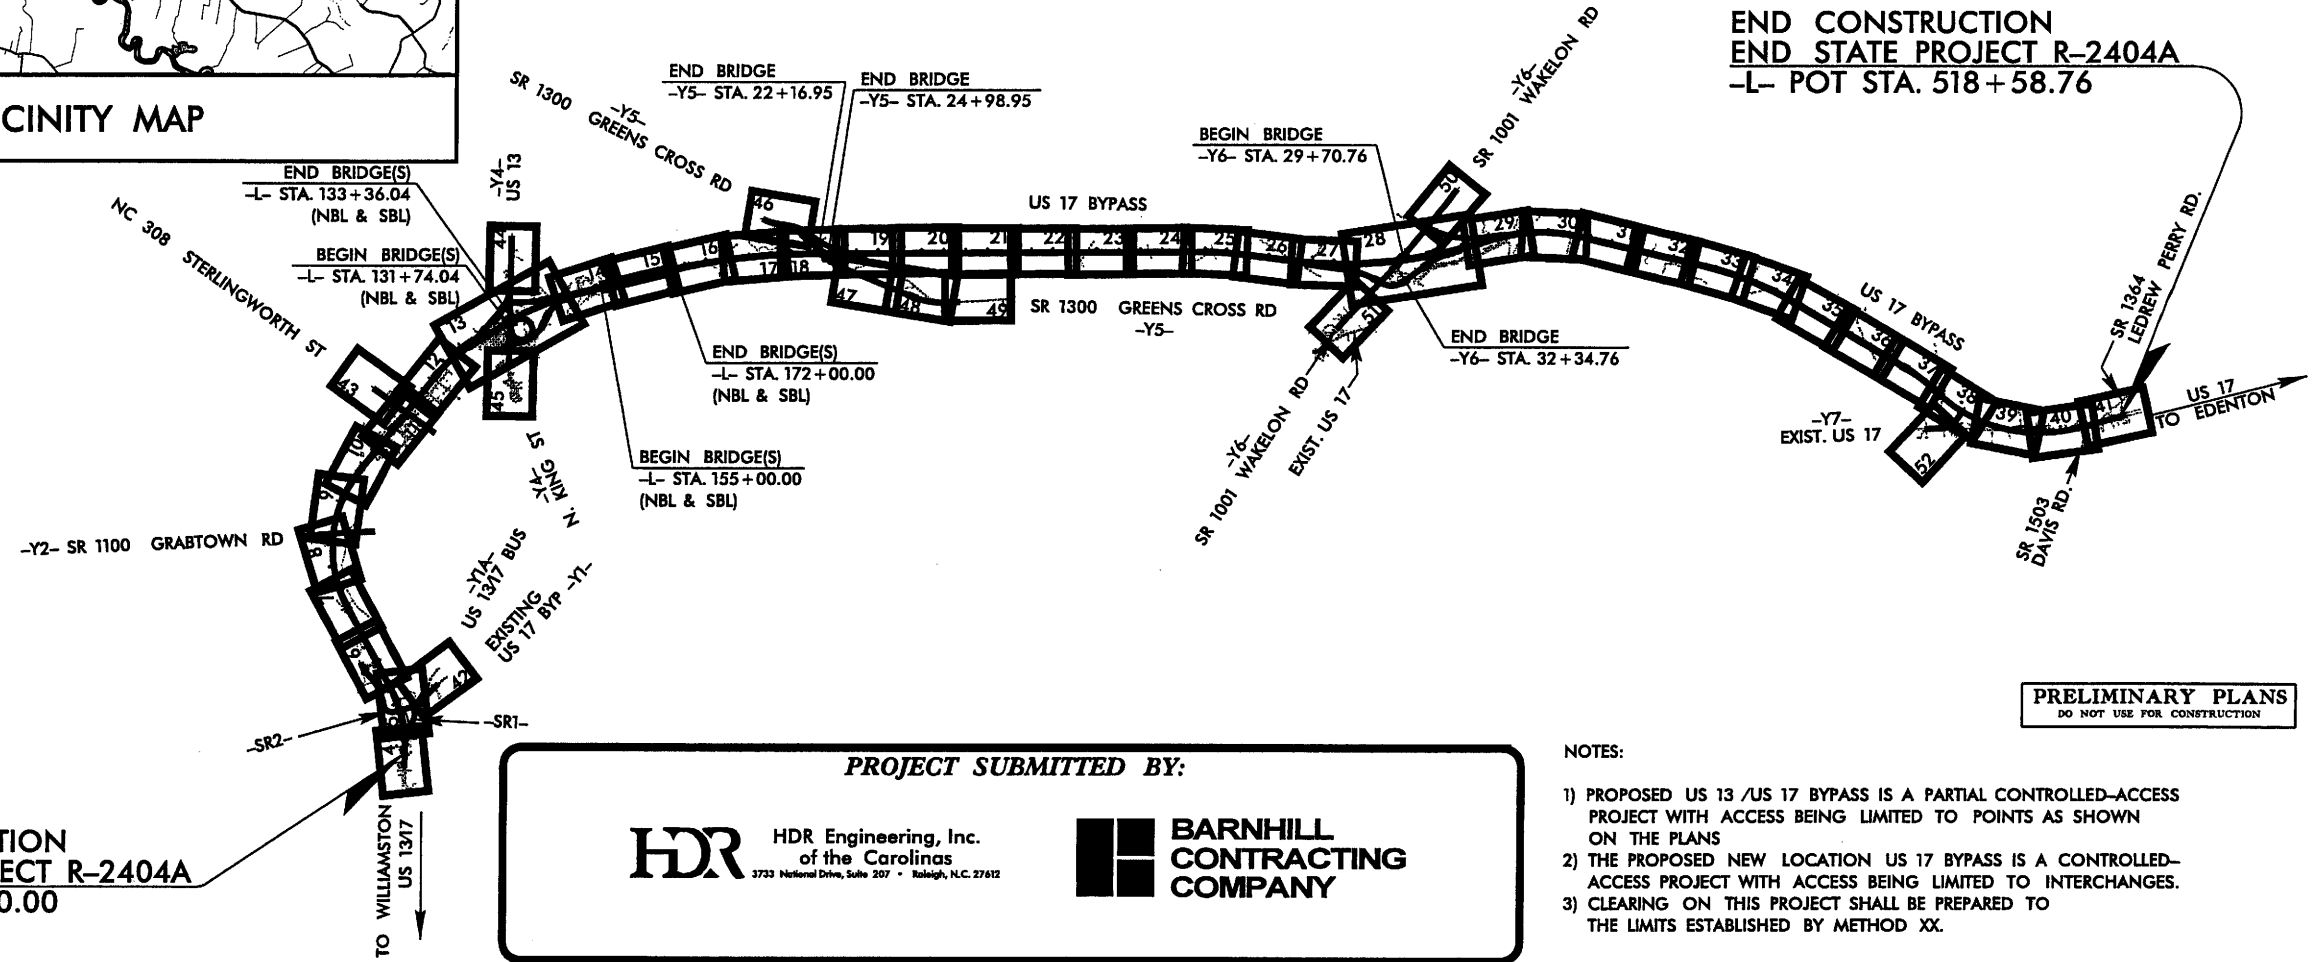

**END CONSTRUCTION
END STATE PROJECT R-2404A
-L- POT STA. 518+58.76**

**BEGIN CONSTRUCTION
BEGIN STATE PROJECT R-2404A
-L- POT STA. 12+00.00**


**PRELIMINARY PLANS
DO NOT USE FOR CONSTRUCTION**

PROJECT SUBMITTED BY:

HDR Engineering, Inc.
of the Carolinas
3733 National Drive, Suite 207 • Raleigh, N.C. 27612

**BARNHILL
CONTRACTING
COMPANY**

- NOTES:**
- 1) PROPOSED US 13 /US 17 BYPASS IS A PARTIAL CONTROLLED-ACCESS PROJECT WITH ACCESS BEING LIMITED TO POINTS AS SHOWN ON THE PLANS
 - 2) THE PROPOSED NEW LOCATION US 17 BYPASS IS A CONTROLLED-ACCESS PROJECT WITH ACCESS BEING LIMITED TO INTERCHANGES.
 - 3) CLEARING ON THIS PROJECT SHALL BE PREPARED TO THE LIMITS ESTABLISHED BY METHOD XX.

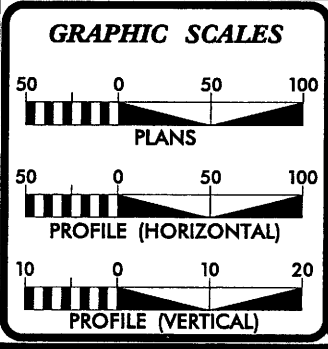

DESIGN DATA

ADT 2004 =	12,500
ADT 2025 =	21,300
DHV =	12 %
D =	55 %
T =	12 % *
V =	70 mph (NEW LOC.)
* TTST 8% DUAL 4%	
Functional Class:	Freeway

PROJECT LENGTH

LENGTH ROADWAY TIP PROJECT R-2404A	=	9.241 MILES
LENGTH ROADWAY TIP PROJECT R-2404A	=	0.353 MILES
TOTAL LENGTH STATE PROJECT R-2404A	=	9.594 MILES

Prepared in the Office of:
DIVISION OF HIGHWAYS
1000 Birch Ridge Dr., NC, 27610

2002 STANDARD SPECIFICATIONS NCDOT CONTACT:

LETTING DATE:
DECEMBER 23, 2004

RODGER ROCHELLE, PE
STATE ALTERNATIVE DELIVERY SYSTEMS ENGINEER

DESIGN-BUILD PROJECT ENGINEER

HYDRAULICS ENGINEER

SIGNATURE: _____ P.E.

ROADWAY DESIGN ENGINEER

SIGNATURE: _____ P.E.

**DIVISION OF HIGHWAYS
STATE OF NORTH CAROLINA**

STATE DESIGN ENGINEER _____ P.E.

**DEPARTMENT OF TRANSPORTATION
FEDERAL HIGHWAY ADMINISTRATION**


APPROVED _____ DATE _____

7/15/2005 9:35:12 AM R:\R-2404A\proj\N2404A_rdy_tsh.dgn


PROJECT: R-2404A C201236

7/15/2005 9:41:11 AM
 F:\R-2404A\proj\R2404A_rdy_typ.dgn

PAVEMENT SCHEDULE	
C1	PROP. APPROX. 3.0" ASPHALT CONCRETE SURFACE COURSE, TYPE S9.5B, AT AN AVERAGE RATE OF 168 Lbs PER SQUARE YARD IN EACH OF TWO LAYERS.
C2	PROP. APPROX. 3.0" ASPHALT CONCRETE SURFACE COURSE, TYPE S9.5C, AT AN AVERAGE RATE OF 168 Lbs PER SQUARE YARD IN EACH OF TWO LAYERS.
C3	PROP. VAR. DEPTH ASPHALT CONCRETE SURFACE COURSE, TYPE S9.5B, AT AN AVERAGE RATE OF 112 LBS. PER SQ. YD. PER 1" DEPTH. TO BE PLACED IN LAYERS NOT TO EXCEED 1.5" IN DEPTH.
C4	PROP. VAR. DEPTH ASPHALT CONCRETE SURFACE COURSE, TYPE S9.5C, AT AN AVERAGE RATE OF 112 LBS. PER SQ. YD. PER 1" DEPTH. TO BE PLACED IN LAYERS NOT TO EXCEED 1.5" IN DEPTH.
D1	PROP. APPROX. 2.5" ASPHALT CONCRETE INTERMEDIATE COURSE, TYPE I19.0B, AT AN AVERAGE RATE OF 285 Lbs PER SQUARE YARD IN ONE LAYER.
D2	PROP. APPROX. 3.0" ASPHALT CONCRETE INTERMEDIATE COURSE, TYPE I19.0C, AT AN AVERAGE RATE OF 342 Lbs PER SQUARE YARD IN ONE LAYER.
D3	PROP. APPROX. 4.0" ASPHALT CONCRETE INTERMEDIATE COURSE, TYPE I19.0C, AT AN AVERAGE RATE OF 456 Lbs PER SQUARE YARD IN ONE LAYER.
D4	PROP. VAR. DEPTH ASPHALT CONCRETE INTERMEDIATE COURSE, TYPE I19.0C, AT AN AVERAGE RATE OF 114 LBS. PER SQ. YD. PER 1" DEPTH, TO BE PLACED IN LAYERS NOT LESS THAN 2.25" IN DEPTH OR OR GREATER THAN 4" IN DEPTH
E1	PROP. APPROX. 4.0" ASPHALT CONCRETE BASE COURSE, TYPE B25.0B, AT AN AVERAGE RATE OF 456 Lbs PER SQUARE YARD IN ONE LAYER.
E2	PROP. APPROX. 4.0" ASPHALT CONCRETE BASE COURSE, TYPE B25.0C, AT AN AVERAGE RATE OF 456 Lbs PER SQUARE YARD IN ONE LAYER.
E3	PROP. APPROX. 4.5" ASPHALT CONCRETE BASE COURSE, TYPE B25.0B, AT AN AVERAGE RATE OF 513 Lbs PER SQUARE YARD IN ONE LAYER.
E4	PROP. APPROX. 5.5" ASPHALT CONCRETE BASE COURSE, TYPE B25.0B, AT AN AVERAGE RATE OF 627 Lbs PER SQUARE YARD IN ONE LAYER.
E5	PROP. APPROX. 5.5" ASPHALT CONCRETE BASE COURSE, TYPE B25.0C, AT AN AVERAGE RATE OF 627 Lbs PER SQUARE YARD IN ONE LAYER.
E6	PROP. VAR. DEPTH ASPHALT CONCRETE BASE COURSE, TYPE B25.0B, AT AN AVERAGE RATE OF 114 LBS. PER SQ. YD. PER 1" DEPTH. TO BE PLACED IN LAYERS NOT LESS THAN 3" IN DEPTH OR GREATER THAN 5.5" IN DEPTH
E7	PROP. VAR. DEPTH ASPHALT CONCRETE BASE COURSE, TYPE B25.0C, AT AN AVERAGE RATE OF 114 LBS. PER SQ. YD. PER 1" DEPTH. TO BE PLACED IN LAYERS NOT LESS THAN 3" IN DEPTH OR GREATER THAN 5.5" IN DEPTH
R1	2'-6" CONCRETE CURB AND GUTTER
T	EARTH MATERIAL.
U	EXISTING PAVEMENT.
V	MILLING EXISTING ASPHALT PAVEMENT, 0" TO 3" DEPTH
W1	VARIABLE DEPTH ASPHALT PAVEMENT (SEE STANDARD WEDGING DETAIL SHEET 2-A)
W2	VARIABLE DEPTH ASPHALT PAVEMENT (SEE STANDARD WEDGING DETAIL SHEET 2-A)
W3	VARIABLE DEPTH ASPHALT PAVEMENT (SEE STANDARD WEDGING DETAIL SHEET 2-A)

R-2404A		2	
RW SHEET NO.			
ROADWAY DESIGN ENGINEER		PAVEMENT DESIGN ENGINEER	
PRELIMINARY PLANS DO NOT USE FOR CONSTRUCTION			
 HDR Engineering, Inc. of the Carolinas 3733 National Drive, Suite 207 Raleigh, N.C. 27612			



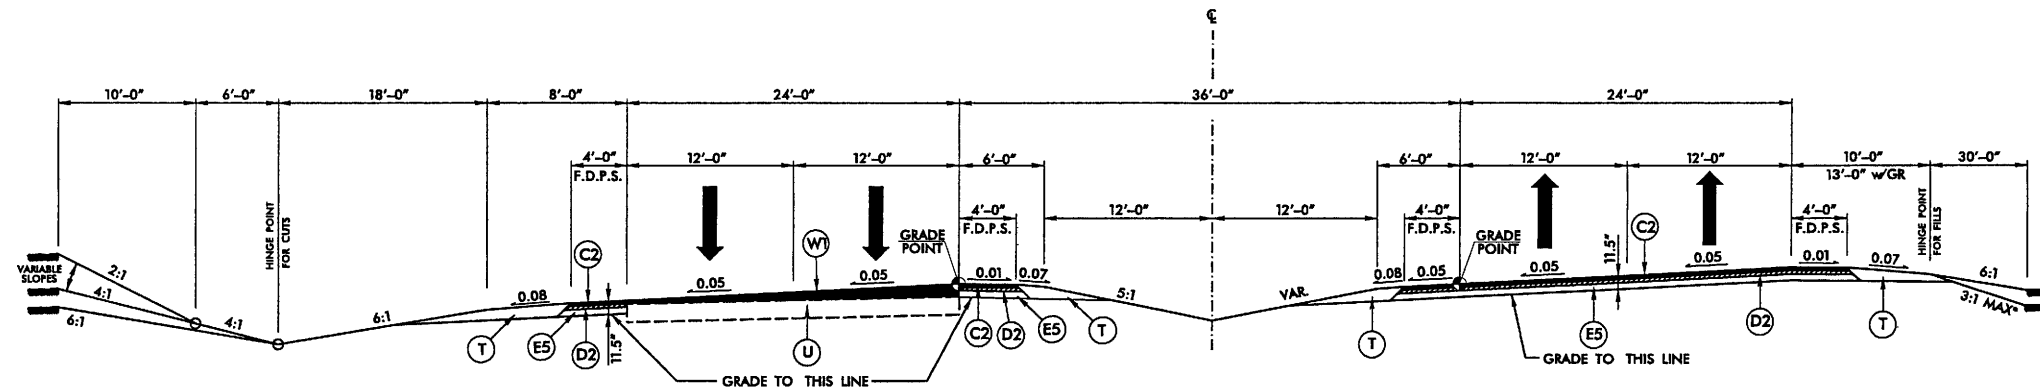


TYPICAL SECTION NO. 1

LINE TO FROM
 -L- 12+00.00 28+52.50
 USE MILLING TRANSITION DETAIL FOR STA. 12+00 TO 13+50


*ADD USABLE SHOULDER WIDTH WIDENING FOR FILL SLOPES STEEPER THAN 4:1.

PAVEMENT SCHEDULE


C1	PROP. 3.0" SURFACE COURSE, TYPE S9.5B
C2	PROP. 3.0" SURFACE COURSE, TYPE S9.5C
C3	PROP. VARIABLE DEPTH BASE COURSE, TYPE S9.5B
C4	PROP. VARIABLE DEPTH BASE COURSE, TYPE S9.5C
D1	PROP. 2.5" INTERMEDIATE COURSE, TYPE I19.0B
D2	PROP. 3.0" INTERMEDIATE COURSE, TYPE I19.0C
D3	PROP. 4.0" INTERMEDIATE COURSE, TYPE I19.0C
D4	PROP. VARIABLE DEPTH INTERMEDIATE COURSE, TYPE I19.0C
E1	PROP. 4.0" BASE COURSE, TYPE B25.0B
E2	PROP. 4.0" BASE COURSE, TYPE B25.0C
E3	PROP. 4.5" BASE COURSE, TYPE B25.0B
E4	PROP. 5.5" BASE COURSE, TYPE B25.0B
E5	PROP. 5.5" BASE COURSE, TYPE B25.0C
E6	PROP. VARIABLE DEPTH BASE COURSE, TYPE B25.0B
E7	PROP. VARIABLE DEPTH BASE COURSE, TYPE B25.0C
R1	2'-6" CONCRETE CURB AND GUTTER
T	EARTH MATERIAL.
U	EXISTING PAVEMENT.
V	MILLING EXISTING ASPHALT PAVEMENT, 0" TO 3" DEPTH.
W1	WEDGE (SEE STANDARD WEDGING DETAIL 1, THIS SHEET)
W2	WEDGE (SEE STANDARD WEDGING DETAIL 2, THIS SHEET)
W3	WEDGE (SEE STANDARD WEDGING DETAIL 3, THIS SHEET)

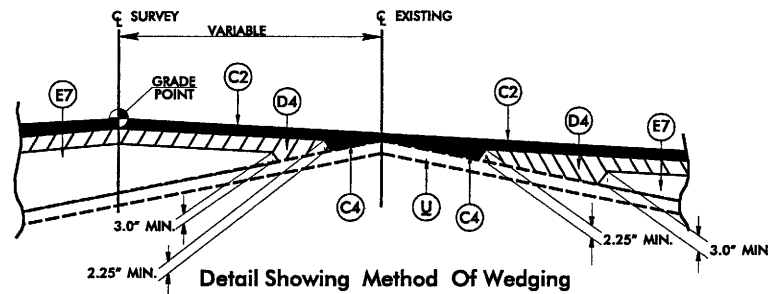


STANDARD WEDGING DETAIL 1

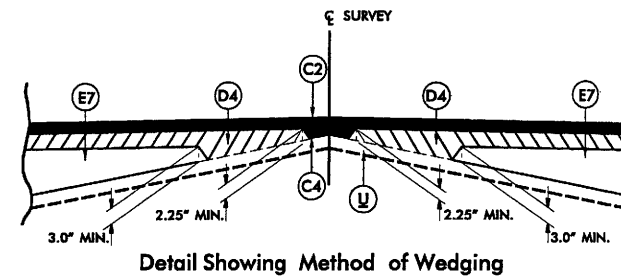


STANDARD WEDGING DETAIL 2

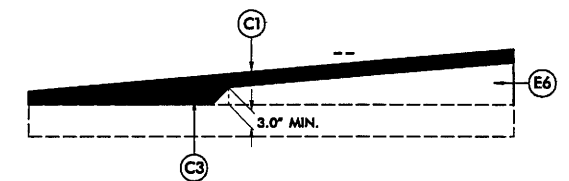

STANDARD WEDGING DETAIL 3

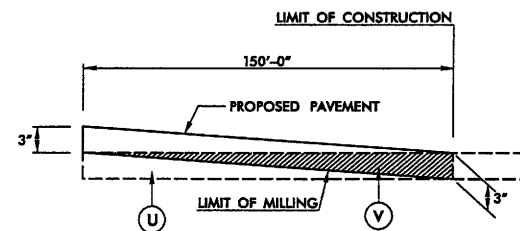

MILLING TRANSITION DETAIL

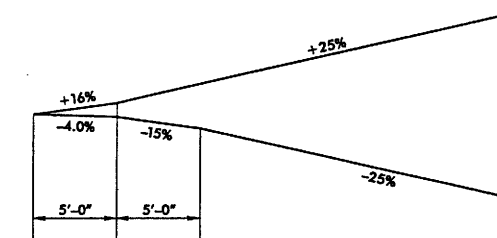


STANDARD DRIVEWAY PROFILE

7/15/2005 9:41:06 AM C:\R-2404A\PROJ\R2404A_rdy_typ.dgn


PAYEMENT SCHEDULE

C1	PROP. 3.0" SURFACE COURSE, TYPE S9.5B
C2	PROP. 3.0" SURFACE COURSE, TYPE S9.5C
C3	PROP. VARIABLE DEPTH BASE COURSE, TYPE S9.5B
C4	PROP. VARIABLE DEPTH BASE COURSE, TYPE S9.5C
D1	PROP. 2.5" INTERMEDIATE COURSE, TYPE I19.0B
D2	PROP. 3.0" INTERMEDIATE COURSE, TYPE I19.0C
D3	PROP. 4.0" INTERMEDIATE COURSE, TYPE I19.0C
D4	PROP. VARIABLE DEPTH INTERMEDIATE COURSE, TYPE I19.0C
E1	PROP. 4.0" BASE COURSE, TYPE B25.0B
E2	PROP. 4.0" BASE COURSE, TYPE B25.0C
E3	PROP. 4.5" BASE COURSE, TYPE B25.0B
E4	PROP. 5.5" BASE COURSE, TYPE B25.0B
E5	PROP. 5.5" BASE COURSE, TYPE B25.0C
E6	PROP. VARIABLE DEPTH BASE COURSE, TYPE B25.0B
E7	PROP. VARIABLE DEPTH BASE COURSE, TYPE B25.0C
R1	2'-6" CONCRETE CURB AND GUTTER
T	EARTH MATERIAL.
U	EXISTING PAVEMENT.
V	MILLING EXISTING ASPHALT PAVEMENT, 0" TO 3" DEPTH.
W1	WEDGE (SEE STANDARD WEDGING DETAIL 1, THIS SHEET)
W2	WEDGE (SEE STANDARD WEDGING DETAIL 2, THIS SHEET)
W3	WEDGE (SEE STANDARD WEDGING DETAIL 3, THIS SHEET)

*ADD USABLE SHOULDER WIDTH WIDENING FOR FILL SLOPES STEEPER THAN 4:1.


R-2404A	2-B
ROADWAY DESIGN ENGINEER	PAVEMENT DESIGN ENGINEER
PRELIMINARY PLANS DO NOT USE FOR CONSTRUCTION	
 HDR Engineering, Inc. of the Carolinas 3733 National Drive, Suite 207 Raleigh, N.C. 27612	

BARNHILL CONTRACTING COMPANY

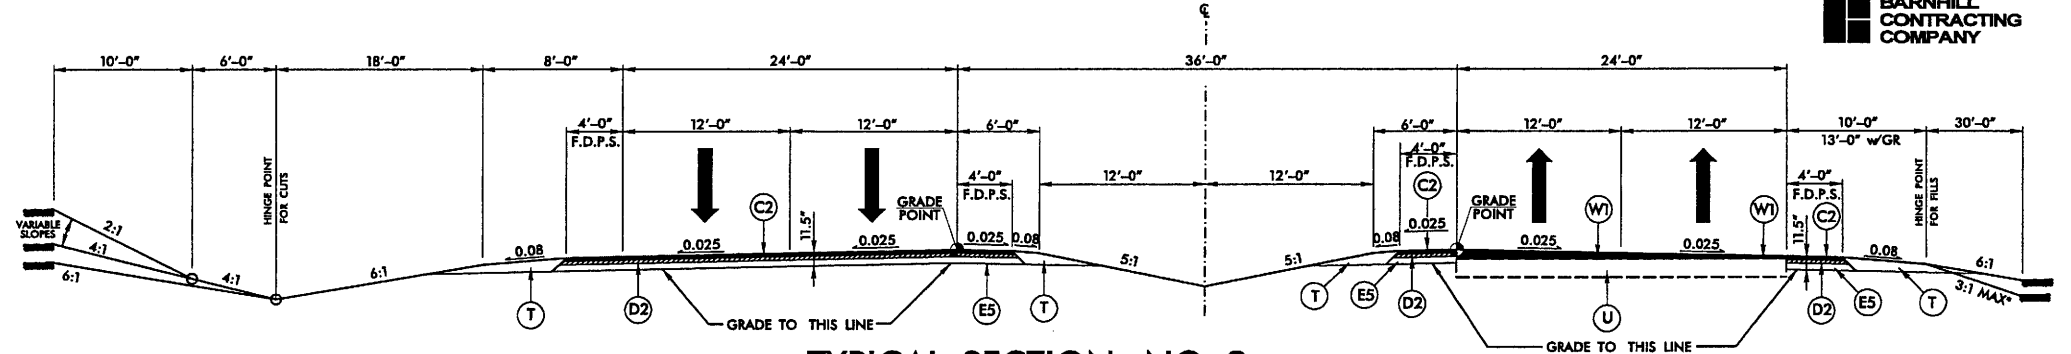


TYPICAL SECTION NO. 2

LINE FROM TO
-L- 28 + 52.50 86 + 40.00

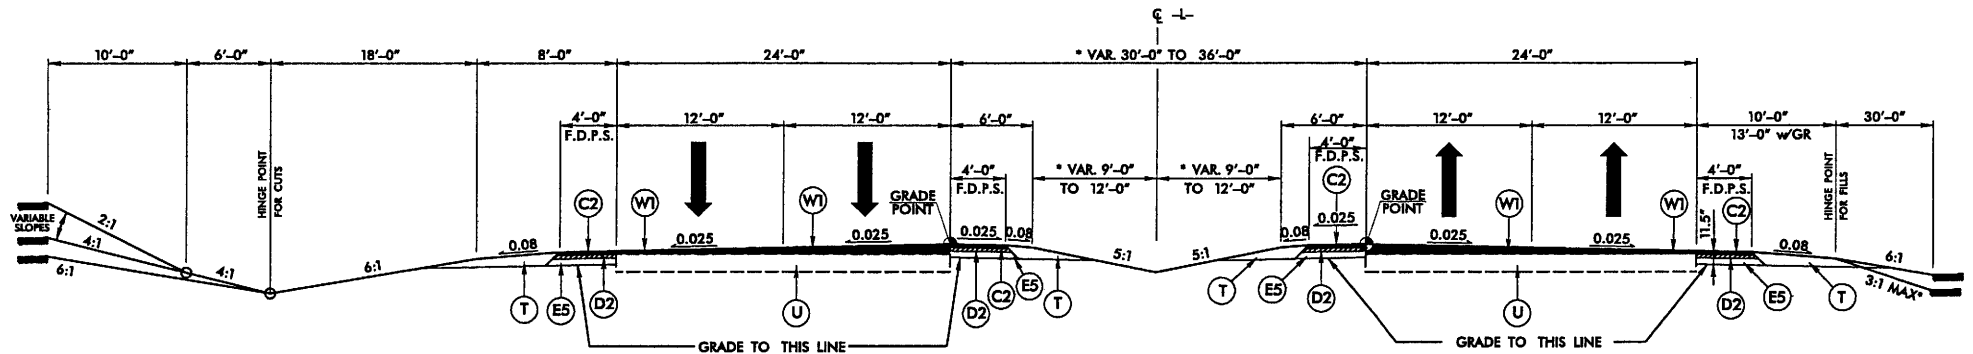

TYPICAL SECTION NO. 3


LINE FROM TO
-L- 86 + 40.00 119 + 40.00
* SEE PLANS FOR TRANSITION LOCATIONS

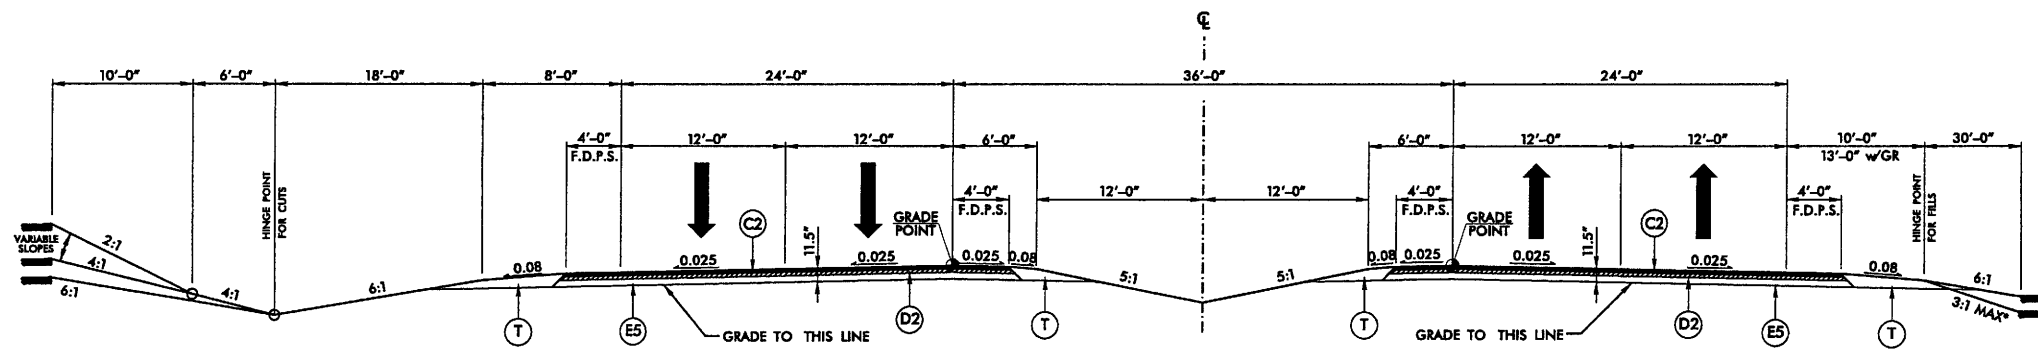

TYPICAL SECTION NO. 4


LINE FROM TO
-L- 119 + 40.00 139 + 00.00

7/15/2005 9:41:02 AM R:\R-2404A\PROJ\R2404A_rdy_typ.dgn

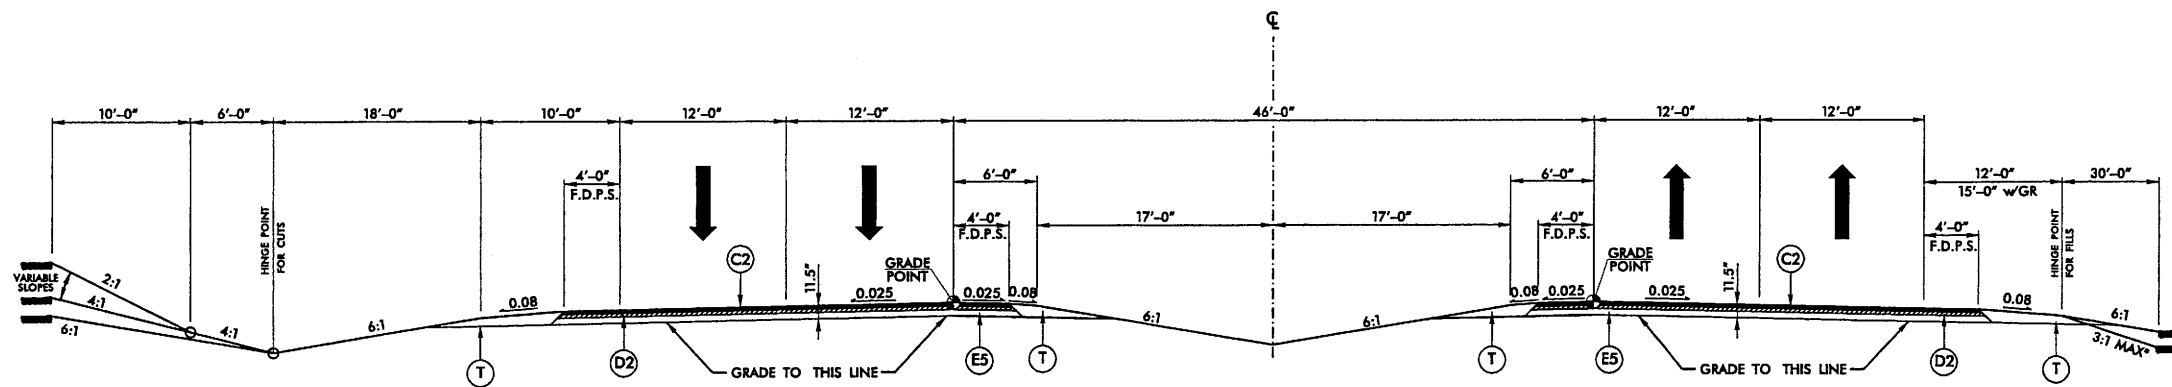


TYPICAL SECTION NO. 5

LINE FROM TO
 -L- 139+00.00 478+75.00

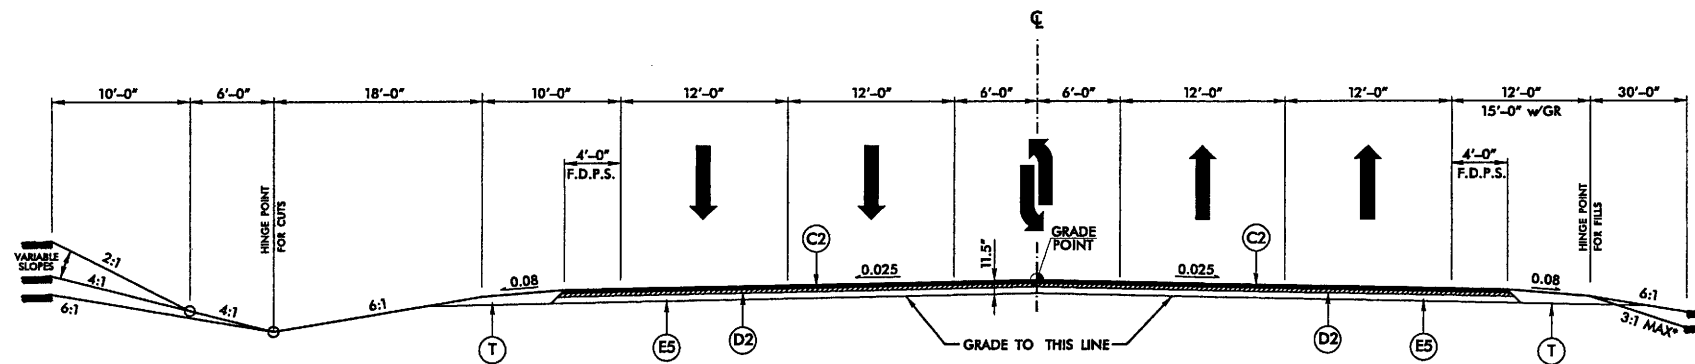

TYPICAL SECTION NO. 6

LINE FROM TO
 -L- 478+75.00 512+68.83

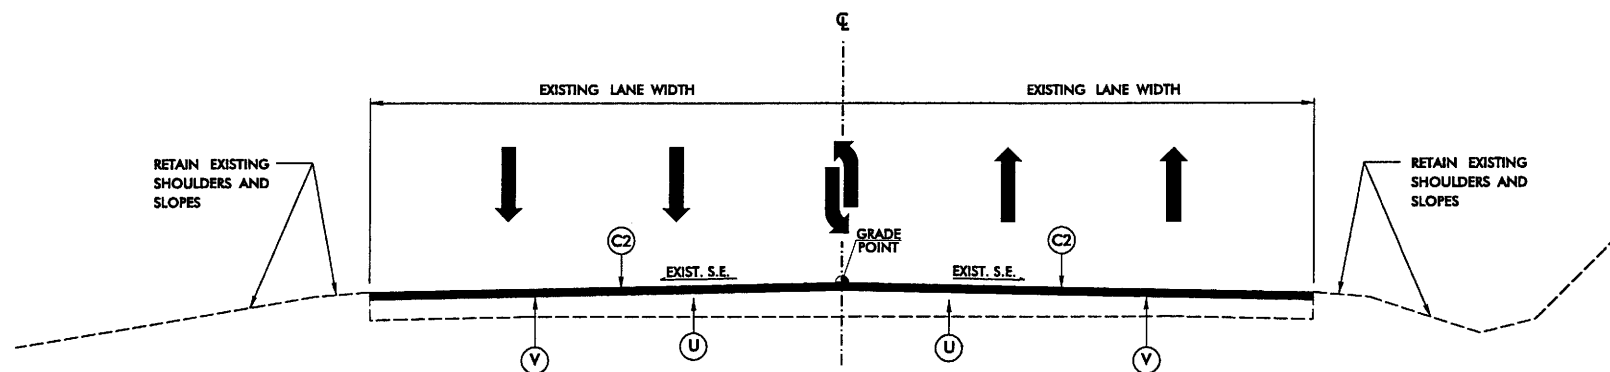

TYPICAL SECTION NO. 7

LINE FROM TO
 -L- 512+68.83 518+58.76

USE MILLING TRANSITION DETAIL FOR STA. 517+08.76 TO 518+58.76

*ADD USABLE SHOULDER WIDTH WIDENING FOR FILL SLOPES STEEPER THAN 4:1.

PAVEMENT SCHEDULE



C1	PROP. 3.0" SURFACE COURSE, TYPE S9.5B
C2	PROP. 3.0" SURFACE COURSE, TYPE S9.5C
C3	PROP. VARIABLE DEPTH BASE COURSE, TYPE S9.5B
C4	PROP. VARIABLE DEPTH BASE COURSE, TYPE S9.5C
D1	PROP. 2.5" INTERMEDIATE COURSE, TYPE I19.0B
D2	PROP. 3.0" INTERMEDIATE COURSE, TYPE I19.0C
D3	PROP. 4.0" INTERMEDIATE COURSE, TYPE I19.0C
D4	PROP. VARIABLE DEPTH INTERMEDIATE COURSE, TYPE I19.0C
E1	PROP. 4.0" BASE COURSE, TYPE B25.0B
E2	PROP. 4.0" BASE COURSE, TYPE B25.0C
E3	PROP. 4.5" BASE COURSE, TYPE B25.0B
E4	PROP. 5.5" BASE COURSE, TYPE B25.0B
E5	PROP. 5.5" BASE COURSE, TYPE B25.0C
E6	PROP. VARIABLE DEPTH BASE COURSE, TYPE B25.0B
E7	PROP. VARIABLE DEPTH BASE COURSE, TYPE B25.0C
R1	2'-6" CONCRETE CURB AND GUTTER
T	EARTH MATERIAL
U	EXISTING PAVEMENT.
V	MILLING EXISTING ASPHALT PAVEMENT, 0" TO 3" DEPTH.
W1	WEDGE (SEE STANDARD WEDGING DETAIL 1, THIS SHEET)
W2	WEDGE (SEE STANDARD WEDGING DETAIL 2, THIS SHEET)
W3	WEDGE (SEE STANDARD WEDGING DETAIL 3, THIS SHEET)


7/15/2005 9:40:56 AM
 C:\R-2404A\PROJ\R2404A_rdy_typ.dgn

PAYMENT SCHEDULE

C1	PROP. 3.0" SURFACE COURSE, TYPE S9.5B
C2	PROP. 3.0" SURFACE COURSE, TYPE S9.5C
C3	PROP. VARIABLE DEPTH BASE COURSE, TYPE S9.5B
C4	PROP. VARIABLE DEPTH BASE COURSE, TYPE S9.5C
D1	PROP. 2.5" INTERMEDIATE COURSE, TYPE I19.0B
D2	PROP. 3.0" INTERMEDIATE COURSE, TYPE I19.0C
D3	PROP. 4.0" INTERMEDIATE COURSE, TYPE I19.0C
D4	PROP. VARIABLE DEPTH INTERMEDIATE COURSE, TYPE I19.0C
E1	PROP. 4.0" BASE COURSE, TYPE B25.0B
E2	PROP. 4.0" BASE COURSE, TYPE B25.0C
E3	PROP. 4.5" BASE COURSE, TYPE B25.0B
E4	PROP. 5.5" BASE COURSE, TYPE B25.0B
E5	PROP. 5.5" BASE COURSE, TYPE B25.0C
E6	PROP. VARIABLE DEPTH BASE COURSE, TYPE B25.0B
E7	PROP. VARIABLE DEPTH BASE COURSE, TYPE B25.0C
R1	2'-6" CONCRETE CURB AND GUTTER
T	EARTH MATERIAL.
U	EXISTING PAVEMENT.
V	MILLING EXISTING ASPHALT PAVEMENT, 0" TO 3" DEPTH.
W1	WEDGE (SEE STANDARD WEDGING DETAIL 1, THIS SHEET)
W2	WEDGE (SEE STANDARD WEDGING DETAIL 2, THIS SHEET)
W3	WEDGE (SEE STANDARD WEDGING DETAIL 3, THIS SHEET)


*ADD USABLE SHOULDER WIDTH WIDENING FOR FILL SLOPES STEEPER THAN 4:1.

R-2404A		2-D	
RW SHEET NO.			
ROADWAY DESIGN ENGINEER	PAVEMENT DESIGN ENGINEER		
PRELIMINARY PLANS DO NOT USE FOR CONSTRUCTION			
 HDR Engineering, Inc. of the Carolinas 3733 National Drive, Suite 207 Raleigh, N.C. 27612			
 BARNHILL CONTRACTING COMPANY			

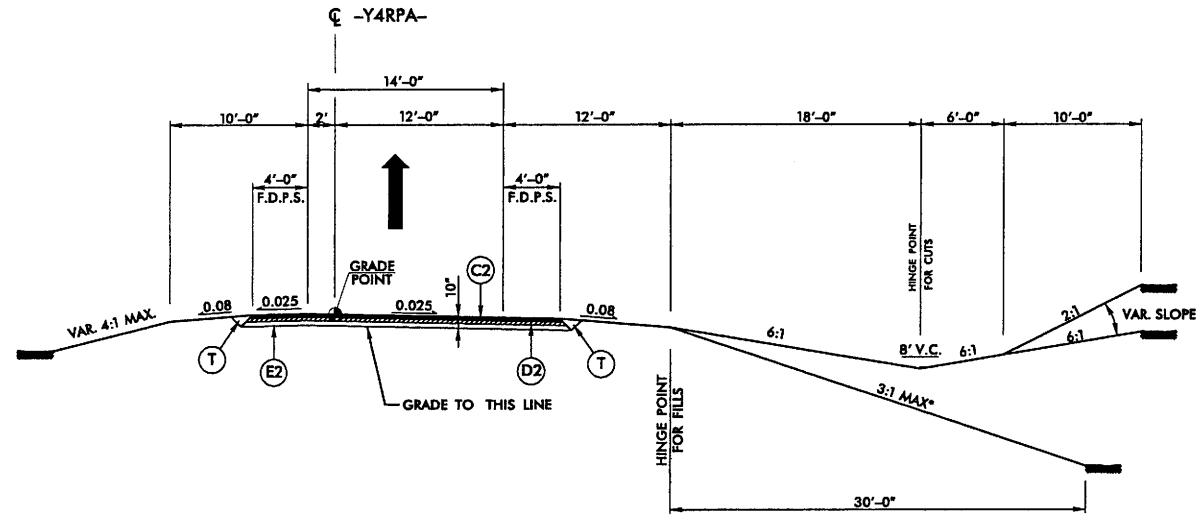


TYPICAL SECTION NO. 8

LINE	FROM	TO
-Y4RPA-	13+73.81	23+00.25

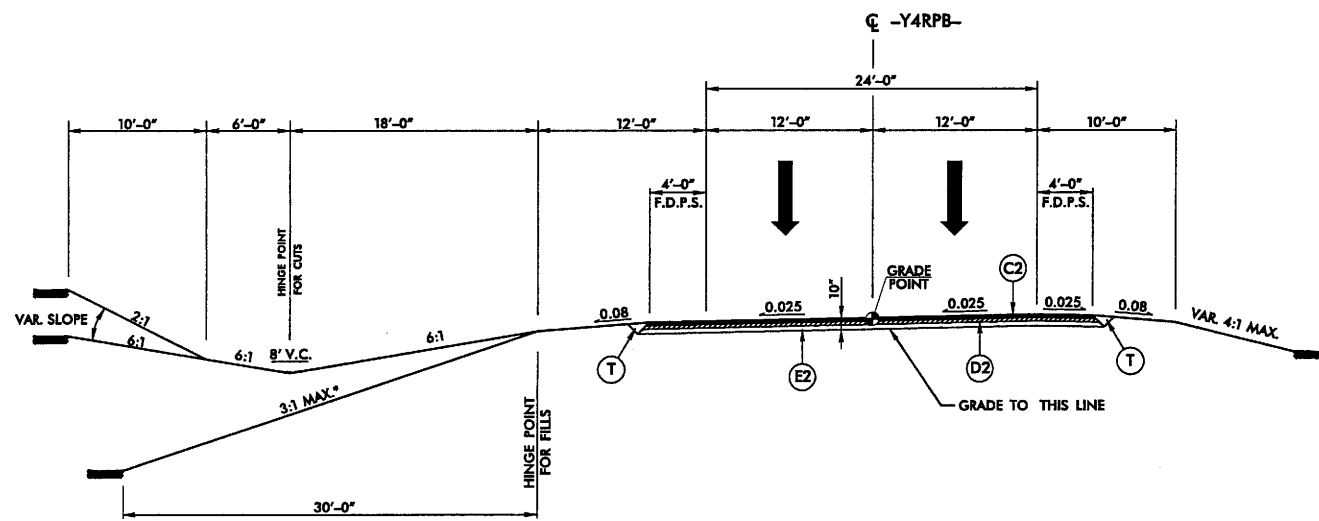

TYPICAL SECTION NO. 9

LINE	FROM	TO
-Y4RPB-	14+95.55	26+71.66

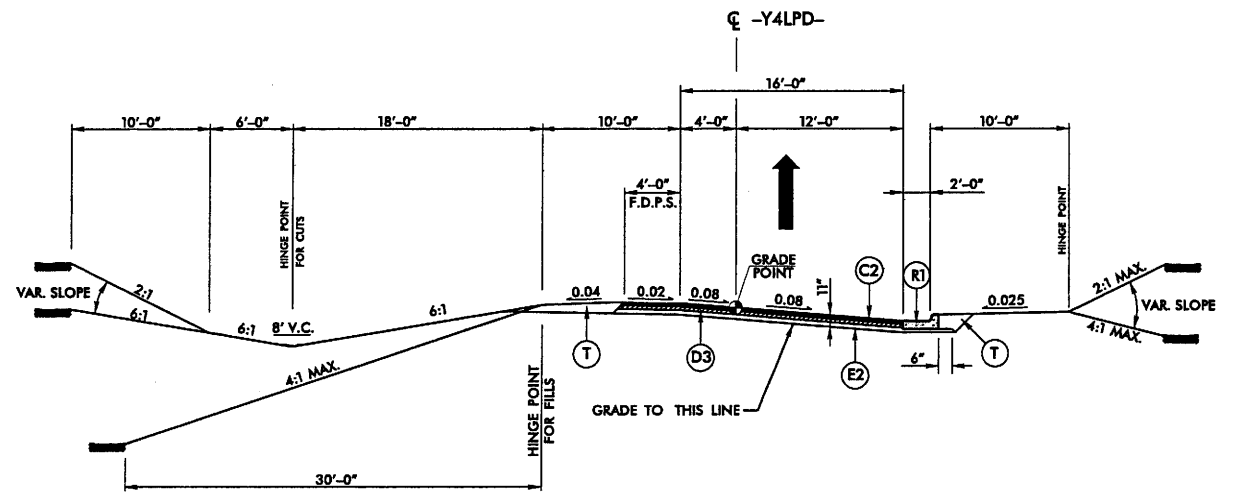

TYPICAL SECTION NO. 10

LINE	FROM	TO
-Y4LPD-	2+26.88	13+14.25

7/15/2005 9:40:50 AM
 G:\R-2404A\proj\2404A_rdy_typ.dgn

C1	PROP. 3.0" SURFACE COURSE, TYPE S9.5B
C2	PROP. 3.0" SURFACE COURSE, TYPE S9.5C
C3	PROP. VARIABLE DEPTH BASE COURSE, TYPE S9.5B
C4	PROP. VARIABLE DEPTH BASE COURSE, TYPE S9.5C
D1	PROP. 2.5" INTERMEDIATE COURSE, TYPE I19.0B
D2	PROP. 3.0" INTERMEDIATE COURSE, TYPE I19.0C
D3	PROP. 4.0" INTERMEDIATE COURSE, TYPE I19.0C
D4	PROP. VARIABLE DEPTH INTERMEDIATE COURSE, TYPE I19.0C
E1	PROP. 4.0" BASE COURSE, TYPE B25.0B
E2	PROP. 4.0" BASE COURSE, TYPE B25.0C
E3	PROP. 4.5" BASE COURSE, TYPE B25.0B
E4	PROP. 5.5" BASE COURSE, TYPE B25.0B
E5	PROP. 5.5" BASE COURSE, TYPE B25.0C
E6	PROP. VARIABLE DEPTH BASE COURSE, TYPE B25.0B
E7	PROP. VARIABLE DEPTH BASE COURSE, TYPE B25.0C
R1	2'-6" CONCRETE CURB AND GUTTER
T	EARTH MATERIAL.
U	EXISTING PAVEMENT.
V	MILLING EXISTING ASPHALT PAVEMENT, 0" TO 3" DEPTH.
W1	WEDGE (SEE STANDARD WEDGING DETAIL 1, THIS SHEET)
W2	WEDGE (SEE STANDARD WEDGING DETAIL 2, THIS SHEET)
W3	WEDGE (SEE STANDARD WEDGING DETAIL 3, THIS SHEET)

*ADD USABLE SHOULDER WIDTH WIDENING FOR FILL SLOPES STEEPER THAN 4:1.

R-2404A 2-E


RW SHEET NO.

ROADWAY DESIGN ENGINEER	PAVEMENT DESIGN ENGINEER
-------------------------	--------------------------

PRELIMINARY PLANS
DO NOT USE FOR CONSTRUCTION


HDR Engineering, Inc.
of the Carolinas
3733 National Drive, Suite 207
Raleigh, N.C. 27612

BARNHILL CONTRACTING COMPANY

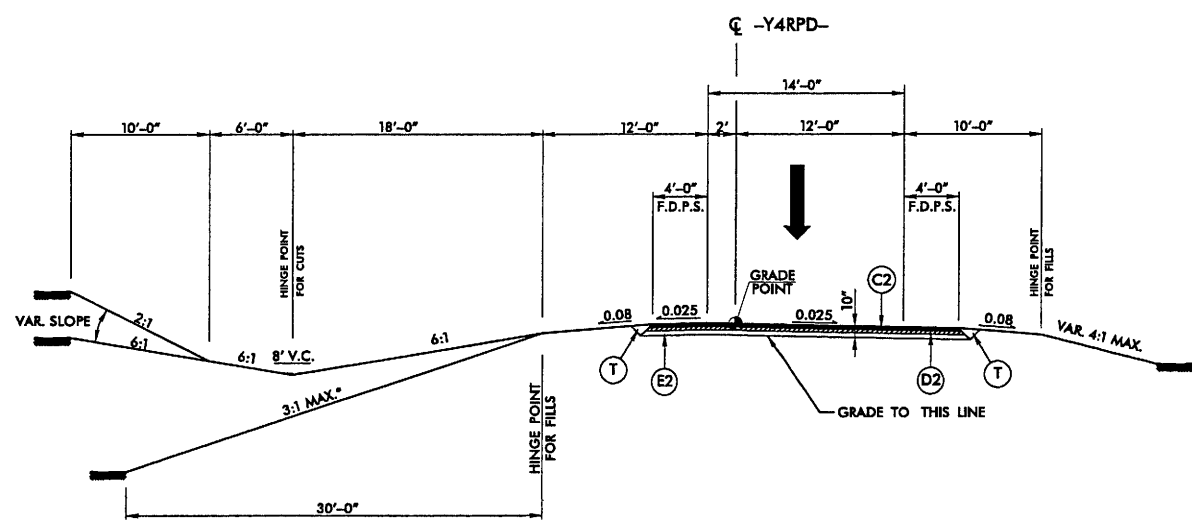


TYPICAL SECTION NO. 11

LINE	FROM	TO
-Y4RPD-	12 + 85.21	28 + 72.60

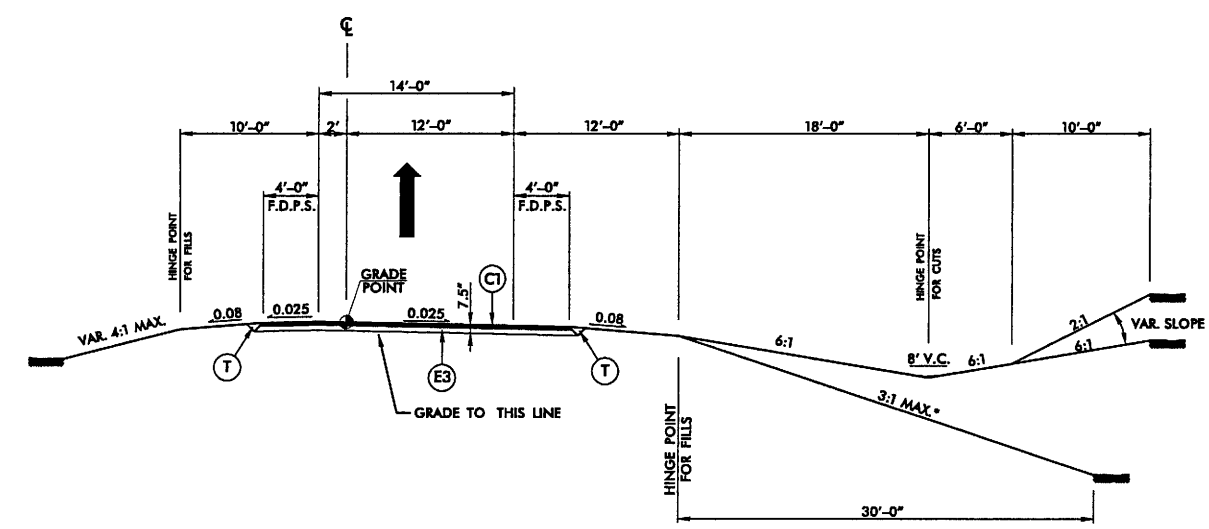

TYPICAL SECTION NO. 12

LINE	FROM	TO
-Y6RPA-	12 + 99.94	27 + 60.66
-Y6RPC-	14 + 56.28	27 + 92.53

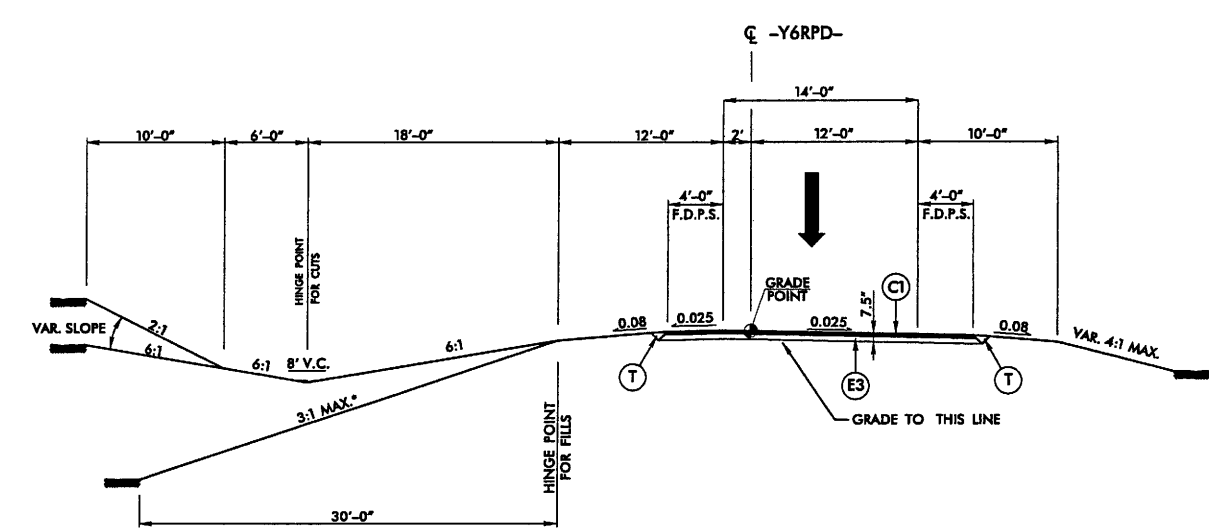


TYPICAL SECTION NO. 13

LINE	FROM	TO
-Y6RPD-	14 + 48.62	30 + 67.61

7/15/2005 9:40:37 AM G:\R-2404A\proj\R2404A_rdy_typ.dgn


C1	PROP. 3.0" SURFACE COURSE, TYPE S9.5B
C2	PROP. 3.0" SURFACE COURSE, TYPE S9.5C
C3	PROP. VARIABLE DEPTH BASE COURSE, TYPE S9.5B
C4	PROP. VARIABLE DEPTH BASE COURSE, TYPE S9.5C
D1	PROP. 2.5" INTERMEDIATE COURSE, TYPE I19.0B
D2	PROP. 3.0" INTERMEDIATE COURSE, TYPE I19.0C
D3	PROP. 4.0" INTERMEDIATE COURSE, TYPE I19.0C
D4	PROP. VARIABLE DEPTH INTERMEDIATE COURSE, TYPE I19.0C
E1	PROP. 4.0" BASE COURSE, TYPE B25.0B
E2	PROP. 4.0" BASE COURSE, TYPE B25.0C
E3	PROP. 4.5" BASE COURSE, TYPE B25.0B
E4	PROP. 5.5" BASE COURSE, TYPE B25.0B
E5	PROP. 5.5" BASE COURSE, TYPE B25.0C
E6	PROP. VARIABLE DEPTH BASE COURSE, TYPE B25.0B
E7	PROP. VARIABLE DEPTH BASE COURSE, TYPE B25.0C
R1	2'-6" CONCRETE CURB AND GUTTER
T	EARTH MATERIAL.
U	EXISTING PAVEMENT.
V	MILLING EXISTING ASPHALT PAVEMENT, 0" TO 3" DEPTH.
W1	WEDGE (SEE STANDARD WEDGING DETAIL 1, THIS SHEET)
W2	WEDGE (SEE STANDARD WEDGING DETAIL 2, THIS SHEET)
W3	WEDGE (SEE STANDARD WEDGING DETAIL 3, THIS SHEET)

*ADD USABLE SHOULDER WIDTH WIDENING FOR FILL SLOPES STEEPER THAN 4:1.

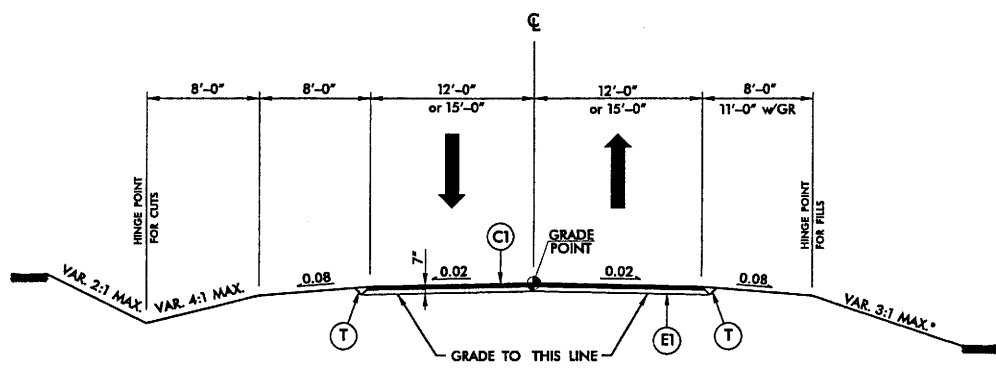


TYPICAL SECTION NO. 16

LINE	FROM	TO
-Y1A-	10 + 12.39	12 + 35.31
-SR1-	10 + 18.09	16 + 45.00
-SR2-	10 + 00.00	25 + 42.72

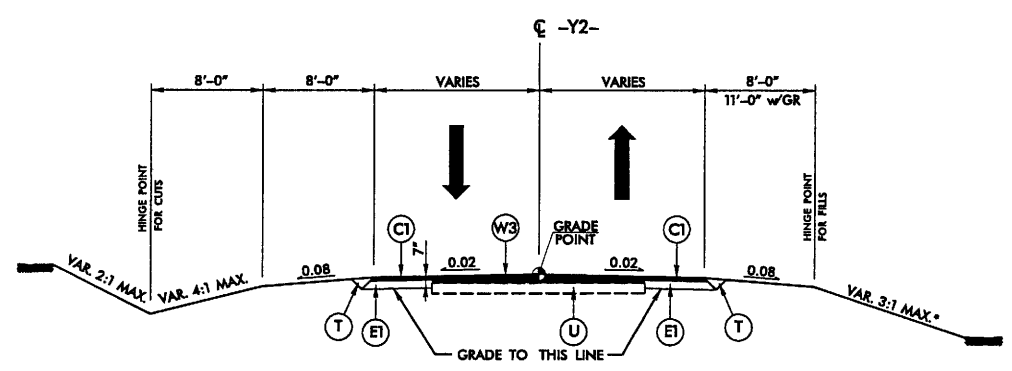

TYPICAL SECTION NO. 17

LINE	FROM	TO
-Y2-	15 + 77.84	17 + 43.29
-Y2-	18 + 28.65	20 + 00.00

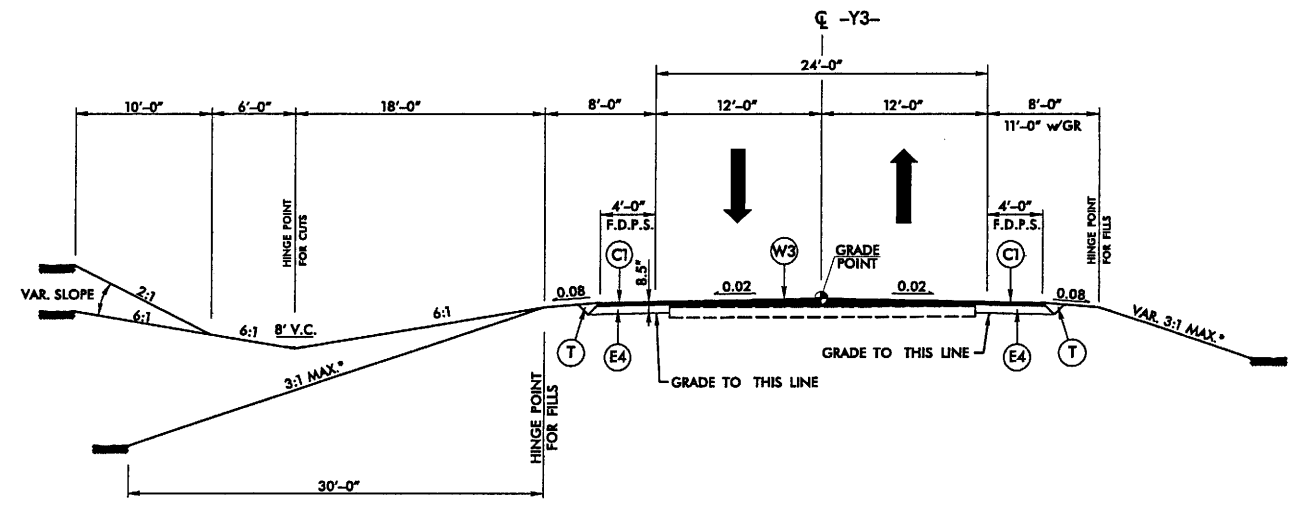


TYPICAL SECTION NO. 18

LINE	FROM	TO
-Y3-	11 + 16.81	19 + 05.49
-Y3-	19 + 83.58	24 + 65.75

7/15/2005 9:40:03 AM R:\R-2404A\proj\R2404A_rdy_typ.dgn


C1	PROP. 3.0" SURFACE COURSE, TYPE S9.5B
C2	PROP. 3.0" SURFACE COURSE, TYPE S9.5C
C3	PROP. VARIABLE DEPTH BASE COURSE, TYPE S9.5B
C4	PROP. VARIABLE DEPTH BASE COURSE, TYPE S9.5C
D1	PROP. 2.5" INTERMEDIATE COURSE, TYPE I19.0B
D2	PROP. 3.0" INTERMEDIATE COURSE, TYPE I19.0C
D3	PROP. 4.0" INTERMEDIATE COURSE, TYPE I19.0C
D4	PROP. VARIABLE DEPTH INTERMEDIATE COURSE, TYPE I19.0C
E1	PROP. 4.0" BASE COURSE, TYPE B25.0B
E2	PROP. 4.0" BASE COURSE, TYPE B25.0C
E3	PROP. 4.5" BASE COURSE, TYPE B25.0B
E4	PROP. 5.5" BASE COURSE, TYPE B25.0B
E5	PROP. 5.5" BASE COURSE, TYPE B25.0C
E6	PROP. VARIABLE DEPTH BASE COURSE, TYPE B25.0B
E7	PROP. VARIABLE DEPTH BASE COURSE, TYPE B25.0C
R1	2'-6" CONCRETE CURB AND GUTTER
T	EARTH MATERIAL.
U	EXISTING PAVEMENT.
V	MILLING EXISTING ASPHALT PAVEMENT, 0" TO 3" DEPTH.
W1	WEDGE (SEE STANDARD WEDGING DETAIL 1, THIS SHEET)
W2	WEDGE (SEE STANDARD WEDGING DETAIL 2, THIS SHEET)
W3	WEDGE (SEE STANDARD WEDGING DETAIL 3, THIS SHEET)

*ADD USABLE SHOULDER WIDTH WIDENING FOR FILL SLOPES STEEPER THAN 4:1.

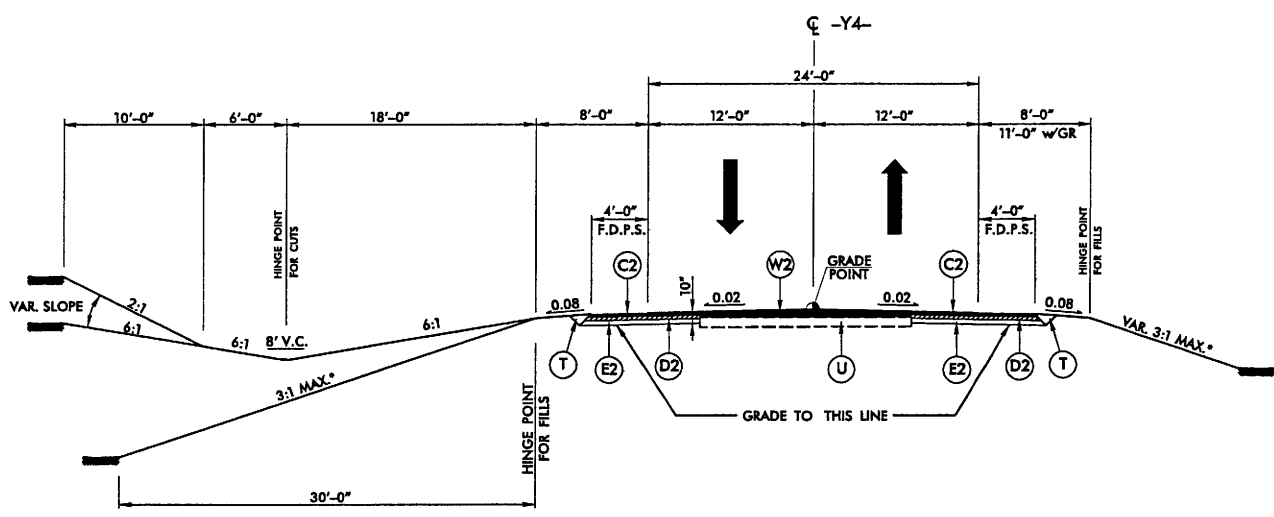


TYPICAL SECTION NO. 19

LINE	FROM	TO
-Y4-	20+00.00	39+43.51

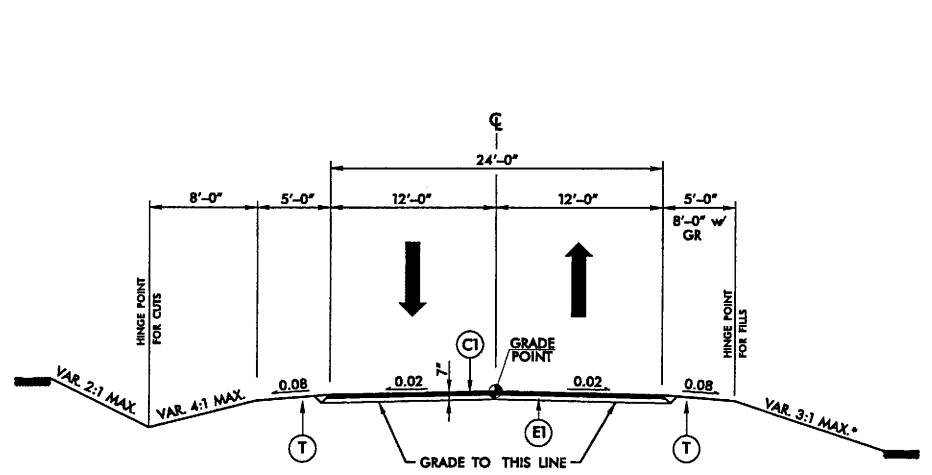

TYPICAL SECTION NO. 20

LINE	FROM	TO
-Y5-	11+00.00	57+66.18

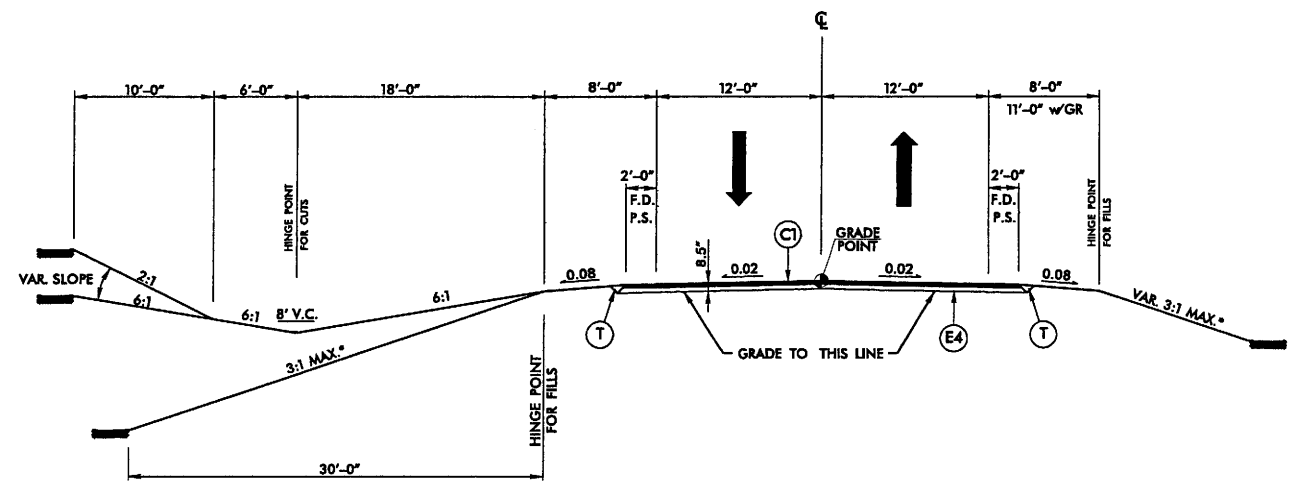


TYPICAL SECTION NO. 21

LINE	FROM	TO
-Y6-	16+00.00	45+00.00

7/15/2005 9:39:51 AM G:\R-2404A\proj\R2404A_rdy_typ.dgn


C1	PROP. 3.0" SURFACE COURSE, TYPE S9.5B
C2	PROP. 3.0" SURFACE COURSE, TYPE S9.5C
C3	PROP. VARIABLE DEPTH BASE COURSE, TYPE S9.5B
C4	PROP. VARIABLE DEPTH BASE COURSE, TYPE S9.5C
D1	PROP. 2.5" INTERMEDIATE COURSE, TYPE I19.0B
D2	PROP. 3.0" INTERMEDIATE COURSE, TYPE I19.0C
D3	PROP. 4.0" INTERMEDIATE COURSE, TYPE I19.0C
D4	PROP. VARIABLE DEPTH INTERMEDIATE COURSE, TYPE I19.0C
E1	PROP. 4.0" BASE COURSE, TYPE B25.0B
E2	PROP. 4.0" BASE COURSE, TYPE B25.0C
E3	PROP. 4.5" BASE COURSE, TYPE B25.0B
E4	PROP. 5.5" BASE COURSE, TYPE B25.0B
E5	PROP. 5.5" BASE COURSE, TYPE B25.0C
E6	PROP. VARIABLE DEPTH BASE COURSE, TYPE B25.0B
E7	PROP. VARIABLE DEPTH BASE COURSE, TYPE B25.0C
R1	2'-6" CONCRETE CURB AND GUTTER
T	EARTH MATERIAL.
U	EXISTING PAVEMENT.
V	MILLING EXISTING ASPHALT PAVEMENT, 0" TO 3" DEPTH.
W1	WEDGE (SEE STANDARD WEDGING DETAIL 1, THIS SHEET)
W2	WEDGE (SEE STANDARD WEDGING DETAIL 2, THIS SHEET)
W3	WEDGE (SEE STANDARD WEDGING DETAIL 3, THIS SHEET)

*ADD USABLE SHOULDER WIDTH WIDENING FOR FILL SLOPES STEEPER THAN 4:1.

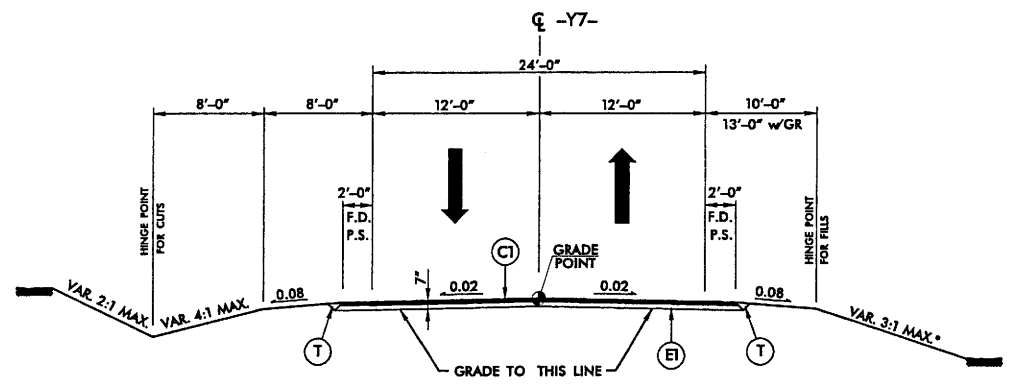


TYPICAL SECTION NO. 22

LINE	FROM	TO
-Y7-	10+30.00	16+92.40

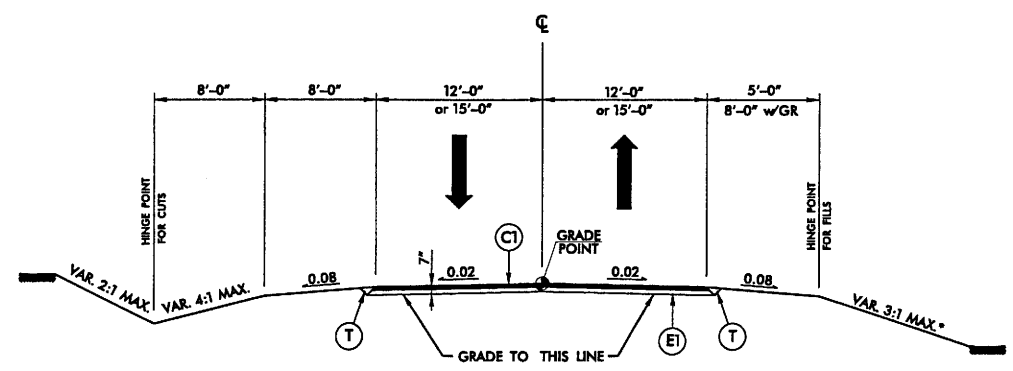

TYPICAL SECTION NO. 23


LINE	FROM	TO
-SR1-	10+18.09	16+45.00
-SR2-	10+00.00	25+42.72

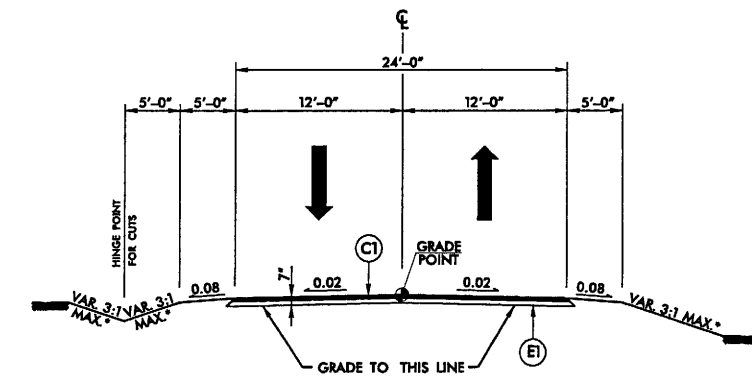


TYPICAL SECTION NO. 24

LINE	FROM	TO
-Y5DET-	10+00.00	30+07.67
-Y6DET-	10+00.00	50+79.11


7/15/2005 9:39:09 AM
 r:\R-2404A\proj\R2404A_rdy_typ.dgn

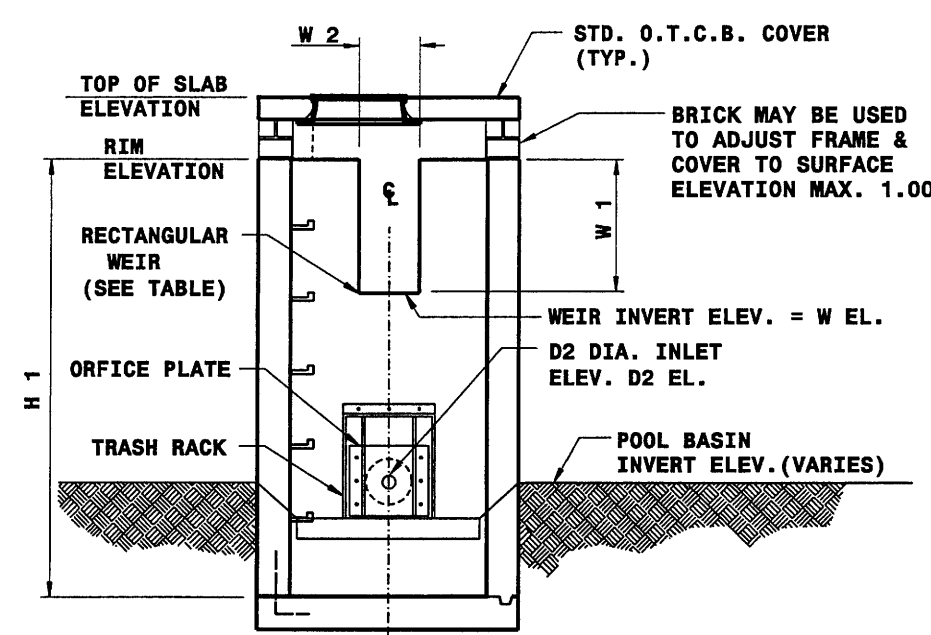


ELEVATION OF STRUCTURE
SIDE 1

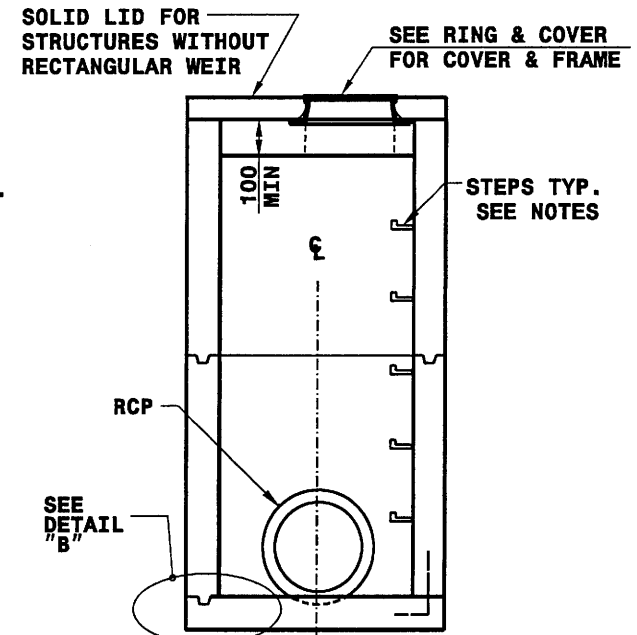

ELEVATION OF STRUCTURE
SIDE 2

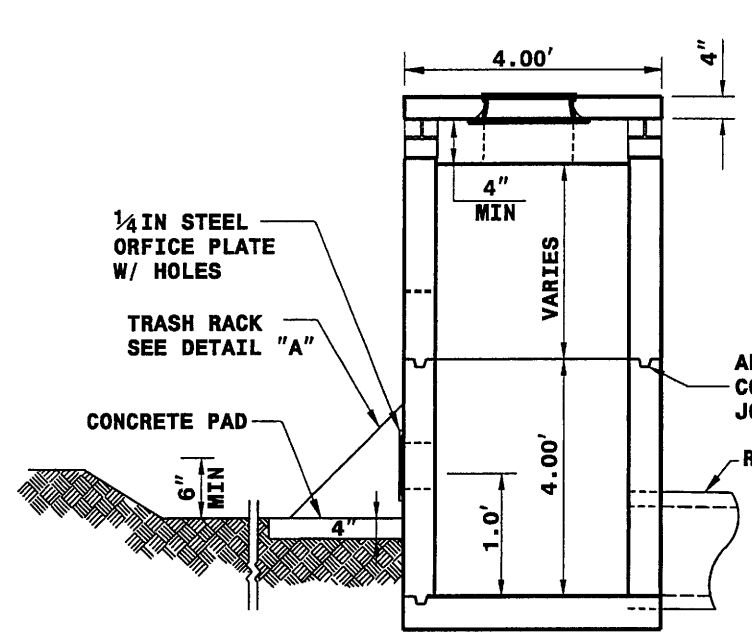


ELEVATION OF STRUCTURE
SIDE 3

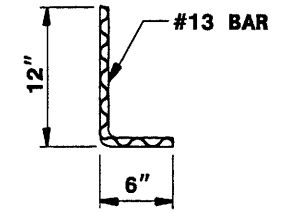


DOWEL

MINIMUM DIMENSIONS FOR DRY DETENTION BASIN DRAWDOWN STRUCTURE													
QUANTITIES FOR CONCRETE DETERMINED FROM NCDOT STANDARD 840.04													
STATION	PIPE D	OUTLET BOX PIPE INVERT	BOX PIPE HEIGHT H1	RIM ELEVATION	TOP OF SLAB ELEV.	REMARKS	WEIR DIMENSIONS			DRAWDOWN ORFICE		POOL BASIN INVERT INV. EL.	
							W1	W2	W EL	D2	NO. OF HOLES		D2 EL
-Y4LPD-	18"	8.00	4.00	12.00	8.50	OTCB	0.50'	2.00'	11.50	3"	1	9.00	9.00

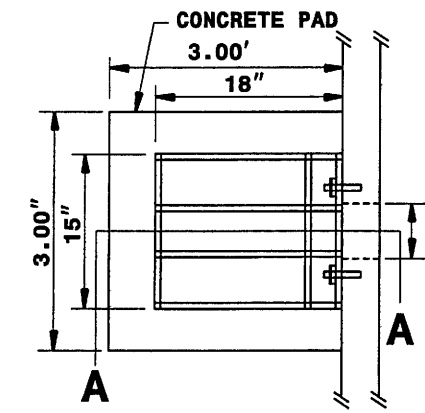

PLAN VIEW

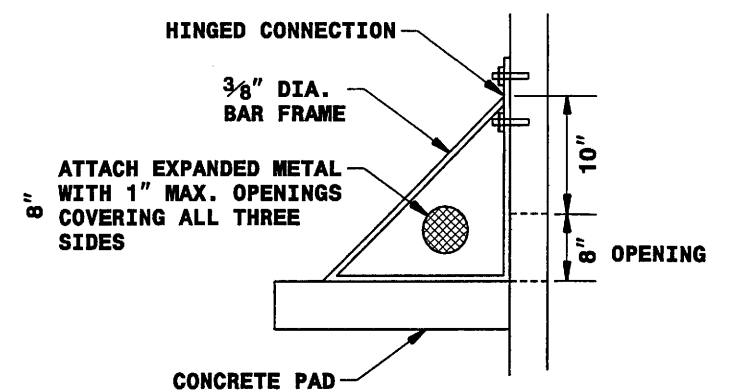


SECTION A-A


DETAIL A - EXTENDED DETENTION TRASH RACK

GENERAL NOTES:


- * CLASS 'B' CONCRETE TO BE USED THROUGHOUT. PRECAST CONCRETE STRUCTURES TO BE SUBMITTED FOR APPROVAL.
- * OPTIONAL CONSTRUCTION - MONOLITHIC POUR, 2" KEYWAY, OR #13 BAR DOWELS AT 12" CENTERS, AS DIRECTED BY ENGINEER.
- * FORMS ARE TO BE USED FOR THE CONSTRUCTION OF THE BOTTOM SLAB.
- * IF REINFORCED CONCRETE PIPE IS SET IN BASE SLAB OF BOX, ADD TO BASE AS SHOWN ON STANDARD 840.00.
- * ALL DRAWDOWN STRUCTURES OVER 3' IN DEPTH TO BE PROVIDED WITH STEPS 14" ON CENTERS. STEPS SHALL BE INSTALLED IN ACCORDANCE WITH STANDARD 840.66.
- * FOR 8.0' IN HEIGHT OR LESS USE 6" WALLS AND BOTTOM SLAB. OVER 8.0' TO 16.0' IN HEIGHT USE 8" WALLS AND BOTTOM SLAB. ADJUST QUANTITIES ACCORDINGLY.

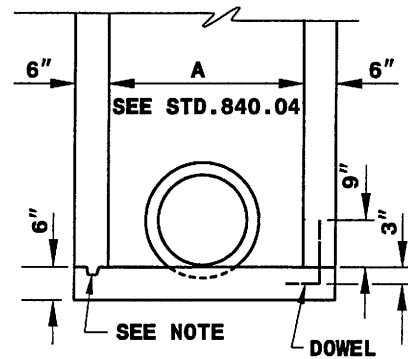


DETAIL 'B'

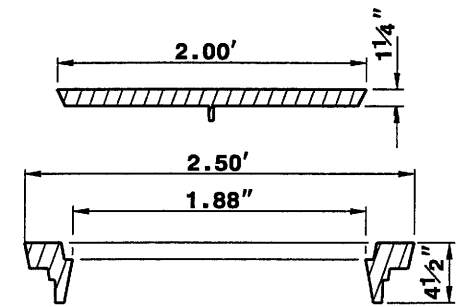

RING & COVER

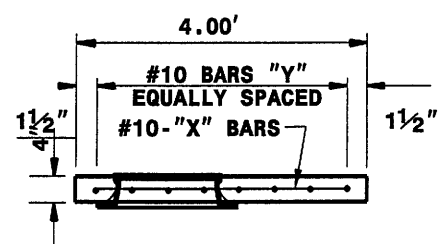

TOP SLAB

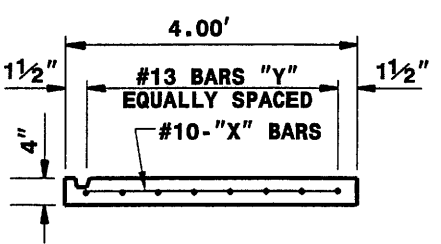


BOTTOM SLAB

REVISIONS

2 20'(B) Sta. 17+90 FT
D.A. = 5.22 AC
Grade E.H. = 28.41 ft
Depth = 3.0


1 20'(B) Sta. 17+90 M
D.A. = 1.14 AC
Grade E.H. = 28.67 ft
Depth = 3.0

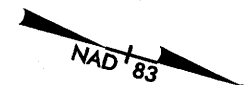

PI = 22+06.75
Δ = 29° 08' 08.4" (LT)
Dc = 7' 54" 35.5"
Cs = 7' 54" 35.5"
Ls = 200.00'
Ts = 879.78'
Lc = 1,325.54'
Rc = 3,000.00'
LT = 133.34'
ST = 66.67'
e = 0.05
DS = 60 mph

PROJECT REFERENCE NO. R-2404A	SHEET NO. 4
RW SHEET NO.	
ROADWAY DESIGN ENGINEER	HYDRAULICS ENGINEER
PRELIMINARY PLANS DO NOT USE FOR CONSTRUCTION	
 HDR Engineering, Inc. of the Carolinas 3733 National Drive, Suite 207 Raleigh, N.C. 27612	
 BARNHILL CONTRACTING COMPANY	

LAVERNE B. JENKINS
DB 410 PG 391
DB 680 PG 35

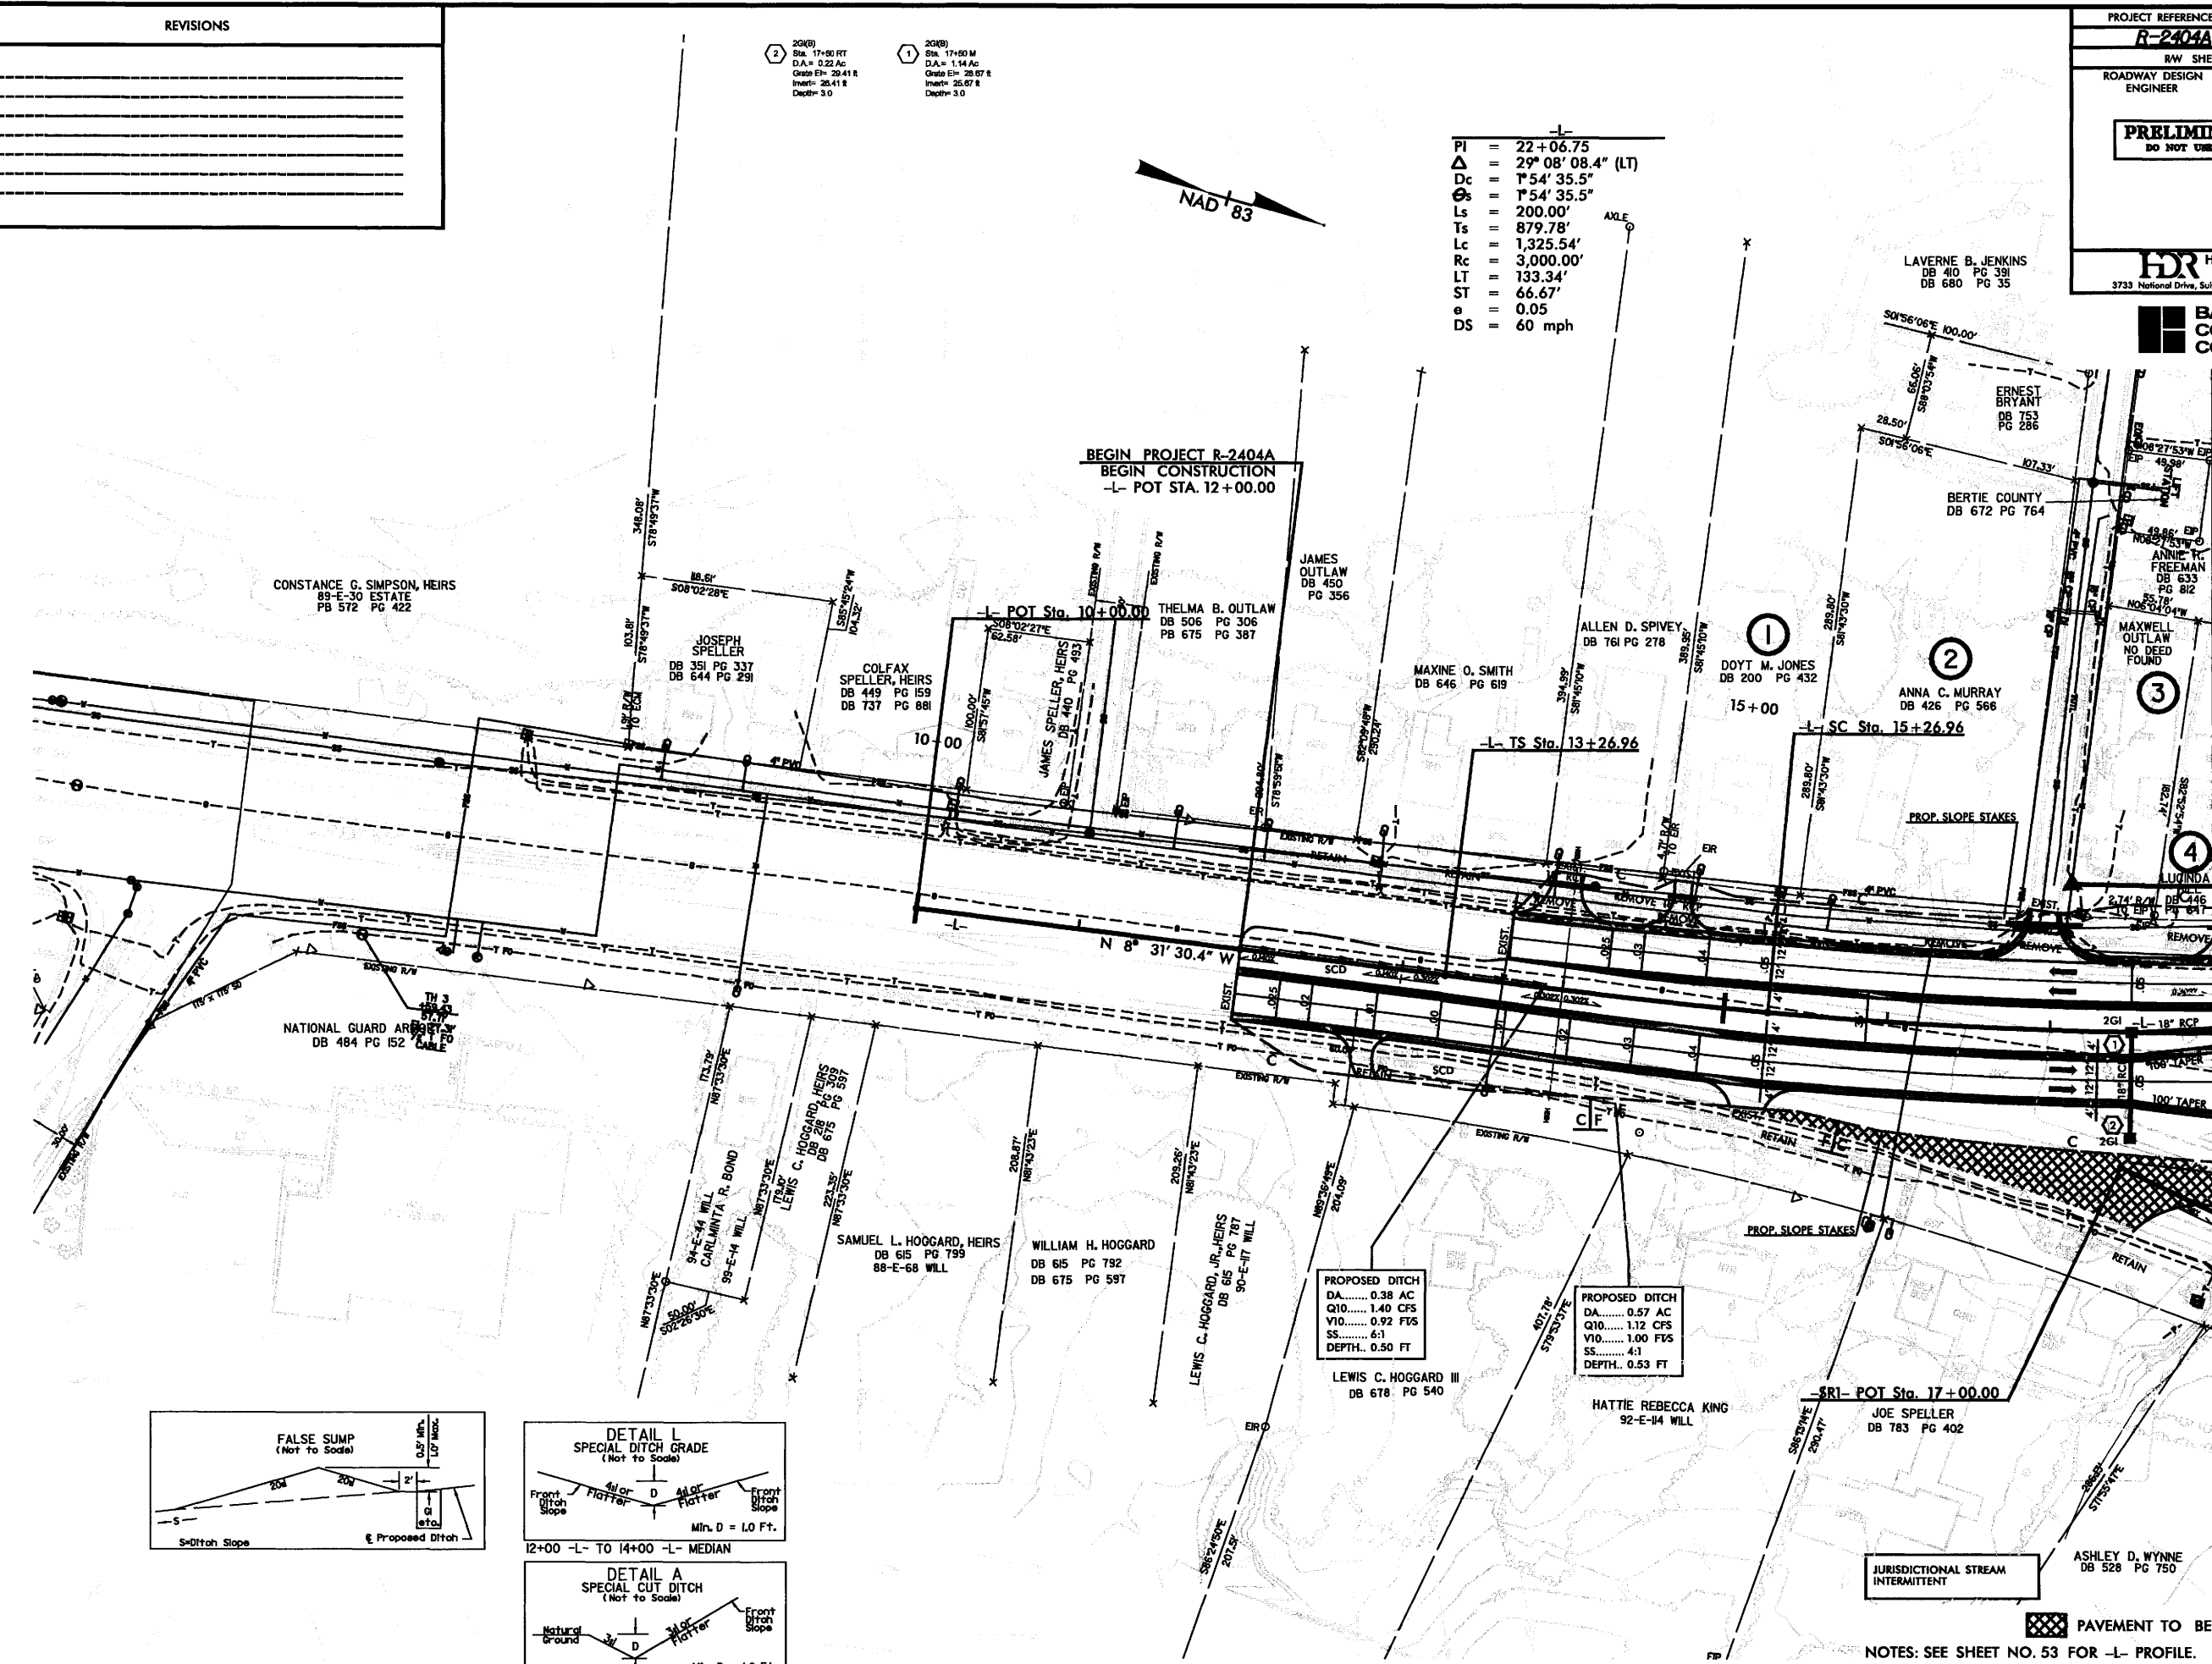

BEGIN PROJECT R-2404A
BEGIN CONSTRUCTION
-L- POT STA. 12+00.00




-L- POT Sta. 10+00.00

-L- TS Sta. 13+26.96

-L- SC Sta. 15+26.96

-SRI- POT Sta. 17+00.00

MATCH LINE STA. 18+00 -L- SEE SHEET NO. 5

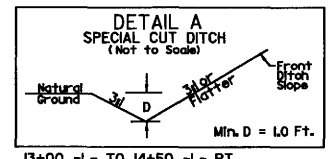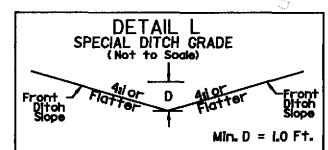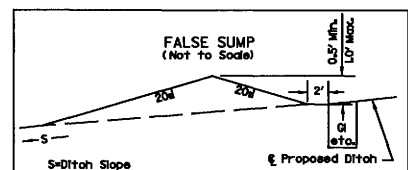



PROPOSED DITCH
DA..... 0.38 AC
Q10..... 1.40 CFS
V10..... 0.92 FFS
SS..... 6:1
DEPTH. 0.50 FT

PROPOSED DITCH
DA..... 0.57 AC
Q10..... 1.12 CFS
V10..... 1.00 FFS
SS..... 4:1
DEPTH. 0.53 FT

PAVEMENT TO BE OBLITERATED

NOTES: SEE SHEET NO. 53 FOR -L- PROFILE.
ALL DRIVEWAY RADII ARE 20' UNLESS OTHERWISE NOTED.
DO NOT PLACE ROCK IN BED OF JURISDICTIONAL STREAMS.

8/1/2005 10:29:13 AM 404a\hydro\Redline_plansheets\R2404A_hyl_Redline_psh_04.dgn

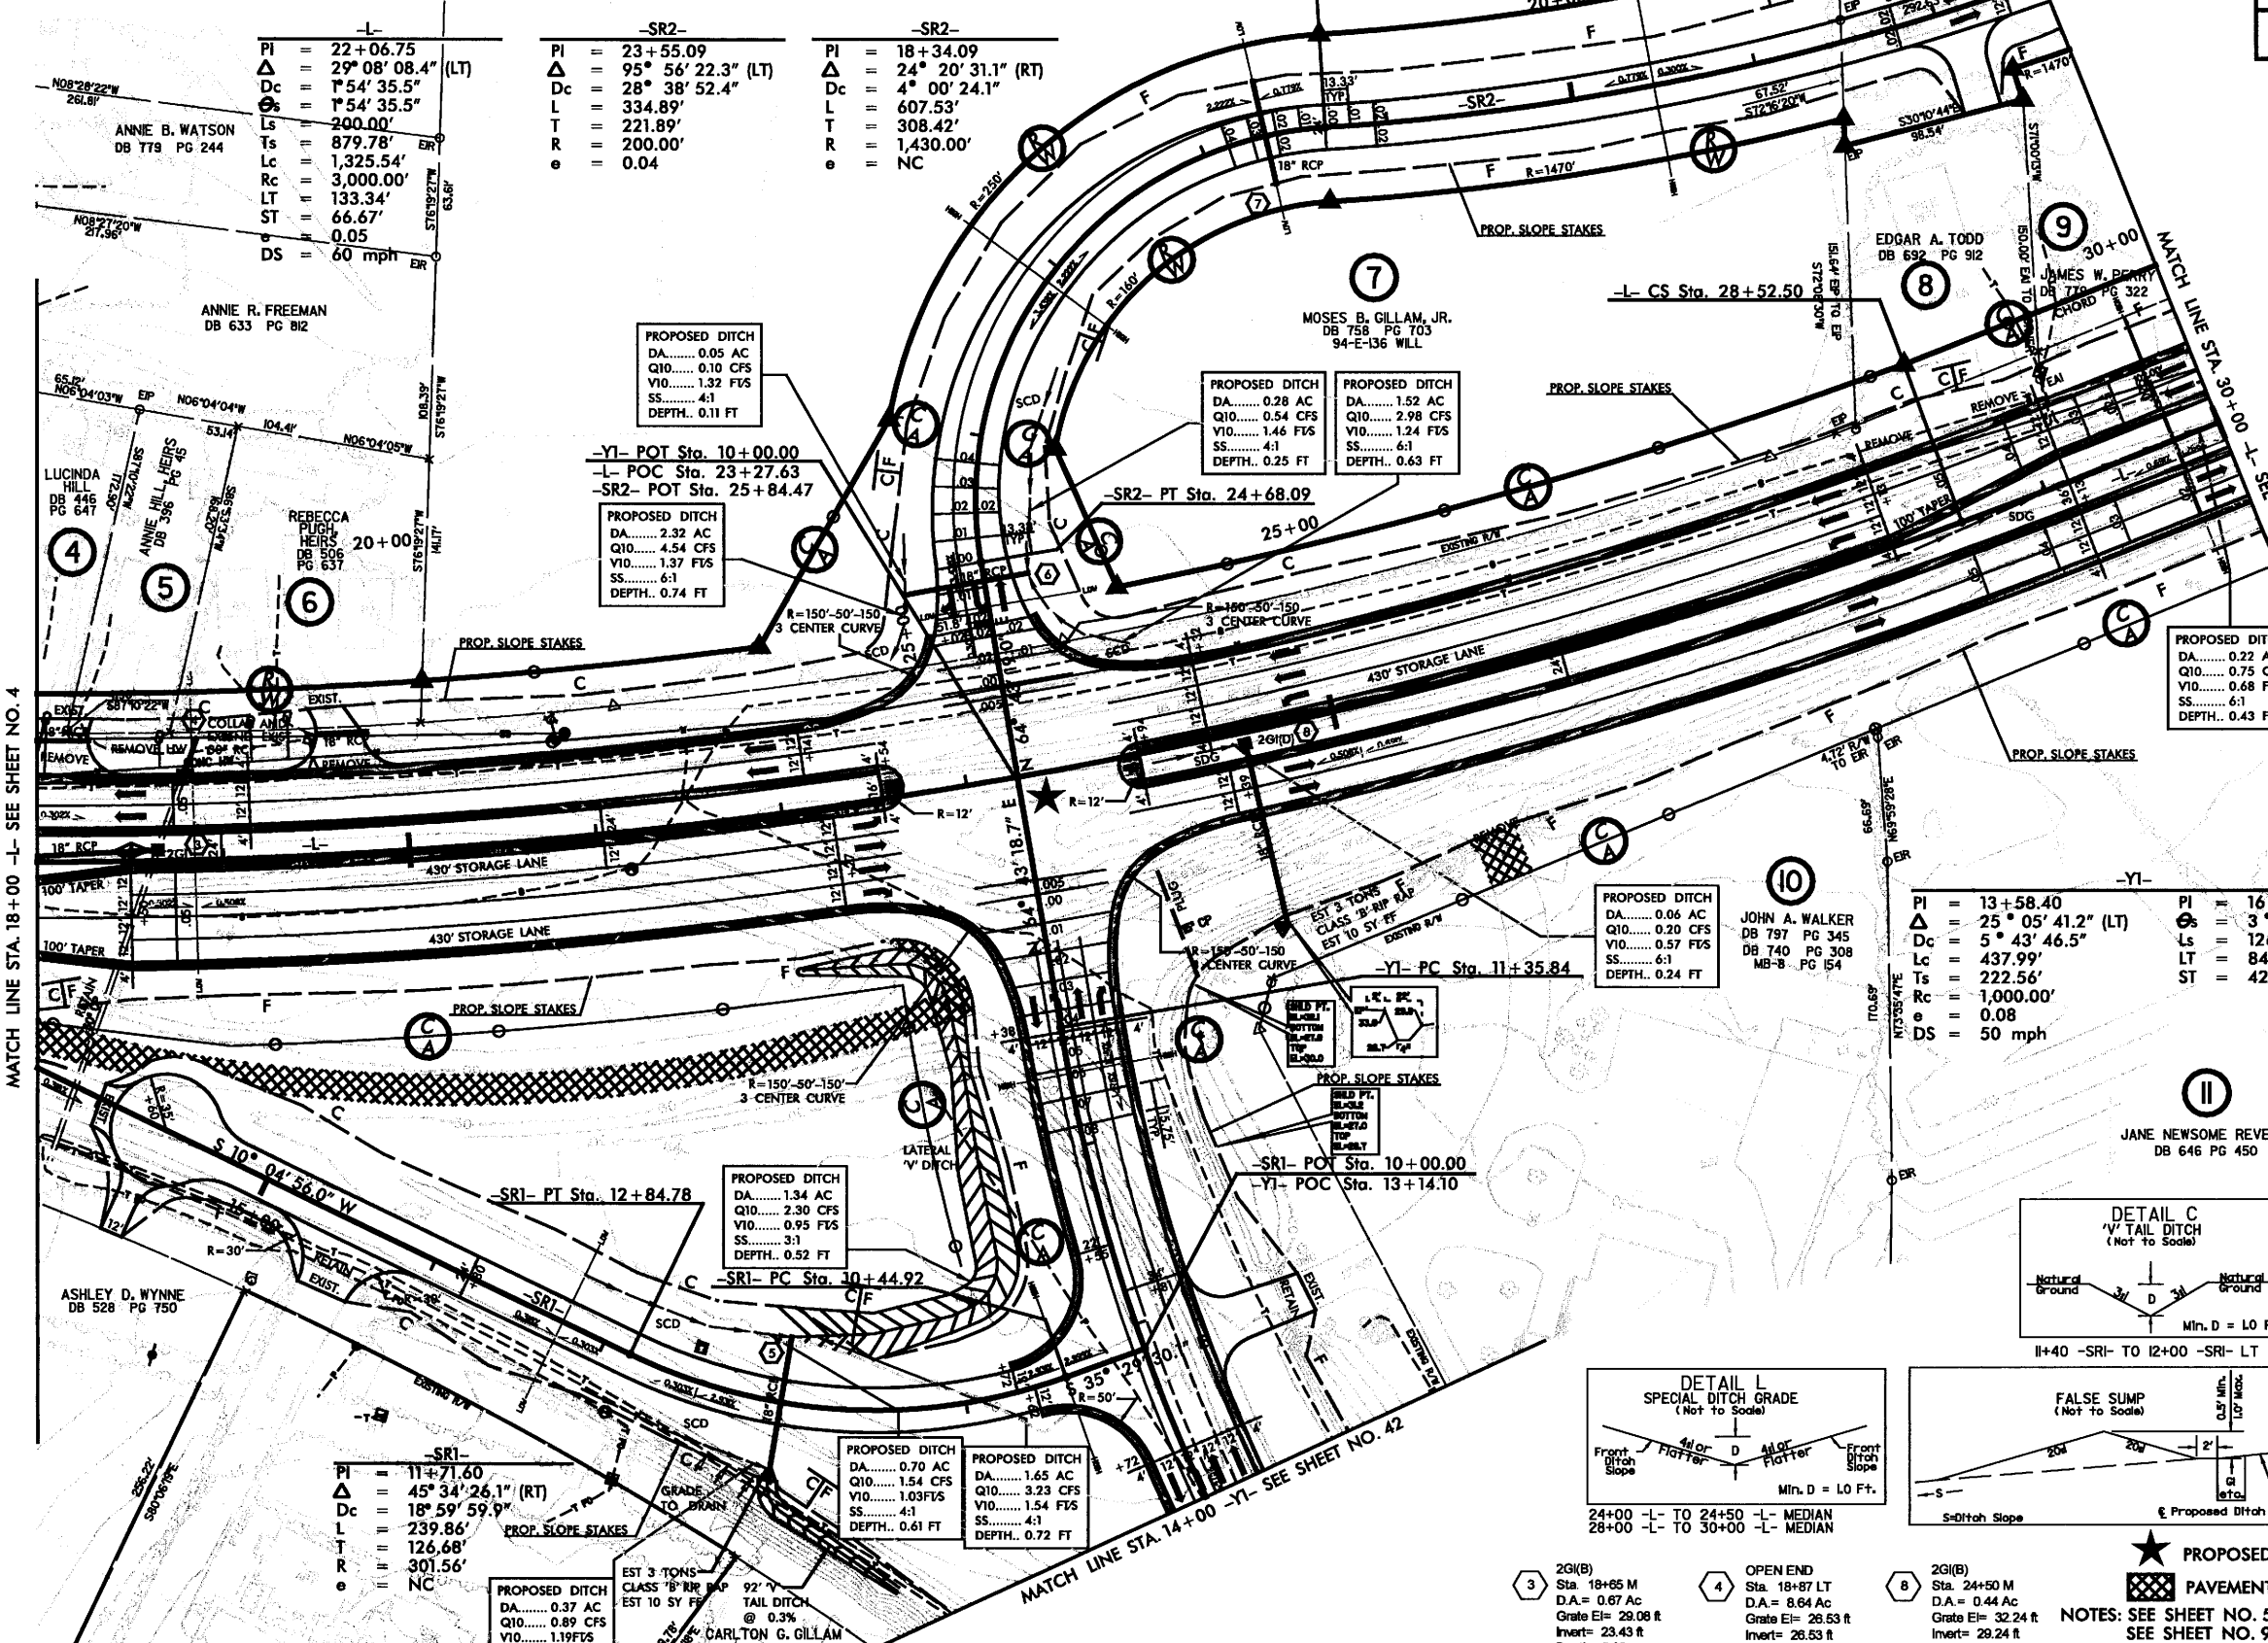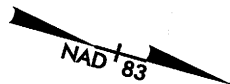

Station	PI	Delta	Dc	L	T	R	e
-L-	22+06.75	29° 08' 08.4" (LT)	1° 54' 35.5"	200.00'	879.78'	1,325.54'	3,000.00'
-SR2-	23+55.09	95° 56' 22.3" (LT)	28° 38' 52.4"	334.89'	221.89'	200.00'	0.04
-SR2-	18+34.09	24° 20' 31.1" (RT)	4° 00' 24.1"	607.53'	308.42'	1,430.00'	NC

ANNE B. WATSON
DB 779 PG 244

ANNE R. FREEMAN
DB 633 PG 812

LUCINDA HILL
DB 446 PG 647

REBECCA PUGH HEIRS
DB 637 PG 637

ASHLEY D. WYNNE
DB 528 PG 750

CARLTON G. GILLAM
DB 668 PG 221

PROPOSED DITCH
DA.....0.05 AC
Q10.....0.10 CFS
V10.....1.32 FFS
SS.....4:1
DEPTH..0.11 FT

-Y1- POT Sta. 10+00.00
-L- POC Sta. 23+27.63
-SR2- POT Sta. 25+84.47

PROPOSED DITCH
DA.....2.32 AC
Q10.....4.54 CFS
V10.....1.37 FFS
SS.....6:1
DEPTH..0.74 FT

PROPOSED DITCH
DA.....0.28 AC
Q10.....0.54 CFS
V10.....1.46 FFS
SS.....4:1
DEPTH..0.25 FT

PROPOSED DITCH
DA.....1.52 AC
Q10.....2.98 CFS
V10.....1.24 FFS
SS.....6:1
DEPTH..0.63 FT

PROPOSED DITCH
DA.....0.22 AC
Q10.....0.75 CFS
V10.....0.68 FFS
SS.....6:1
DEPTH..0.43 FT

PROPOSED DITCH
DA.....0.06 AC
Q10.....0.20 CFS
V10.....0.57 FFS
SS.....6:1
DEPTH..0.24 FT

-Y1-
PI = 13+58.40
Delta = 25° 05' 41.2" (LT)
Dc = 5° 43' 46.5"
Ls = 126.00'
Lt = 437.99'
Ts = 222.56'
Rc = 1,000.00'
e = 0.08
DS = 50 mph

PI = 16+15.84
Delta = 3° 36' 34.7"
Ls = 126.00'
Lt = 84.02'
ST = 42.02'






PROPOSED DITCH
DA.....1.34 AC
Q10.....2.30 CFS
V10.....0.95 FFS
SS.....3:1
DEPTH..0.52 FT

PROPOSED DITCH
DA.....0.70 AC
Q10.....1.54 CFS
V10.....1.03 FFS
SS.....4:1
DEPTH..0.61 FT

PROPOSED DITCH
DA.....1.65 AC
Q10.....3.23 CFS
V10.....1.54 FFS
SS.....4:1
DEPTH..0.72 FT

-SR1-
PI = 11+71.60
Delta = 45° 34' 26.1" (RT)
Dc = 18° 59' 59.9"
L = 239.86'
T = 126.68'
R = 301.56'
e = NC

PROPOSED DITCH
DA.....0.37 AC
Q10.....0.89 CFS
V10.....1.19 FFS
SS.....4:1
DEPTH..0.43 FT

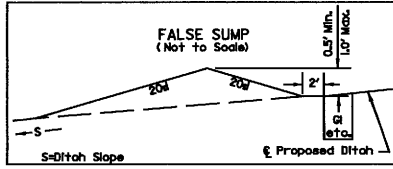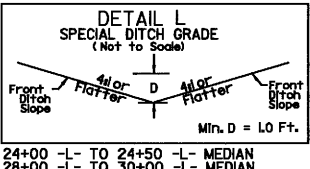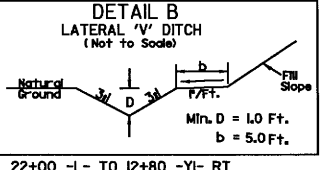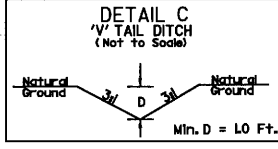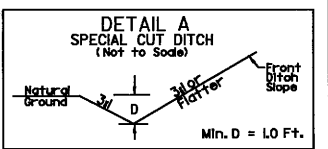

★ PROPOSED TRAFFIC SIGNAL

PAVEMENT TO BE OBLITERATED

NOTES: SEE SHEET NO. 53 FOR -L- PROFILE.
SEE SHEET NO. 91 FOR -SR1- & -Y1- PROFILE
SEE SHEET NO. 92 FOR -SR2- PROFILE
ALL DRIVEWAY RADII ARE 20' UNLESS OTHERWISE NOTED.

- 3 2G(B) Sta. 18+65 M
D.A. = 0.67 Ac
Grate EI= 29.08 ft
Invert= 23.43 ft
Depth= 5.65
- 4 OPEN END Sta. 18+87 LT
D.A. = 0.67 Ac
Grate EI= 26.53 ft
Invert= 26.53 ft
Depth= 0.0
- 8 2G(B) Sta. 24+50 M
D.A. = 0.44 Ac
Grate EI= 32.24 ft
Invert= 29.24 ft
Depth= 3.0

8/2/2005 9:40 AM \\s01\hdc\Redline\planning\12404A_hvl_Redline_pst_05.dgn

REVISIONS


-L-

PI = 69+00.63
 Δ = 66° 46' 43.5" (RT)
 Dc = 2° 01' 28.5"
 Θ_s = 2° 25' 46.2"
 Ls = 240.00'
 Ts = 1,985.84'
 Lc = 3,058.39'
 Rc = 2,830.00'
 LT = 160.02'
 ST = 80.01'
 e = 0.06
 DS = 60 mph



(18)
 BELL BROTHERS, INC.
 DB 494 PG 79
 DB 528 PG 58
 DB 557 PG 595
 DB 494 PG 87
 PB-2 PG II & 79
 PB-4 PG 48




W. RUSSELL SPIVEY
 DB 603 PG 227

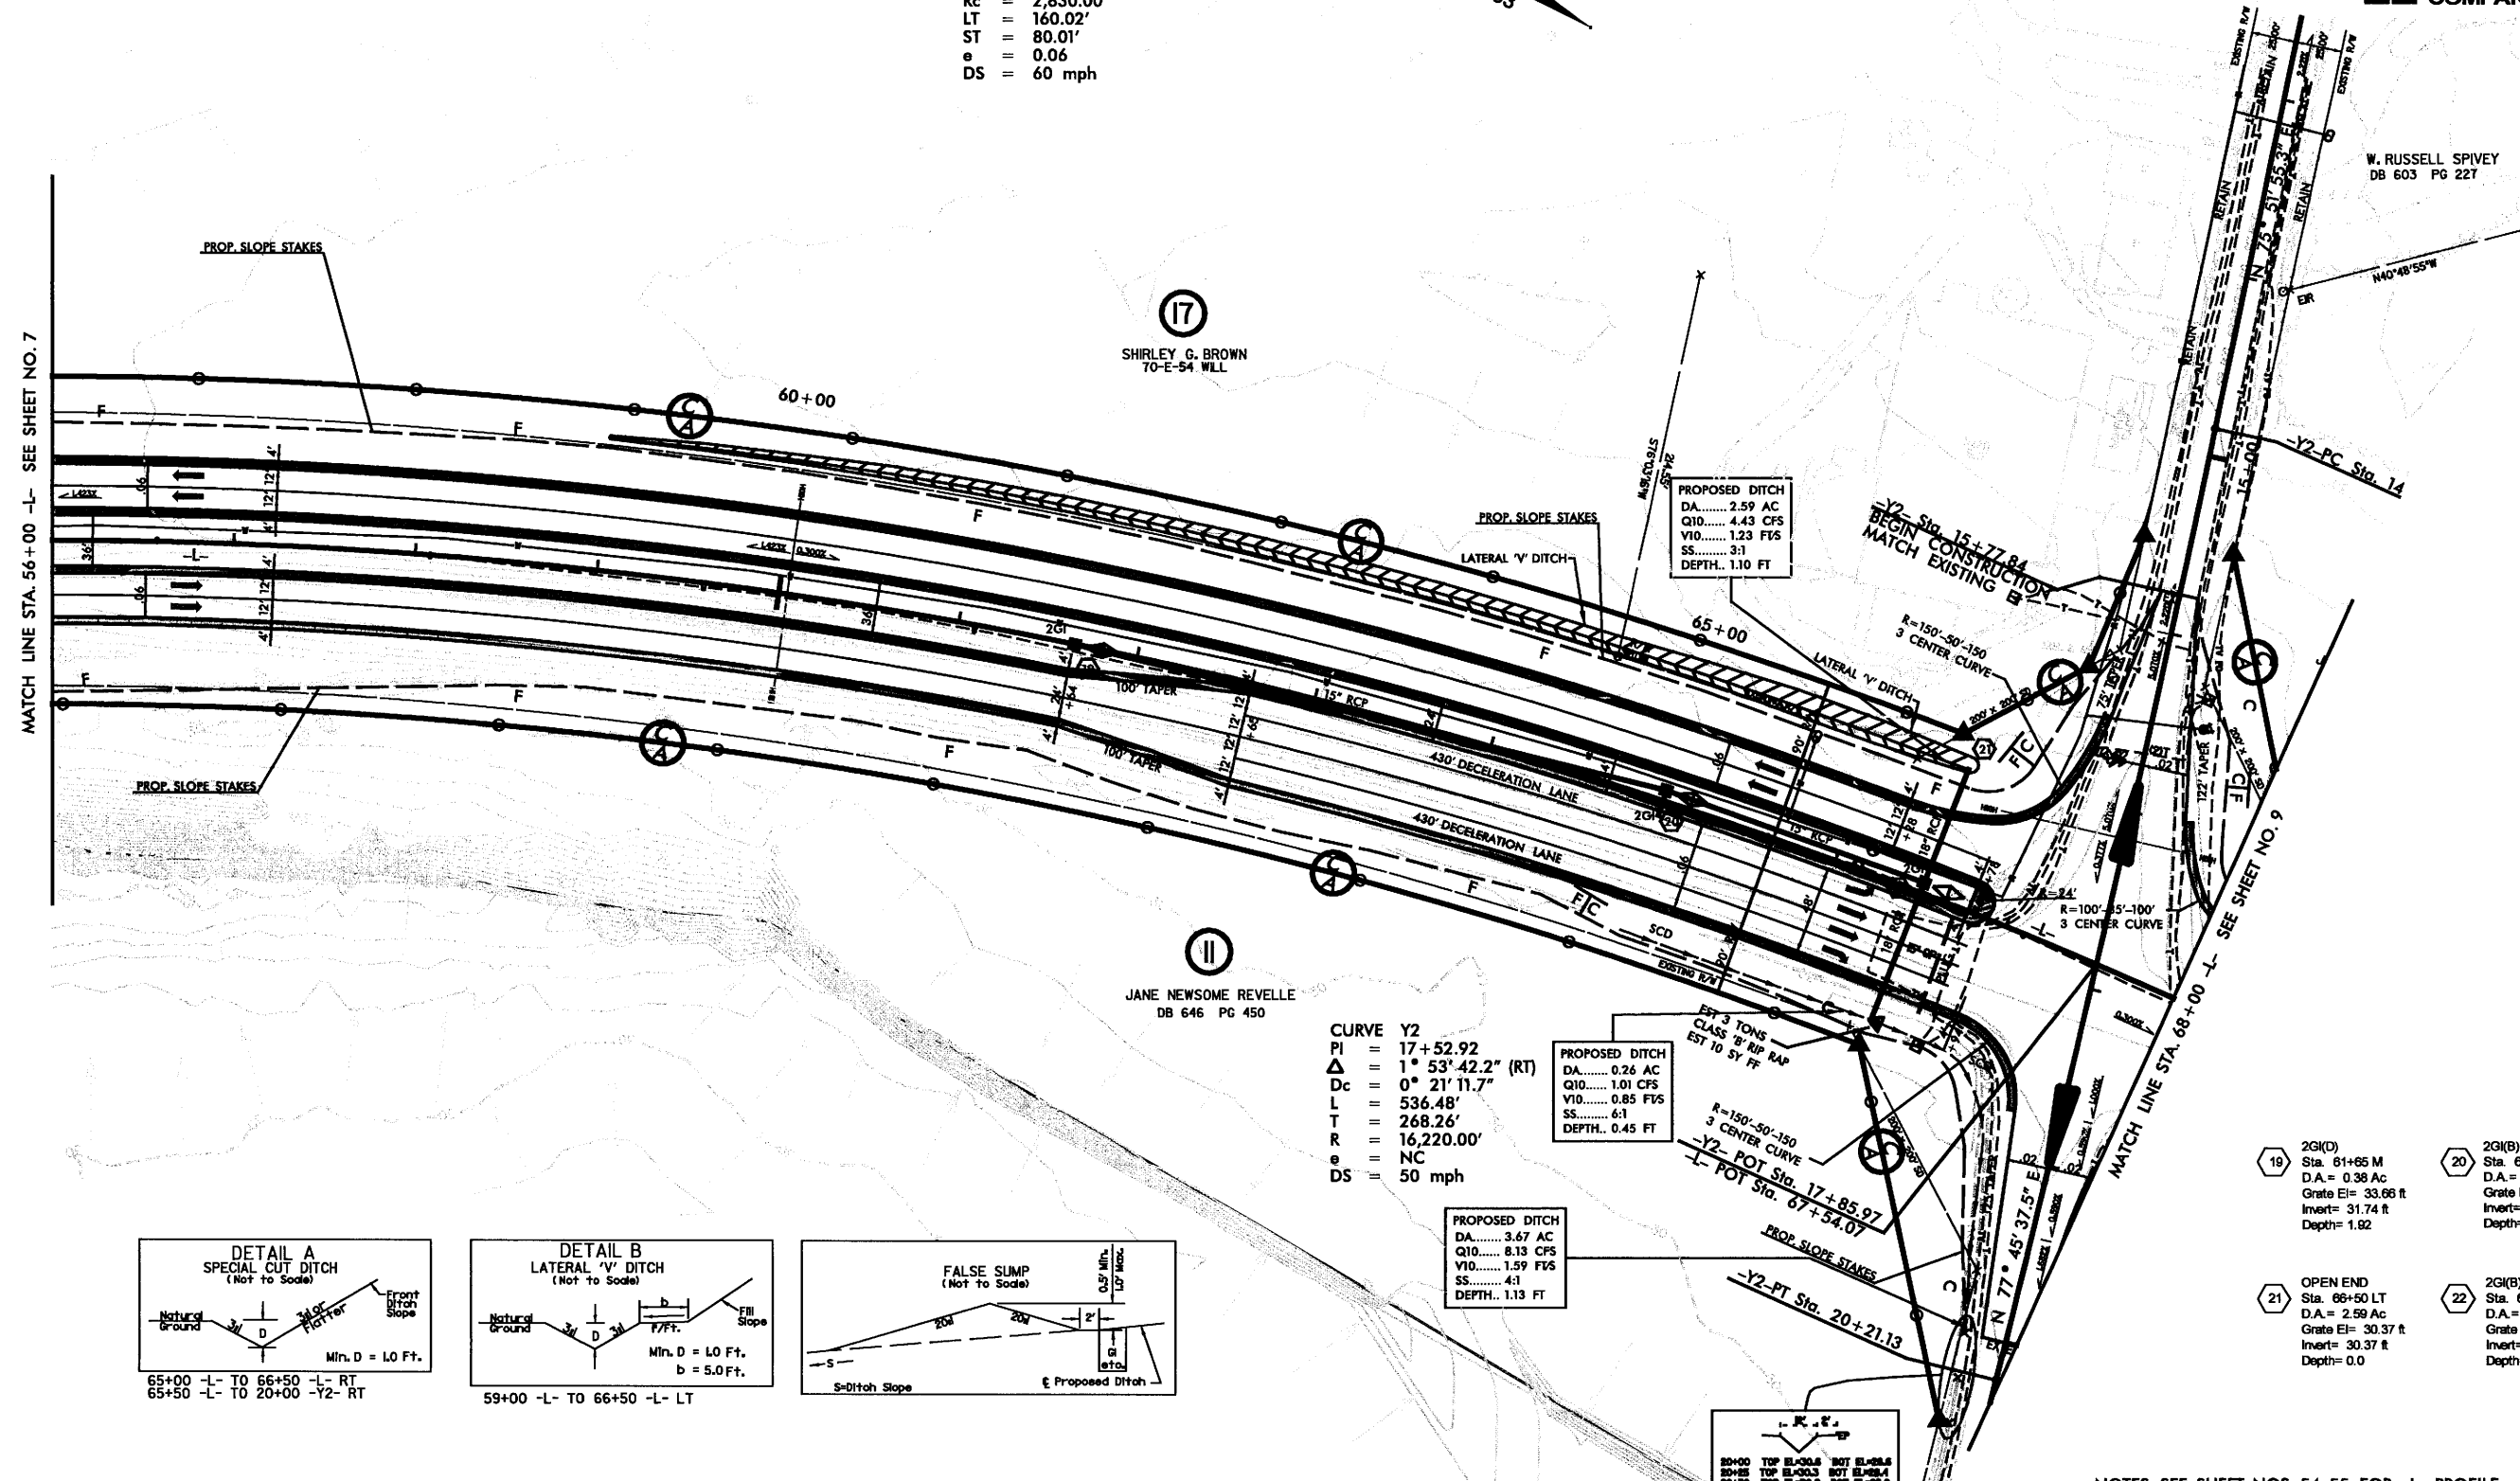

CURVE Y2
 PI = 17+52.92
 Δ = 1° 53' 42.2" (RT)
 Dc = 0° 21' 11.7"
 L = 536.48'
 T = 268.26'
 R = 16,220.00'
 e = NC
 DS = 50 mph

PROPOSED DITCH
 DA..... 0.26 AC
 Q10..... 1.01 CFS
 V10..... 0.85 FTS
 SS..... 6:1
 DEPTH.. 0.45 FT

PROPOSED DITCH
 DA..... 3.67 AC
 Q10..... 8.13 CFS
 V10..... 1.59 FTS
 SS..... 4:1
 DEPTH.. 1.13 FT

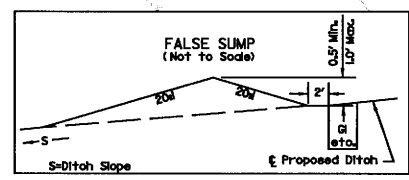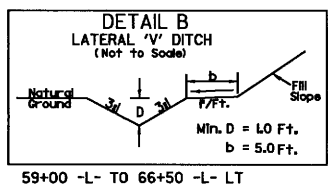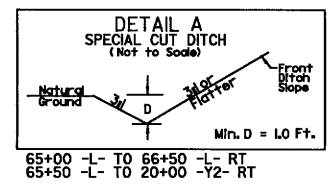

- 19 2G(D)
Sta. 61+65 M
D.A. = 0.38 Ac
Grate El= 33.66 ft
Invert= 31.74 ft
Depth= 1.92
- 20 2G(B)
Sta. 65+00 M
D.A. = 0.22 Ac
Grate El= 34.14 ft
Invert= 30.39 ft
Depth= 3.74
- 21 OPEN END
Sta. 66+50 LT
D.A. = 2.59 Ac
Grate El= 30.37 ft
Invert= 30.37 ft
Depth= 0.0
- 22 2G(B)
Sta. 66+50 M
D.A. = 0.21 Ac
Grate El= 33.72 ft
Invert= 29.63 ft
Depth= 4.08



NOTES: SEE SHEET NOS. 54-55 FOR -L- PROFILE.
 ALL DRIVEWAY RADII ARE 20' UNLESS OTHERWISE NOTED.

8/7/2005 10:35:09 AM
 W:\Projects\2404\Revisions\2404A_TVL_Revisions.dwg - 08.dwg


REVISIONS

-L-



PI = 69+00.63
 Δ = 66° 46' 43.5" (RT)
 Dc = 2° 01' 28.5"
 ϕ_s = 2° 25' 46.2"
 Ls = 240.00'
 Ts = 1,985.84'
 Lc = 3,058.39'
 Rc = 2,830.00'
 LT = 160.02'
 ST = 80.01'
 e = 0.06
 DS = 60 mph

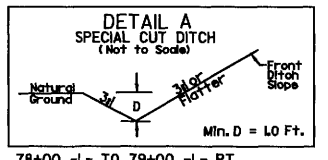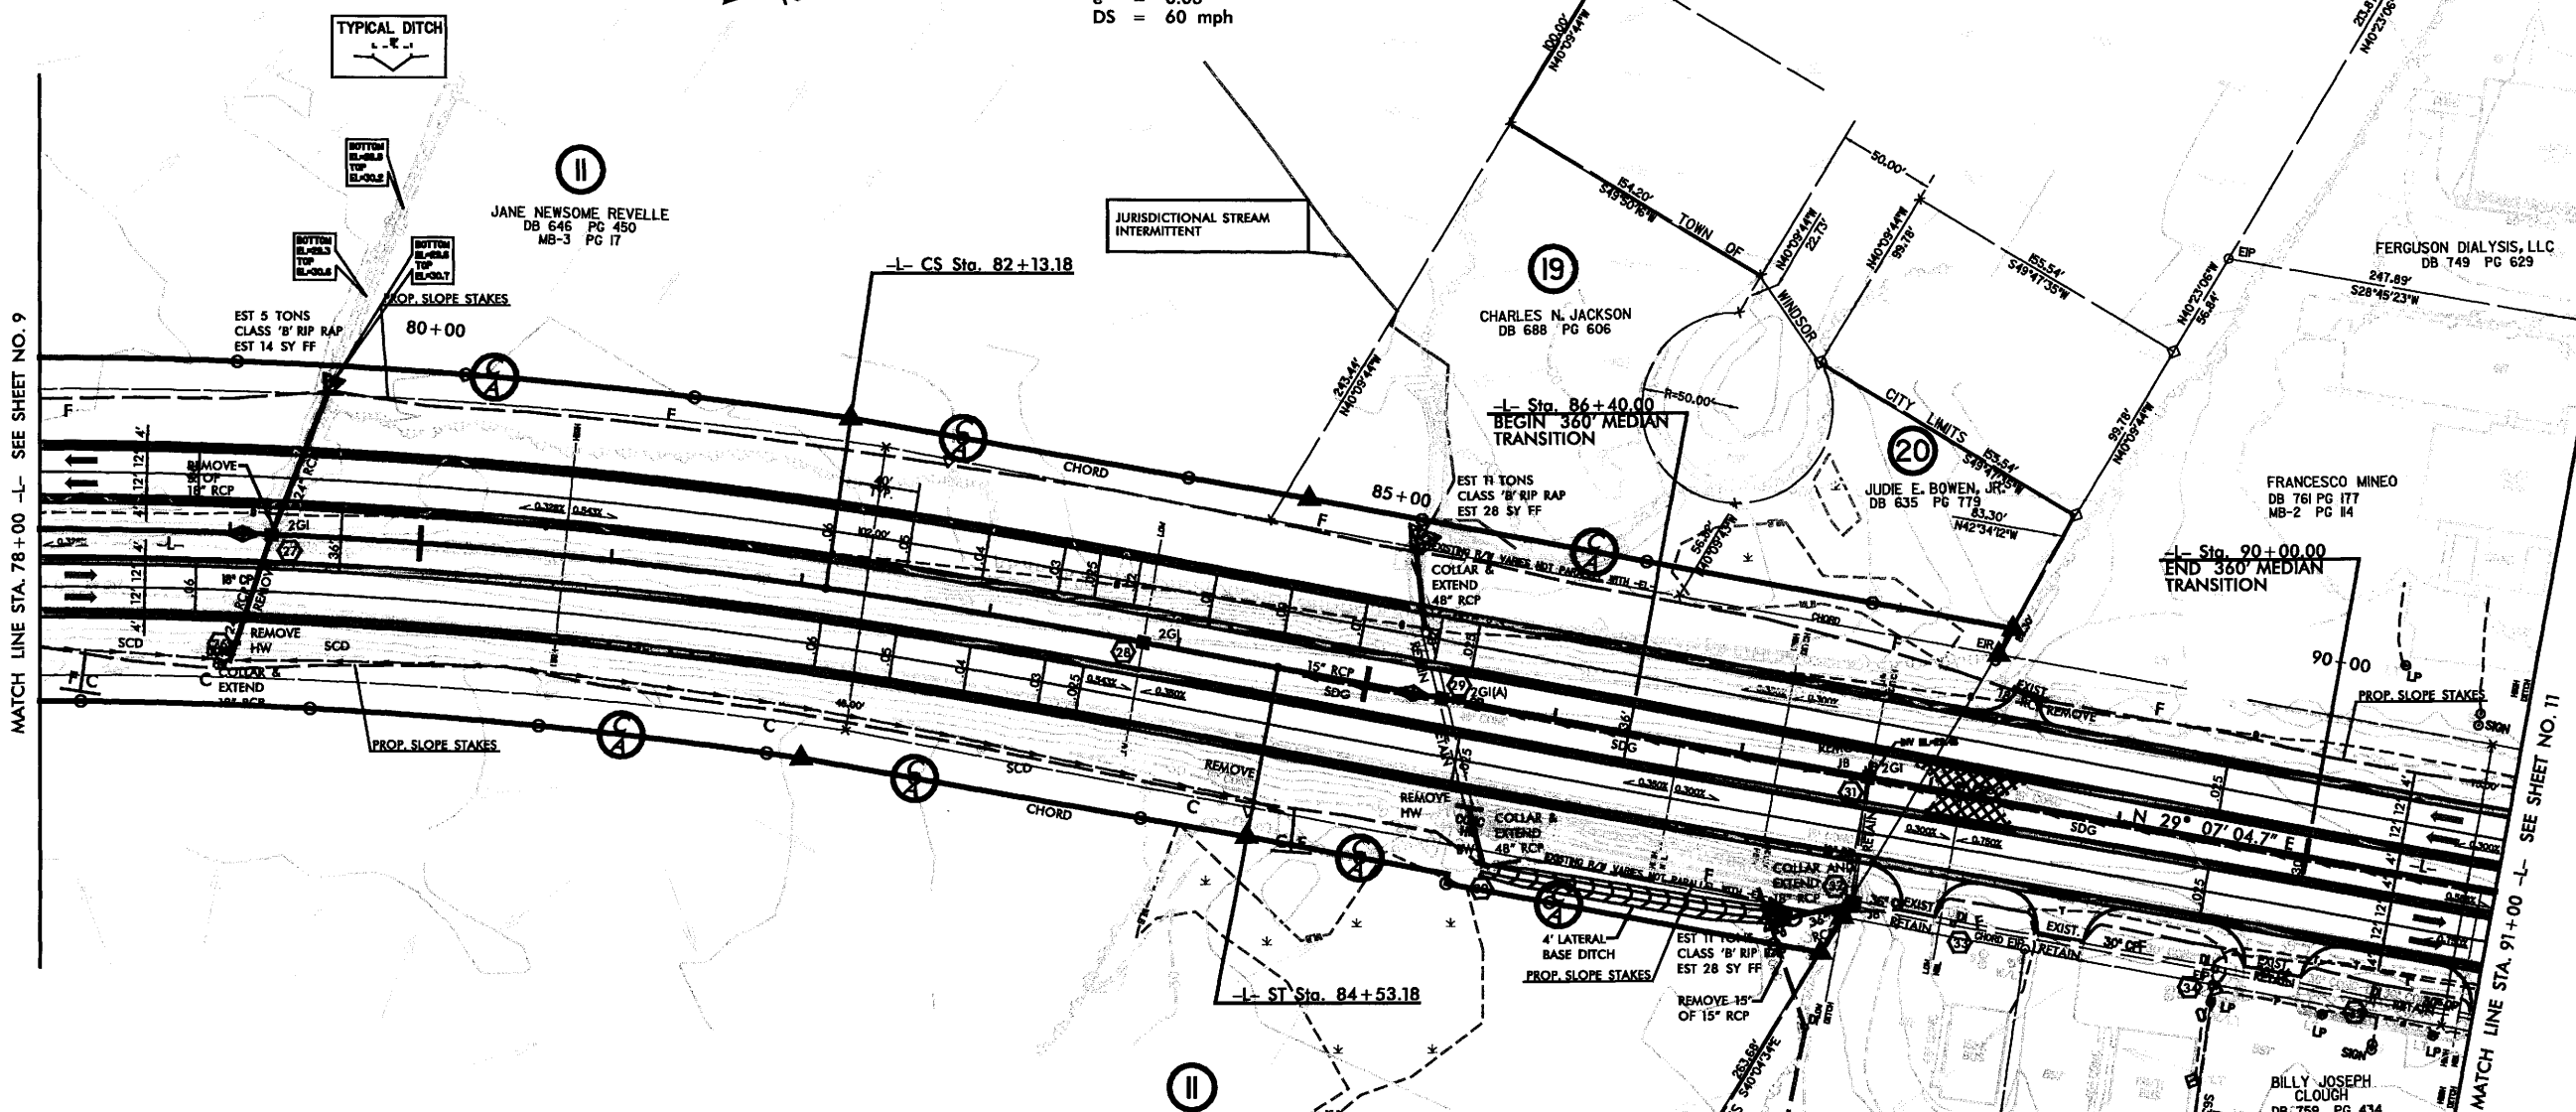

78+00 -L- TO 79+00 -L- RT
 79+00 -L- TO 80+50 -L- RT
 80+50 -L- TO 84+00 -L- RT
 84+00 -L- TO 84+69 -L- RT

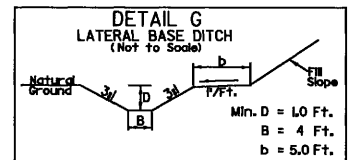

85+55 -L- TO 87+45 -L- RT

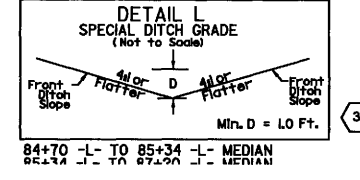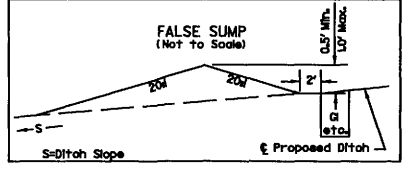

84+70 -L- TO 85+34 -L- MEDIAN

26 OPEN END
 Sta. 79+00 RT
 D.A. = 3.02 Ac
 Grate El= 29.84 ft
 Invert= 29.84 ft
 Depth= 0.0

27 2G(B)
 Sta. 79+21 M
 D.A. = 0.23 Ac
 Grate El= 33.23 ft
 Invert= 29.35 ft
 Depth= 4.88

28 2G(B)
 Sta. 83+82 M
 D.A. = 0.58 Ac
 Grate El= 33.77 ft
 Invert= 30.77 ft
 Depth= 3.0

29 2G(A)
 Sta. 85+34 M
 D.A. = 0.15 Ac
 Grate El= 34.13 ft
 Invert= 25.95 ft
 Depth= 8.18

30 OPEN END
 Sta. 85+55 RT
 D.A. = 76.64 Ac
 Grate El= 26.50 ft
 Invert= 26.50 ft
 Depth= 0.0

31 2G(B)
 Sta. 87+67 M
 D.A. = 0.27 Ac
 Grate El= 34.48 ft
 Invert= 31.48 ft
 Depth= 3.0

32 JB w/ Slab
 Sta. 87+72 RT
 D.A. = 0.0 Ac
 Grate El= 27.16 ft
 Invert= 27.16 ft
 Depth= 4.77

33 2G(B)
 Sta. 88+25 RT
 D.A. = 0.22 Ac
 Grate El= 31.80 ft
 Invert= 27.60 ft
 Depth= 4.20

34 2G(B)
 Sta. 89+84 RT
 D.A. = 0.21 Ac
 Grate El= 31.62 ft
 Invert= 27.62 ft
 Depth= 4.10



35 2G(B)
 Sta. 90+48 RT
 D.A. = 0.2 Ac
 Grate El= 31.38 ft
 Invert= 27.87 ft
 Depth= 3.41

SITE 2

NOTES: SEE SHEET NO. 55-56 FOR -L- PROFILE.
 ALL DRIVEWAY RADII ARE 20' UNLESS OTHERWISE NOTED.
 DO NOT PLACE ROCK IN BED OF JURISDICTIONAL STREAMS.

10/24/2005 10:34:40 AM 2404A.dwg 2404A.dwg 10/24/2005 10:34:40 AM

REVISIONS

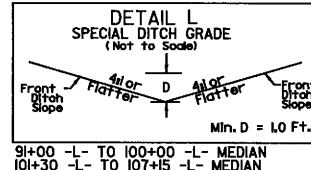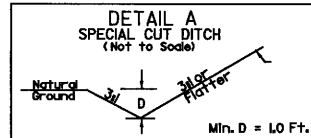

- 40 2G(B) Sta. 93+90 M D.A. = 0.32 Ac Grate El= 34.91 ft Invert= 31.91 ft Depth= 3.0
- 41 OPEN END Sta. 95+80 LT D.A.= 6.58 Ac Grate El= 30.19 ft Invert= 30.19 ft Depth= 0.0
- 42 2G(B) Sta. 95+82 M D.A. = 0.13 Ac Grate El= 36.57 ft Invert= 30.0 ft Depth= 6.57
- 43 2G(B) Sta. 97+17.5 M D.A. = 0.17 Ac Grate El= 36.49 ft Invert= 33.49 ft Depth= 3.0
- 44 OPEN END Sta. 99+55 LT D.A. = 2.77 Ac Grate El= 31.39 ft Invert= 31.39 ft Depth= 0.0
- 45 JB w/MH Sta. 99+55 RT D.A. = 0.0 Ac Grate El= 34.0 ft Invert= 30.33 ft Depth= 3.67
- 46 OPEN END Sta. 100+10 RT D.A. = 13.29 Ac Grate El= 30.89 ft Invert= 30.89 ft Depth= 0.0
- 47 OPEN END Sta. 101+71 LT D.A. = 0.54 Ac Grate El= 32.04 ft Invert= 32.04 ft Depth= 0.0
- 48 2G(B) Sta. 101+71 M D.A. = 0.24 Ac Grate El= 37.28 ft Invert= 31.68 ft Depth= 5.60


PROJECT REFERENCE NO. **R-2404A** SHEET NO. **11**

R/W SHEET NO. ROADWAY DESIGN HYDRAULICS ENGINEER

PRELIMINARY PLANS
DO NOT USE FOR CONSTRUCTION

HDR Engineering, Inc. of the Carolinas Raleigh, N.C. 27612

BARNHILL CONTRACTING COMPANY

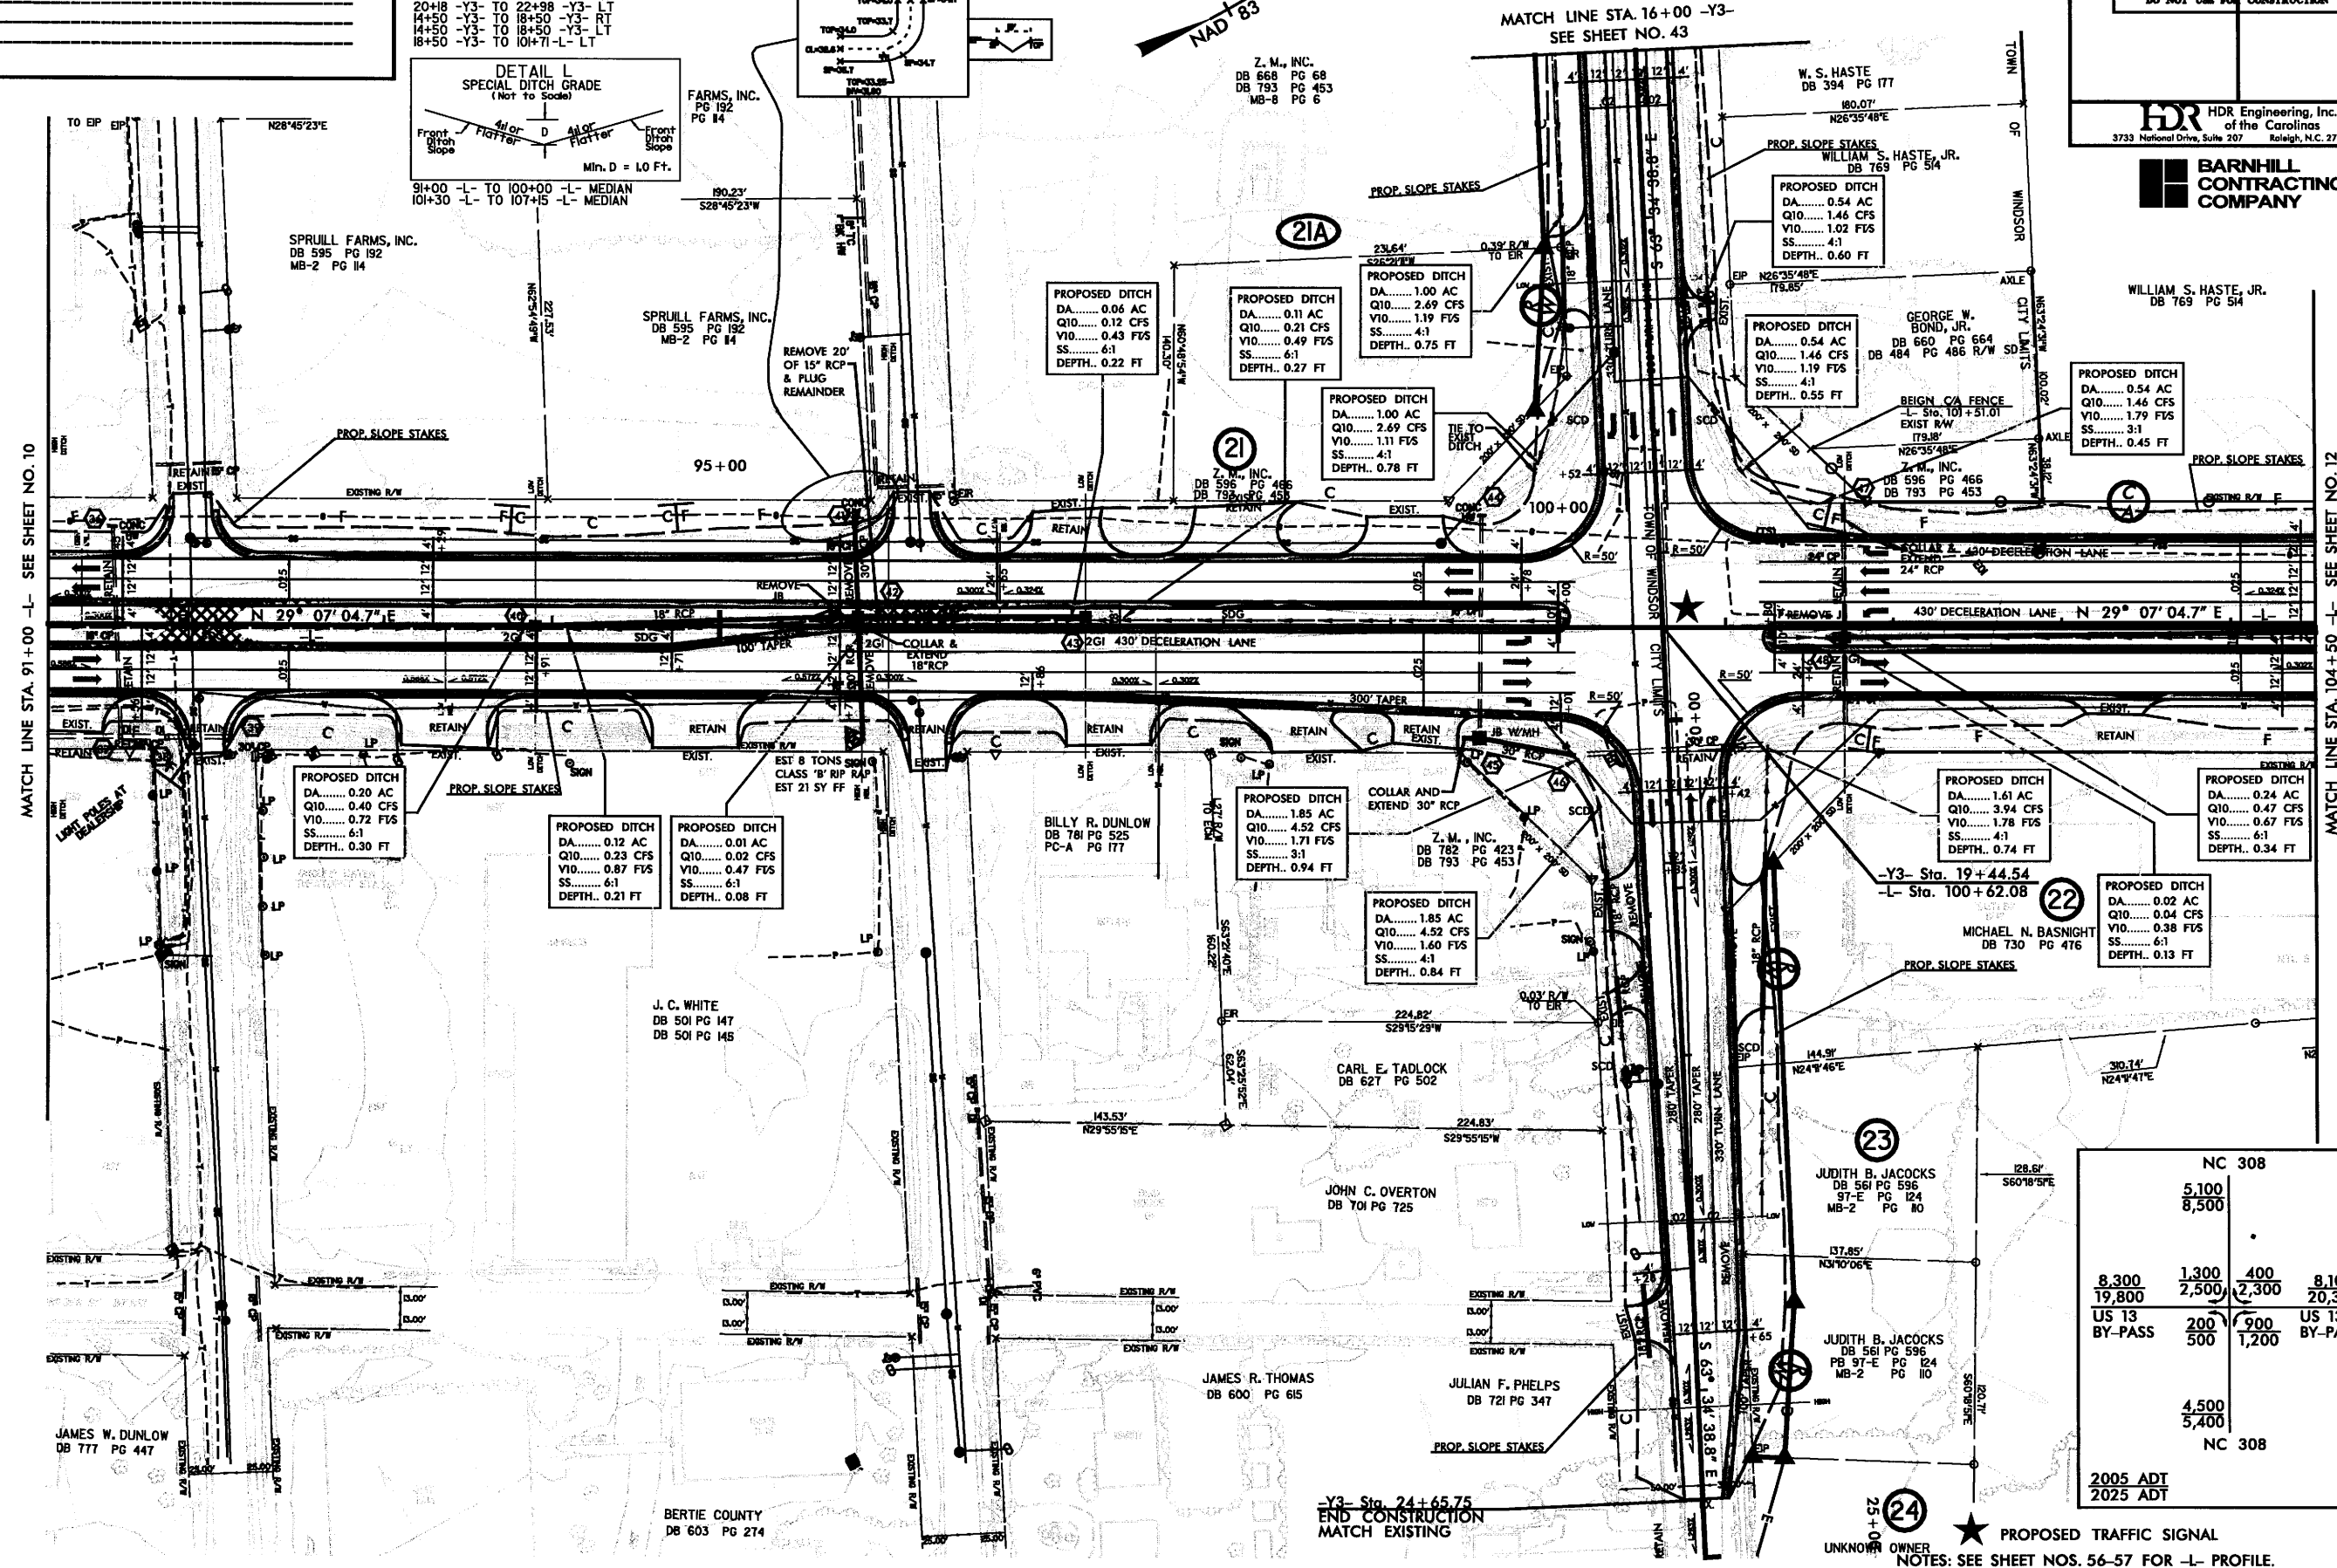

MATCH LINE STA. 91+00 -L- SEE SHEET NO. 10

MATCH LINE STA. 104+50 -L- SEE SHEET NO. 12

NC 308			
5,100			
8,500			
8,300	1,300	400	8,100
19,800	2,500	2,300	20,300
US 13 BY-PASS	200	900	US 13 BY-PASS
	500	1,200	
			4,500
			5,400
NC 308			
2005 ADT			
2025 ADT			


24 PROPOSED TRAFFIC SIGNAL
 NOTES: SEE SHEET NOS. 56-57 FOR -L- PROFILE.
 SEE SHEET NO. 75 FOR -Y3- PROFILE.
 ALL DRIVEWAY RADII ARE 20' UNLESS OTHERWISE NOTED.

8/7/2005 10:24:40 AM C:\Users\jrd\Documents\2005\2404A\2404A.dwg

REVISIONS

- 81 2GI(B)
Sta. 148+00
D.A. = 0.47 AC
Grate El= 16.92 ft
Invert= 13.92 ft
Depth= 3.0
- 82 2GI(B)
Sta. 148+00
D.A. = 0.38 AC
Grate El= 14.46 ft
Invert= 11.46 ft
Depth= 3.0
- 83 2GI(B)
Sta. 150+50
D.A. = 0.43 AC
Grate El= 12.90 ft
Invert= 9.90 ft
Depth= 3.0
- 84 2GI(B)w/ FL GR
Sta. 154+30 LT
D.A. = 0.68 AC
Grate El= 16.22 ft
Invert= 13.22 ft
Depth= 3.0
- 85 2GI(B)w/ FL GR
Sta. 154+55 RT
D.A. = 0.68 AC
Grate El= 16.34 ft
Invert= 13.34 ft
Depth= 3.0

PROJECT REFERENCE NO. R-2404A	SHEET NO. 14
RW SHEET NO.	
ROADWAY DESIGN	HYDRAULICS ENGINEER
PRELIMINARY PLANS DO NOT USE FOR CONSTRUCTION	
HDR Engineering, Inc. of the Carolinas 3733 National Drive, Suite 307 Raleigh, N.C. 27612	
BARNHILL CONTRACTING COMPANY	

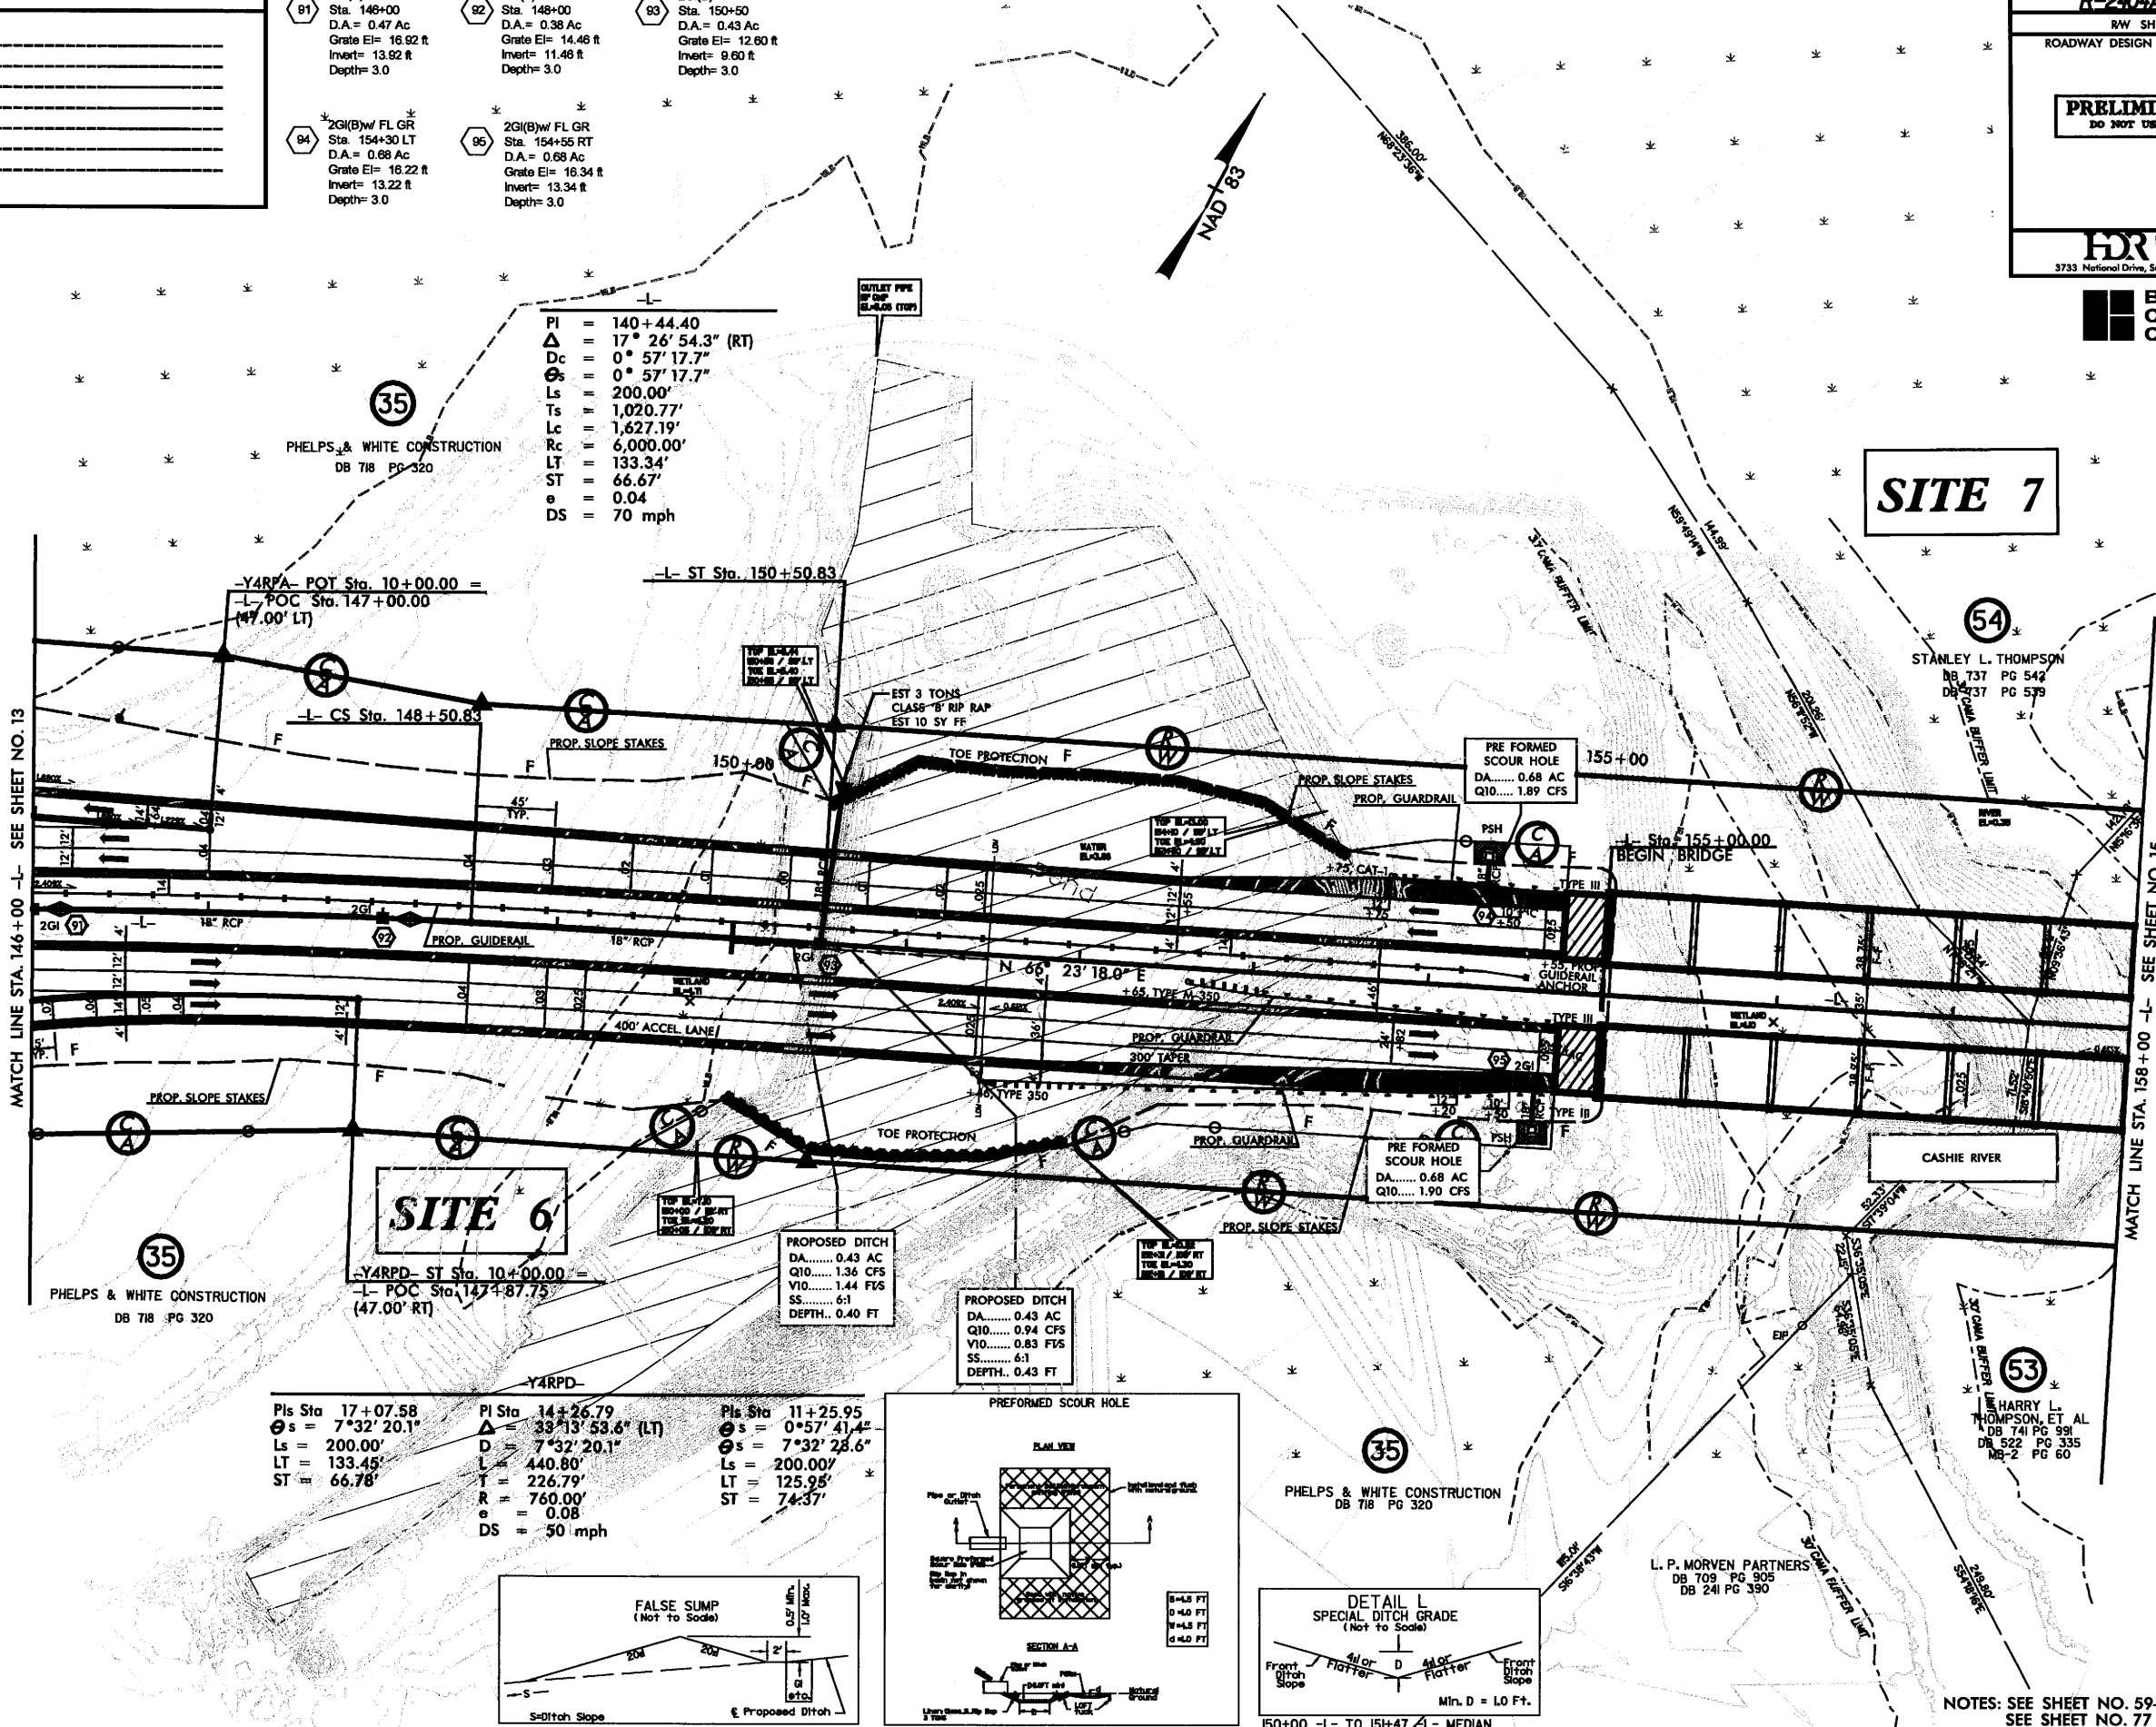

PI = 140+44.40
 Δ = 17° 26' 54.3" (RT)
 Dc = 0° 57' 17.7"
 Θ_s = 0° 57' 17.7"
 Ls = 200.00'
 Ts = 1,020.77'
 Lc = 1,627.19'
 Rc = 6,000.00'
 LT = 133.34'
 ST = 66.67'
 e = 0.04
 DS = 70 mph

-Y4RPA- POT Sta. 10+00.00 =
 -L- POC Sta. 147+00.00
 (47.00' LT)




-L- ST Sta. 150+50.83

-Y4RPD- ST Sta. 10+00.00 =
 -L- POC Sta. 147+87.75
 (47.00' RT)

PIs Sta 17+07.58
 Θ_s = 7° 32' 20.1"
 Ls = 200.00'
 LT = 133.45'
 ST = 66.78'

PIs Sta 14+26.79
 Δ = 33° 13' 53.6" (LT)
 D = 7° 32' 20.1"
 L = 440.80'
 T = 226.79'
 R = 760.00'
 e = 0.08
 DS = 50 mph

PIs Sta 11+25.95
 Θ_s = 0° 57' 41.4"
 Θ_s = 7° 32' 28.6"
 Ls = 200.00'
 LT = 125.95'
 ST = 74.37'

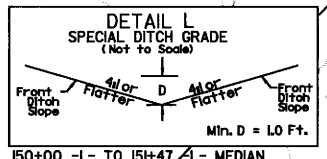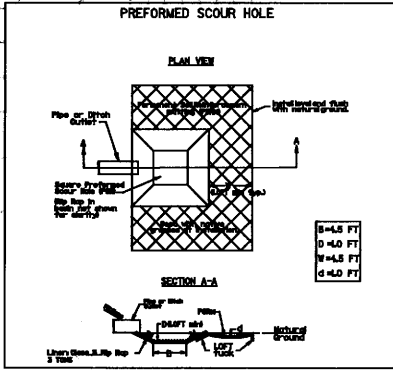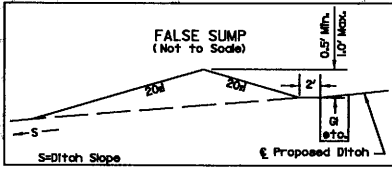

NOTES: SEE SHEET NO. 59-60 FOR -L- PROFILE
 SEE SHEET NO. 77 FOR -Y4RPA- PROFILE.
 SEE SHEET NO. 79 FOR -Y4RPD- PROFILE.
 SEE SHEET NO. 2-J FOR STRUCTURE DETAIL.
 DO NOT PLACE ROCK IN BED OF JURISDICTIONAL STREAMS.

8/17/2005 10:36:27 AM
 2404A\Roadway\Site\2404A-RW-14.dwg
 2404A-RW-14.dwg

REVISIONS

PROJECT REFERENCE NO. SHEET NO.

R-2404A 16

R/W SHEET NO. HYDRAULICS ENGINEER

ROADWAY DESIGN

PRELIMINARY PLANS
DO NOT USE FOR CONSTRUCTION

FDR HDR Engineering, Inc.
of the Carolinas
3733 National Drive, Suite 207
Raleigh, N.C. 27612

BARNHILL CONTRACTING COMPANY

-L-
PI = 186+35.23
Δ = 13° 56' 35.9" (RT)
Dc = 0° 22' 55.1"
L = 3,650.35'
T = 1,834.24'
R = 15,000.00'
e = NC
DS = 70 mph




53

HARRY L. THOMPSON, ET AL
DB 741 PG 99
DB 522 PG 335
MB-2 PG 60

- 96 2GI(B)w/ FL GR
Sta. 172+36 LT
D.A. = 0.04 Ac
Grate EI= 26.74 ft
Depth= 3.0
- 97 2GI(B)w/ FL GR
Sta. 172+86 LT
D.A. = 0.16 Ac
Grate EI= 27.05 ft
Depth= 5.29
- 98 2GI(B)w/ FL GR
Sta. 172+36 RT
D.A. = 0.04 Ac
Grate EI= 26.74 ft
Depth= 3.0
- 99 2GI(B)
Sta. 172+86 M
D.A. = 0.26 Ac
Grate EI= 25.32 ft
Depth= 3.0
- 100 2GI(B)w/ FL GR
Sta. 172+86 RT
D.A. = 0.2 Ac
Grate EI= 27.05 ft
Invert= 23.22 ft
Depth= 3.83
- 101 2GI(D)
Sta. 175+00 M
D.A. = 0.66 Ac
Grate EI= 26.62 ft
Invert= 24.45 ft
Depth= 2.17
- 102 2GI(B)
Sta. 181+15 M
D.A. = 0.25 Ac
Grate EI= 29.74 ft
Invert= 26.74 ft
Depth= 3.0

SITE 8




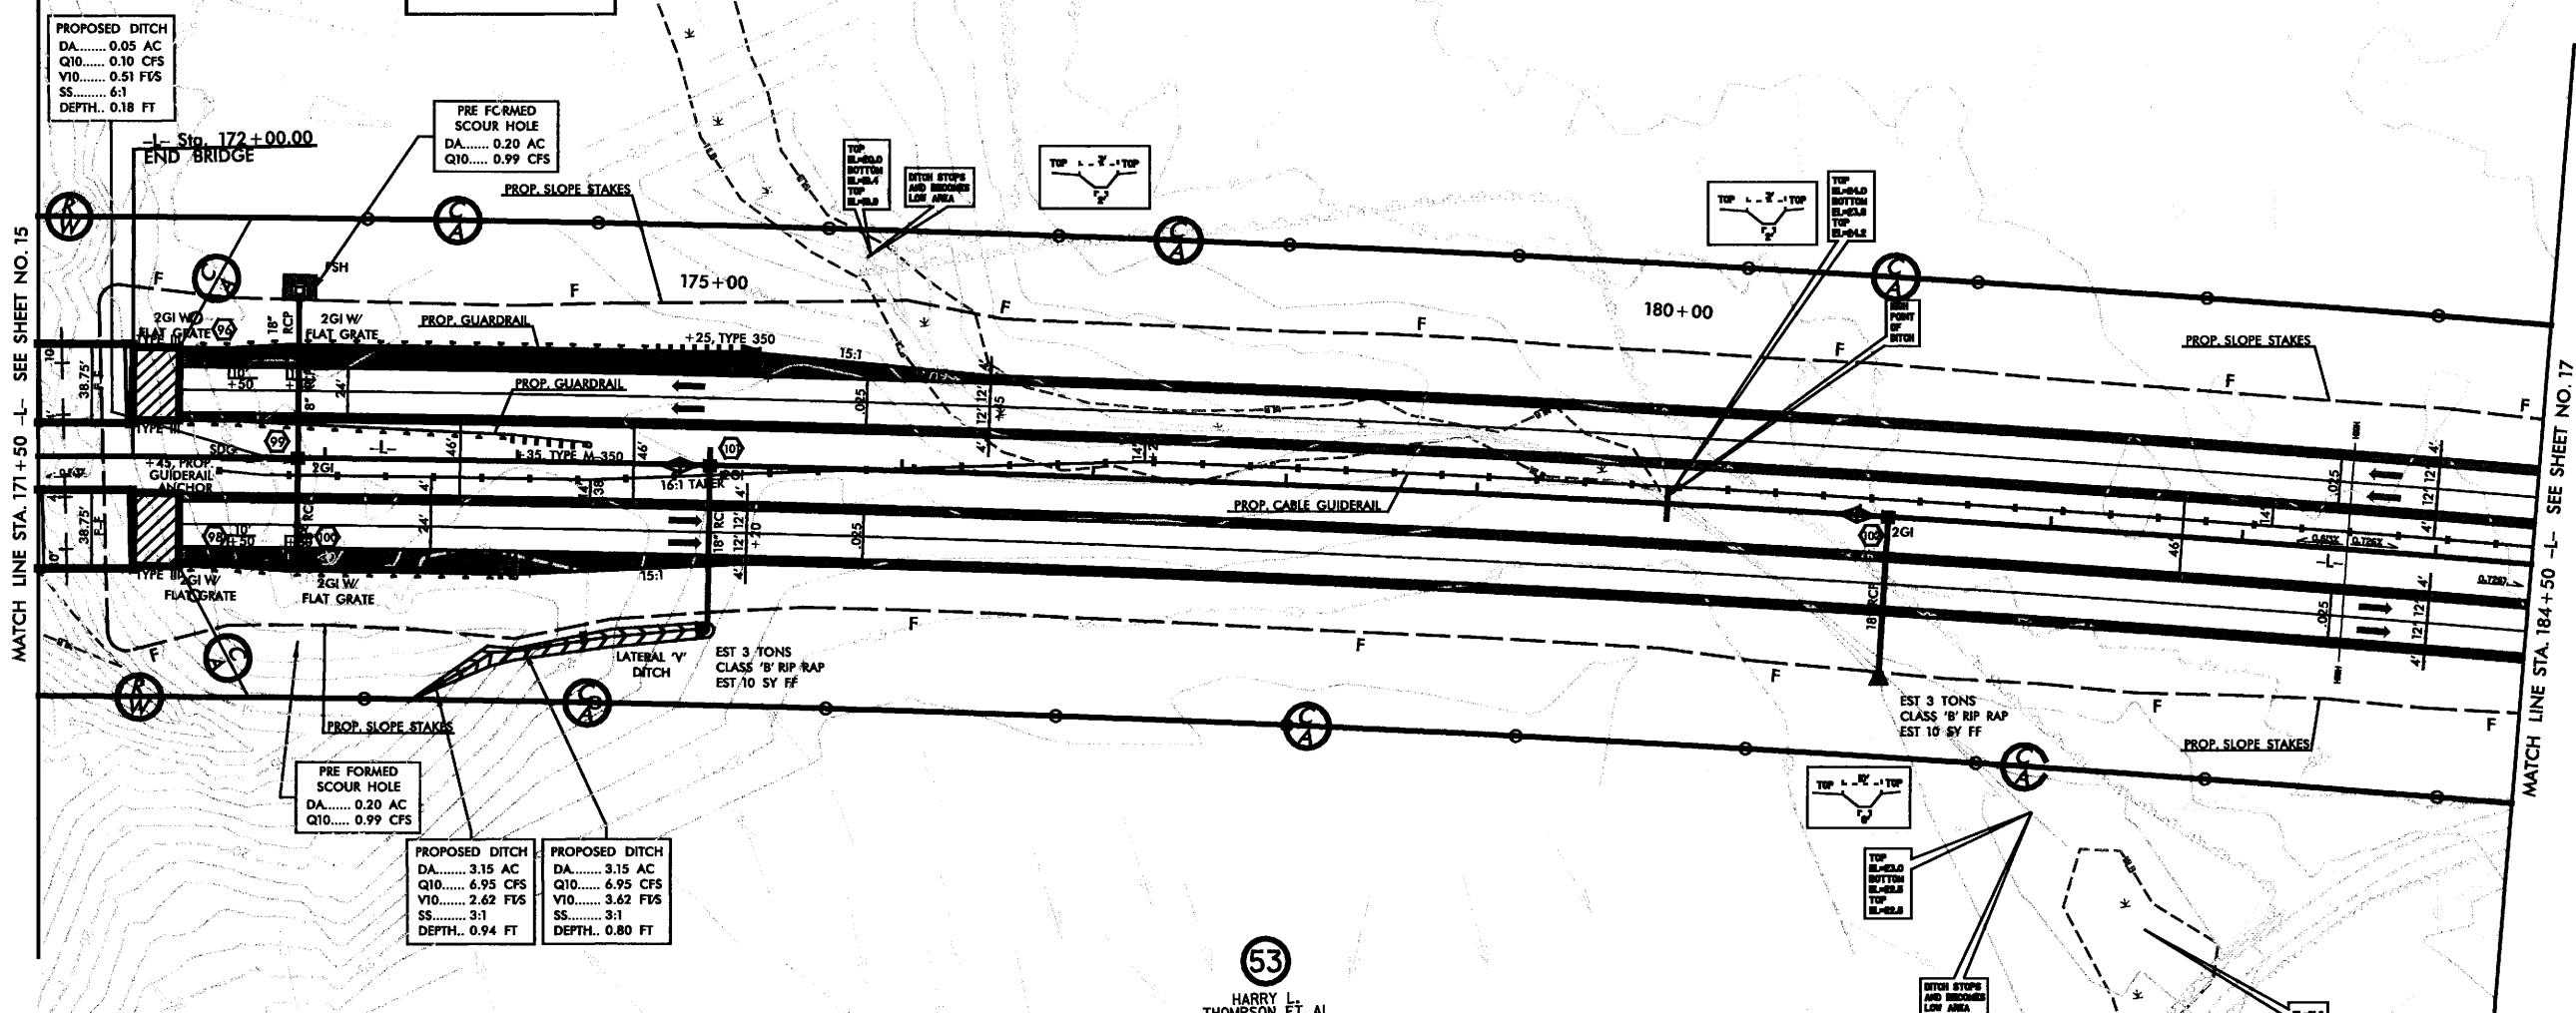


PROPOSED DITCH
DA..... 0.05 AC
Q10..... 0.10 CFS
V10..... 0.51 FVS
SS..... 6:1
DEPTH.. 0.18 FT

PRE FORMED SCOUR HOLE
DA..... 0.20 AC
Q10..... 0.99 CFS

PROPOSED DITCH
DA..... 3.15 AC
Q10..... 6.95 CFS
V10..... 2.62 FVS
SS..... 3:1
DEPTH.. 0.94 FT

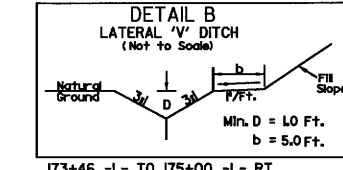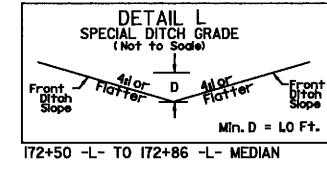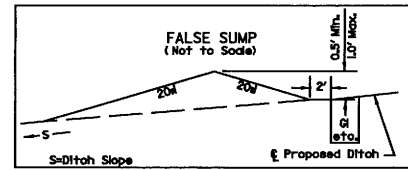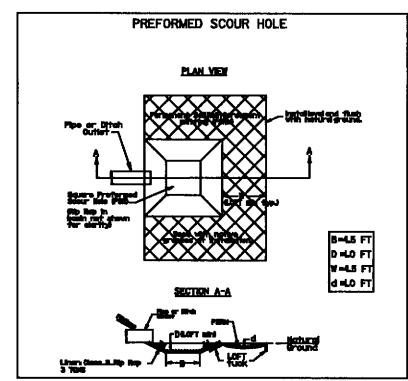

PROPOSED DITCH
DA..... 3.15 AC
Q10..... 6.95 CFS
V10..... 3.62 FVS
SS..... 3:1
DEPTH.. 0.80 FT




NOTES: SEE SHEET NO. 60-61 FOR -L- PROFILE.
SEE SHEET NO. 2-J FOR STRUCTURE DETAIL.
ALL CSP TO BE ROD AND LUG CONNECTED.

04/2005
2005/04/20
10:31:25 AM
C:\Users\jrd\Documents\Projects\2404A\2404A.dwg
2404A.dwg
18-04-04

REVISIONS

PROJECT REFERENCE NO. R-2404A	SHEET NO. 17
RW SHEET NO.	
ROADWAY DESIGN	HYDRAULICS ENGINEER
PRELIMINARY PLANS DO NOT USE FOR CONSTRUCTION	
 HDR Engineering, Inc. of the Carolinas 3733 National Drive, Suite 207 Raleigh, N.C. 27612	
 BARNHILL CONTRACTING COMPANY	

-L-
 PI = 186+35.23
 $\Delta = 13^\circ 56' 35.9''$ (RT)
 Dc = 0° 22' 55.1"
 L = 3,650.35'
 T = 1,834.24'
 R = 15,000.00'
 e = NC
 DS = 70 mph

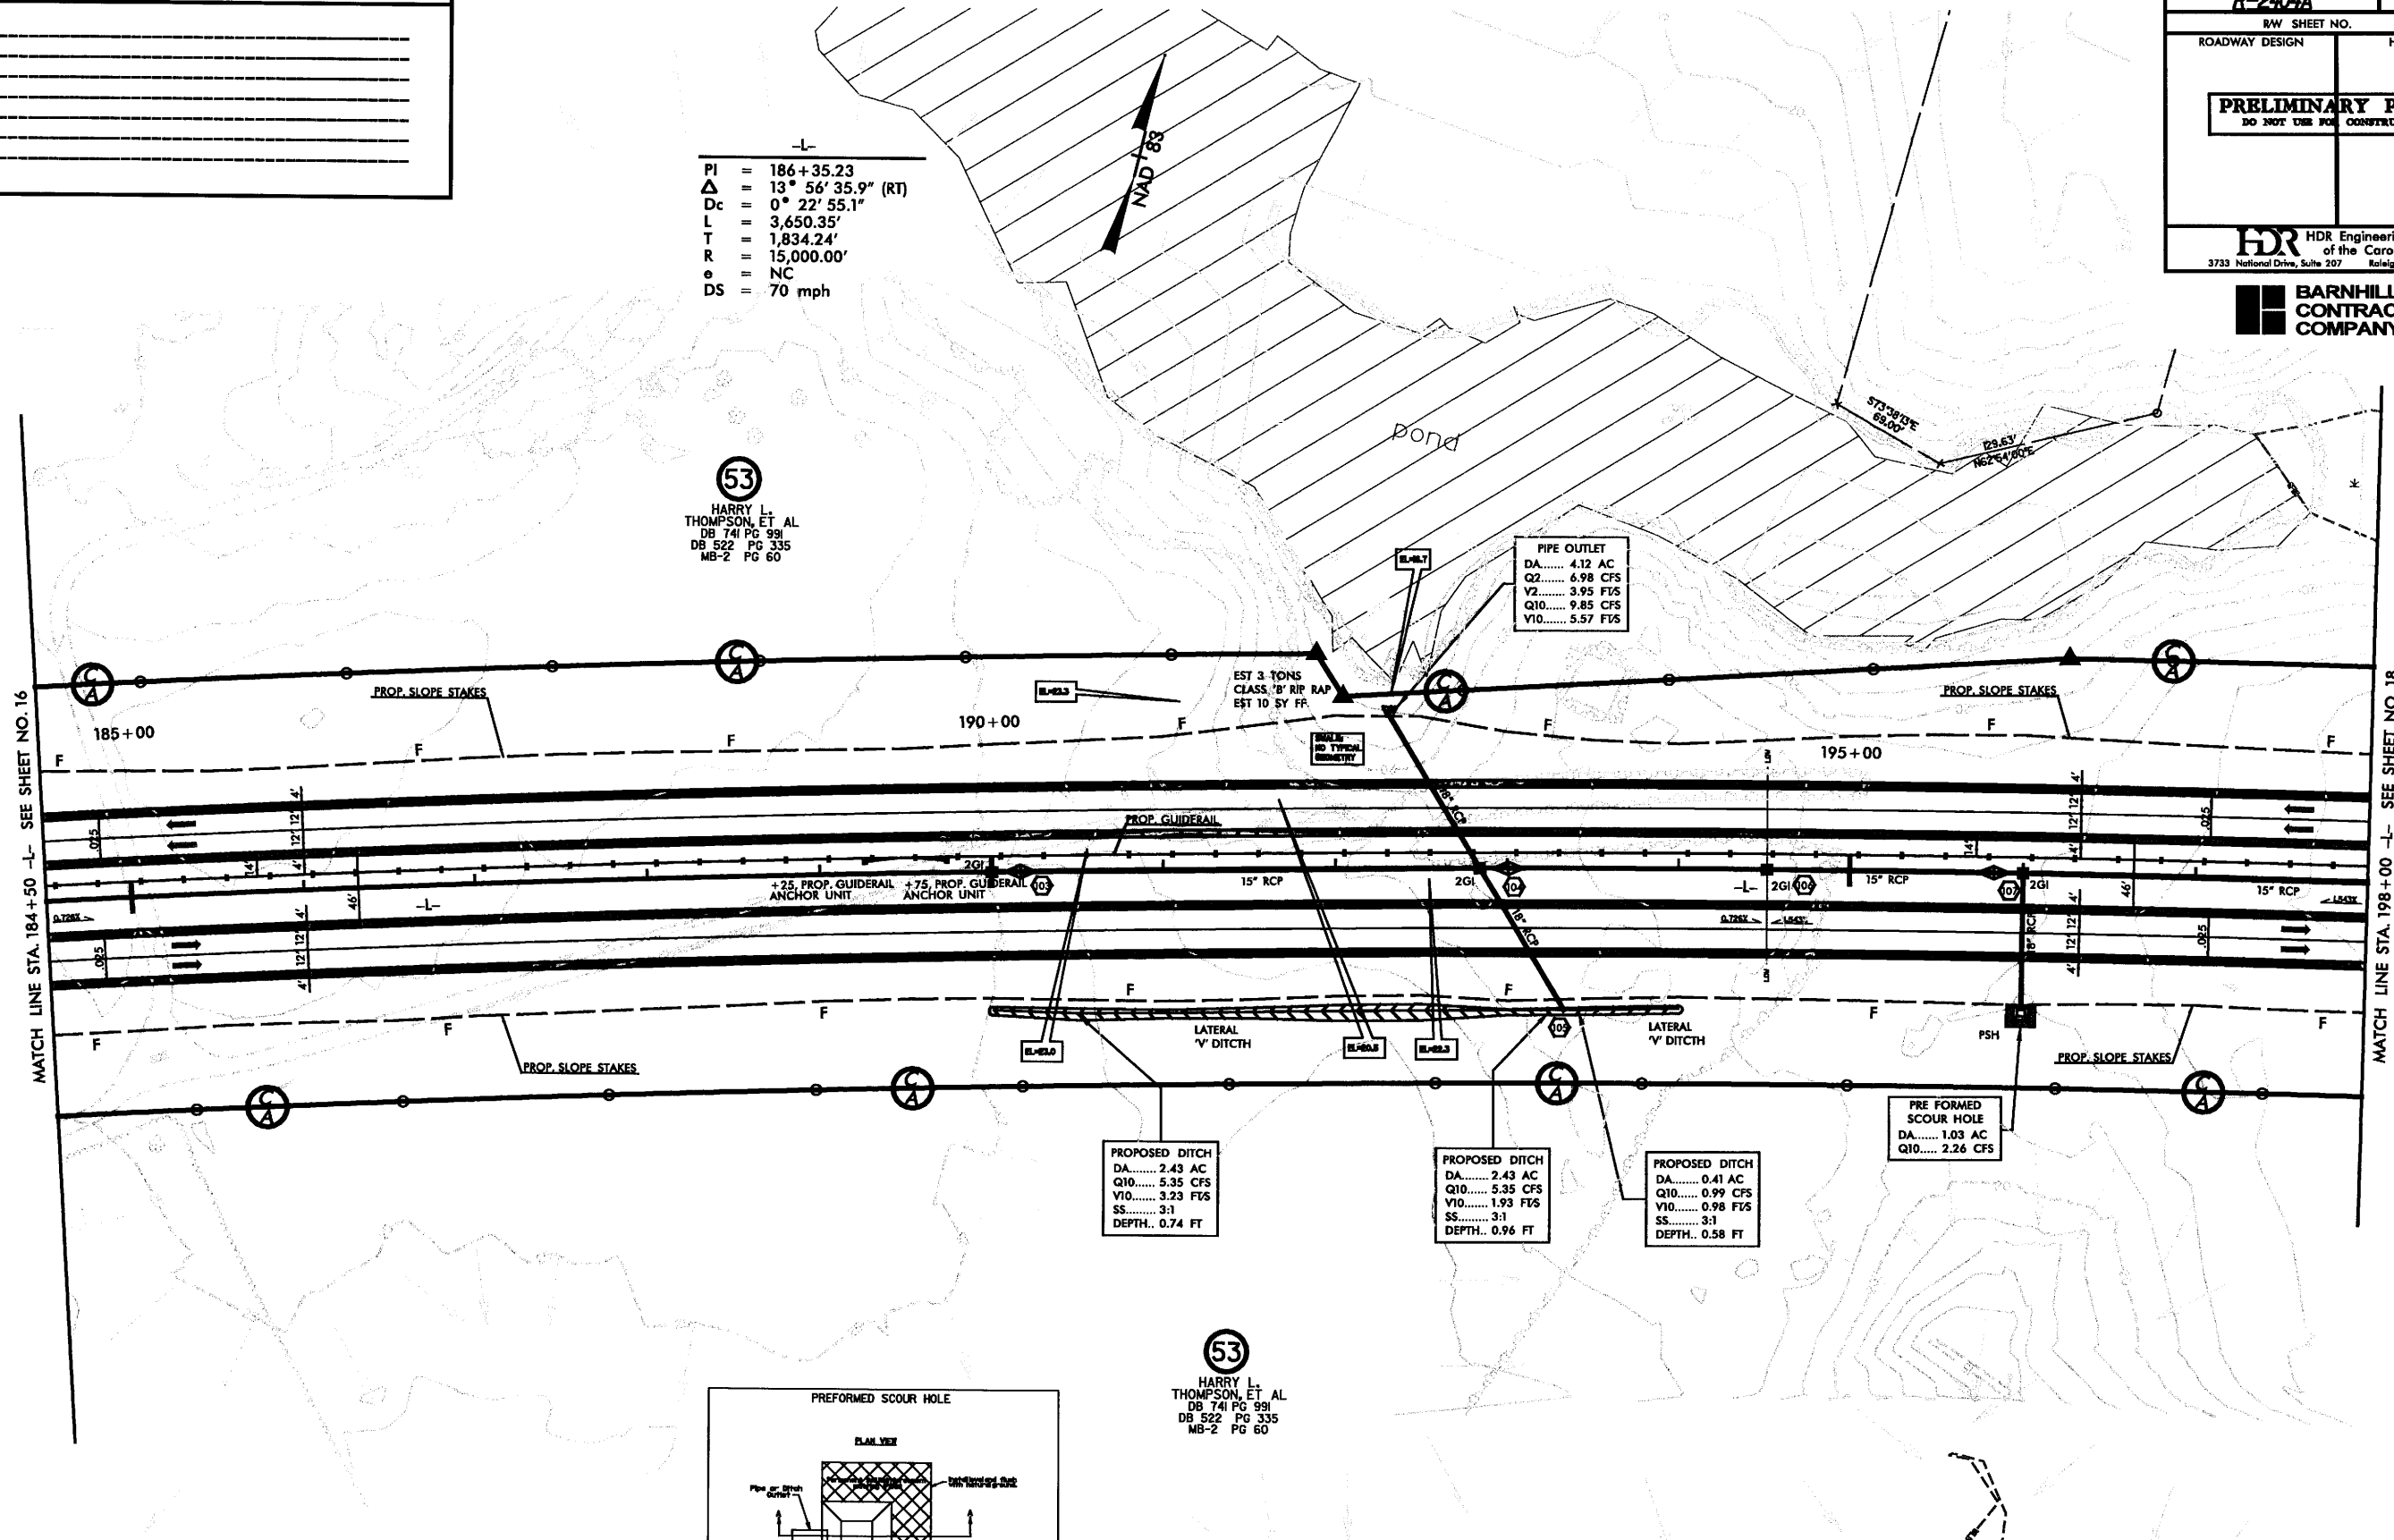

MATCH LINE STA. 184+50 -L- SEE SHEET NO. 16

MATCH LINE STA. 198+00 -L- SEE SHEET NO. 18

53
 HARRY L. THOMPSON, ET AL
 DB 741 PG 99
 DB 522 PG 335
 MB-2 PG 60

53
 HARRY L. THOMPSON, ET AL
 DB 741 PG 99
 DB 522 PG 335
 MB-2 PG 60

PIPE OUTLET
 DA..... 4.12 AC
 Q2..... 6.98 CFS
 V2..... 3.95 FFS
 Q10..... 9.85 CFS
 V10..... 5.57 FFS




PROPOSED DITCH
 DA..... 2.43 AC
 Q10..... 5.35 CFS
 V10..... 3.23 FFS
 SS..... 3:1
 DEPTH.. 0.74 FT

PROPOSED DITCH
 DA..... 2.43 AC
 Q10..... 5.35 CFS
 V10..... 1.93 FFS
 SS..... 3:1
 DEPTH.. 0.96 FT

PROPOSED DITCH
 DA..... 0.41 AC
 Q10..... 0.99 CFS
 V10..... 0.98 FFS
 SS..... 3:1
 DEPTH.. 0.58 FT


PRE FORMED SCOUR HOLE
 DA..... 1.03 AC
 Q10..... 2.26 CFS

- 103** 2G(B)
Sta. 190+00 M
D.A. = 0.98 Ac
Grate El= 27.90 ft
Invert= 25.15 ft
Depth= 2.75
- 104** 2G(B)
Sta. 192+84 M
D.A. = 0.3 Ac
Grate El= 25.87 ft
Invert= 19.63 ft
Depth= 6.24
- 106** OPEN END
Sta. 193+30 RT
D.A. = 2.84 Ac
Grate El= 21.0 ft
Invert= 21.0 ft
Depth= 0.0
- 108** 2G(B)
Sta. 194+52 M
D.A. = 0.18 Ac
Grate El= 25.33 ft
Invert= 22.58 ft
Depth= 2.75
- 107** 2G(B)
Sta. 196+00 M
D.A. = 0.32 Ac
Grate El= 25.75 ft
Invert= 21.84 ft
Depth= 3.90

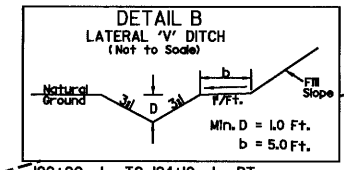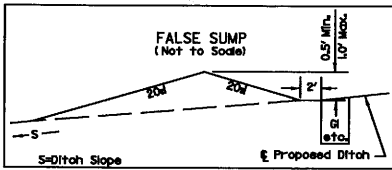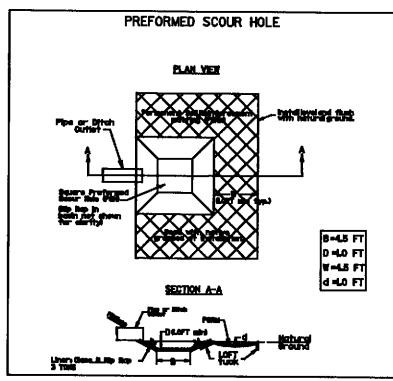

NOTES: SEE SHEET NO. 60 FOR -L- PROFILE.

REVISIONS

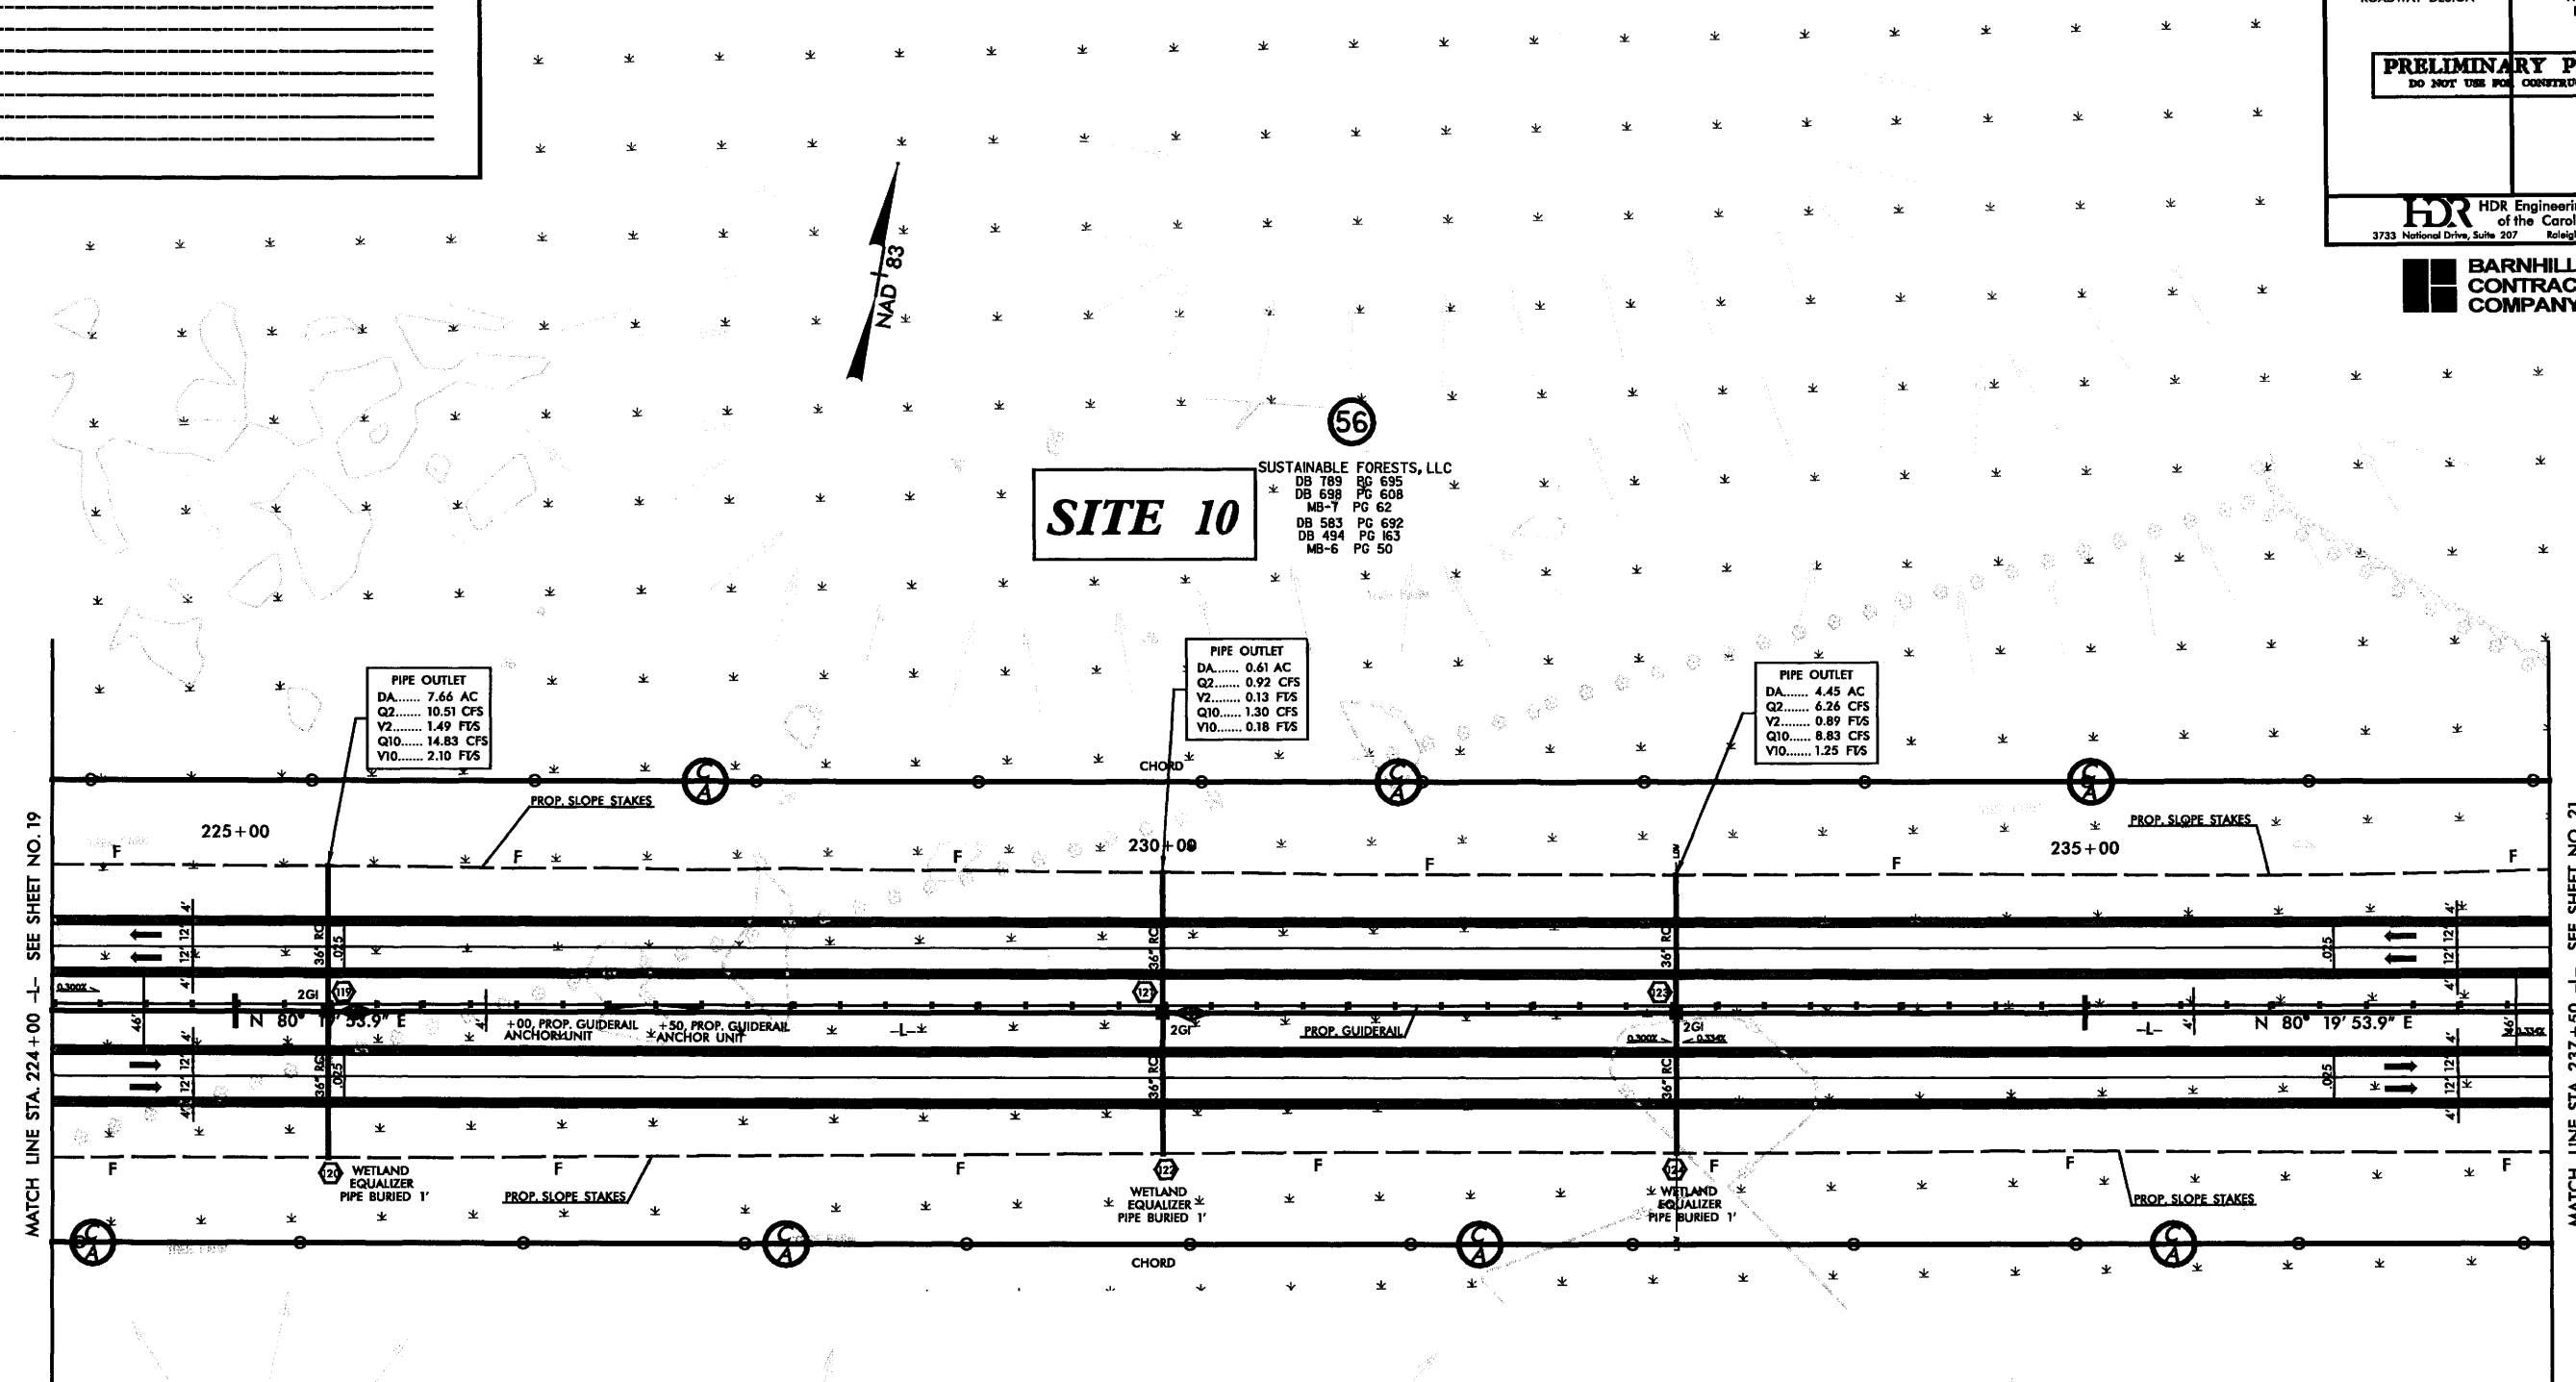

SITE 10

SUSTAINABLE FORESTS, LLC
 DB 789 PG 695
 DB 698 PG 608
 MB-7 PG 62
 DB 583 PG 692
 DB 494 PG 163
 MB-6 PG 50

PIPE OUTLET
 DA..... 7.66 AC
 Q2..... 10.51 CFS
 V2..... 1.49 FTS
 Q10..... 14.83 CFS
 V10..... 2.10 FTS

PIPE OUTLET
 DA..... 0.61 AC
 Q2..... 0.92 CFS
 V2..... 0.13 FTS
 Q10..... 1.30 CFS
 V10..... 0.18 FTS

PIPE OUTLET
 DA..... 4.45 AC
 Q2..... 6.26 CFS
 V2..... 0.89 FTS
 Q10..... 8.83 CFS
 V10..... 1.25 FTS


MATCH LINE STA. 224+00 -L- SEE SHEET NO. 19

MATCH LINE STA. 237+50 -L- SEE SHEET NO. 21

56

SUSTAINABLE FORESTS, LLC
 DB 789 PG 695
 DB 698 PG 608
 MB-7 PG 62
 DB 583 PG 692
 DB 494 PG 163
 MB-6 PG 50

- 119**
 2G(B)
 Sta. 225+50 M
 D.A. = 0.3 Ac
 Grate El= 40.15 ft
 Invert= 34.54 ft
 Depth= 5.61
- 120**
 OPEN END
 Sta. 225+50 RT
 D.A. = 7.36 Ac
 Grate El= 34.55 ft
 Depth= 0.0
- 121**
 2G(B)
 Sta. 230+00 M
 D.A. = 0.13 Ac
 Grate El= 38.86 ft
 Invert= 34.19 ft
 Depth= 4.68
- 122**
 OPEN END
 Sta. 230+00 RT
 D.A. = 0.13 Ac
 Grate El= 34.24 ft
 Depth= 0.0
- 123**
 2G(B)
 Sta. 232+79 M
 D.A. = 0.95 Ac
 Grate El= 38.65 ft
 Invert= 33.99 ft
 Depth= 4.66
- 124**
 OPEN END
 Sta. 232+79 RT
 D.A. = 3.5 Ac
 Grate El= 34.01 ft
 Invert= 34.01 ft
 Depth= 0.0

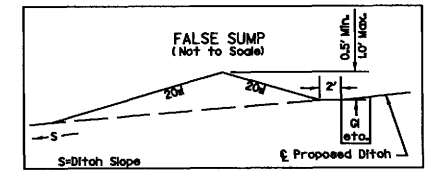


8/1/2005 10:58:20 AM \\s02\work\2404A\rd\2404A_rdw\20.dgn



REVISIONS

PROJECT REFERENCE NO. R-2404A	SHEET NO. 23
RW SHEET NO.	
ROADWAY DESIGN	HYDRAULICS ENGINEER
PRELIMINARY PLANS DO NOT USE FOR CONSTRUCTION	
HDR Engineering, Inc. of the Carolinas 3733 National Drive, Suite 207 Raleigh, N.C. 27612	
BARNHILL CONTRACTING COMPANY	

(56)
SUSTAINABLE FORESTS, LLC
DB 789 PG 695
DB 698 PG 608
MB-7 PG 62
DB 583 PG 692
DB 494 PG 163
MB-6 PG 50

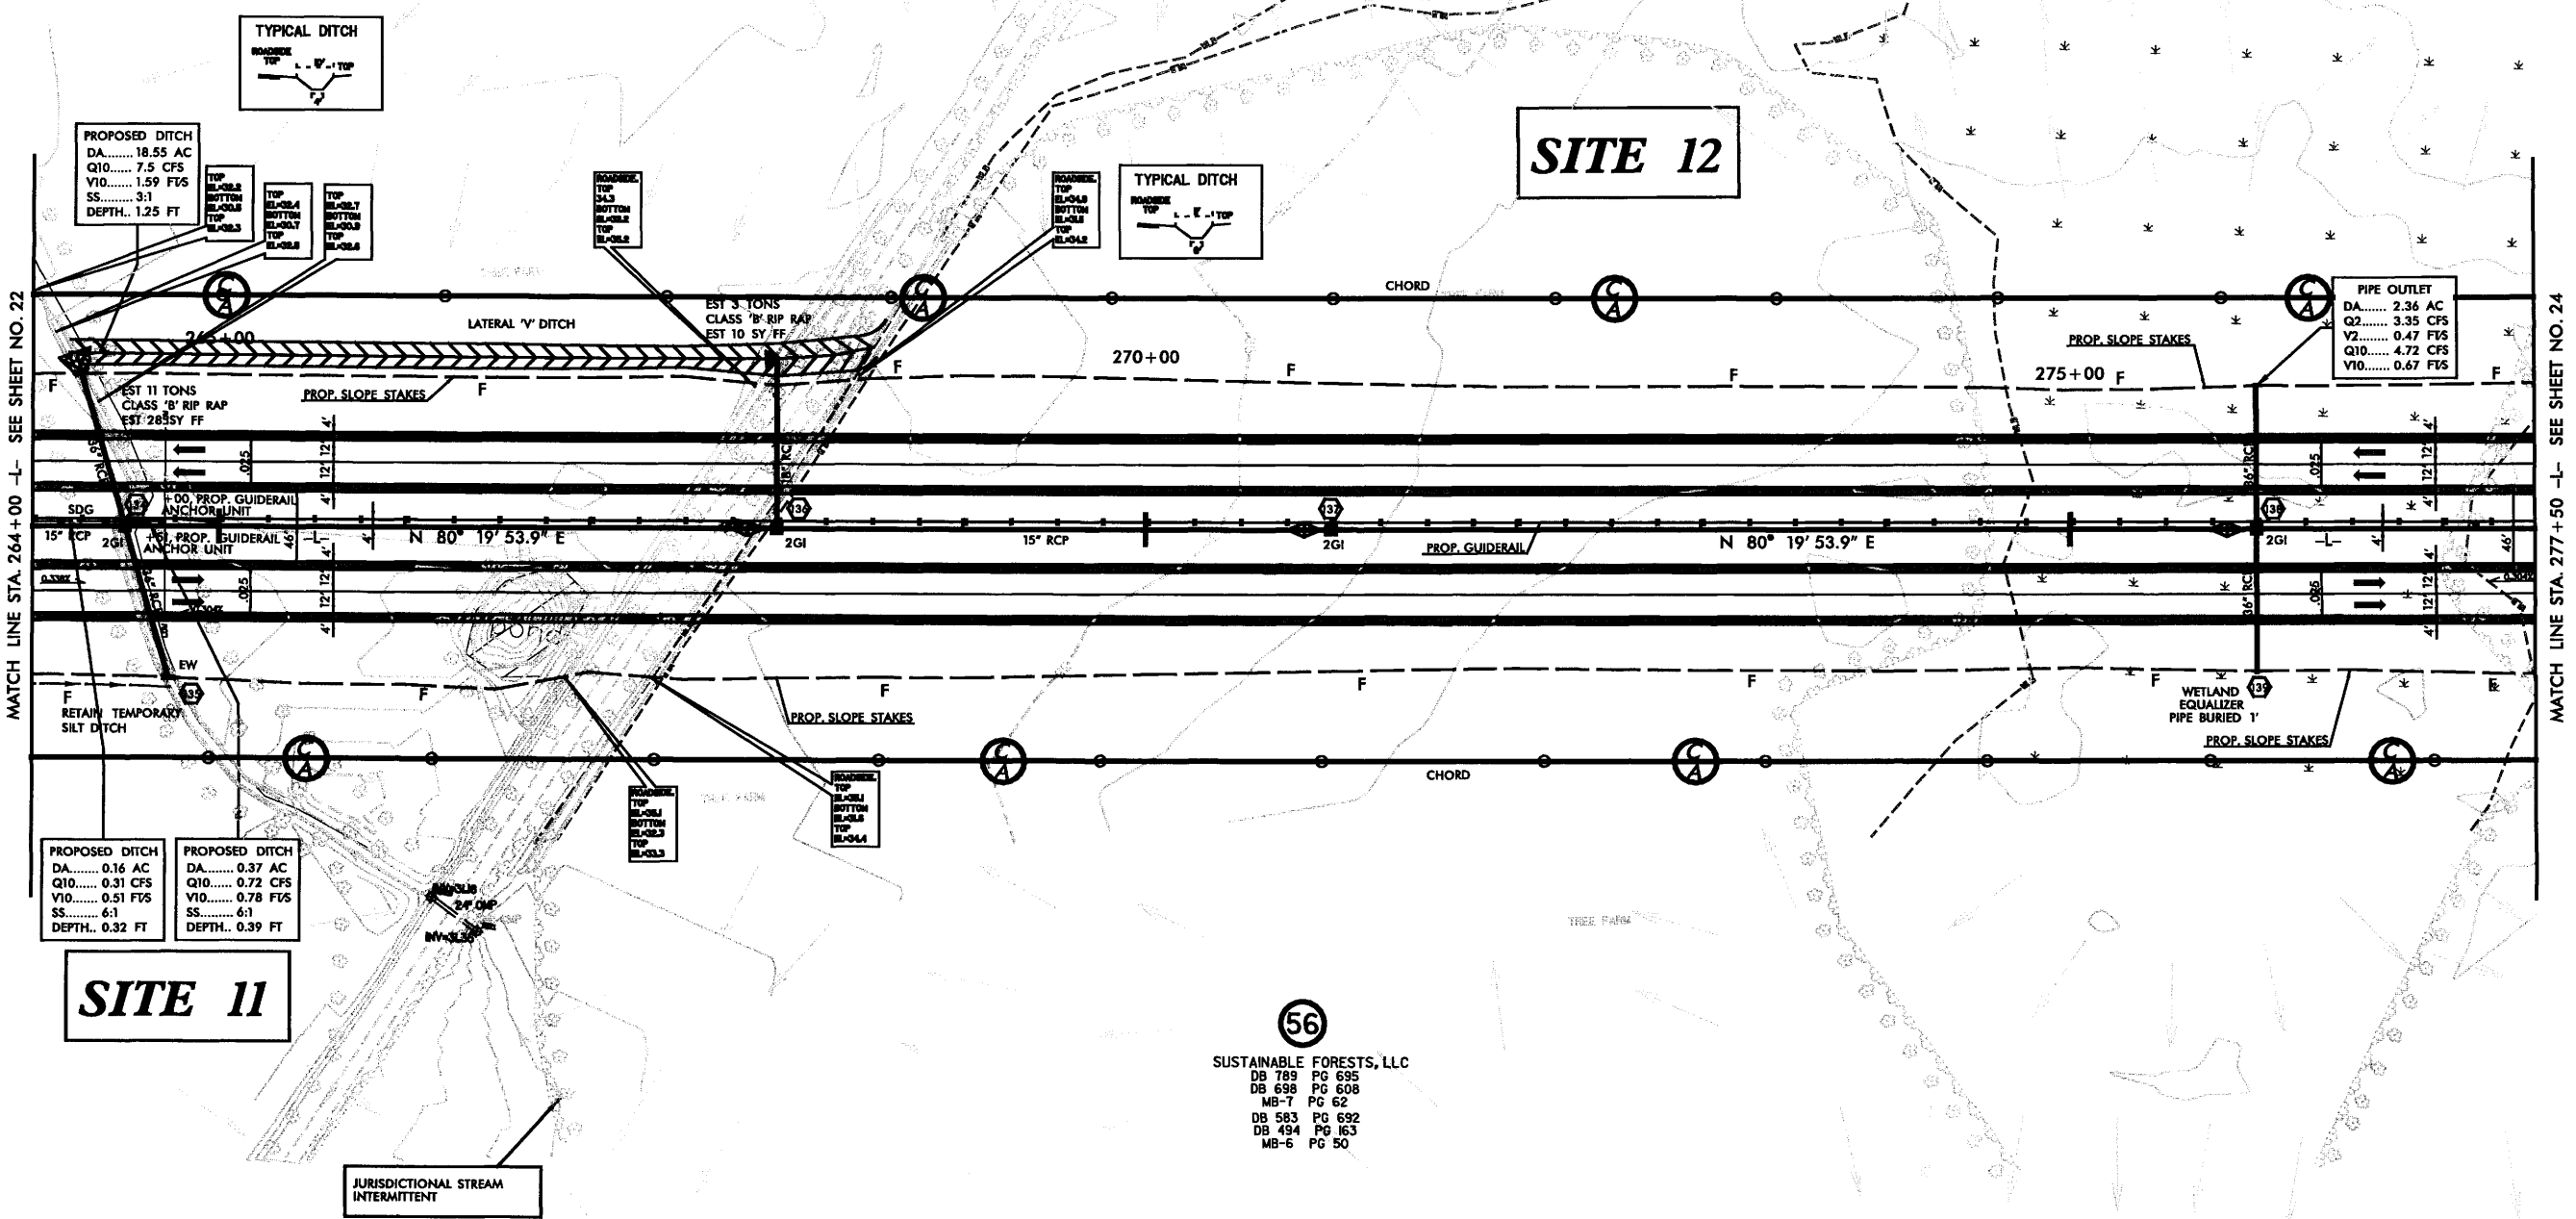

PROPOSED DITCH
DA..... 18.55 AC
Q10..... 7.5 CFS
V10..... 1.59 FFS
SS..... 3:1
DEPTH.. 1.25 FT

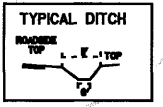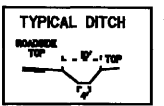

PROPOSED DITCH
DA..... 0.16 AC
Q10..... 0.31 CFS
V10..... 0.51 FFS
SS..... 6:1
DEPTH.. 0.32 FT

PROPOSED DITCH
DA..... 0.37 AC
Q10..... 0.72 CFS
V10..... 0.78 FFS
SS..... 6:1
DEPTH.. 0.39 FT

PIPE OUTLET
DA..... 2.36 AC
Q2..... 3.35 CFS
V2..... 0.47 FFS
Q10..... 4.72 CFS
V10..... 0.67 FFS

SITE 11

SITE 12

(56)
SUSTAINABLE FORESTS, LLC
DB 789 PG 695
DB 698 PG 608
MB-7 PG 62
DB 583 PG 692
DB 494 PG 163
MB-6 PG 50




134 2G(B)
Sta. 264+50 M
D.A. = 0.53 Ac
Grate El= 38.80 ft
Invert= 30.85 ft
Depth= 7.95

135 OPEN END
Sta. 264+73 RT
D.A. = 98.98 Ac
Grate El= 31.10 ft
Invert= 31.10 ft
Depth= 0.0

136 2G(B)
Sta. 268+00 M
D.A. = 0.32 Ac
Grate El= 39.30 ft
Invert= 36.30 ft
Depth= 3.0

137 2G(B)
Sta. 271+00 M
D.A. = 0.53 Ac
Grate El= 40.20 ft
Invert= 37.45 ft
Depth= 2.75



138 2G(B)
Sta. 276+00 M
D.A. = 0.39 Ac
Grate El= 41.52 ft
Invert= 39.49 ft
Depth= 6.04

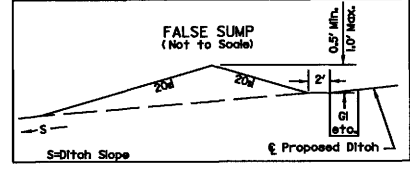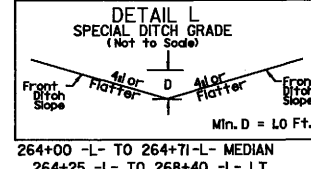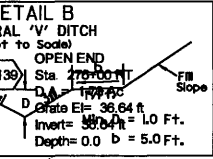

NOTES: SEE SHEET NO. 63 FOR -L- PROFILE.
DO NOT PLACE ROCK IN BED OF JURISDICTIONAL STREAMS.

8/1/2005 10:46:05 AM I:\Projects\2404\Drawings\2404A.dwg, h:_Redline_08-23.dwg


REVISIONS

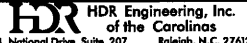PROJECT REFERENCE NO. R-2404A	SHEET NO. 24
RW SHEET NO.	
ROADWAY DESIGN	HYDRAULICS ENGINEER
PRELIMINARY PLANS DO NOT USE FOR CONSTRUCTION	
 FDR HDR Engineering, Inc. of the Carolinas 3733 National Drive, Suite 207 Raleigh, N.C. 27612	
 BARNHILL CONTRACTING COMPANY	

SITE 12


56
SUSTAINABLE FORESTS, LLC
DB 789 PG 695
DB 698 PG 608
MB-7 PG 62
DB 583 PG 692
DB 494 PG 163
MB-6 PG 50

56
SUSTAINABLE FORESTS, LLC
DB 789 PG 695
DB 698 PG 608
MB-7 PG 62
DB 583 PG 692
DB 494 PG 163
MB-6 PG 50

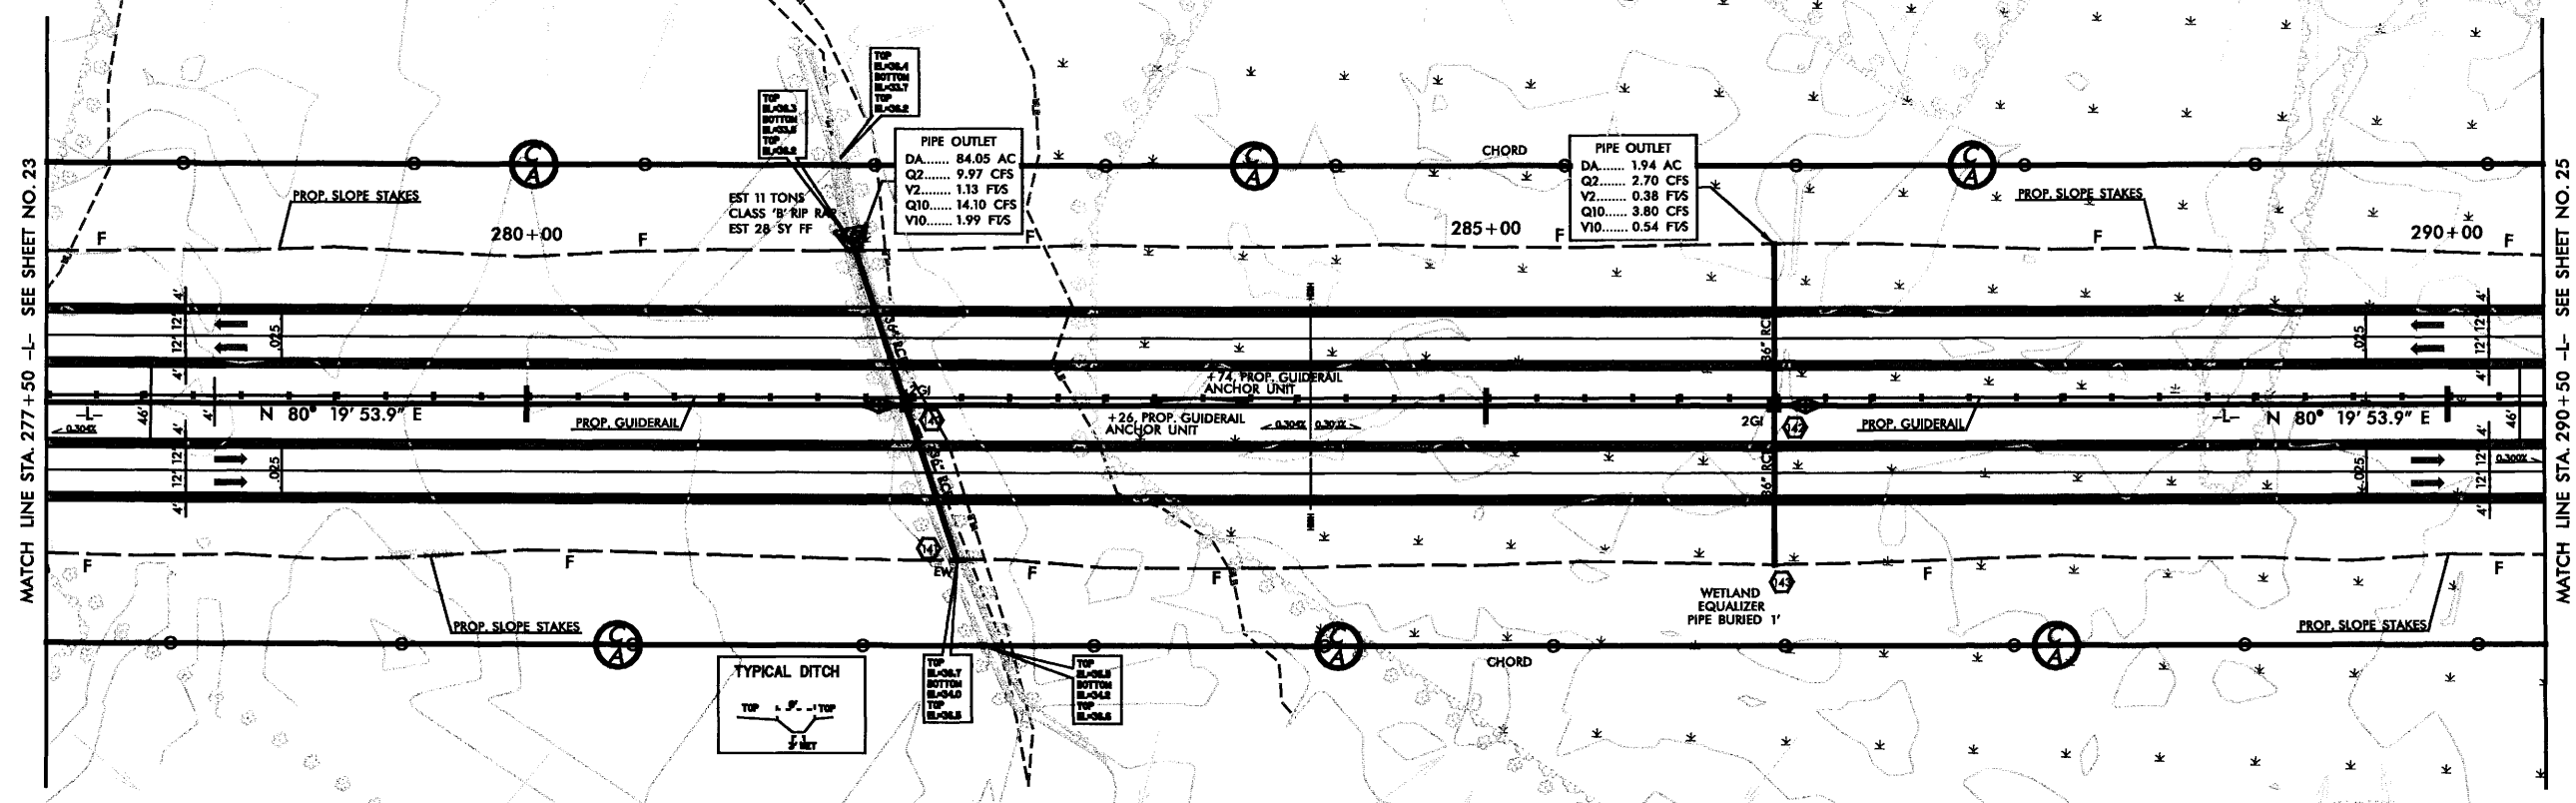

MATCH LINE STA. 277+50 -L- SEE SHEET NO. 23

MATCH LINE STA. 290+50 -L- SEE SHEET NO. 25

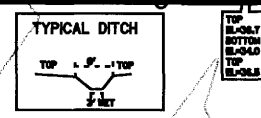


140 2GI(B)
Sta. 281+98 M
D.A. = 0.22 Ac
Grate EI= 42.29 ft
Invert= 33.90 ft
Depth= 8.39

141 OPEN END
Sta. 282+24 RT
D.A. = 83.83 Ac
Grate EI= 34.0 ft
Depth= 0.0

142 2GI(B)
Sta. 286+50 M
D.A. = 0.28 Ac
Grate EI= 42.27 ft
Invert= 35.10 ft
Depth= 7.18

143 OPEN END
Sta. 286+50 RT
D.A. = 1.68 Ac
Grate EI= 35.37 ft
Invert= 35.37 ft
Depth= 0.0

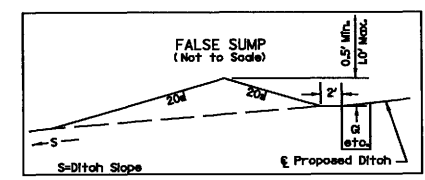


NOTES: SEE SHEET NO. 63-64 FOR -L- PROFILE

8/1/2005 10:43:51 AM \\p2404a\Redline\p2404a.tbl Redline.pch 24.dgn

REVISIONS	

-L-

Pk	=	292+43.57	*
Δ	=	7° 36' 11.3" (RT)	*
Dc	=	0° 45' 50.2"	*
Os	=	0° 45' 50.2"	*
Ls	=	200.00'	*
Ts	=	598.37'	*
Lc	=	795.25'	*
Rc	=	7,500.00'	*
LT	=	133.33'	*
ST	=	66.67'	*
e	=	0.03	*
DS	=	70 mph	*




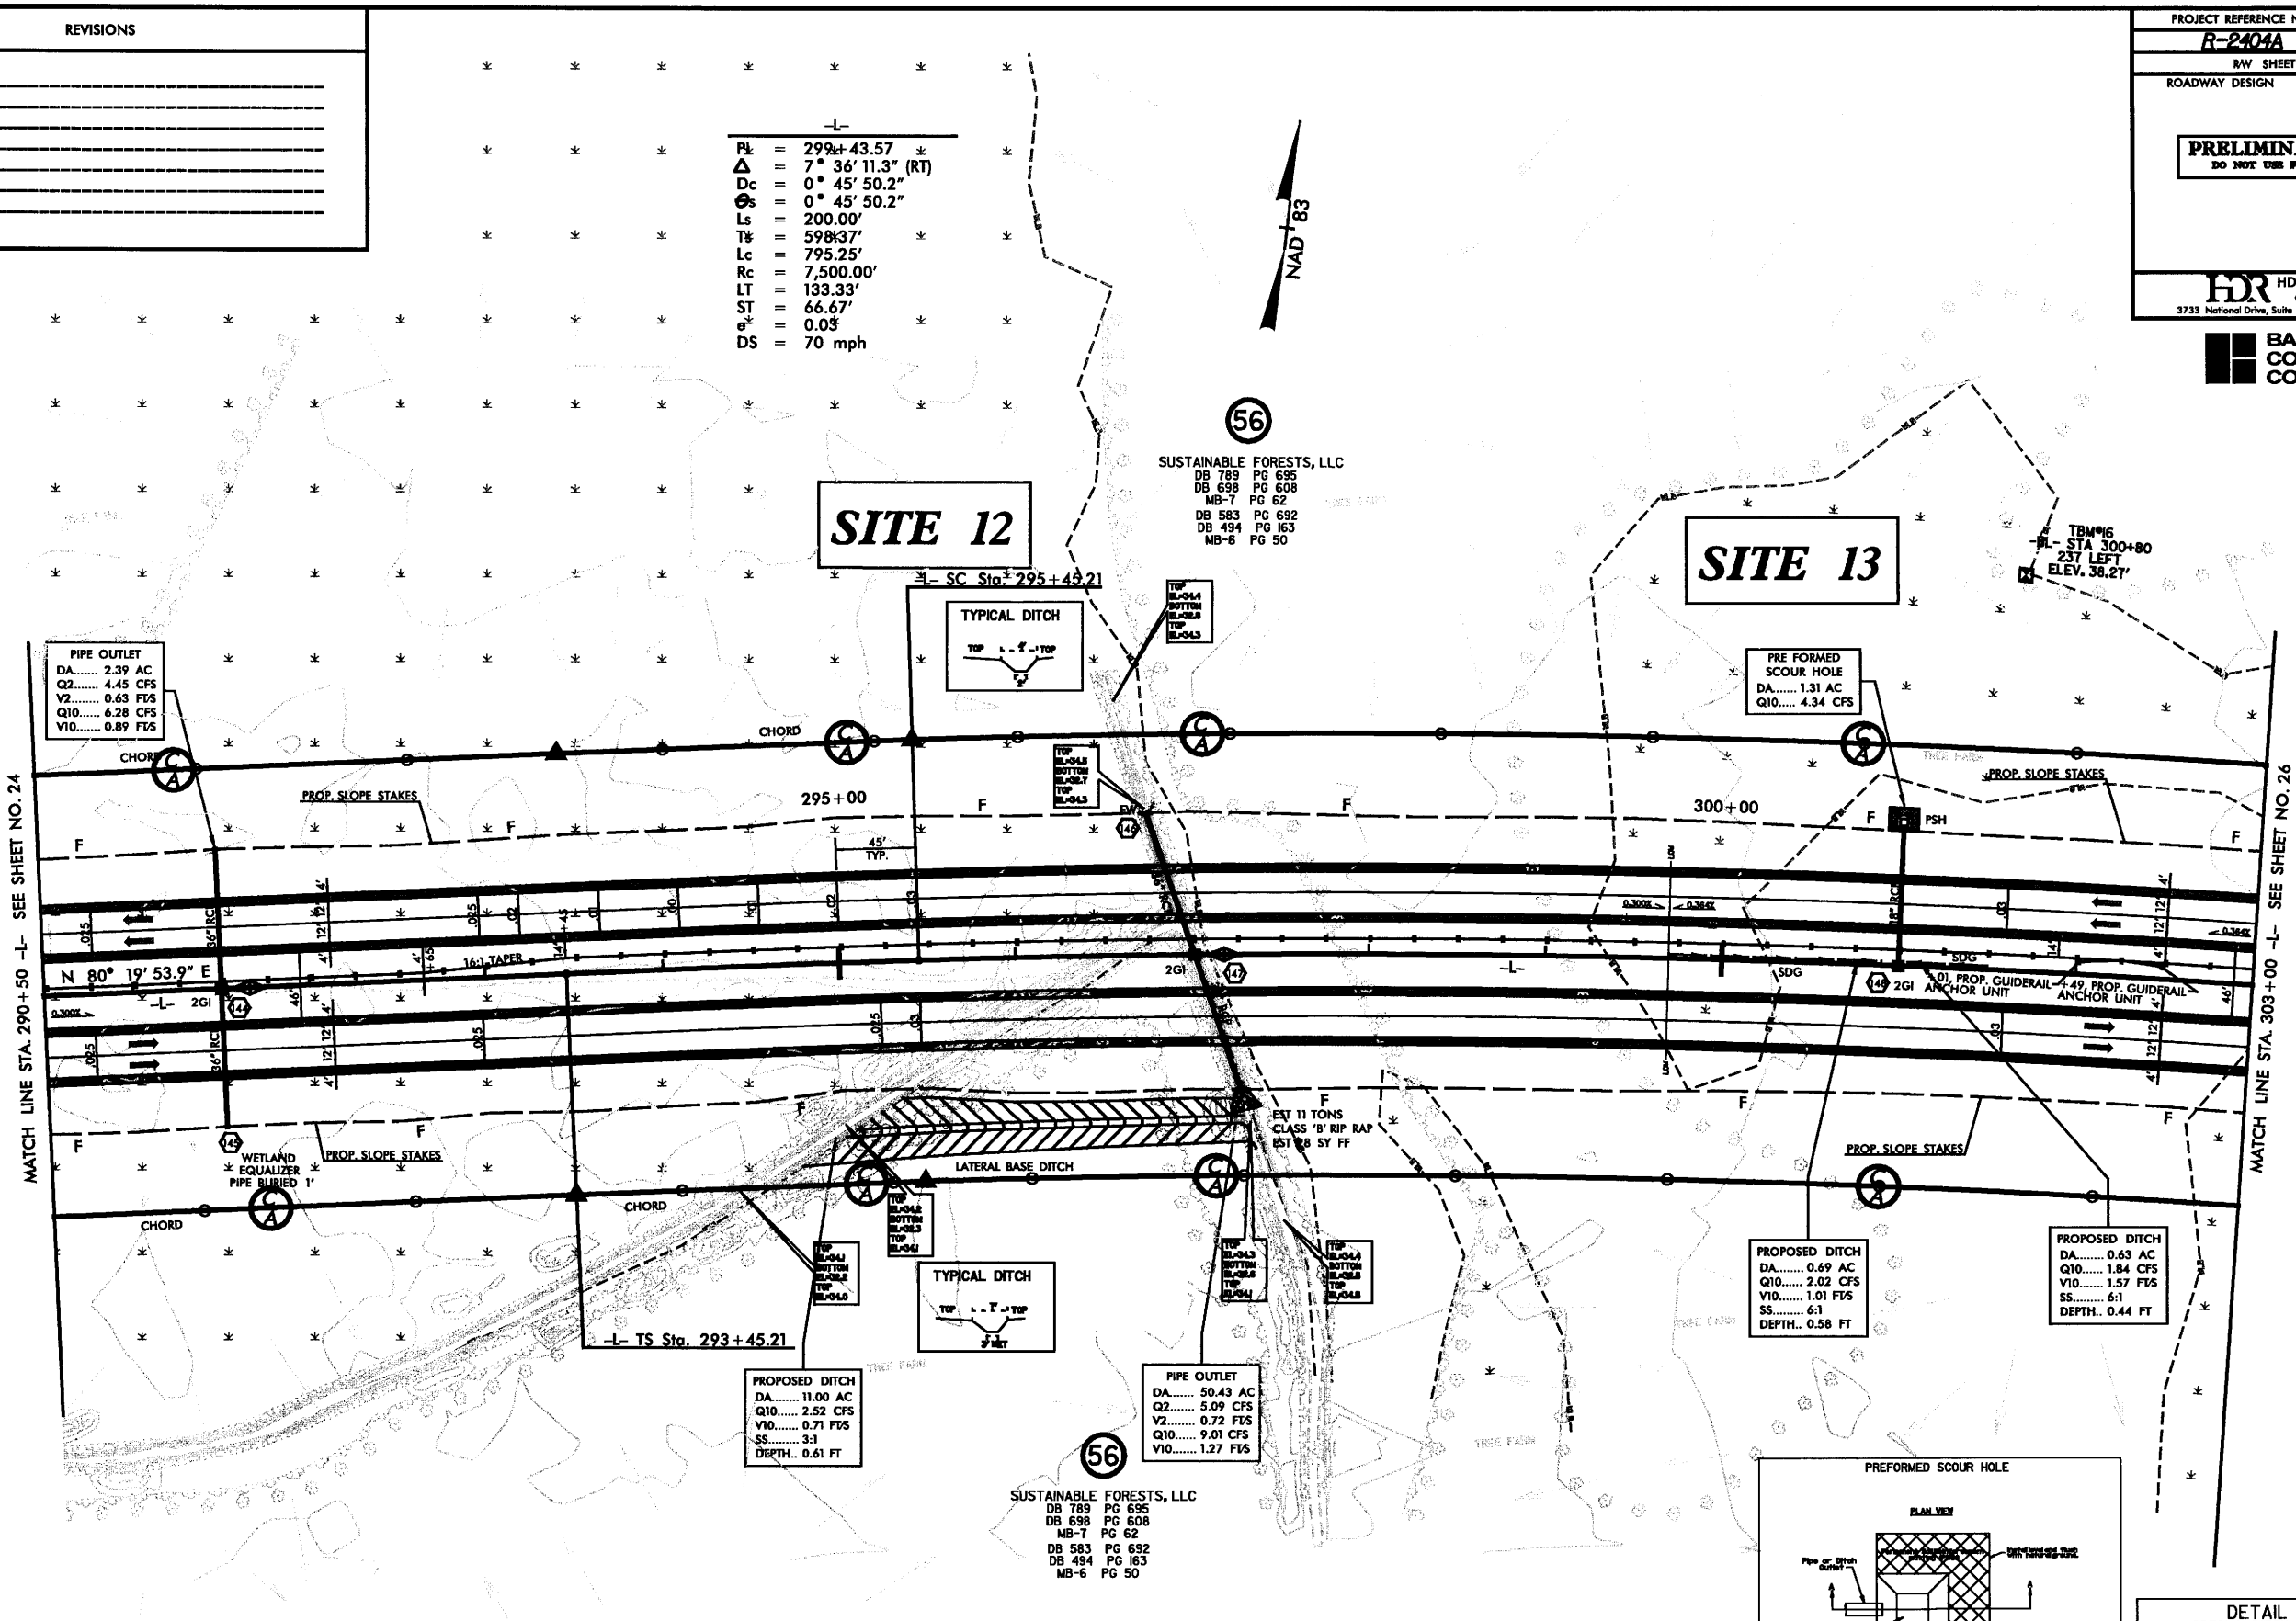


MATCH LINE STA. 290+50 -L- SEE SHEET NO. 24

MATCH LINE STA. 303+00 -L- SEE SHEET NO. 26

- (144) 2G(B) Sta. 291+50 M D.A. = 0.53 Ac Grate El= 41.65 ft Invert= 36.15 ft Depth= 5.51
- (145) OPEN END Sta. 291+50 RT D.A.= 1.86 Ac Grate El= 36.32 ft Invert= 36.32 ft Depth= 0.0
- (146) OPEN END Sta. 296+75 LT D.A.= 49.72 Ac Grate El= 32.70 ft Invert= 32.70 ft Depth= 0.0
- (147) 2G(B) Sta. 297+01 M D.A. = 0.76 Ac Grate El= 40.26 ft Invert= 32.65 ft Depth= 7.61
- (148) 2G(D) Sta. 301+00 M D.A. = 1.31 Ac Grate El= 39.57 ft Invert= 36.82 ft Depth= 2.75

(56) SUSTAINABLE FORESTS, LLC
DB 789 PG 695
DB 698 PG 608
MB-7 PG 62
DB 583 PG 692
DB 494 PG 163
MB-6 PG 50

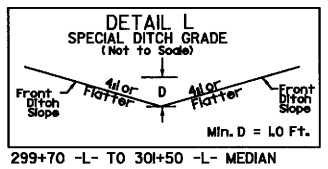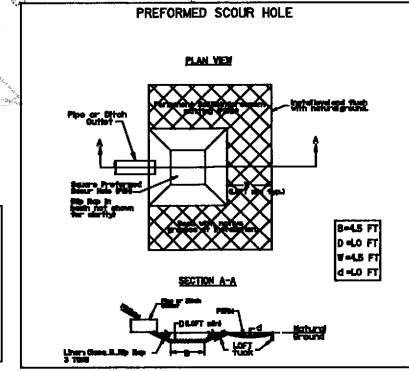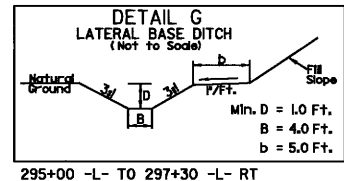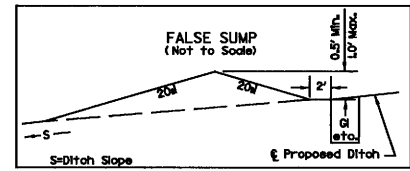

NOTES: SEE SHEET NO. 64 FOR -L- PROFILE.

8/1/2005 10:42:03 AM 240404A.dwg 25/64

REVISIONS

PROJECT REFERENCE NO. R-2404A	SHEET NO. 26
R/W SHEET NO.	HYDRAULICS ENGINEER
PRELIMINARY PLANS DO NOT USE FOR CONSTRUCTION	
HDR Engineering, Inc. of the Carolinas 3733 National Drive, Suite 207 Raleigh, N.C. 27612	
BARNHILL CONTRACTING COMPANY	

PI	=	336+13.09
D	=	23° 52' 20.2" (LT)
Dc	=	0° 34' 22.6"
Fs	=	0° 34' 22.6"
Ls	=	200.00'
Ts	=	2,213.95'
Lc	=	3,966.50'
Rc	=	10,000.00'
LT	=	133.33'
ST	=	66.67'
e	=	0.03
DS	=	70 mph

PI	=	299+43.57
Δ	=	7° 36' 11.3" (RT)
Dc	=	0° 45' 50.2"
Fs	=	0° 45' 50.2"
Ls	=	200.00'
Ts	=	598.37'
Lc	=	795.25'
Rc	=	7,500.00'
LT	=	133.33'
ST	=	66.67'
e	=	0.03
BS	=	70 mph

56
SUSTAINABLE FORESTS, LLC
DB 789 PG 695
DB 698 PG 608
MB-7 PG 62
DB 583 PG 692
DB 494 PG 163
MB-6 PG 50

SITE 13


SITE 14

PROPOSED DITCH
DA..... 33.76 AC
Q10..... 12.5 CFS
V10..... 2.75 FFS
SS..... 3:1
DEPTH..... 1.23 FT



PIPE OUTLET
DA..... 3.57 AC
Q2..... 6.37 CFS
V2..... 0.90 FFS
Q10..... 8.00 CFS
V10..... 1.58 FFS



PIPE OUTLET
DA..... 2.21 AC
Q2..... 3.12 CFS
V2..... 0.44 FFS
Q10..... 4.39 CFS
V10..... 0.62 FFS

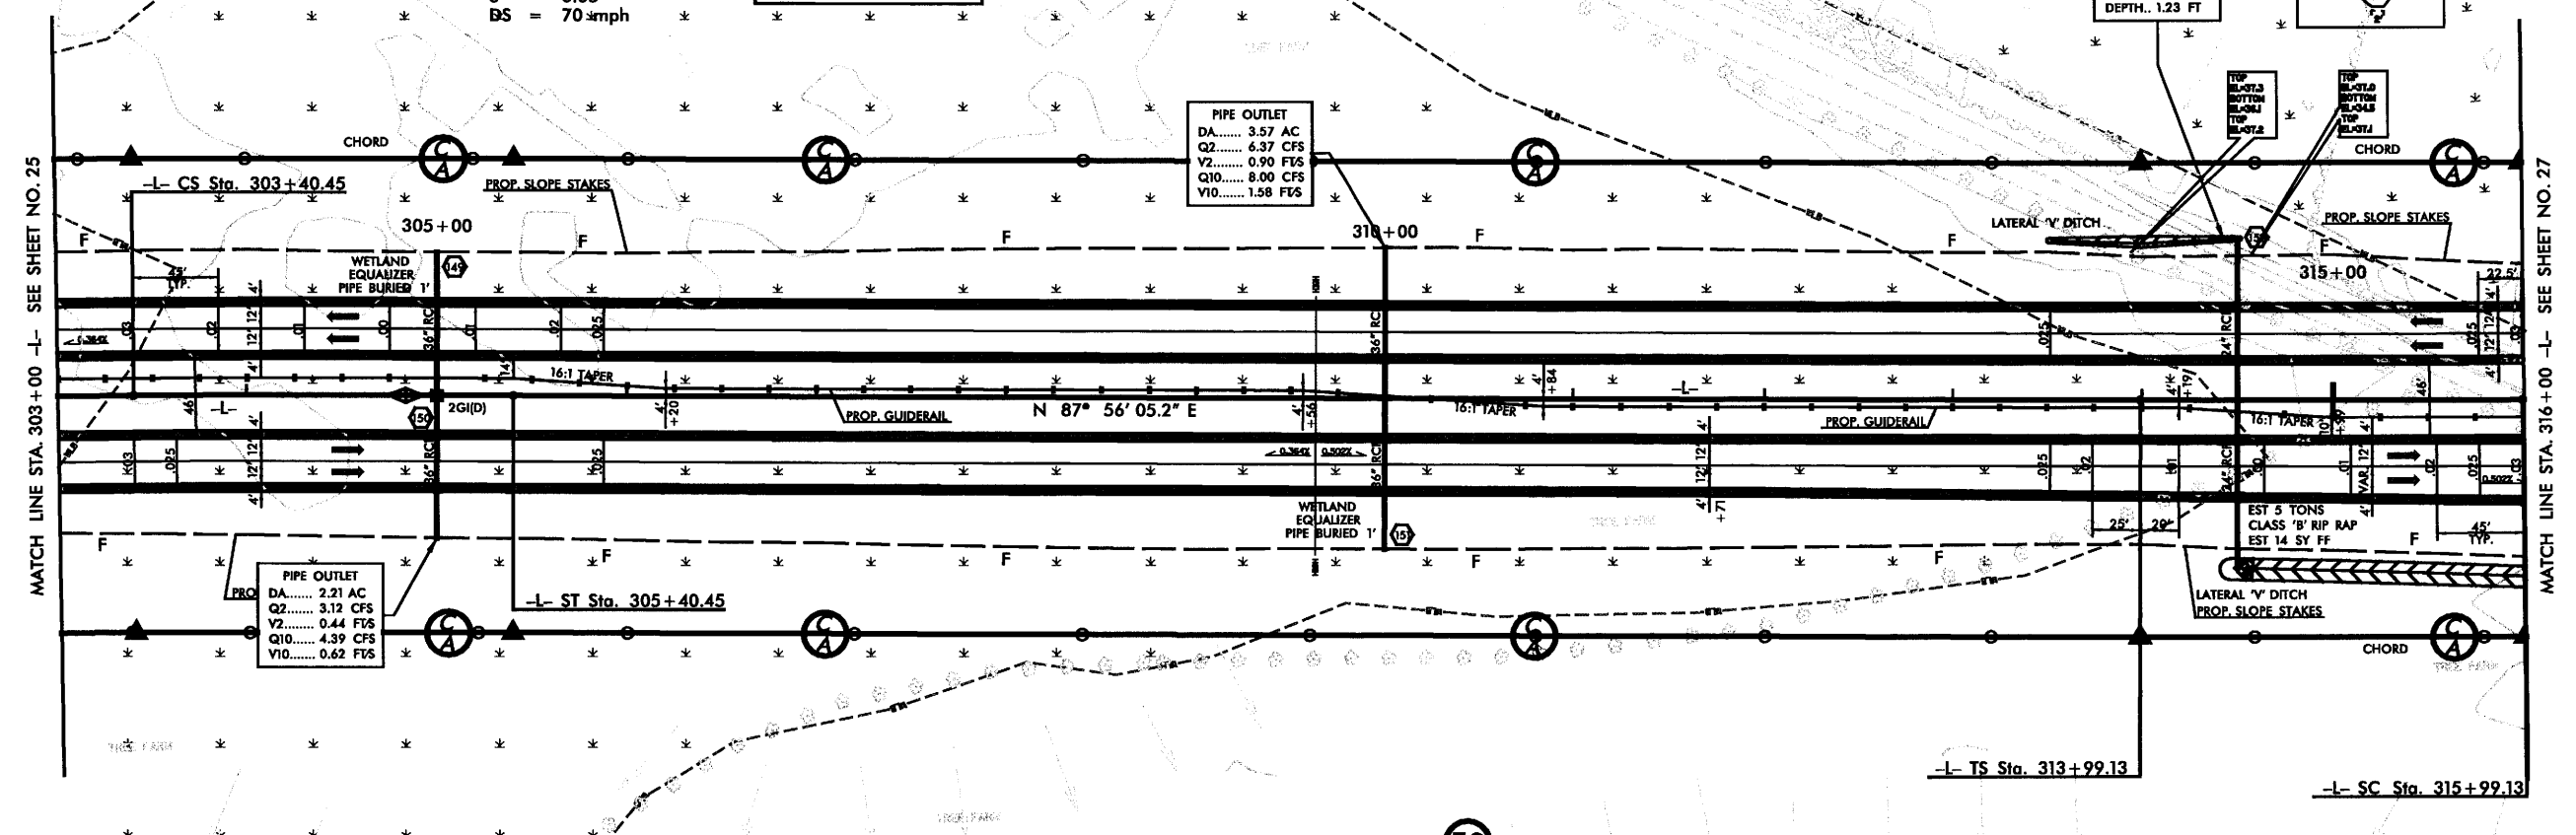

56
SUSTAINABLE FORESTS, LLC
DB 789 PG 695
DB 698 PG 608
MB-7 PG 62
DB 583 PG 692
DB 494 PG 163
MB-6 PG 50

149 OPEN END
Sta. 305+00 LT
D.A. = 1.72 Ac
Grate El. = 37.05 ft
Invert = 37.05 ft
Depth = 0.0

150 2GI(D)
Sta. 305+00 M
D.A. = 0.49 Ac
Grate El. = 41.11 ft
Invert = 36.86 ft
Depth = 4.25

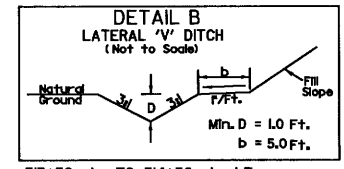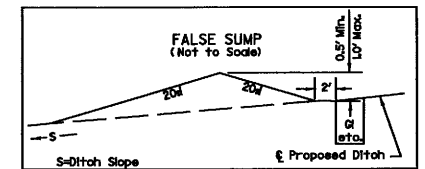

313+50 -L- TO 314+50 -L- LT
314+50 -L- TO 318+50 -L- RT


NOTES: SEE SHEET NO. 65 FOR -L- PROFILE.

8/1/2005 10:45:37 AM
 C:\Users\jmc\Documents\2404A\2404A.dwg
 2404A.dwg

PI = 336+13.09
 D = 23° 52' 20.2" (LT)
 Dc = 0° 34' 22.6"
 Fs = 0° 34' 22.6"
 Ls = 200.00'
 Ts = 2,213.95'
 Lc = 3,966.50'
 Rc = 10,000.00'
 LT = 133.33'
 ST = 66.67'
 e = 0.03
 DS = 70 mph

SITE 14

(56) SUSTAINABLE FORESTS, LLC
 DB 789 PG 695
 DB 698 PG 608
 MB-7 PG 62
 DB 583 PG 682
 DB 494 PG 163
 MB-6 PG 50

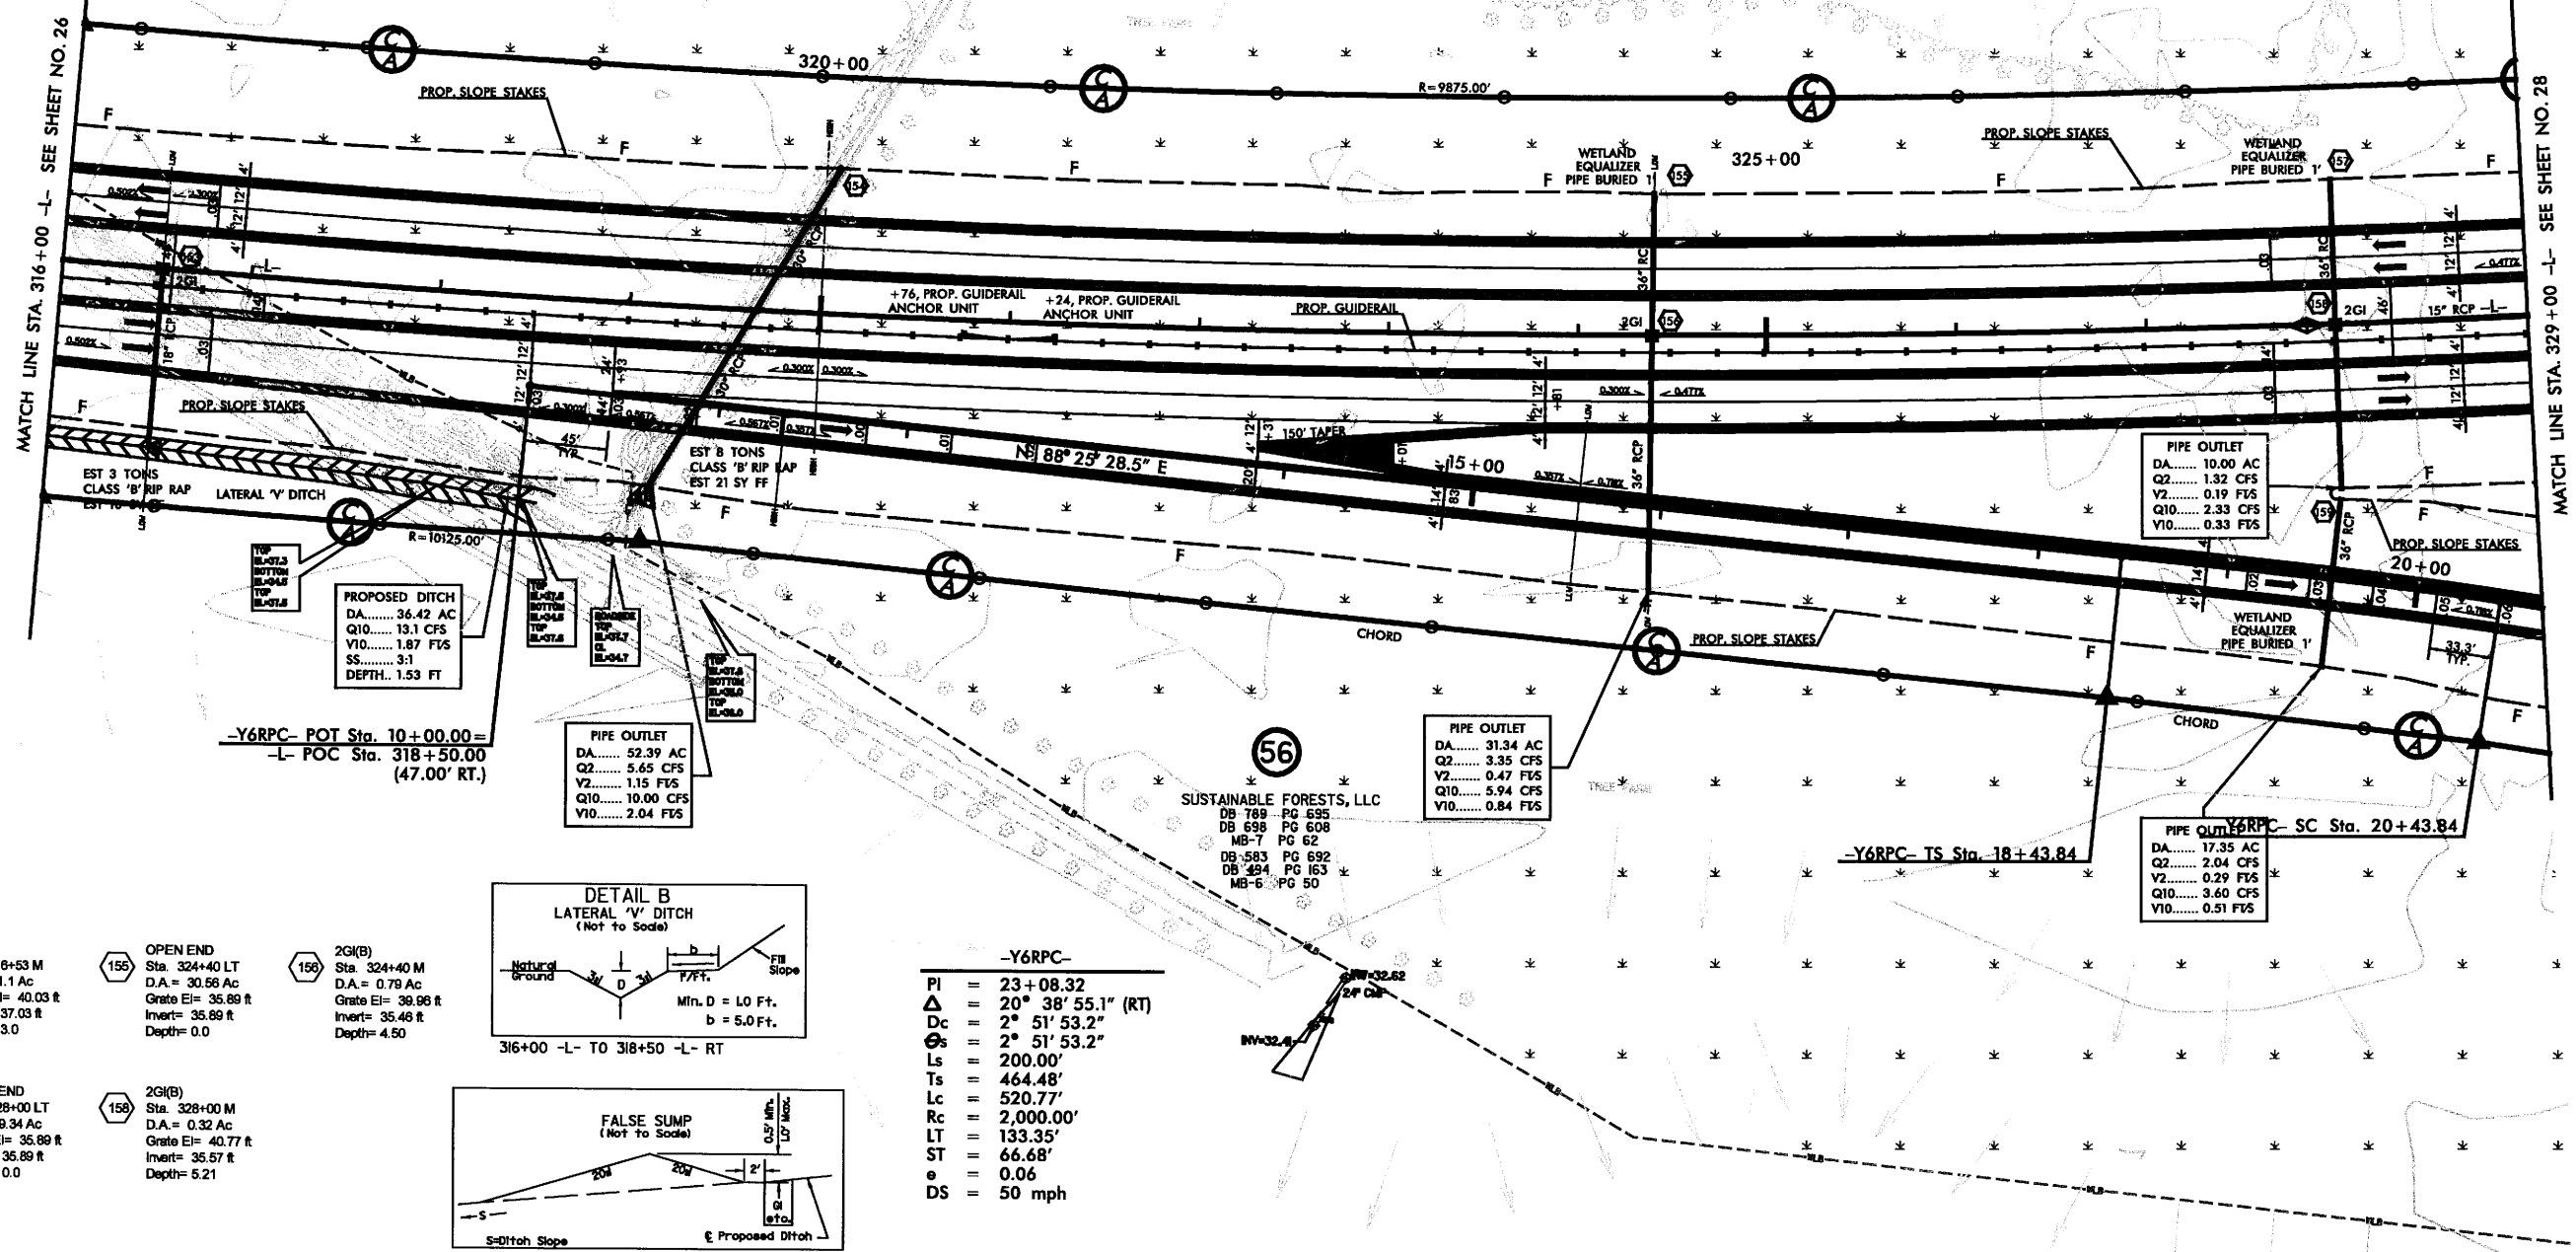

MATCH LINE STA. 316+00 -L- SEE SHEET NO. 26

MATCH LINE STA. 329+00 -L- SEE SHEET NO. 28



-Y6RPC- POT Sta. 10+00.00=
 -L- POC Sta. 318+50.00
 (47.00' RT.)

PIPE OUTLET
 DA..... 52.39 AC
 Q2..... 5.65 CFS
 V2..... 1.15 FFS
 Q10..... 10.00 CFS
 V10..... 2.04 FFS

PIPE OUTLET
 DA..... 31.54 AC
 Q2..... 3.35 CFS
 V2..... 0.47 FFS
 Q10..... 5.94 CFS
 V10..... 0.84 FFS

PIPE OUTLET
 DA..... 10.00 AC
 Q2..... 1.32 CFS
 V2..... 0.19 FFS
 Q10..... 2.33 CFS
 V10..... 0.33 FFS

PIPE OUTLET
 DA..... 17.35 AC
 Q2..... 2.04 CFS
 V2..... 0.29 FFS
 Q10..... 3.60 CFS
 V10..... 0.51 FFS

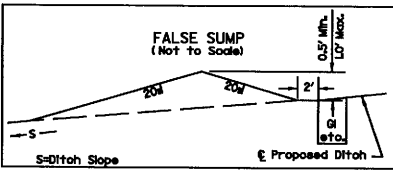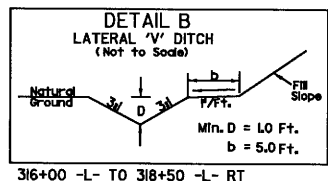



-Y6RPC-
 PI = 23+08.32
 Δ = 20° 38' 55.1" (RT)
 Dc = 2° 51' 53.2"
 Δs = 2° 51' 53.2"
 Ls = 200.00'
 Ts = 464.48'
 Lc = 520.77'
 Rc = 2,000.00'
 LT = 133.35'
 ST = 66.68'
 e = 0.06
 DS = 50 mph

- 153 2G(B)
 Sta. 316+53 M
 D.A. = 1.1 Ac
 Grate El= 40.03 ft
 Invert= 37.03 ft
 Depth= 3.0
- 155 OPEN END
 Sta. 324+40 LT
 D.A. = 0.79 Ac
 Grate El= 35.89 ft
 Invert= 35.89 ft
 Depth= 0.0
- 156 2G(B)
 Sta. 324+40 M
 D.A. = 0.79 Ac
 Grate El= 38.96 ft
 Invert= 35.46 ft
 Depth= 4.50
- 157 OPEN END
 Sta. 328+00 LT
 D.A. = 9.34 Ac
 Grate El= 35.89 ft
 Invert= 35.89 ft
 Depth= 0.0
- 158 2G(B)
 Sta. 328+00 M
 D.A. = 0.32 Ac
 Grate El= 40.77 ft
 Invert= 35.57 ft
 Depth= 5.21

8/1/2005 10:30:07 AM I:\Projects\2404A\2404A.dwg R:\p\p\27.dwg

REVISIONS

PROJECT REFERENCE NO. R-2404A	SHEET NO. 29
RW SHEET NO.	
ROADWAY DESIGN	HYDRAULICS ENGINEER
PRELIMINARY PLANS DO NOT USE FOR CONSTRUCTION	
 HDR Engineering, Inc. of the Carolinas 3723 National Drive, Suite 207 Raleigh, N.C. 27612	
 BARNHILL CONTRACTING COMPANY	


SITE 14

SUSTAINABLE FORESTS, LLC
DB 583 PG 251
DB 494 PG 163
MB 02 PG 01


<p>-Y6RPA-</p> <p>PI = 20+29.42 Δ = 33° 00' 03.5" (RT) Dc = 2° 36' 15.7" Es = 2° 36' 15.7" Ls = 200.00' Ts = 751.91' Lc = 1,067.15' Rc = 2,200.00' LT = 133.35' ST = 66.68' e = 0.05 DS = 50 mph</p>	<p>-L-</p> <p>PI = 372+60.14 Δ = 29° 41' 32.4" (RT) Dc = 1° 25' 56.6" Es = 1° 56' 01.4" Ls = 270.00' Ts = 1,195.49' Lc = 1,802.92' Rc = 4,000.00' LT = 180.01' ST = 90.01' e = 0.06 DS = 70 mph</p>
---	--

PIPE OUTLET

DA.....	157.25 AC
Q2.....	13.54 CFS
V2.....	1.91 FTS
Q10.....	23.96 CFS
V10.....	3.39 FTS

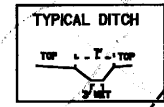

EST 11 TONS
CLASS 'B'
RIP RAP
EST 28 SY FF

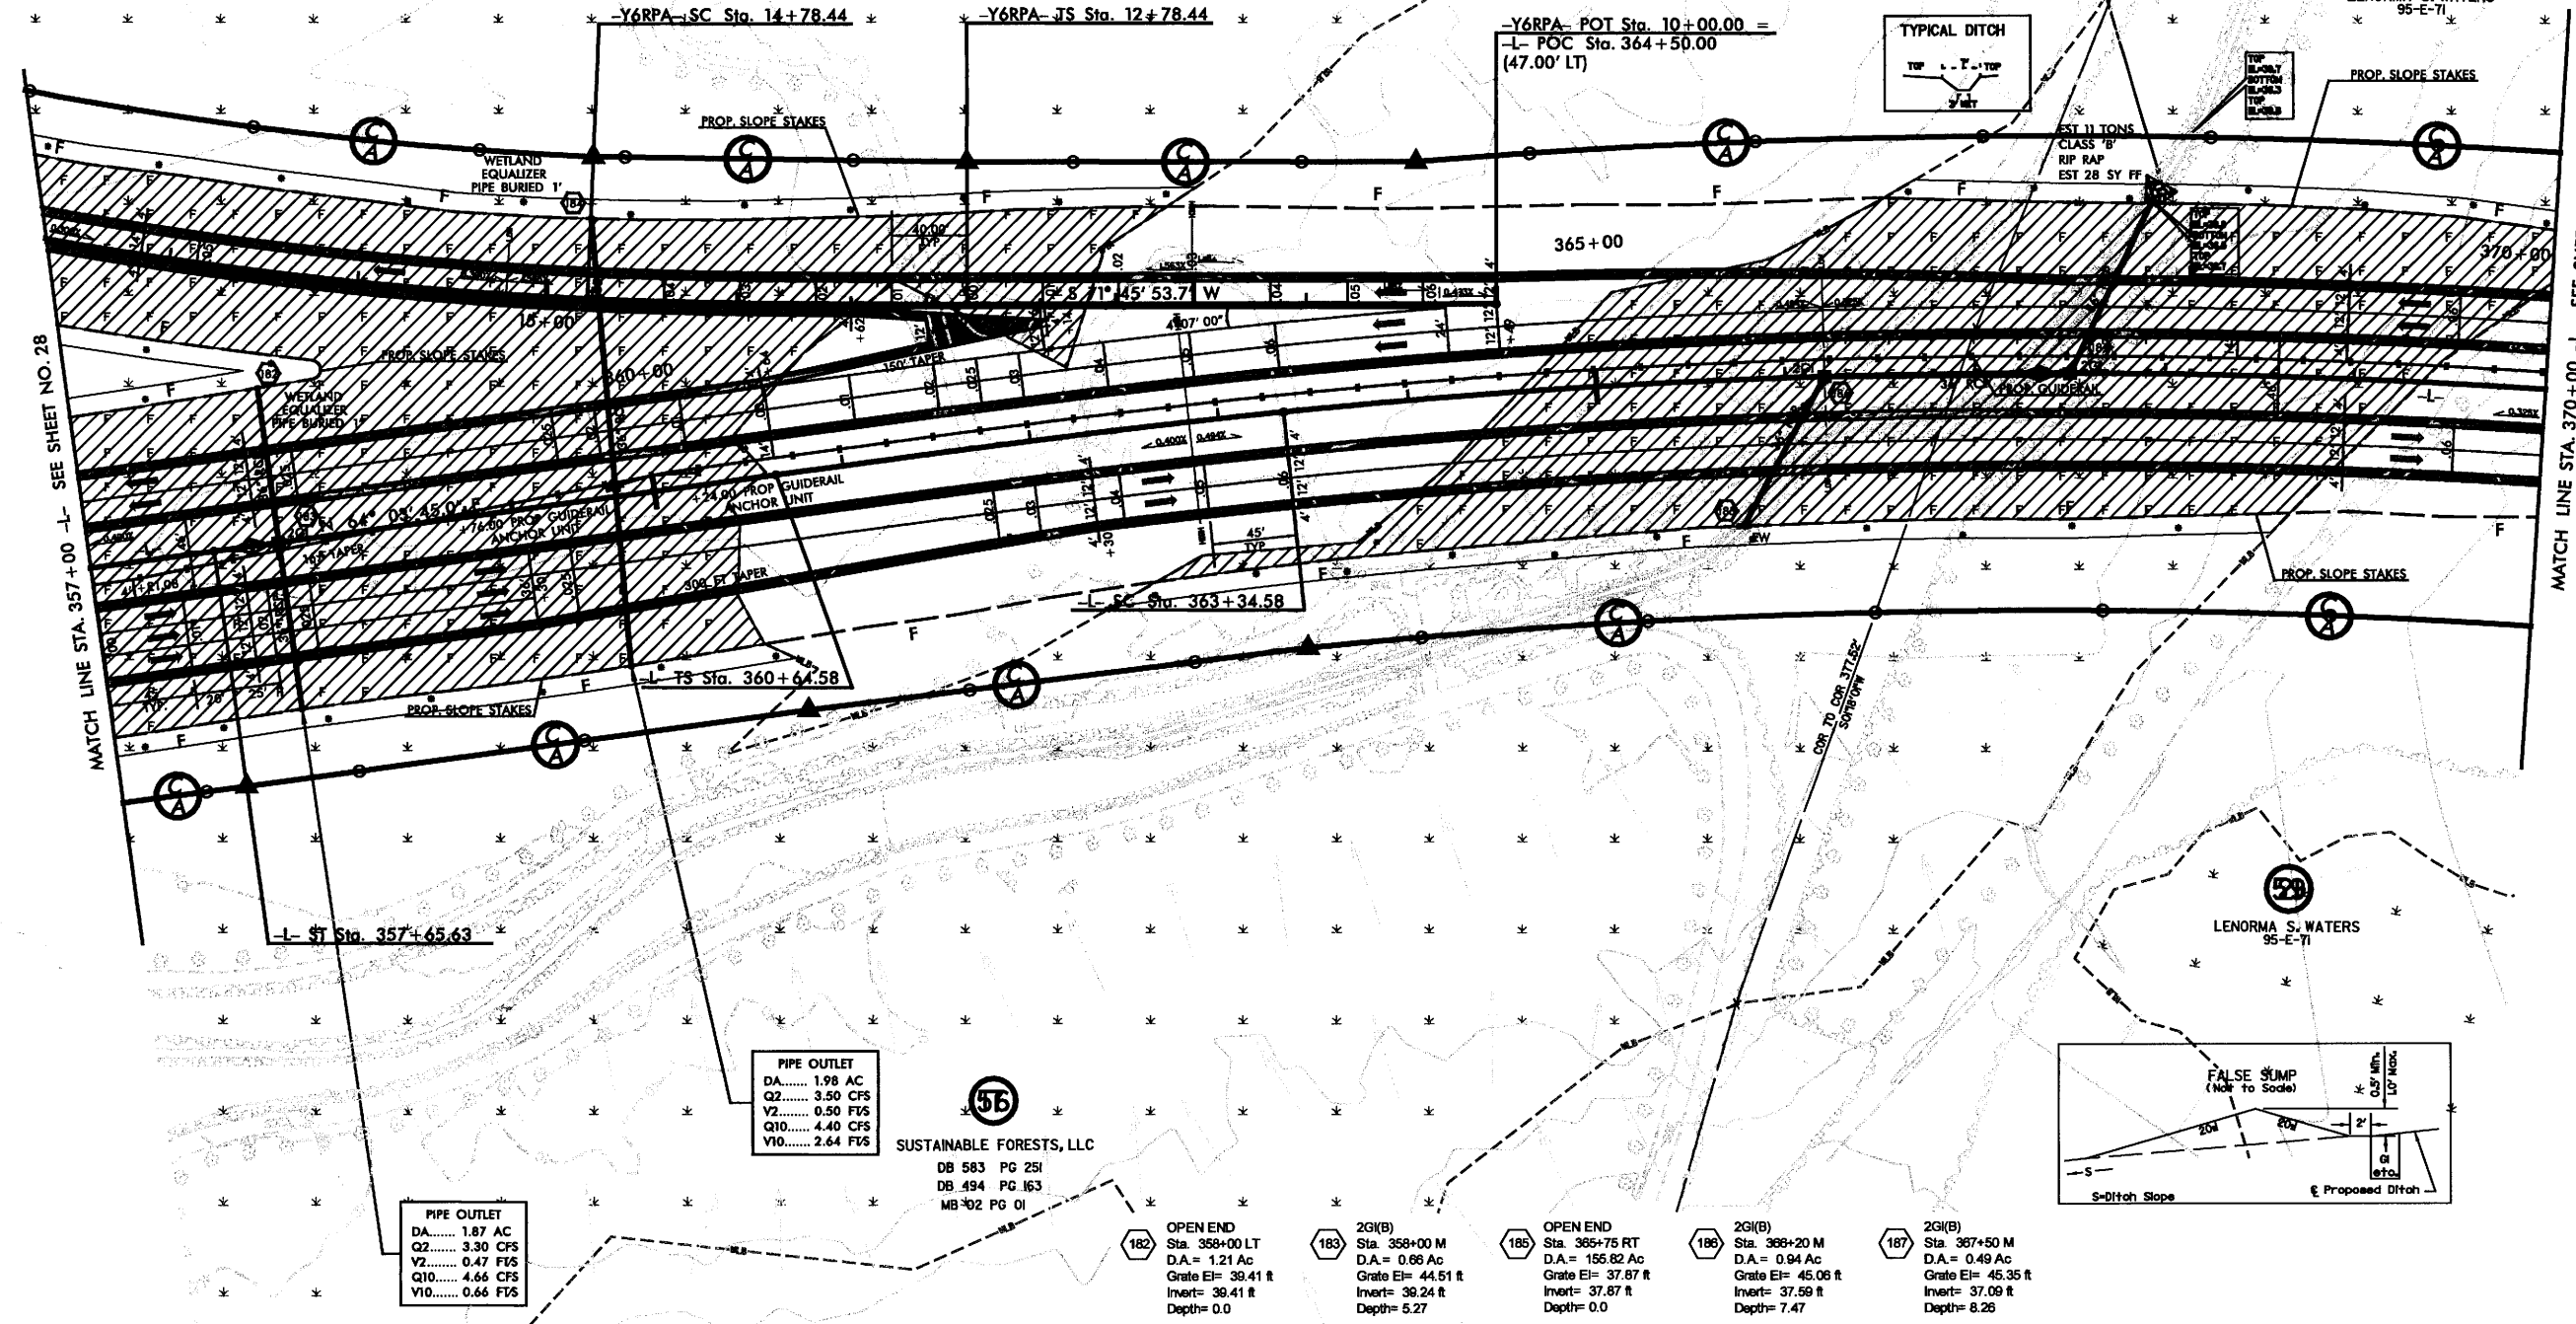


PIPE OUTLET

DA.....	1.98 AC
Q2.....	3.50 CFS
V2.....	0.50 FTS
Q10.....	4.40 CFS
V10.....	2.64 FTS

SUSTAINABLE FORESTS, LLC
DB 583 PG 251
DB 494 PG 163
MB 02 PG 01

<p>OPEN END Sta. 358+00 LT D.A. = 1.21 Ac Grate El= 39.41 ft Invert= 39.24 ft Depth= 0.0</p>	<p>2G(B) Sta. 359+00 M D.A. = 0.66 Ac Grate El= 44.51 ft Invert= 37.87 ft Depth= 5.27</p>	<p>OPEN END Sta. 365+75 RT D.A. = 155.82 Ac Grate El= 37.87 ft Invert= 37.87 ft Depth= 0.0</p>	<p>2G(B) Sta. 369+20 M D.A. = 0.94 Ac Grate El= 45.06 ft Invert= 37.87 ft Depth= 7.47</p>	<p>2G(B) Sta. 367+50 M D.A. = 0.49 Ac Grate El= 45.35 ft Invert= 37.09 ft Depth= 8.28</p>
--	---	--	---	---

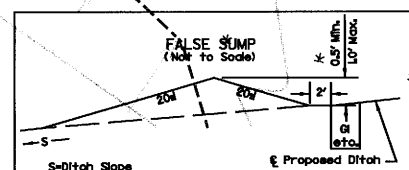



MATCH LINE STA. 357+00 -L- SEE SHEET NO. 28

MATCH LINE STA. 370+00 -L- SEE SHEET NO. 30

NOTES: SEE SHEET NO. 67 FOR -L- PROFILE.
SEE SHEET NO. 86 FOR -Y6RPA- PROFILE.

8/1/2005 10:55:50 AM I:\Projects\2404A\Drawings\2404A.dwg User: jrd/10/05/05


REVISIONS

PROJECT REFERENCE NO. R-2404A	SHEET NO. 30
RW SHEET NO.	
ROADWAY DESIGN	HYDRAULICS ENGINEER
PRELIMINARY PLANS DO NOT USE FOR CONSTRUCTION	
 HDR Engineering, Inc. of the Carolinas 3733 National Drive, Suite 207 Raleigh, N.C. 27612	
 BARNHILL CONTRACTING COMPANY	

SITE 14



59
LENORMA S. WATERS
95-E-71




PI = 372 + 60.14
 Δ = 29° 41' 32.4" (RT)
 Dc = 1° 25' 56.6"
 Δ = 1° 56' 01.4"
 Ls = 270.00'
 Ts = 1,195.49'
 Lc = 1,802.92'
 Rc = 4,000.00'
 LT = 180.01'
 ST = 90.01'
 e = 0.06
 DS = 70 mph

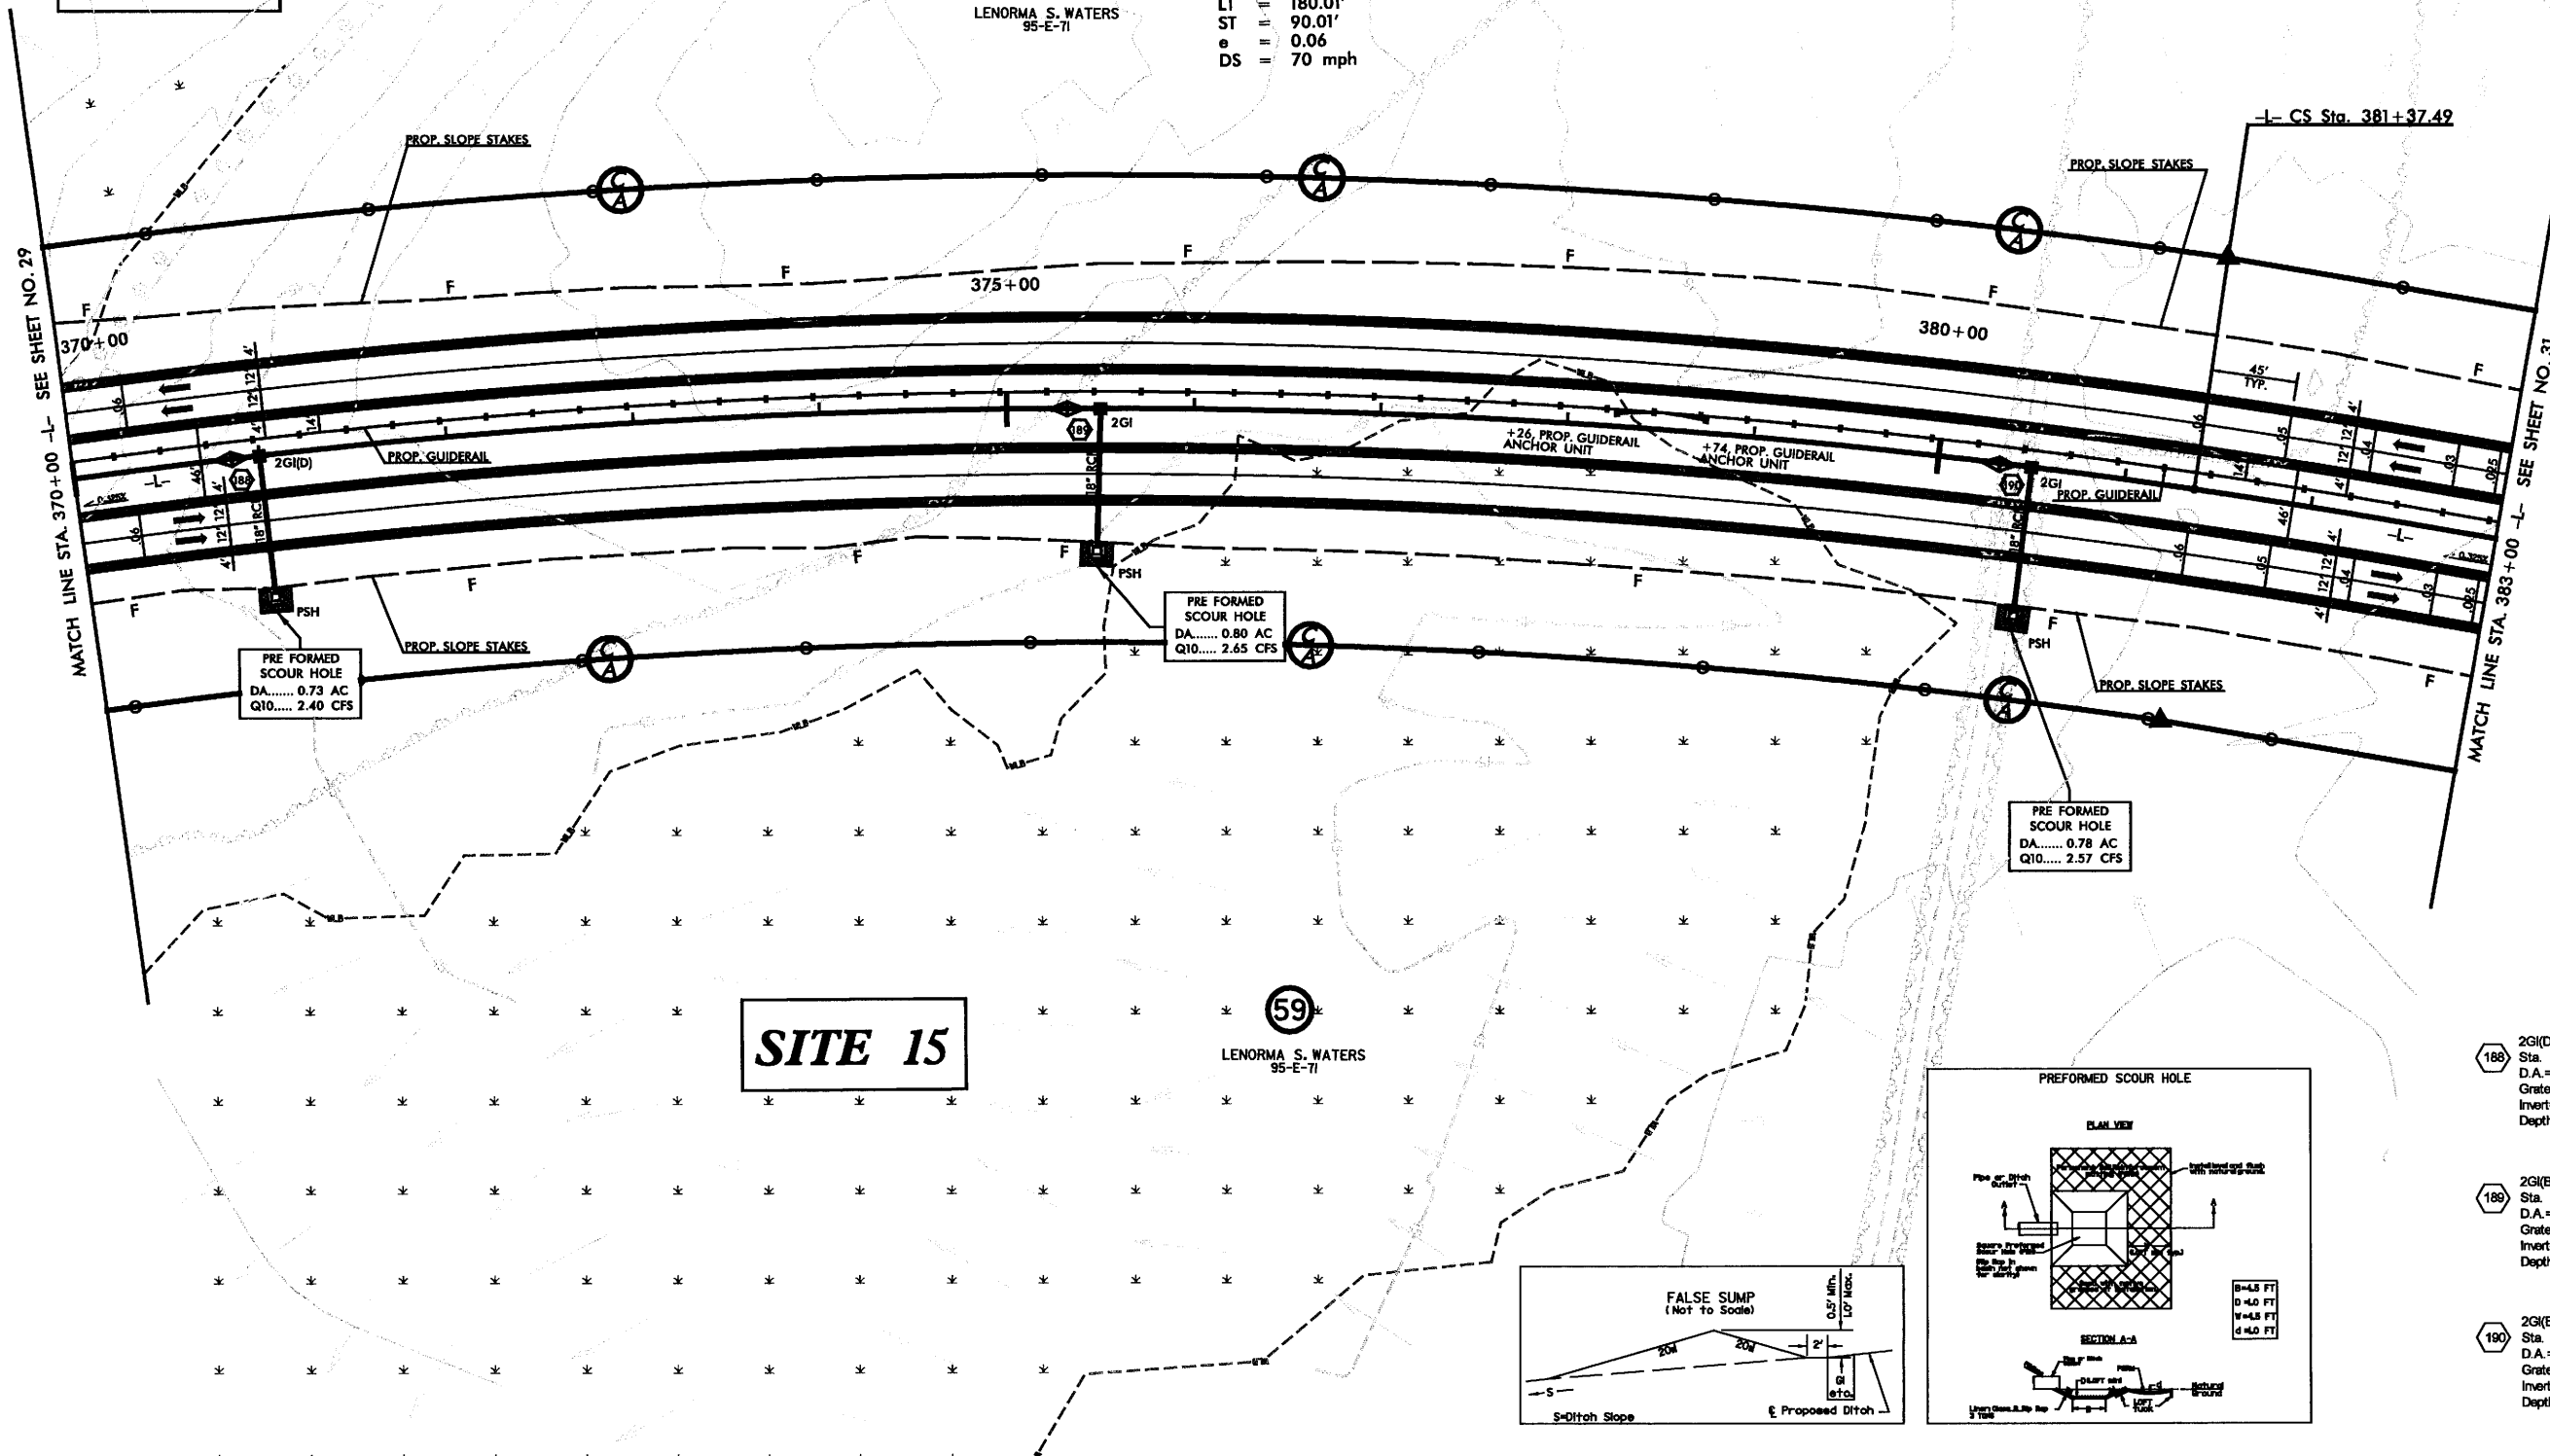

SITE 15

59
LENORMA S. WATERS
95-E-71

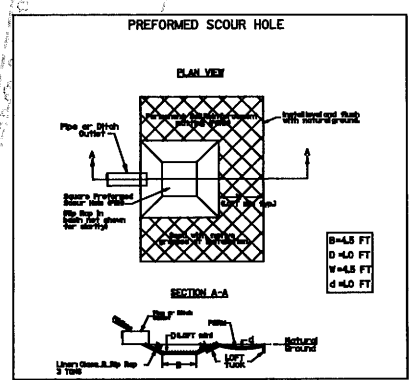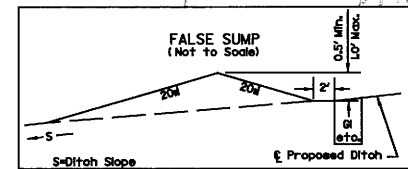

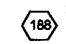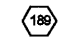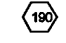

-  2G(D)
 Sta. 371+00 M
 D.A. = 0.73 Ac
 Grate El= 46.49 ft
 Invert= 44.32 ft
 Depth= 2.17
-  2G(B)
 Sta. 375+50 M
 D.A. = 0.8 Ac
 Grate El= 47.95 ft
 Invert= 44.95 ft
 Depth= 3.0
-  2G(B)
 Sta. 380+50 M
 D.A. = 0.78 Ac
 Grate El= 49.57 ft
 Invert= 46.57 ft
 Depth= 3.0

NOTES: SEE SHEET NOS. 68 FOR -L- PROFILE

8/1/2005 10:43:30 AM \\p0252\work\roadway\2404a_rwd\redline_sht_30.dgn

REVISIONS

PROJECT REFERENCE NO. R-2404A	SHEET NO. 31
RW SHEET NO.	
ROADWAY DESIGN	HYDRAULICS ENGINEER
PRELIMINARY PLANS DO NOT USE FOR CONSTRUCTION	
 HDR Engineering, Inc. of the Carolinas 3733 National Drive, Suite 207 Raleigh, N.C. 27612	
 BARNHILL CONTRACTING COMPANY	


-L-

PI	=	372 + 60.14
Δ	=	29° 41' 32.4" (RT)
Dc	=	1° 25' 56.6"
∅s	=	1° 56' 01.4"
Ls	=	270.00'
Ts	=	1,195.49'
Lc	=	1,802.92'
Rc	=	4,000.00'
LT	=	180.01'
ST	=	90.01'
e	=	0.06
DS	=	70 mph

NAD '83

59
LENORMA S. WATERS
55-E-71

60
HOWARD J. ASBELL
DB 73E PG 08
DB 792 PG 828

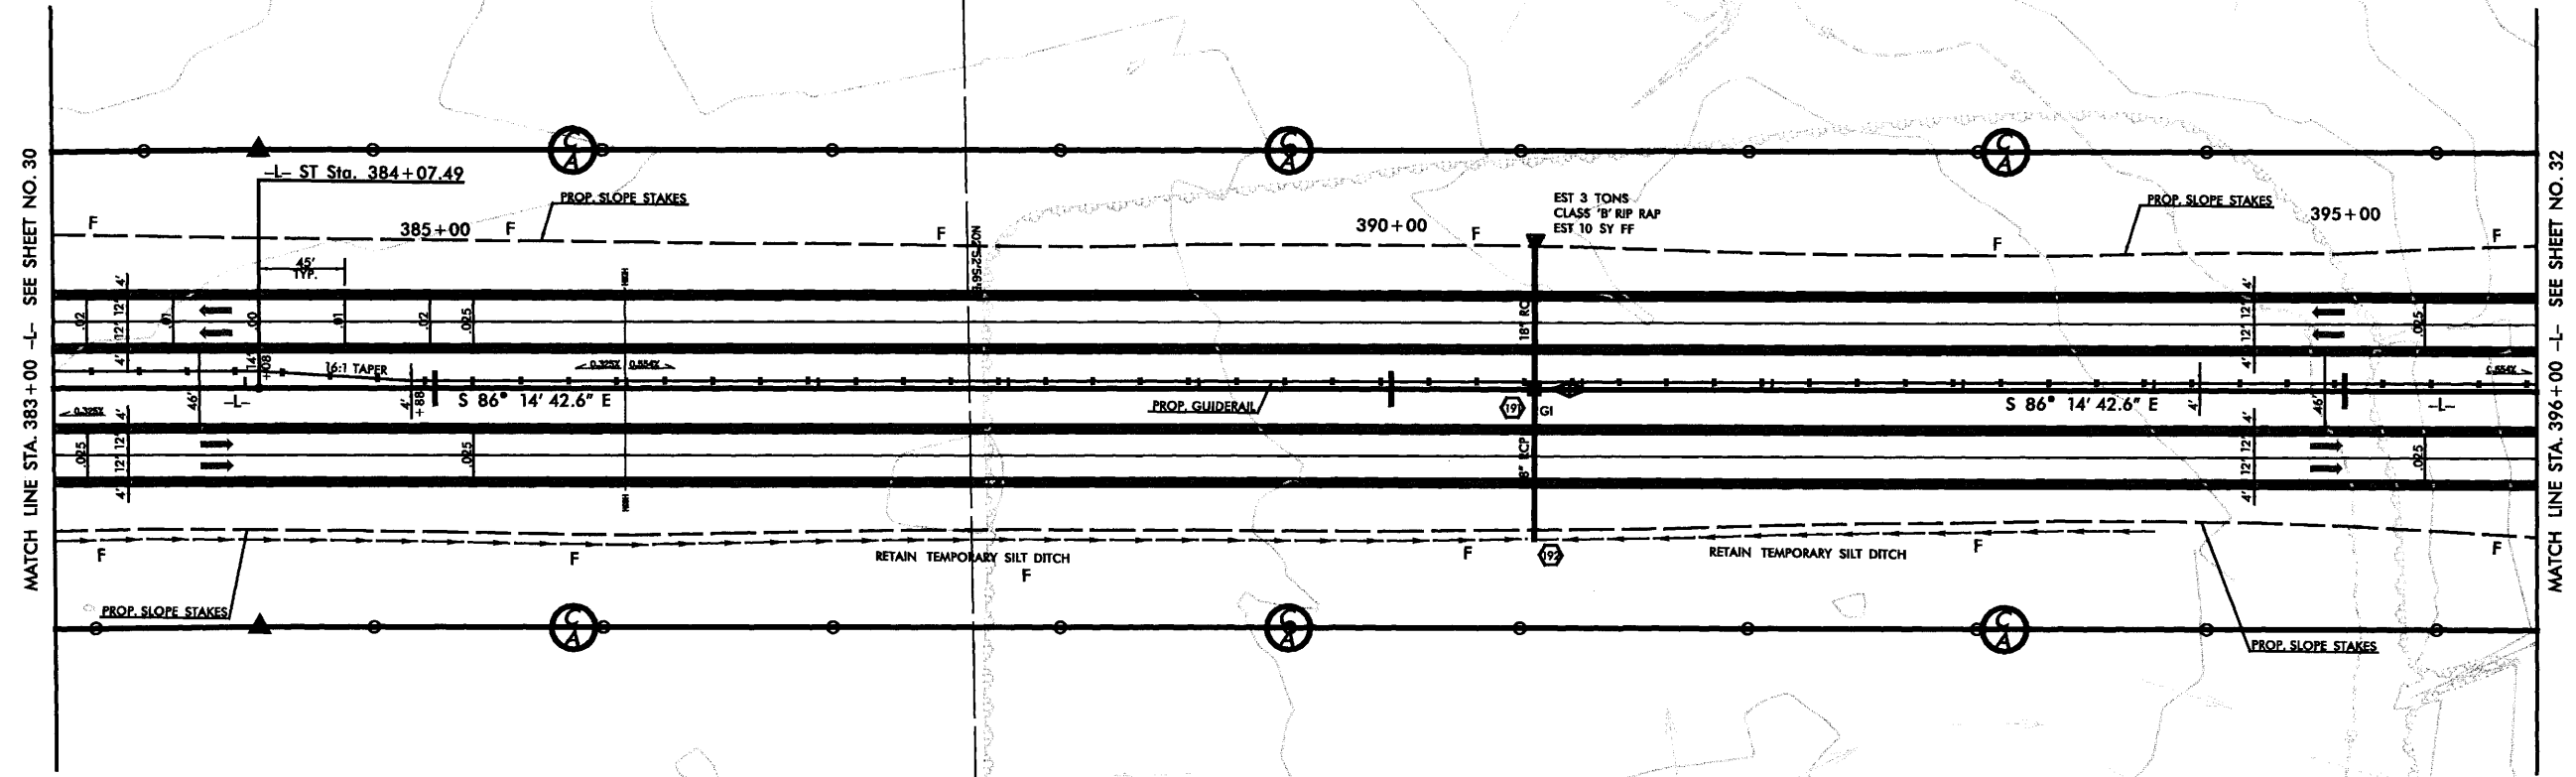

MATCH LINE STA. 383+00 -L- SEE SHEET NO. 30


MATCH LINE STA. 396+00 -L- SEE SHEET NO. 32

59
LENORMA S. WATERS
55-E-71

60
HOWARD J. ASBELL
DB 73E PG 08
DB 792 PG 828

191 20'(B)
Sta. 390+75 M
D.A. = 0.5 Ac
Grate El = 49.33 ft
Invert = 45.37 ft
Depth = 3.95


192 OPEN END
Sta. 390+75 R
D.A. = 0.1 Ac
Grate El = 45.60 ft
Invert = 45.60 ft
Depth = 0.0

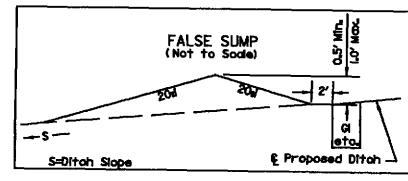




8/7/2005 10:44:53 AM D:\4453 AM 2404A\Roadway\Stationing\2404A.rvt Redline.dwg 31.687

NOTES: SEE SHEET NO. 68 FOR -L- PROFILE

REVISIONS

PROJECT REFERENCE NO. R-2404A	SHEET NO. 32
RW SHEET NO.	
ROADWAY DESIGN	HYDRAULICS ENGINEER
INCOMPLETE PLANS DO NOT USE FOR I/W ACQUISITION	
 HDR Engineering, Inc. of the Carolinas 3733 National Drive, Suite 207 Raleigh, N.C. 27612	

BARNHILL CONTRACTING COMPANY

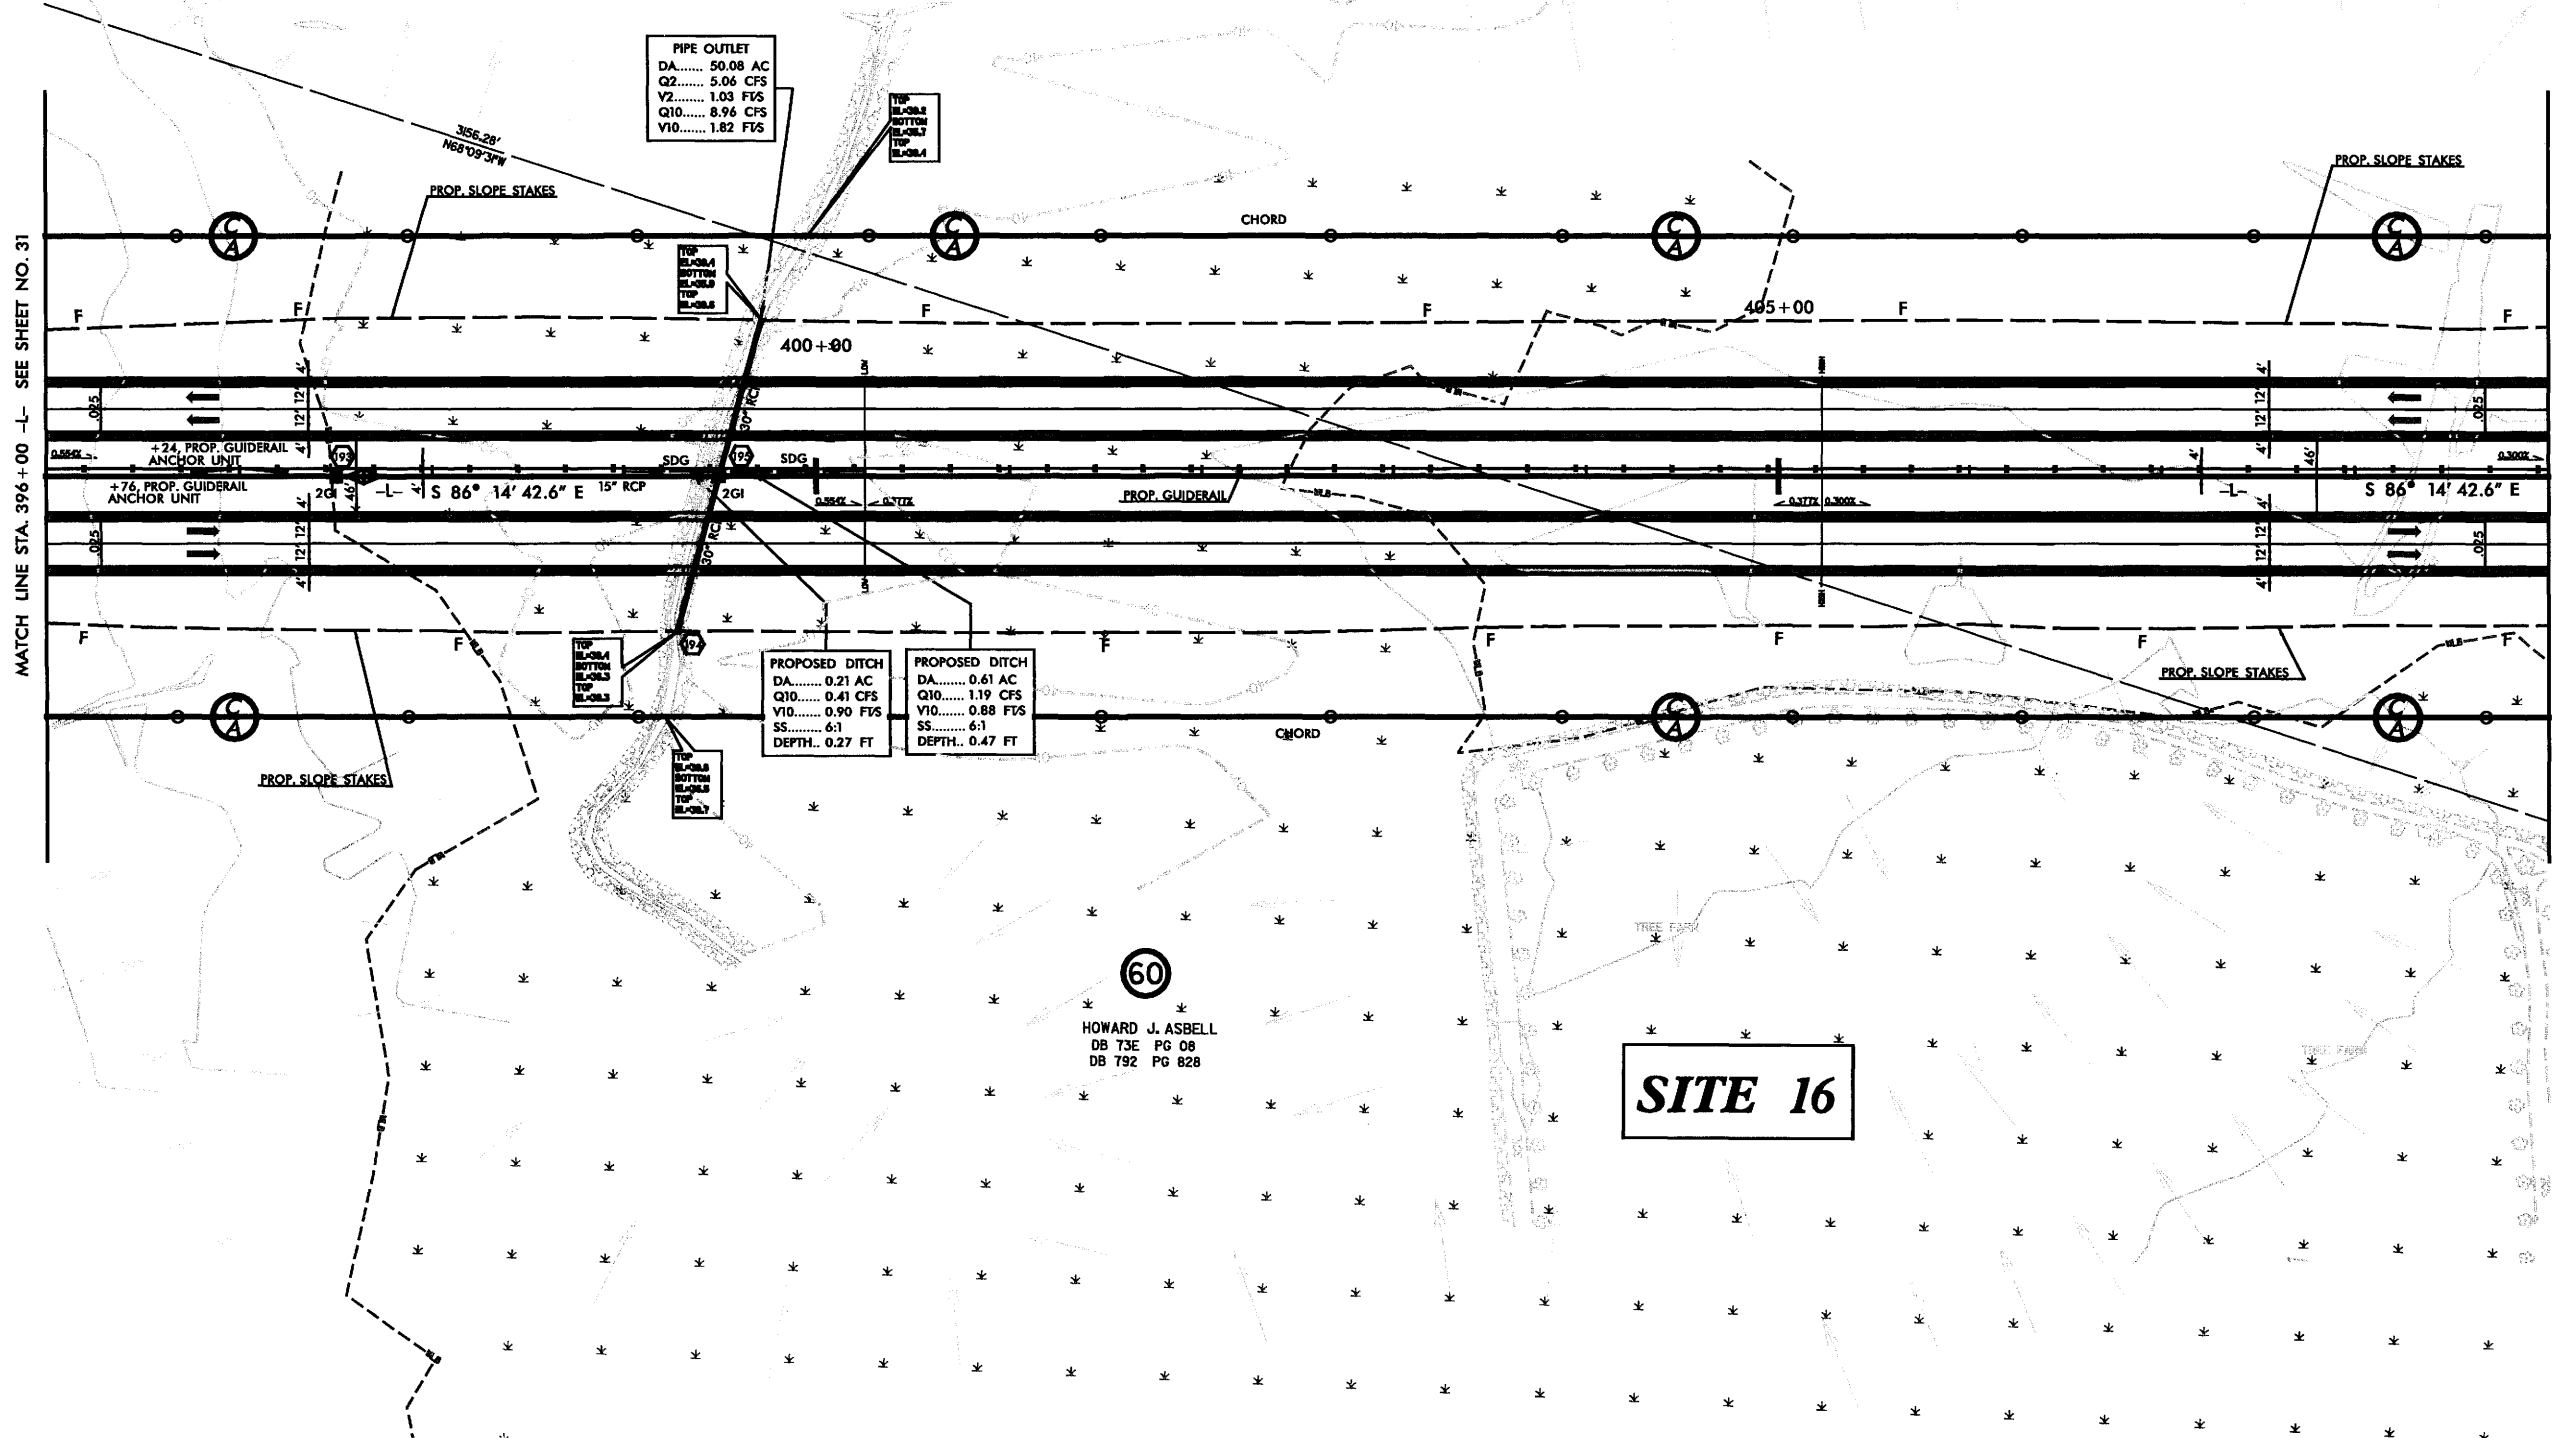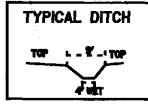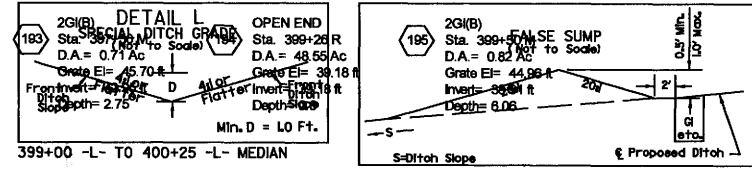

8/1/2005 8:41 AM
 C:\Users\jason\Documents\Projects\2404A\2404A_1.dwg 2404A_1.dwg 32.dwg

NOTES: SEE SHEET NOS. 68-69 FOR -L- PROFILE




REVISIONS	

PI = 423+73.43
 Δ = 17° 23' 44.5" (RT)
 Dc = 0° 42' 58.3"
 S = 0° 42' 58.3"
 Ls = 200.00'
 Ts = 1,323.90'
 Lc = 2,228.90'
 Rc = 8,000.00'
 LT = 133.33'
 ST = 66.67'
 e = 0.03
 DS = 70 mph

(64)
 WALTER HARDEN
 DB 674 PG 778
 PC A PG 755

(63)
 WEYERHAEUSER CO.
 DB 674 PG 323
 PC A PG 755

(63)
 WEYERHAEUSER CO.
 DB 674 PG 323
 PC A PG 755

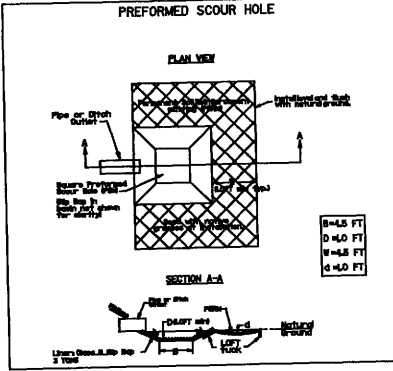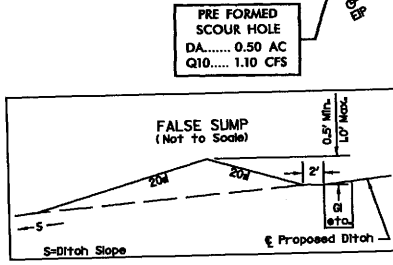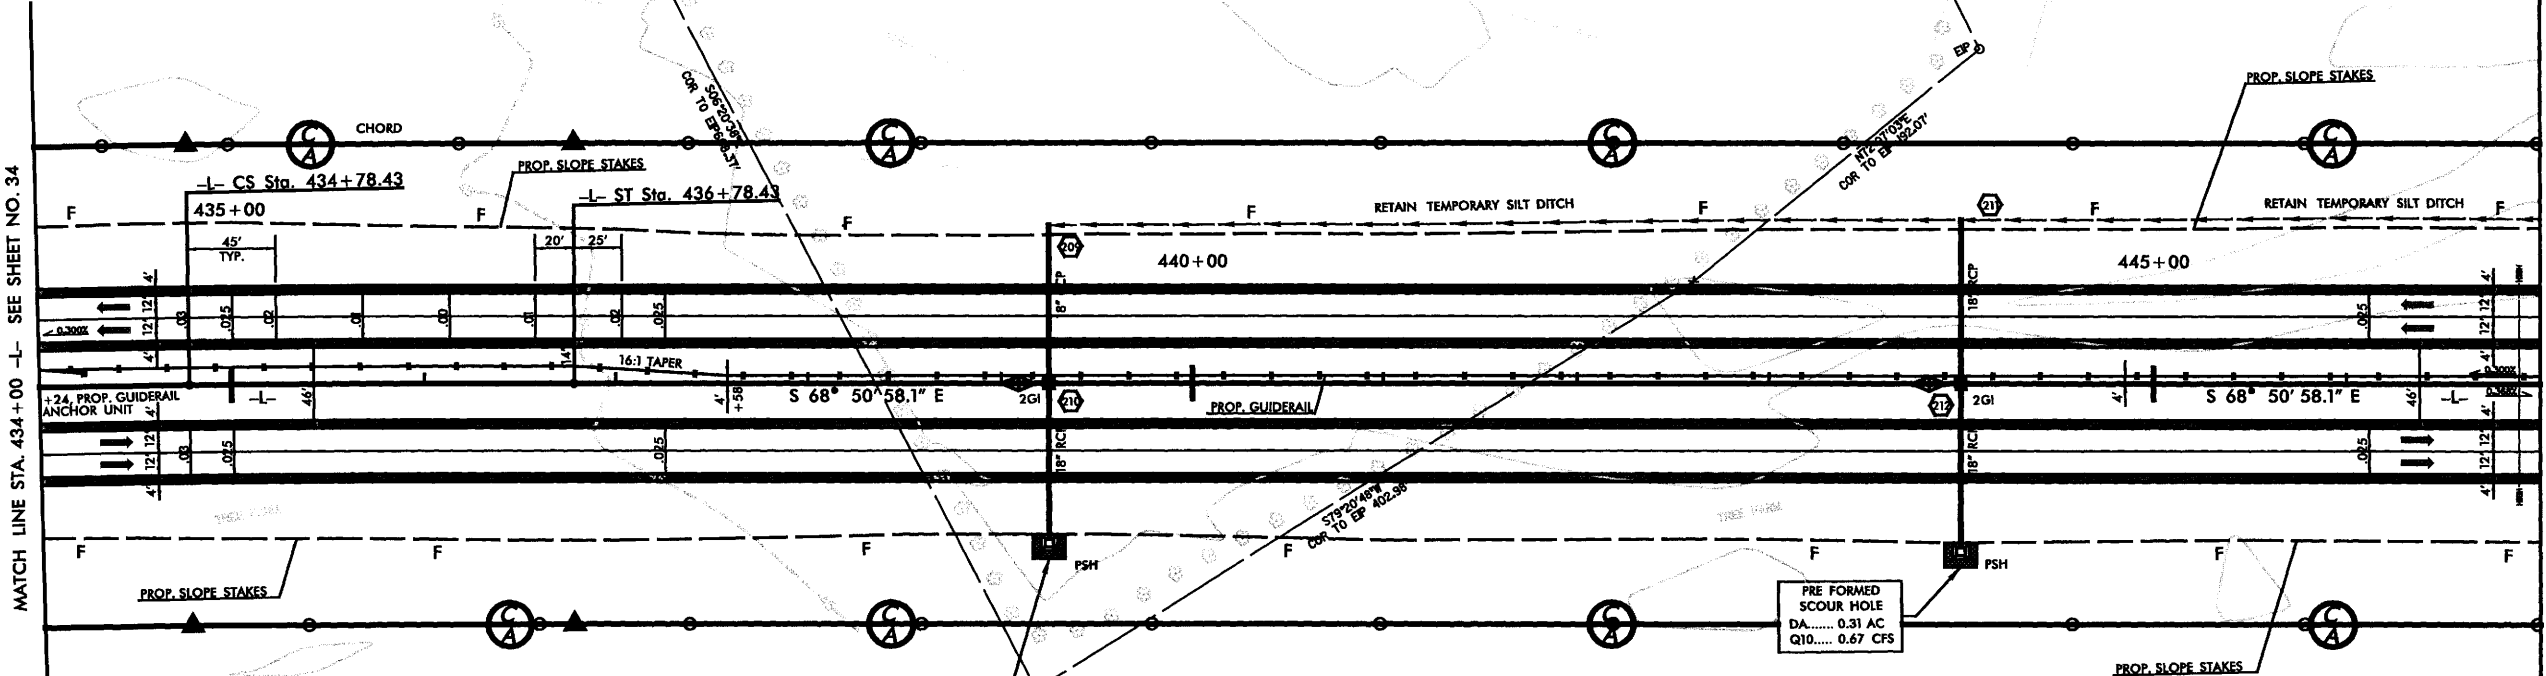


(63)
 WEYERHAEUSER CO.
 DB 674 PG 323
 PC A PG 755

(209) OPEN END Sta. 439+25 L D.A. = 0.1 Ac Grate El= 45.45 ft Invert= 45.45 ft Depth= 0.0	(210) 2G(B) Sta. 439+25 M D.A. = 0.5 Ac Grate El= 50.80 ft Invert= 45.21 ft Depth= 5.39	(211) OPEN END Sta. 444+00 L D.A. = 0.1 Ac Grate El= 45.20 ft Invert= 45.20 ft Depth= 0.0	(212) 2G(B) Sta. 444+00 M D.A. = 0.31 Ac Grate El= 51.30 ft Invert= 44.88 ft Depth= 6.42
---	---	---	--

NOTES: SEE SHEET NO. 70 FOR -L- PROFILE.

10/2005
 10/2005
 10/2005

REVISIONS

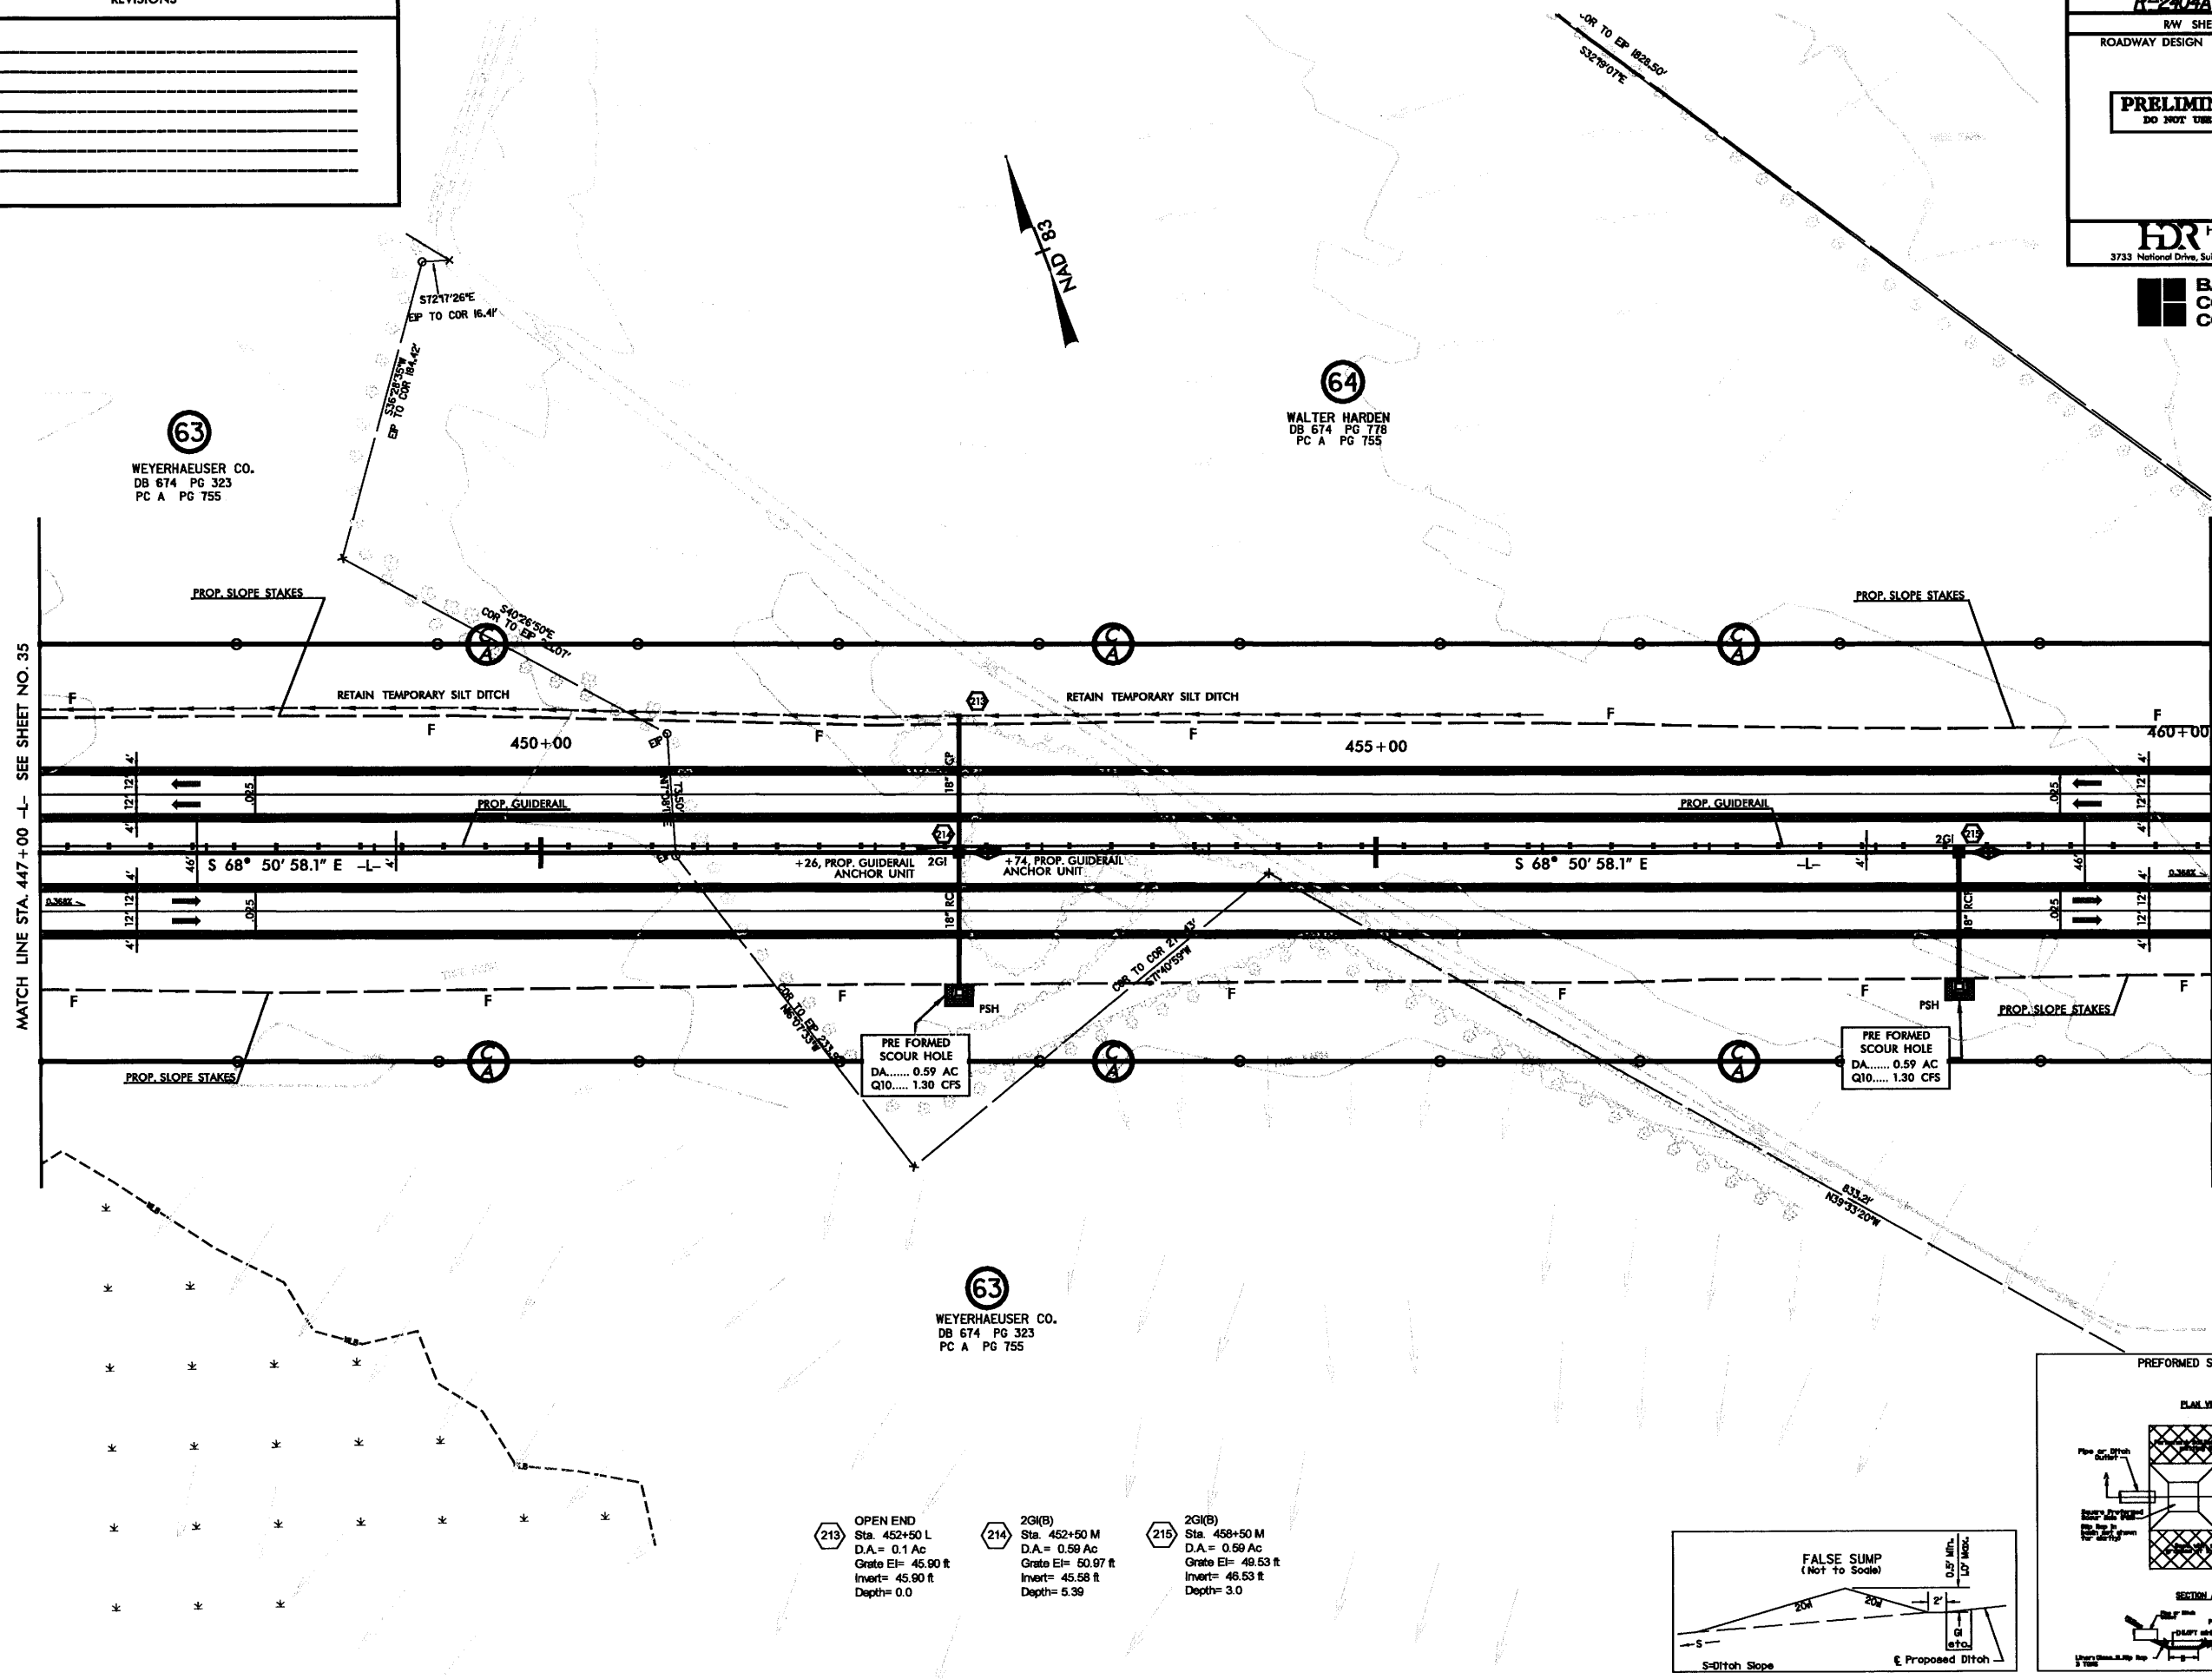

MATCH LINE STA. 447+00 -L- SEE SHEET NO. 35



MATCH LINE STA. 460+00 -L- SEE SHEET NO. 37

(63)
WEYERHAEUSER CO.
DB 674 PG 323
PC A PG 755

(64)
WALTER HARDEN
DB 674 PG 778
PC A PG 755

(63)
WEYERHAEUSER CO.
DB 674 PG 323
PC A PG 755

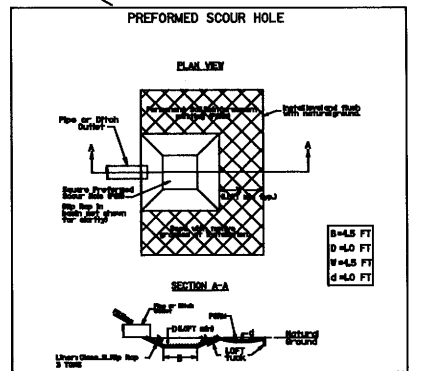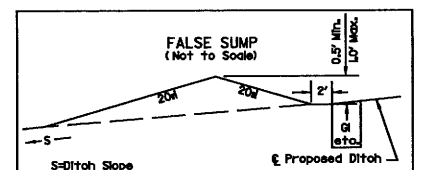

- (213)** OPEN END
Sta. 452+50 L
D.A. = 0.1 Ac
Grate El= 45.90 ft
Invert= 45.90 ft
Depth= 0.0
- (214)** 2G(B)
Sta. 452+50 M
D.A. = 0.59 Ac
Grate El= 50.97 ft
Invert= 45.58 ft
Depth= 5.39
- (215)** 2G(B)
Sta. 458+50 M
D.A. = 0.59 Ac
Grate El= 48.53 ft
Invert= 46.53 ft
Depth= 3.0



NOTES: SEE SHEET NO. 70-71 FOR -L- PROFILE.

8/1/2005 10:46:52 AM D:\2005\A\2404\Drawings\2404A_Hdr_Roadway_sht_36.dwg


REVISIONS

PROJECT REFERENCE NO. R-2404A	SHEET NO. 37
RW SHEET NO.	
ROADWAY DESIGN	HYDRAULICS ENGINEER
PRELIMINARY PLANS DO NOT USE FOR CONSTRUCTION	
 HDR Engineering, Inc. of the Carolinas 3733 National Drive, Suite 207 Raleigh, N.C. 27612	
 BARNHILL CONTRACTING COMPANY	

-L-

PI = 468+50.60
 D = 11° 12' 34.4" (RT)
 Dc = 1° 21' 51.1"
 Fs = 1° 21' 51.1"
 Ls = 200.00'
 Ts = 512.20'
 Lc = 621.70'
 Rc = 4,200.00'
 LT = 133.34'
 ST = 66.67'
 e = 0.04
 DS = 60 mph

- 2G(B) Sta. 464+50 M
D.A. = 0.67 Ac
Grate El= 47.36 ft
Depth= 3.0
- OPEN END Sta. 468+00 L
D.A. = 40.01 Ac
Grate El= 42.03 ft
Depth= 0.0
- 2G(B) Sta. 469+00 M
D.A. = 0.31 Ac
Grate El= 46.16 ft
Depth= 4.50
- 2G(B) Sta. 468+35 M
D.A. = 0.61 Ac
Grate El= 46.27 ft
Invert= 43.52 ft
Depth= 2.75
- 2G(B) Sta. 470+50 M
D.A. = 0.49 Ac
Grate El= 46.33 ft
Invert= 43.33 ft
Depth= 3.0

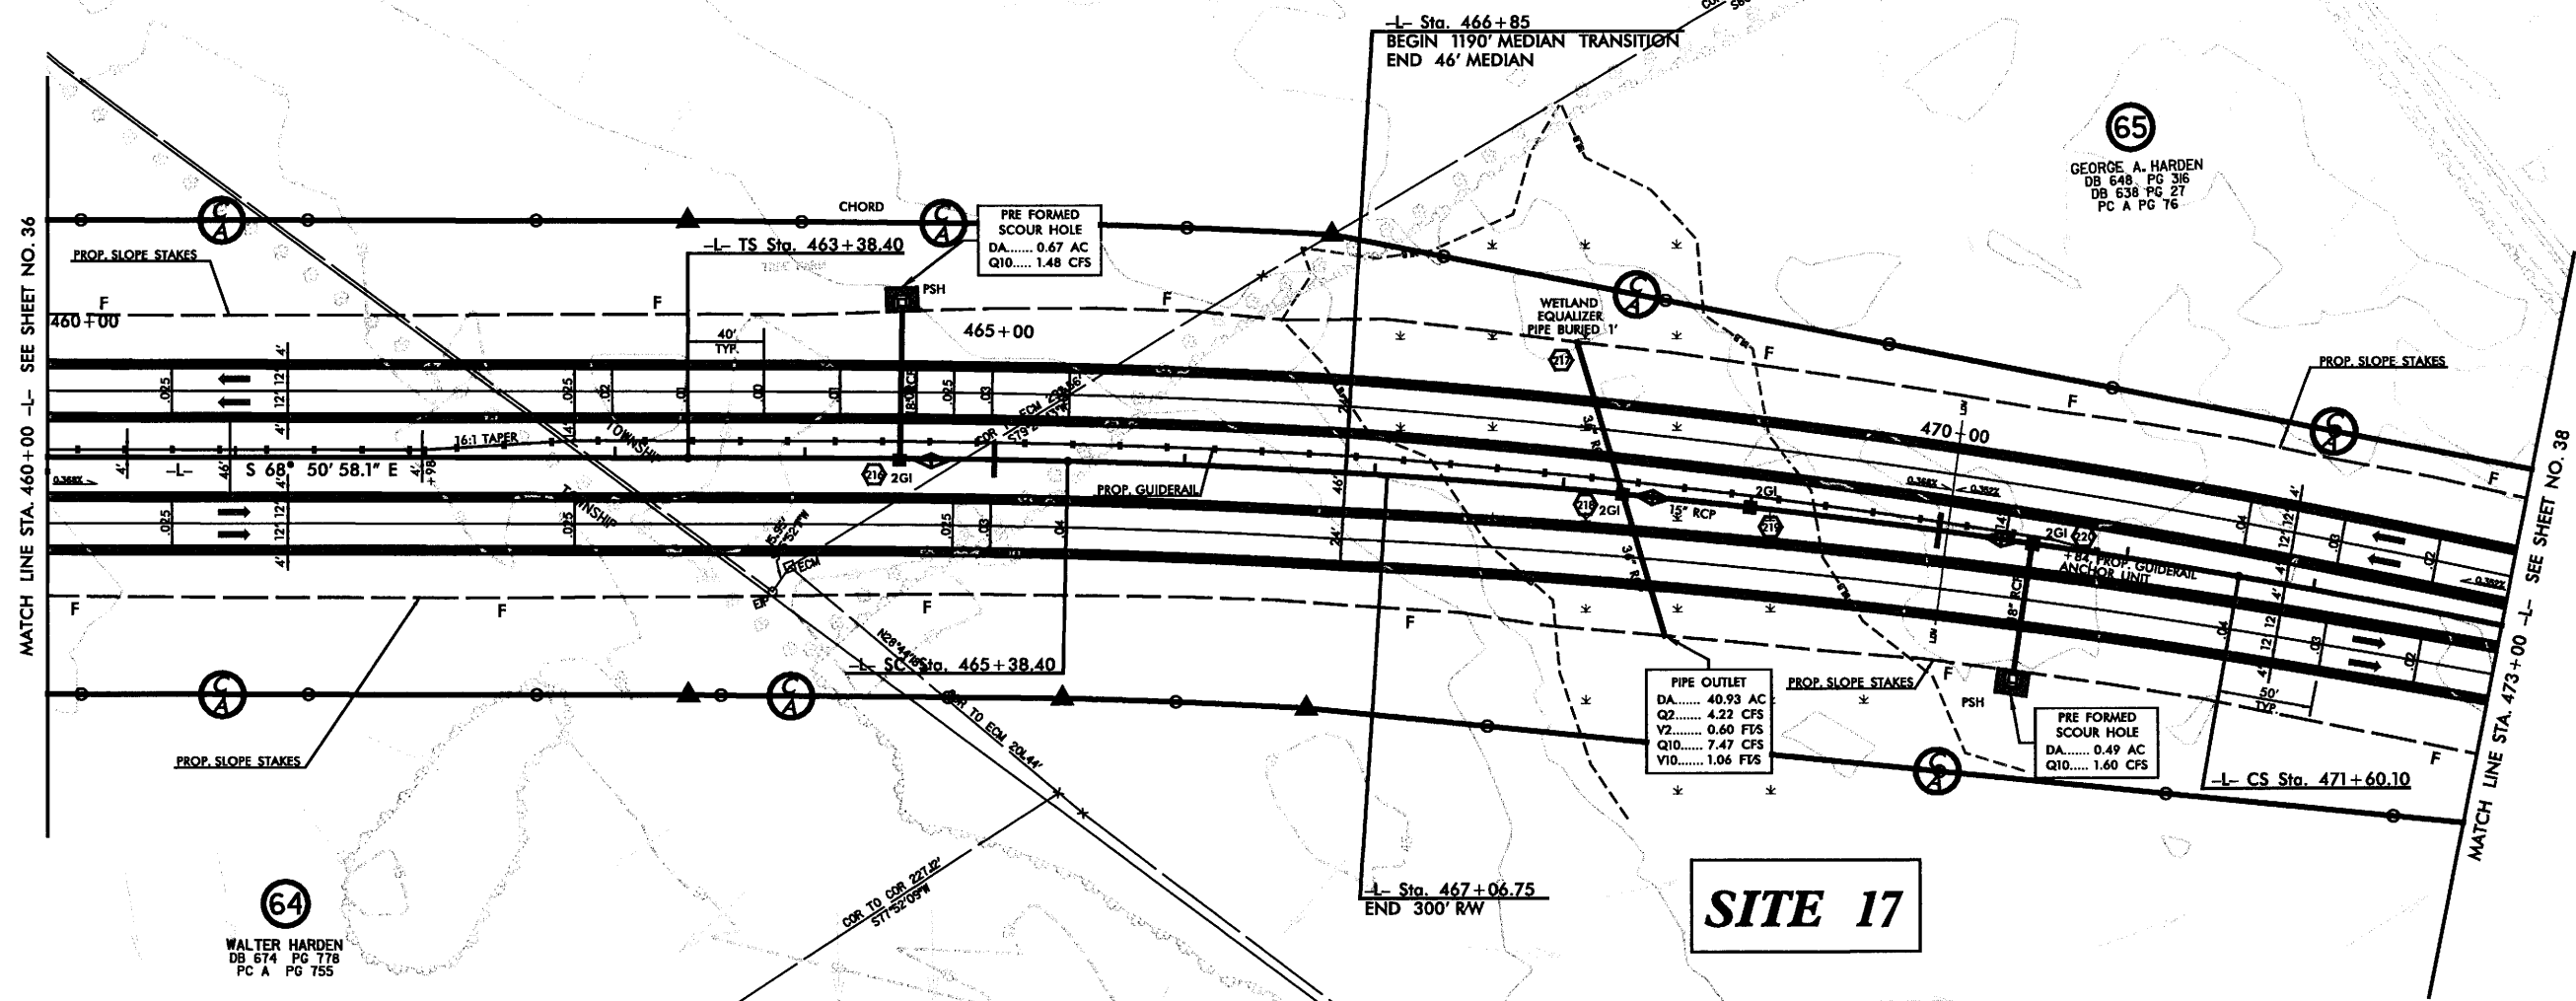

MATCH LINE STA. 460+00 -L- SEE SHEET NO. 36



MATCH LINE STA. 473+00 -L- SEE SHEET NO. 38

SITE 17

64
 WALTER HARDEN
 DB 674 PG 778
 PC A PG 755

65
 GEORGE ALLEN HARDEN
 DB 711 PG 359

65
 GEORGE A. HARDEN
 DB 648 PG 316
 DB 638 PG 27
 PC A PG 76

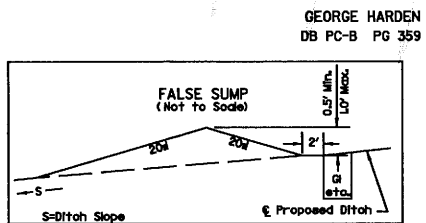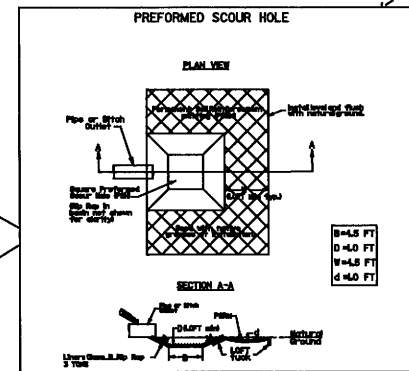



GEORGE HARDEN
 DB PC-B PG 359

NOTES: SEE SHEET NO. 71 FOR -L- PROFILE.

8/1/2005 10:17:47 AM C:\Users\jw\Documents\2404A\171\171.dwg 37.dwg

REVISIONS

PROJECT REFERENCE NO. R-2404A	SHEET NO. 38
RW SHEET NO.	
ROADWAY DESIGN	HYDRAULICS ENGINEER
PRELIMINARY PLANS DO NOT USE FOR CONSTRUCTION	
 HDR Engineering, Inc. of the Carolinas 3733 National Drive, Suite 207 Raleigh, N.C. 27612	
 BARNHILL CONTRACTING COMPANY	

221
Sta. 473+50 M
D.A. = 0.23 Ac
Grate El. = 47.85 ft
Invert = 44.85 ft
Depth = 3.0





-L-
PI = 493+65.10
D = 57° 06' 40.2" (LT)
Dc = 1° 38' 13.3"
Fs = 1° 38' 13.3"
Ls = 200.00'
Ts = 2,005.00'
Lc = 3,288.72'
Rc = 3,500.00'
LT = 133.34'
ST = 66.67'
e = 0.05
DS = 60 mph

65
GEORGE A. HARDEN
DB 648 PG 316
DB 638 PG 27
PC A PG 76

65
GEORGE A. HARDEN
DB 648 PG 316
DB 638 PG 27
PC A PG 76

65
GEORGE A. HARDEN
DB 648 PG 316
DB 638 PG 27
PC A PG 76


NOTES: SEE SHEET NO. 71 FOR -L- PROFILE.
SEE SHEET NO. 90 FOR -Y7- PROFILE.

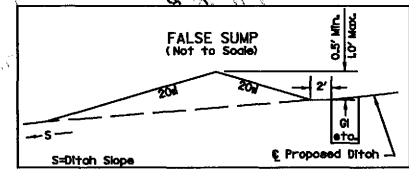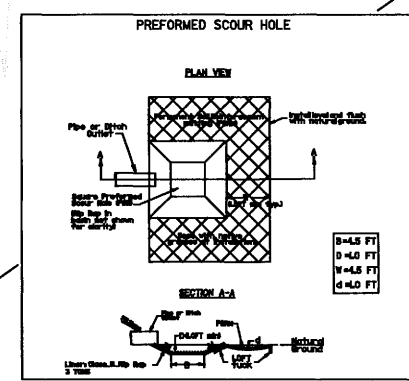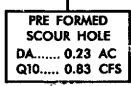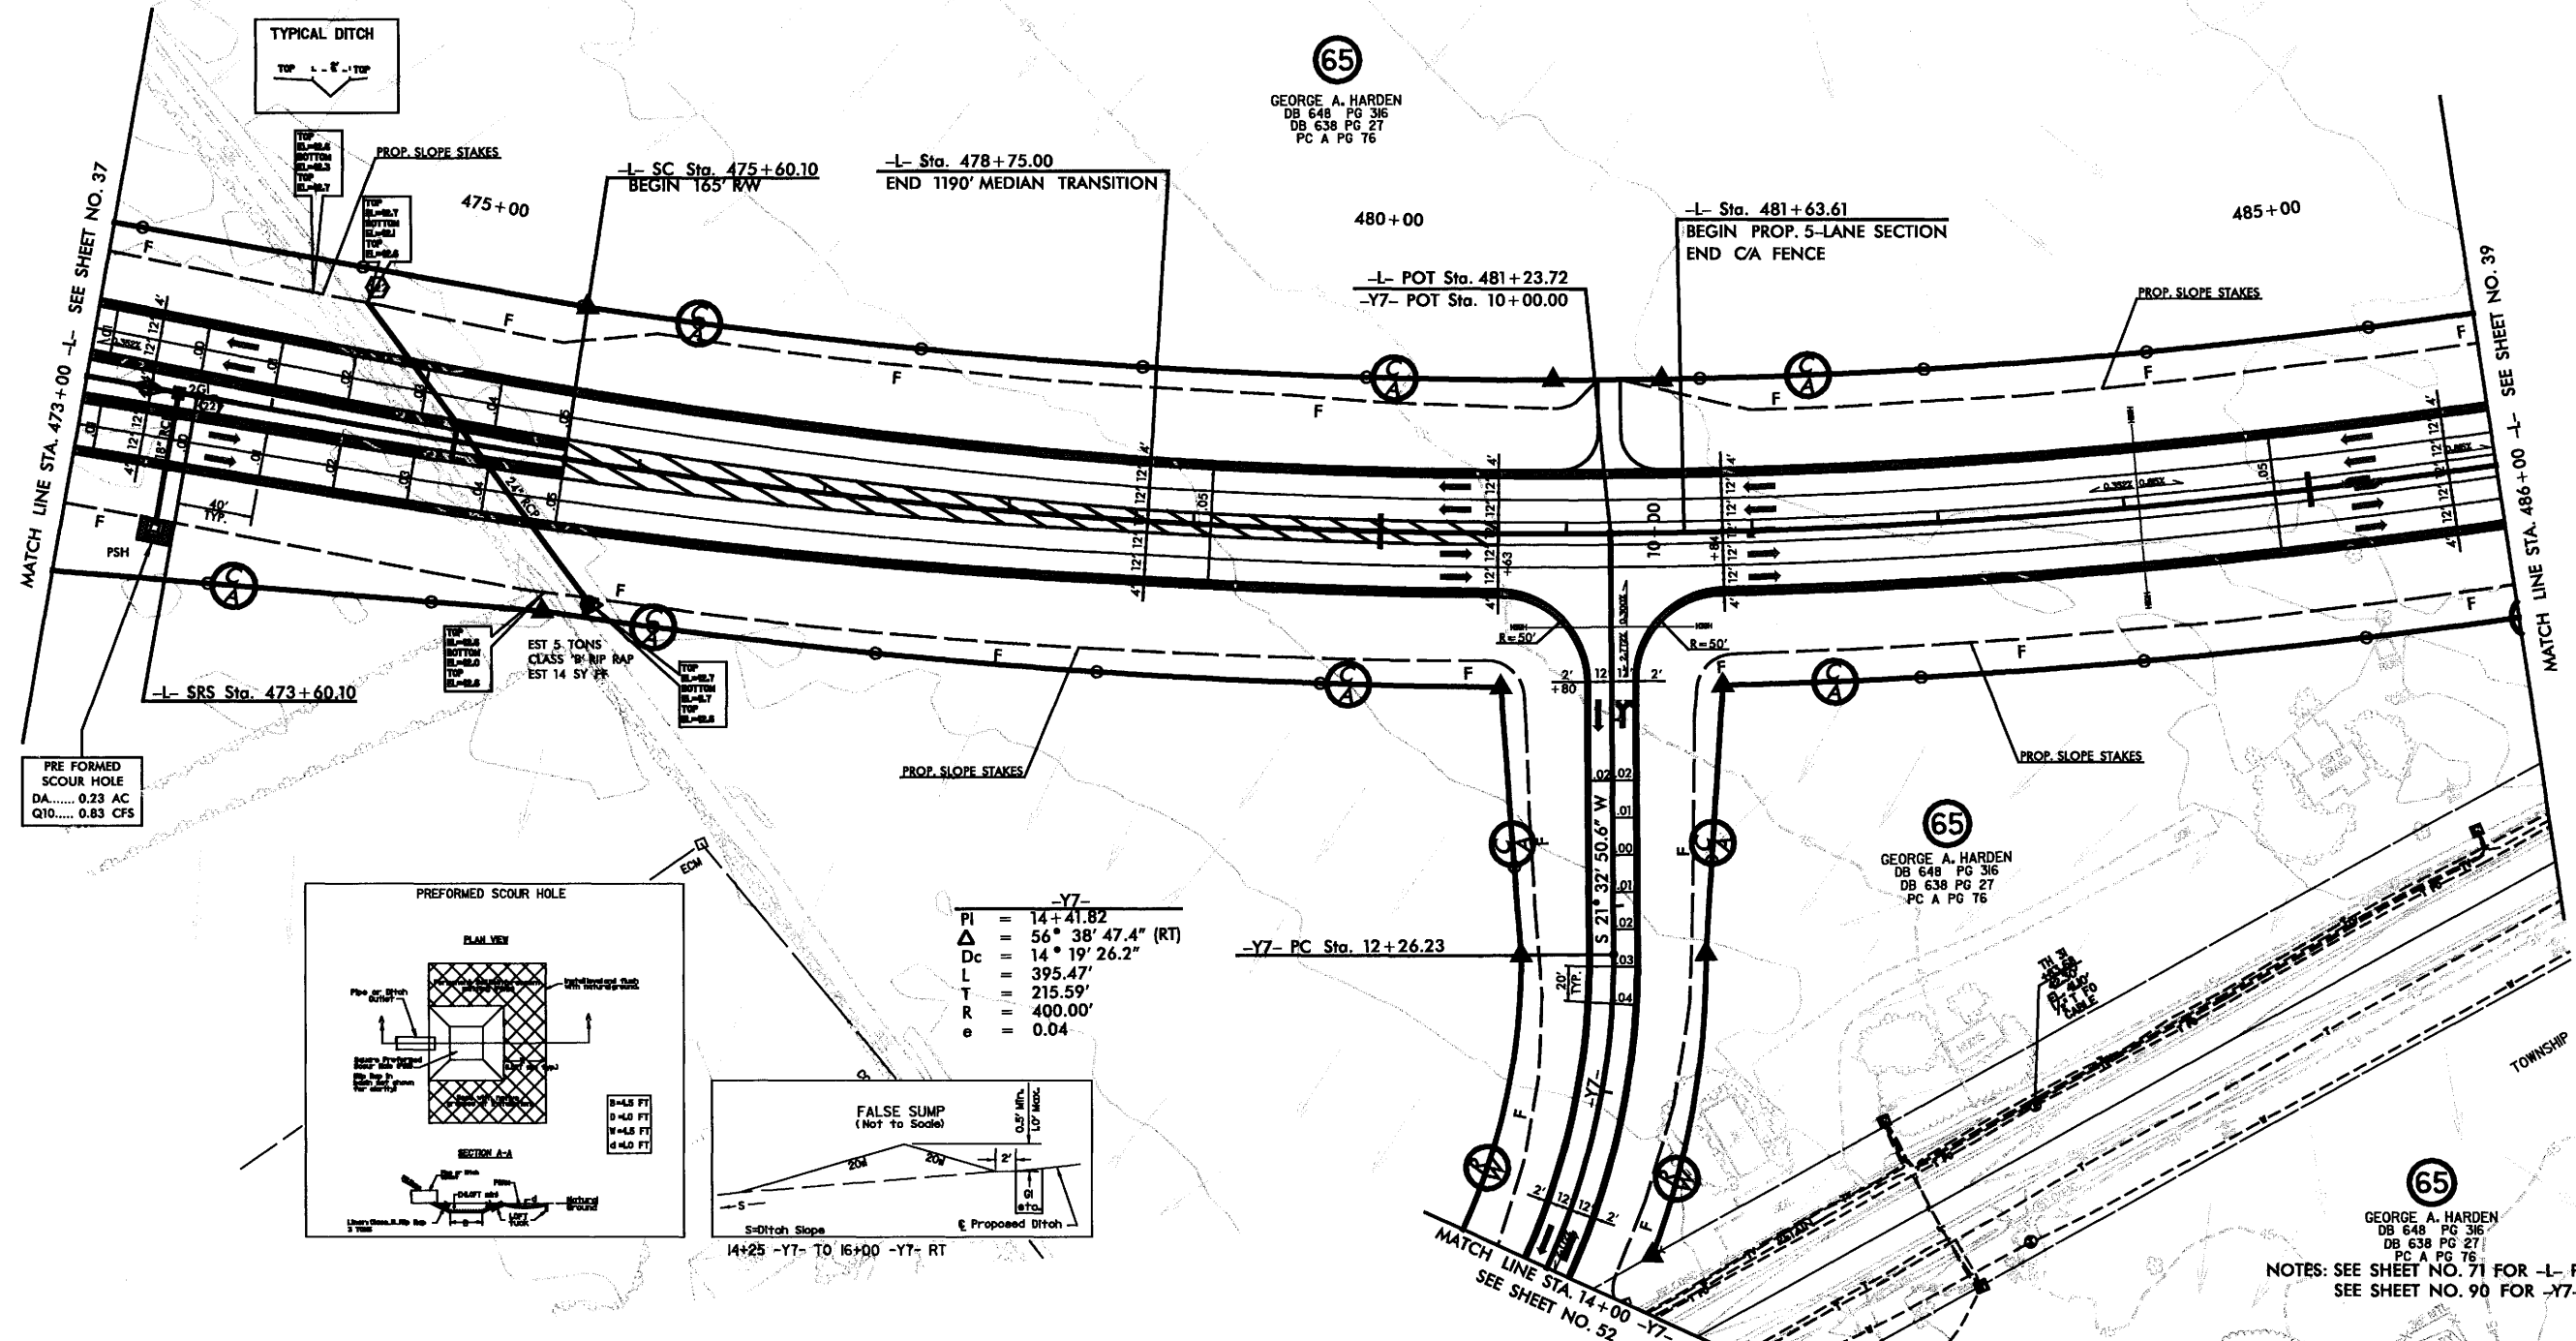

-Y7-
PI = 14+41.82
Δ = 56° 38' 47.4" (RT)
Dc = 14° 19' 26.2"
L = 395.47'
T = 215.59'
R = 400.00'
e = 0.04

8/2005
 2404A\2404A\Roadway\2404A\h\Res\line_38.dwg
 10/14/07 M

REVISIONS

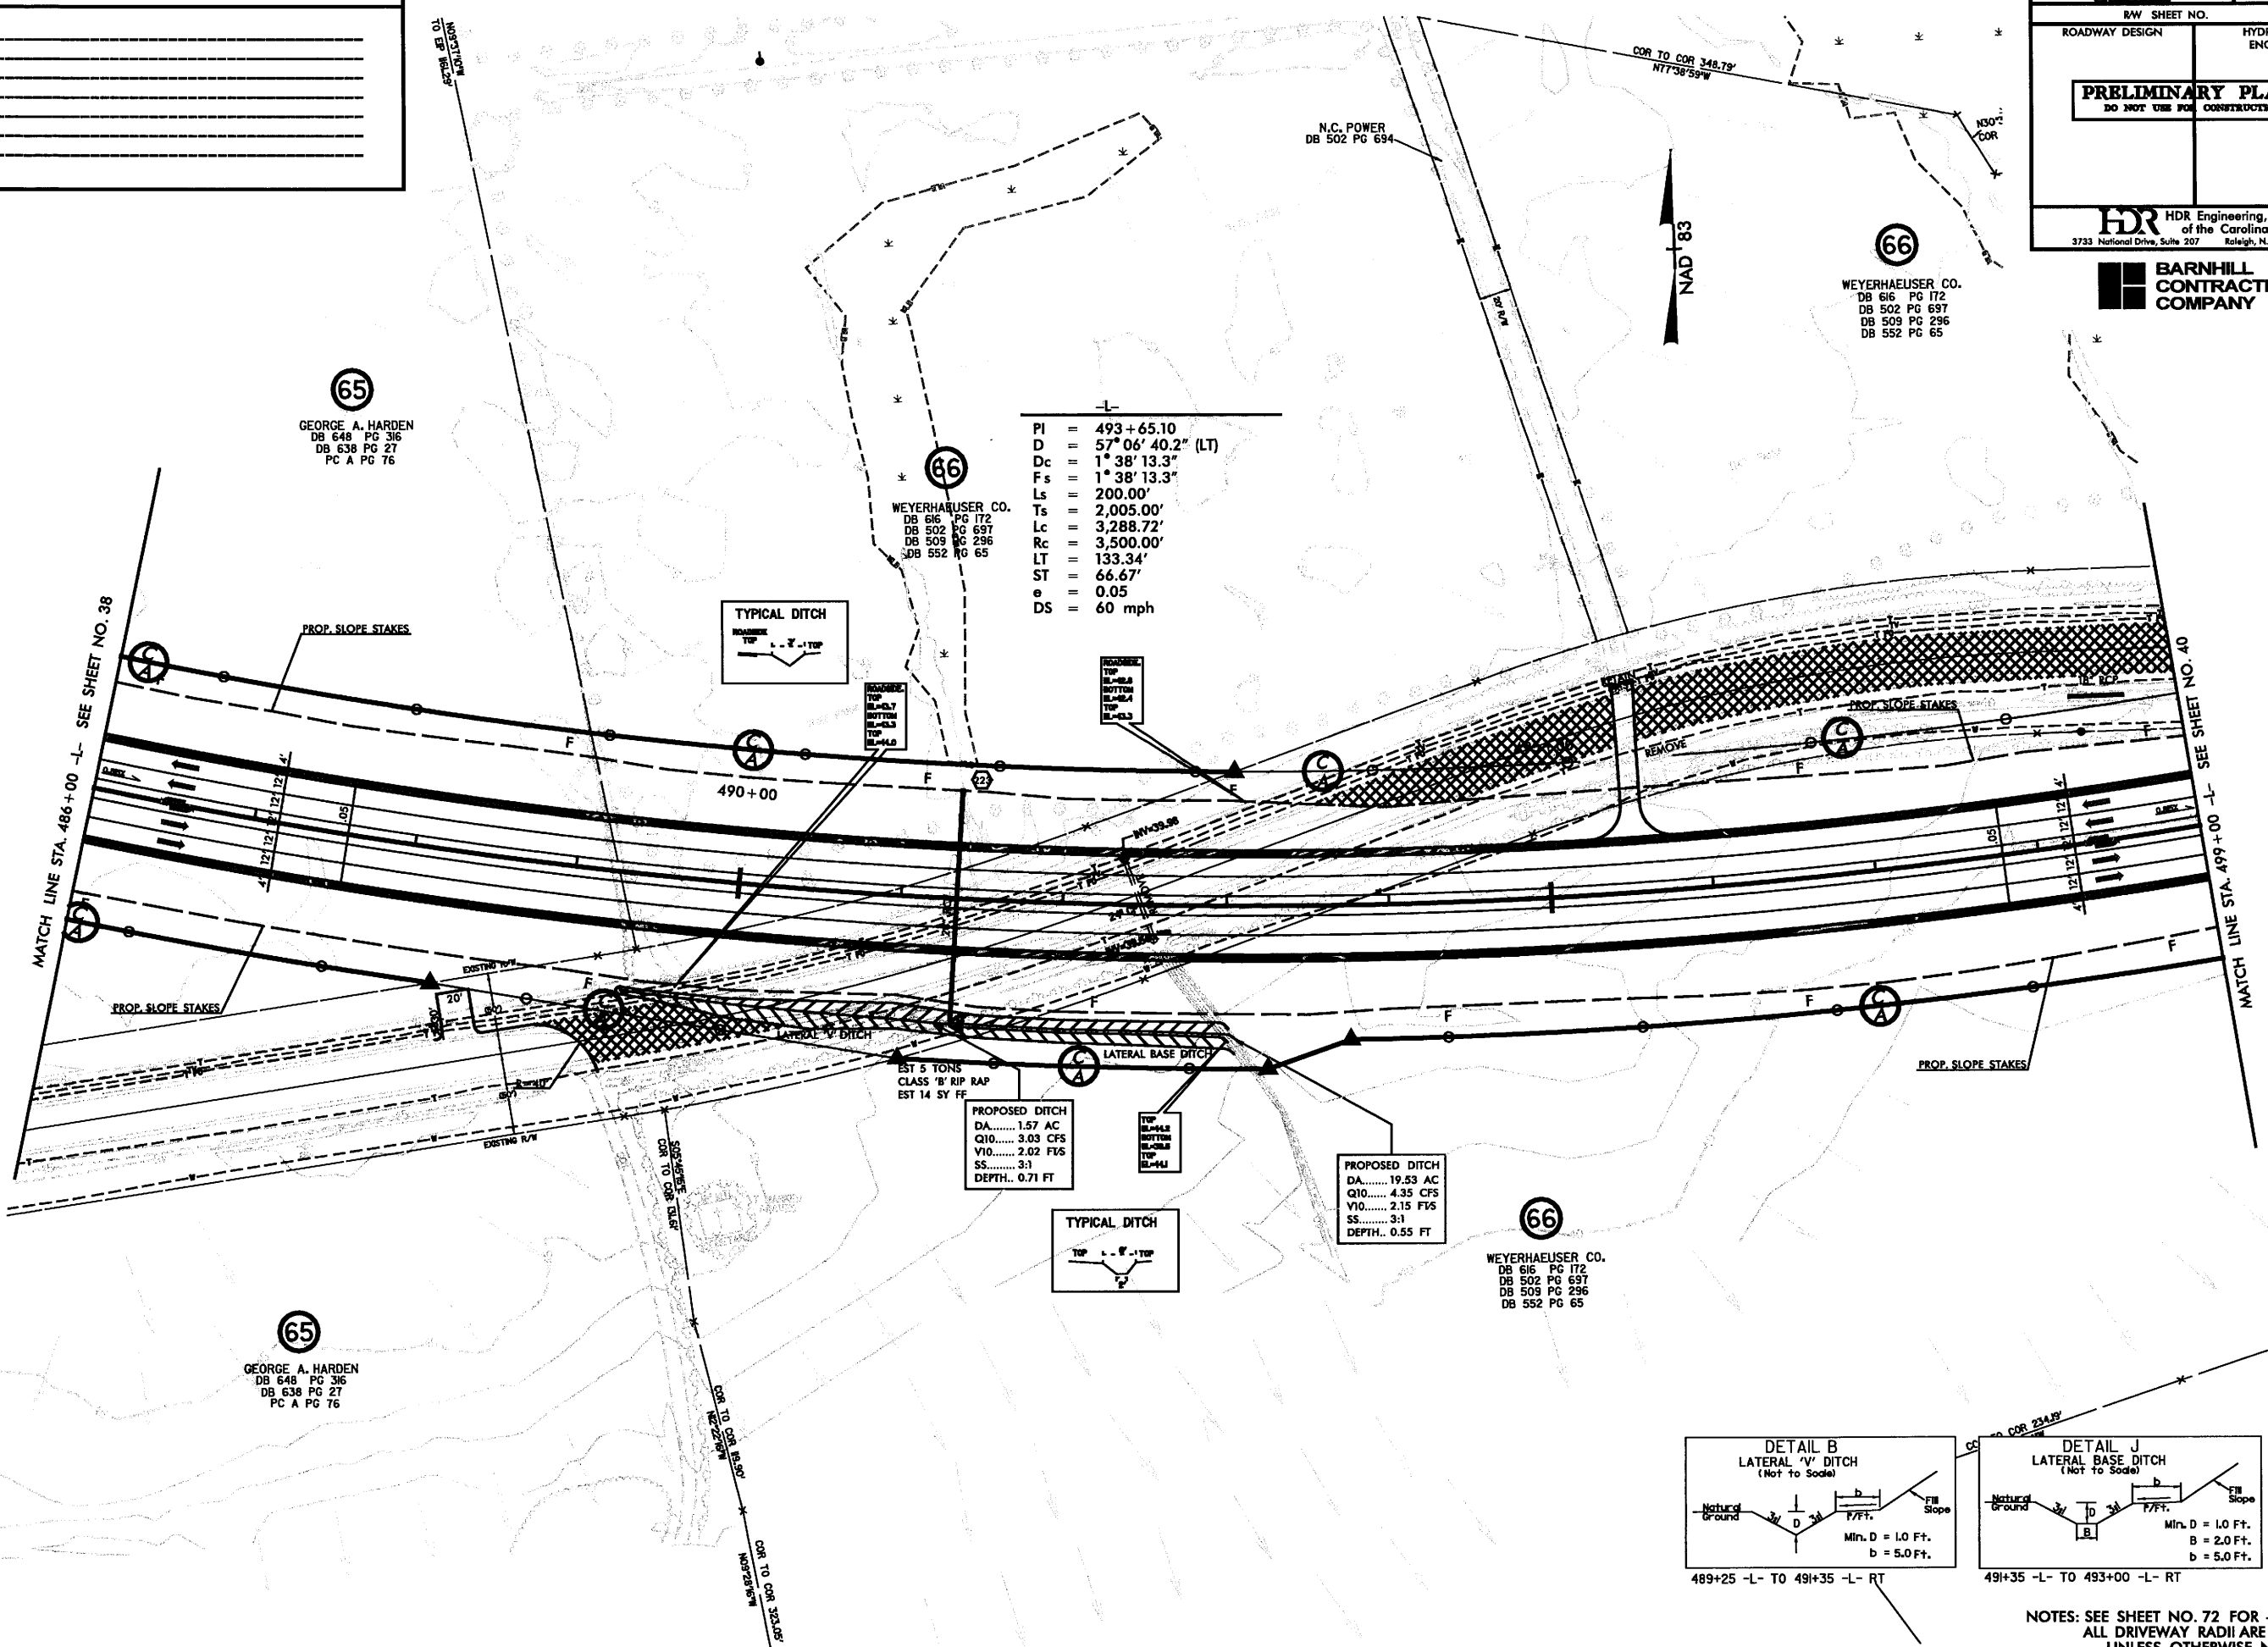

PI = 493+65.10
 D = 57° 06' 40.2" (LT)
 Dc = 1° 38' 13.3"
 Fs = 1° 38' 13.3"
 Ls = 200.00'
 Ts = 2,005.00'
 Lc = 3,288.72'
 Rc = 3,500.00'
 LT = 133.34'
 ST = 66.67'
 e = 0.05
 DS = 60 mph



65
 GEORGE A. HARDEN
 DB 648 PG 316
 DB 638 PG 27
 PC A PG 76

66
 WEYERHAEUSER CO.
 DB 616 PG 172
 DB 502 PG 697
 DB 509 PG 296
 DB 552 PG 65

66
 WEYERHAEUSER CO.
 DB 616 PG 172
 DB 502 PG 697
 DB 509 PG 296
 DB 552 PG 65



66
 WEYERHAEUSER CO.
 DB 616 PG 172
 DB 502 PG 697
 DB 509 PG 296
 DB 552 PG 65

65
 GEORGE A. HARDEN
 DB 648 PG 316
 DB 638 PG 27
 PC A PG 76

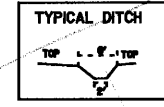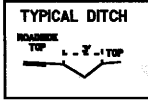

PROPOSED DITCH
 DA..... 1.57 AC
 Q10..... 3.03 CFS
 V10..... 2.02 FVS
 SS..... 3:1
 DEPTH.. 0.71 FT

PROPOSED DITCH
 DA..... 19.53 AC
 Q10..... 4.35 CFS
 V10..... 2.15 FVS
 SS..... 3:1
 DEPTH.. 0.55 FT

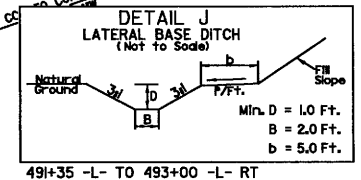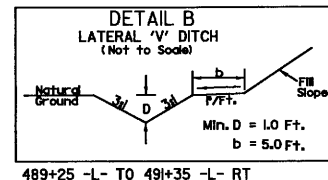

NOTES: SEE SHEET NO. 72 FOR -L- PROFILE.
 ALL DRIVEWAY RADII ARE 20'
 UNLESS OTHERWISE NOTED

8/1/2005 10:44 AM D:\444 AN 2404\Drawings\Roadway\2404A.dwg 39.dgn

REVISIONS





PROJECT REFERENCE NO. R-2404A SHEET NO. 30

Roadway Design HYDRAULICS ENGINEER

PRELIMINARY PLANS DO NOT USE FOR CONSTRUCTION

HDR Engineering, Inc. of the Carolinas 3733 National Drive, Suite 207 Raleigh, N.C. 27612

BARNHILL CONTRACTING COMPANY

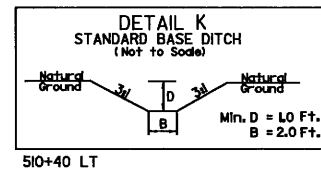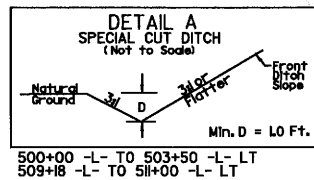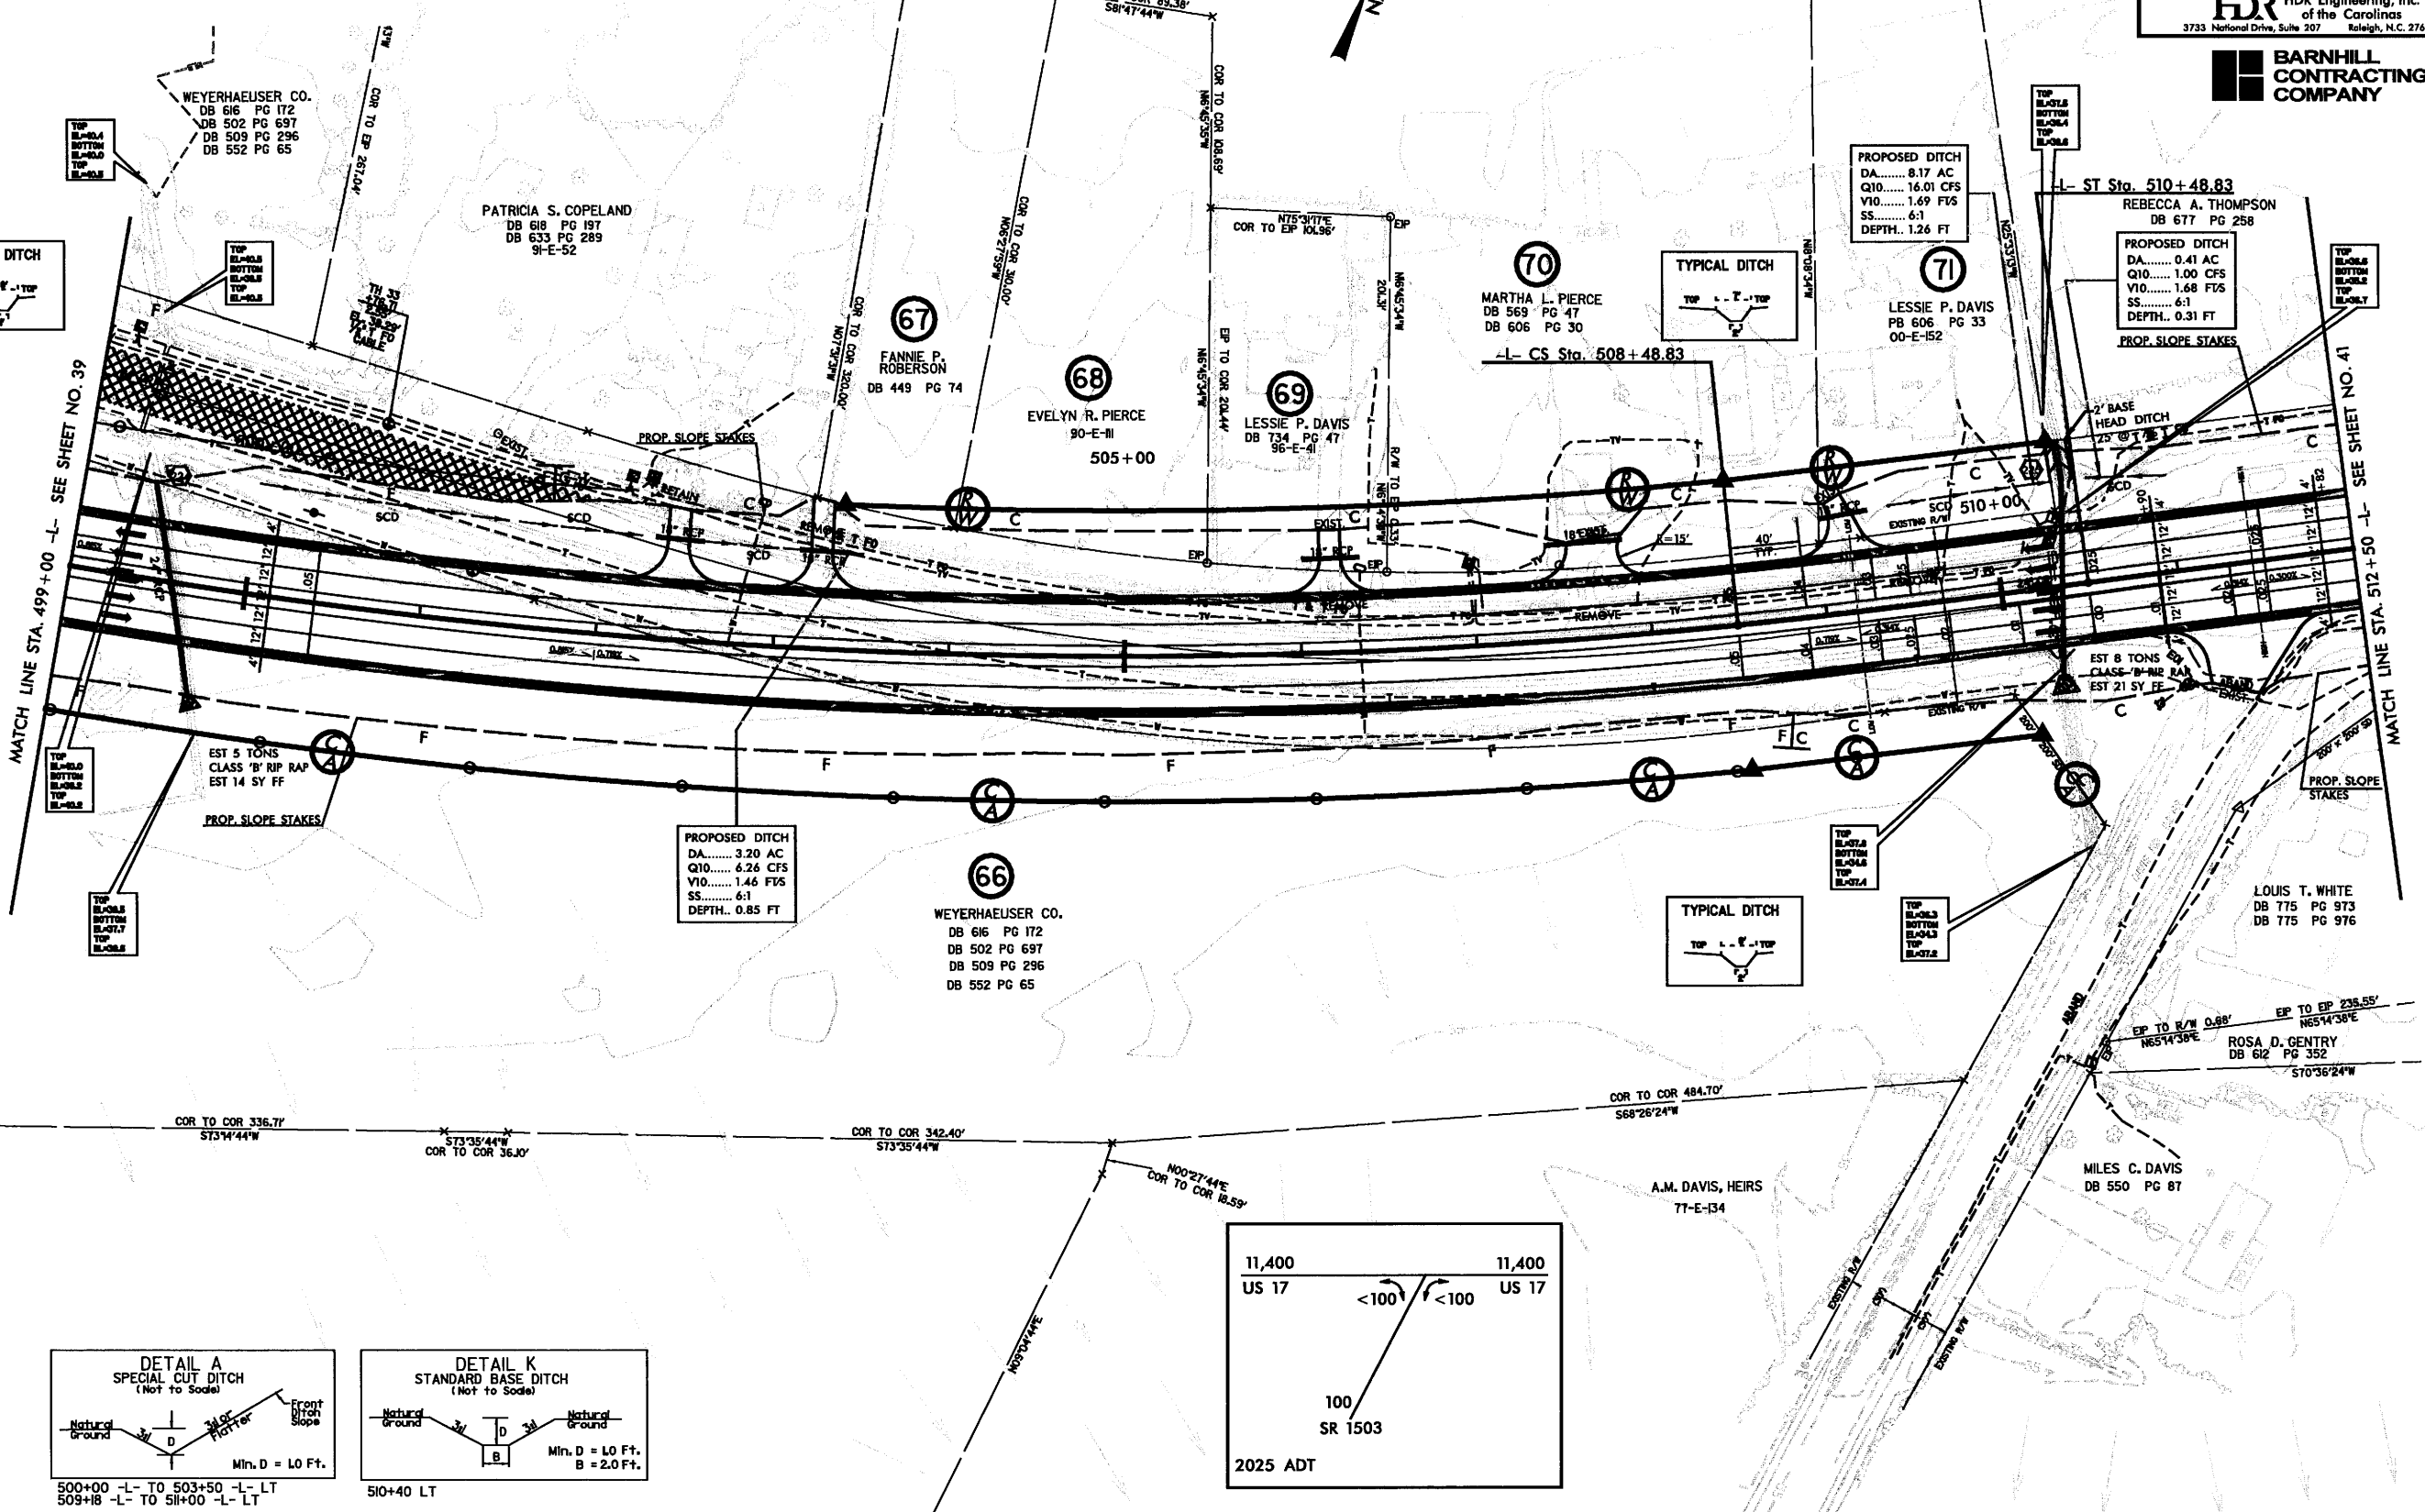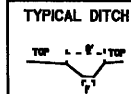


NOTES: SEE SHEET NO. 72 FOR -L- PROFILE. ALL DRIVEWAY RADII ARE 20' UNLESS OTHERWISE NOTED.

8/2/2005 10:58:35 AM C:\Users\jdoyle\Desktop\2404\2404.dwg

REVISIONS

PROJECT REFERENCE NO. R-2404A	SHEET NO. 41
RW SHEET NO.	
ROADWAY DESIGN	HYDRAULICS ENGINEER
PRELIMINARY PLANS DO NOT USE FOR CONSTRUCTION	
HDR HDR Engineering, Inc. of the Carolinas 3733 National Drive, Suite 207 Raleigh, N.C. 27612	

BARNHILL CONTRACTING COMPANY

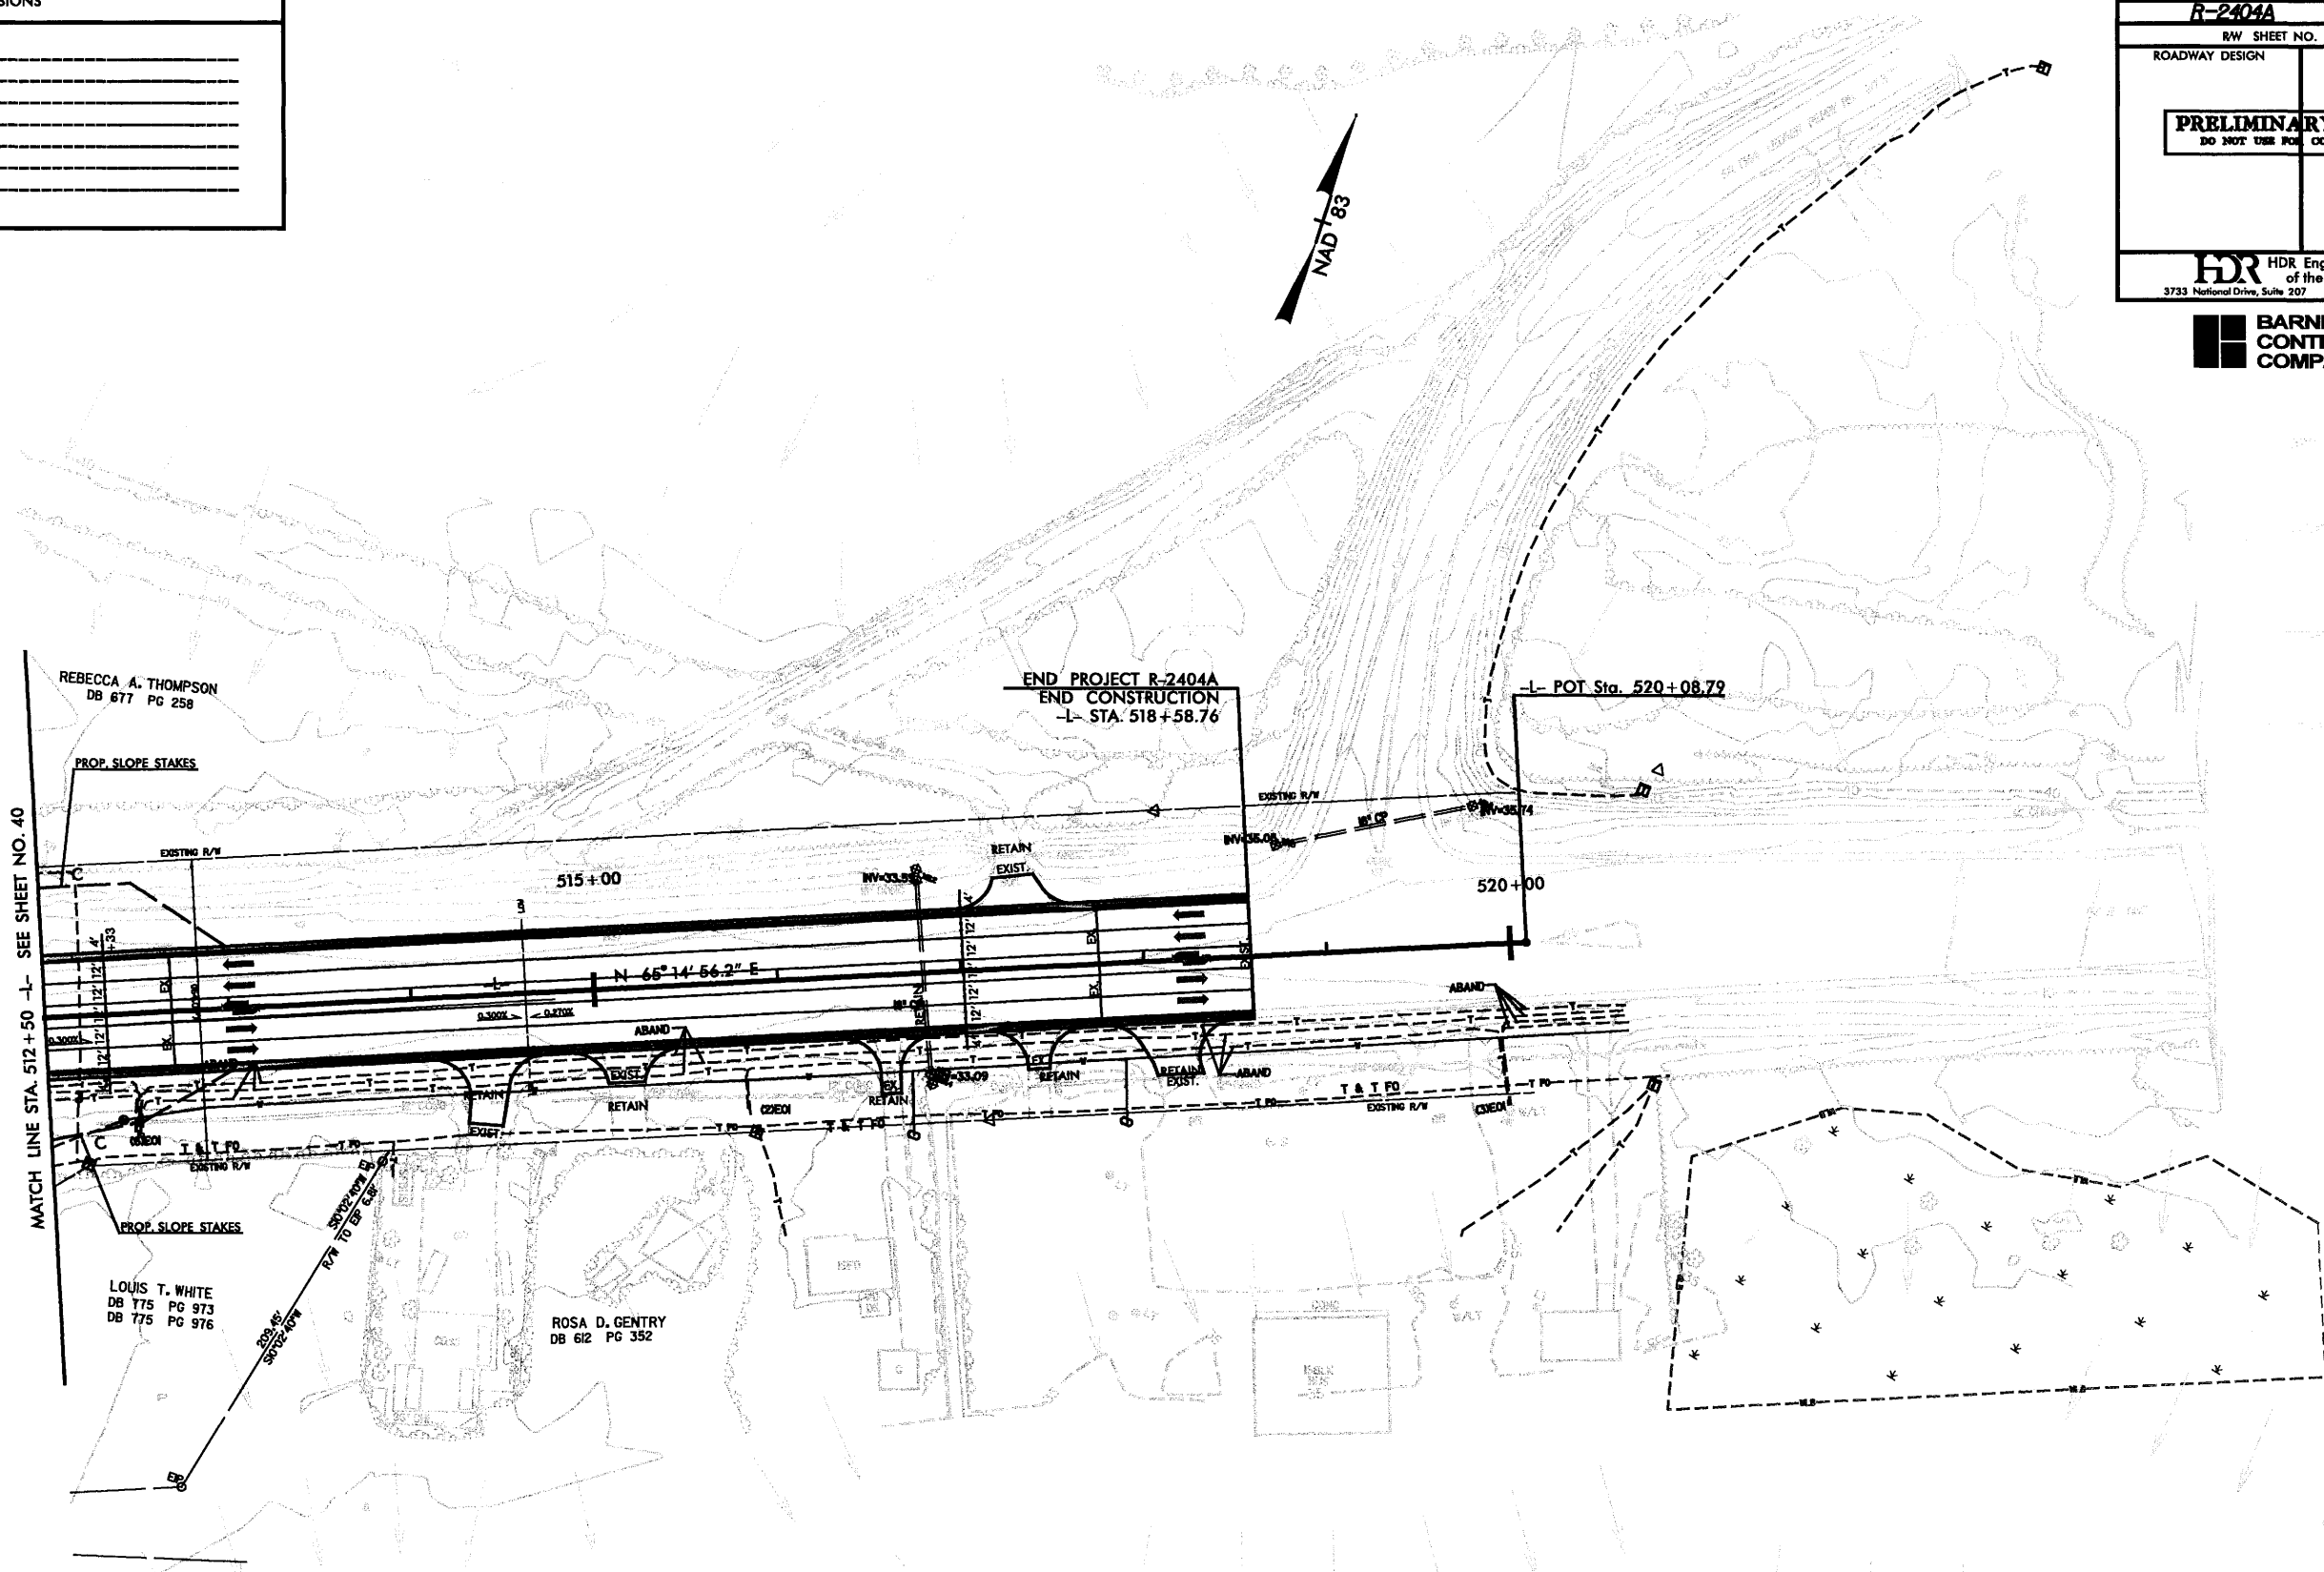

REBECCA A. THOMPSON
DB 677 PG 258

END PROJECT R-2404A
END CONSTRUCTION
-L- STA. 518+58.76

-L- POT Sta. 520+08.79

MATCH LINE STA. 512+50 -L- SEE SHEET NO. 40



LOUIS T. WHITE
DB 775 PG 973
DB 775 PG 976


ROSA D. GENTRY
DB 612 PG 352

NOTES: SEE SHEET NO. 73 FOR -L- PROFILE.
ALL DRIVEWAY RADII ARE 20'
UNLESS OTHERWISE NOTED.

8/7/2005 10:49:00 AM
 2404A\Drawings\Roadway\2404A_101_Roadline.dwg_41.dwg

REVISIONS

PROJECT REFERENCE NO. R-2404A	SHEET NO. 42
R/W SHEET NO.	REVISIONS
ROADWAY DESIGN	HYDRAULICS ENGINEER
PRELIMINARY PLANS DO NOT USE FOR CONSTRUCTION	
 HDR Engineering, Inc. of the Carolinas 3733 National Drive, Suite 207 Raleigh, N.C. 27612	
 BARNHILL CONTRACTING COMPANY	

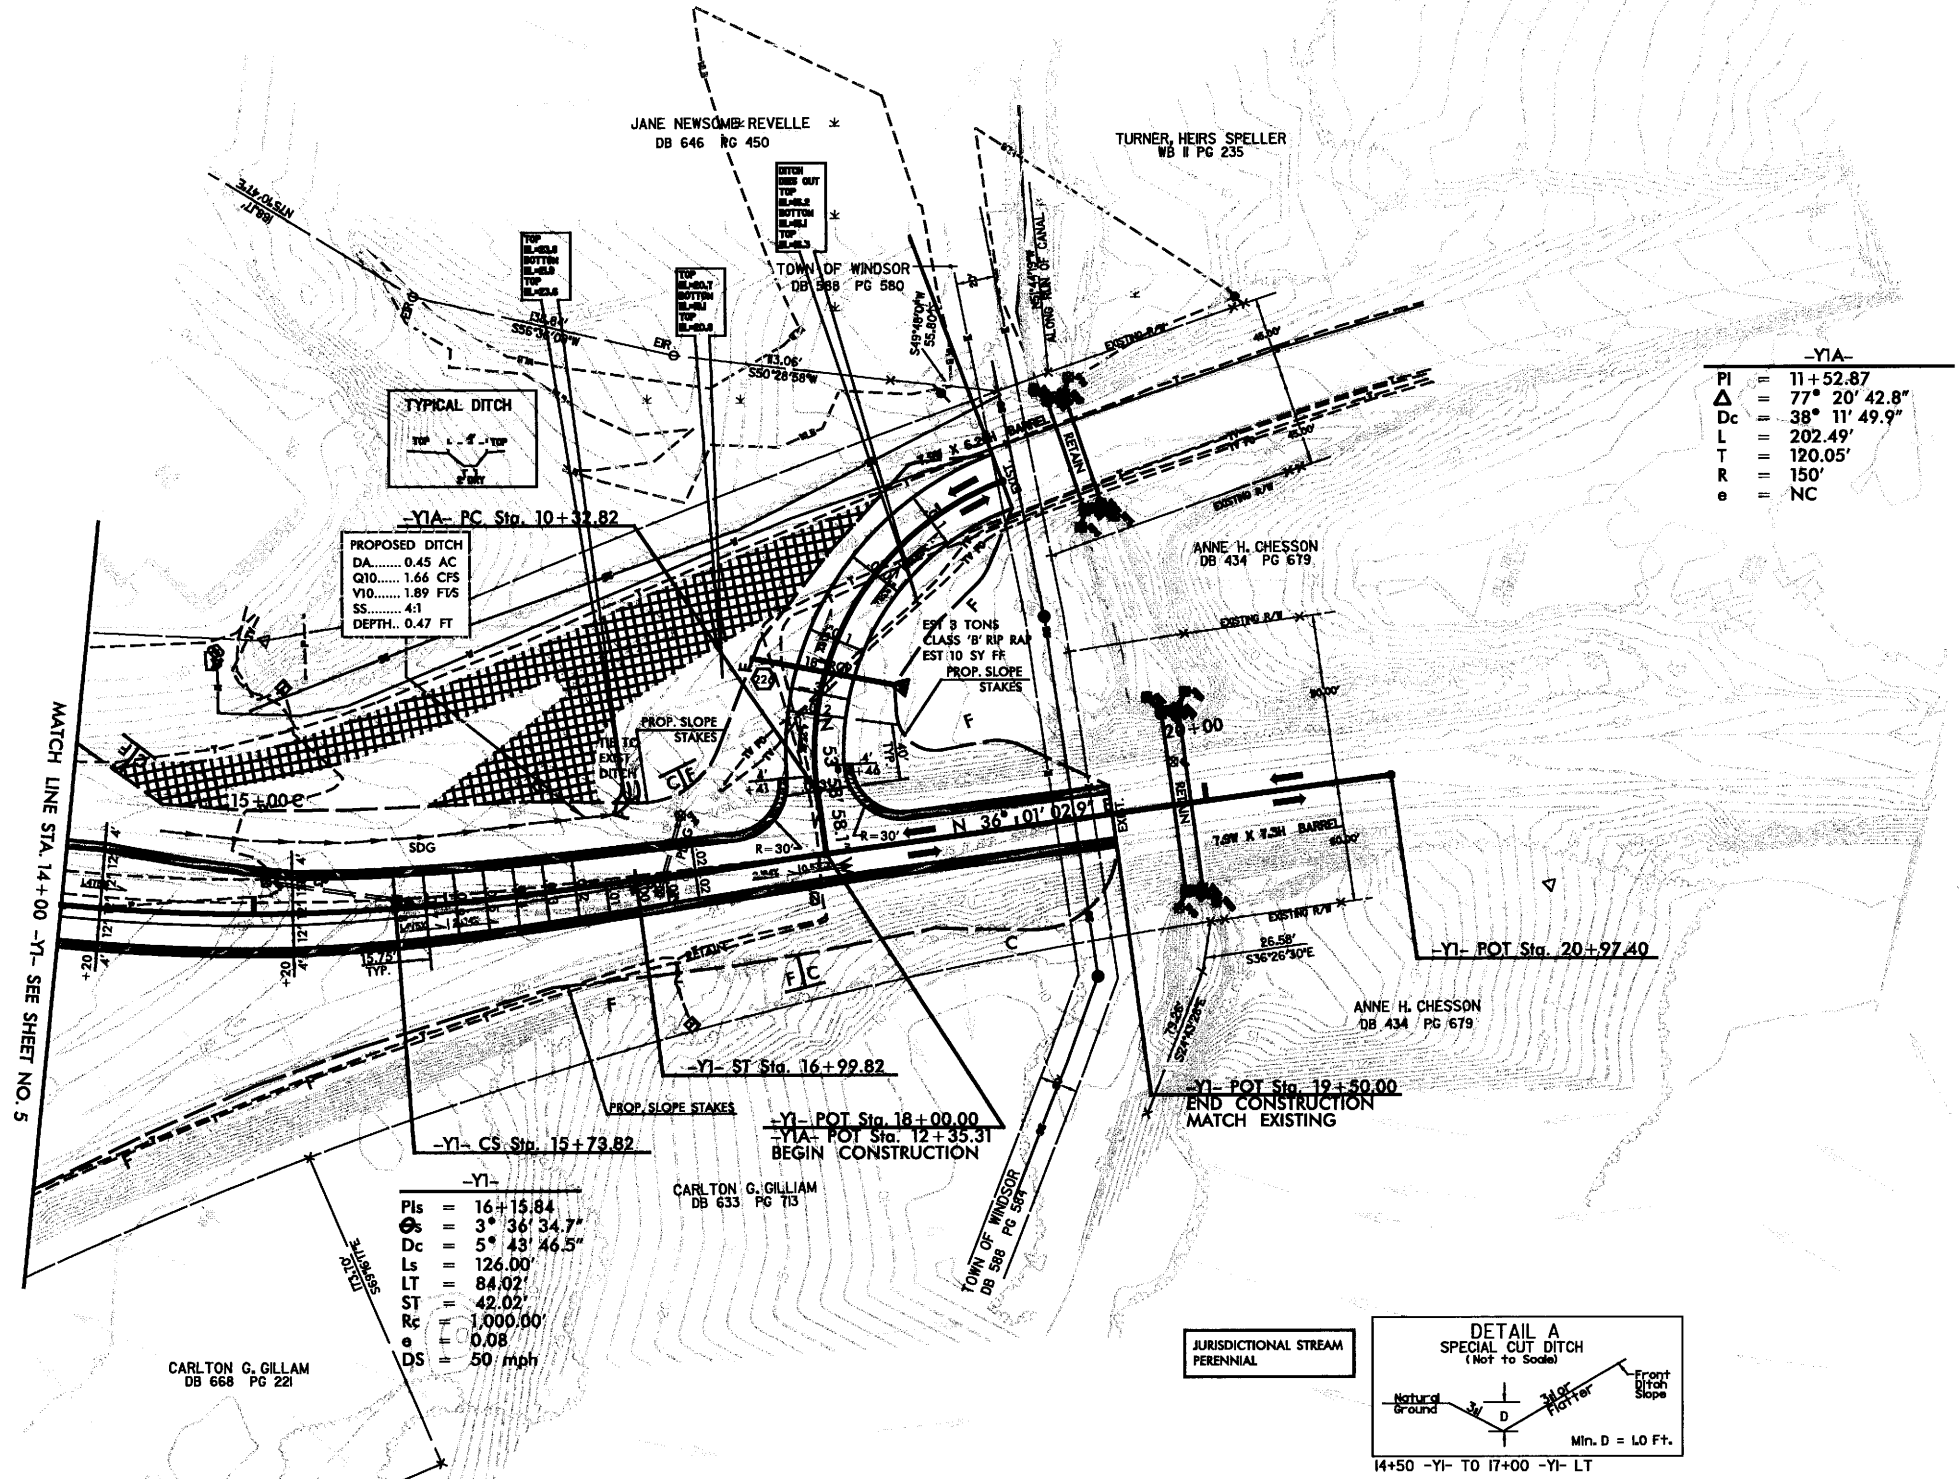

-Y1A-


PI	= 11+52.87
Δ	= 77° 20' 42.8"
Dc	= 38° 11' 49.9"
L	= 202.49'
T	= 120.05'
R	= 150'
e	= NC


PROPOSED DITCH
DA..... 0.45 AC
Q10..... 1.66 CFS
V10..... 1.89 FVS
SS..... 41
DEPTH.. 0.47 FT

-Y1-

PIs	= 16+15.84
Δ	= 3° 36' 34.7"
Dc	= 5° 43' 46.5"
Ls	= 126.00'
LT	= 84.02'
ST	= 42.02'
Rc	= 1,000.00'
e	= 0.08
DS	= 50 mph


JURISDICTIONAL STREAM
PERENNIAL

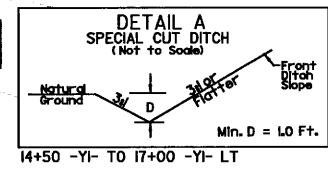


 PAVEMENT TO BE OBLITERATED
NOTES: SEE SHEET NO. 74 FOR -Y1- PROFILE.
SEE SHEET NO. 91 FOR -Y1A- PROFILE.
DO NOT PLACE ROCK IN BED OF JURISDICTIONAL STREAMS.

8/1/2005 10:49:24 AM \\sdc\work\steele\2404A\174\Redline_sph_42.dgn

REVISIONS

PROJECT REFERENCE NO. R-2404A	SHEET NO. 44
RW SHEET NO.	
ROADWAY DESIGN	HYDRAULICS ENGINEER
PRELIMINARY PLANS DO NOT USE FOR CONSTRUCTION	
 HDR Engineering, Inc. of the Carolinas 3733 National Drive, Suite 207 Raleigh, N.C. 27612	

BARNHILL CONTRACTING COMPANY

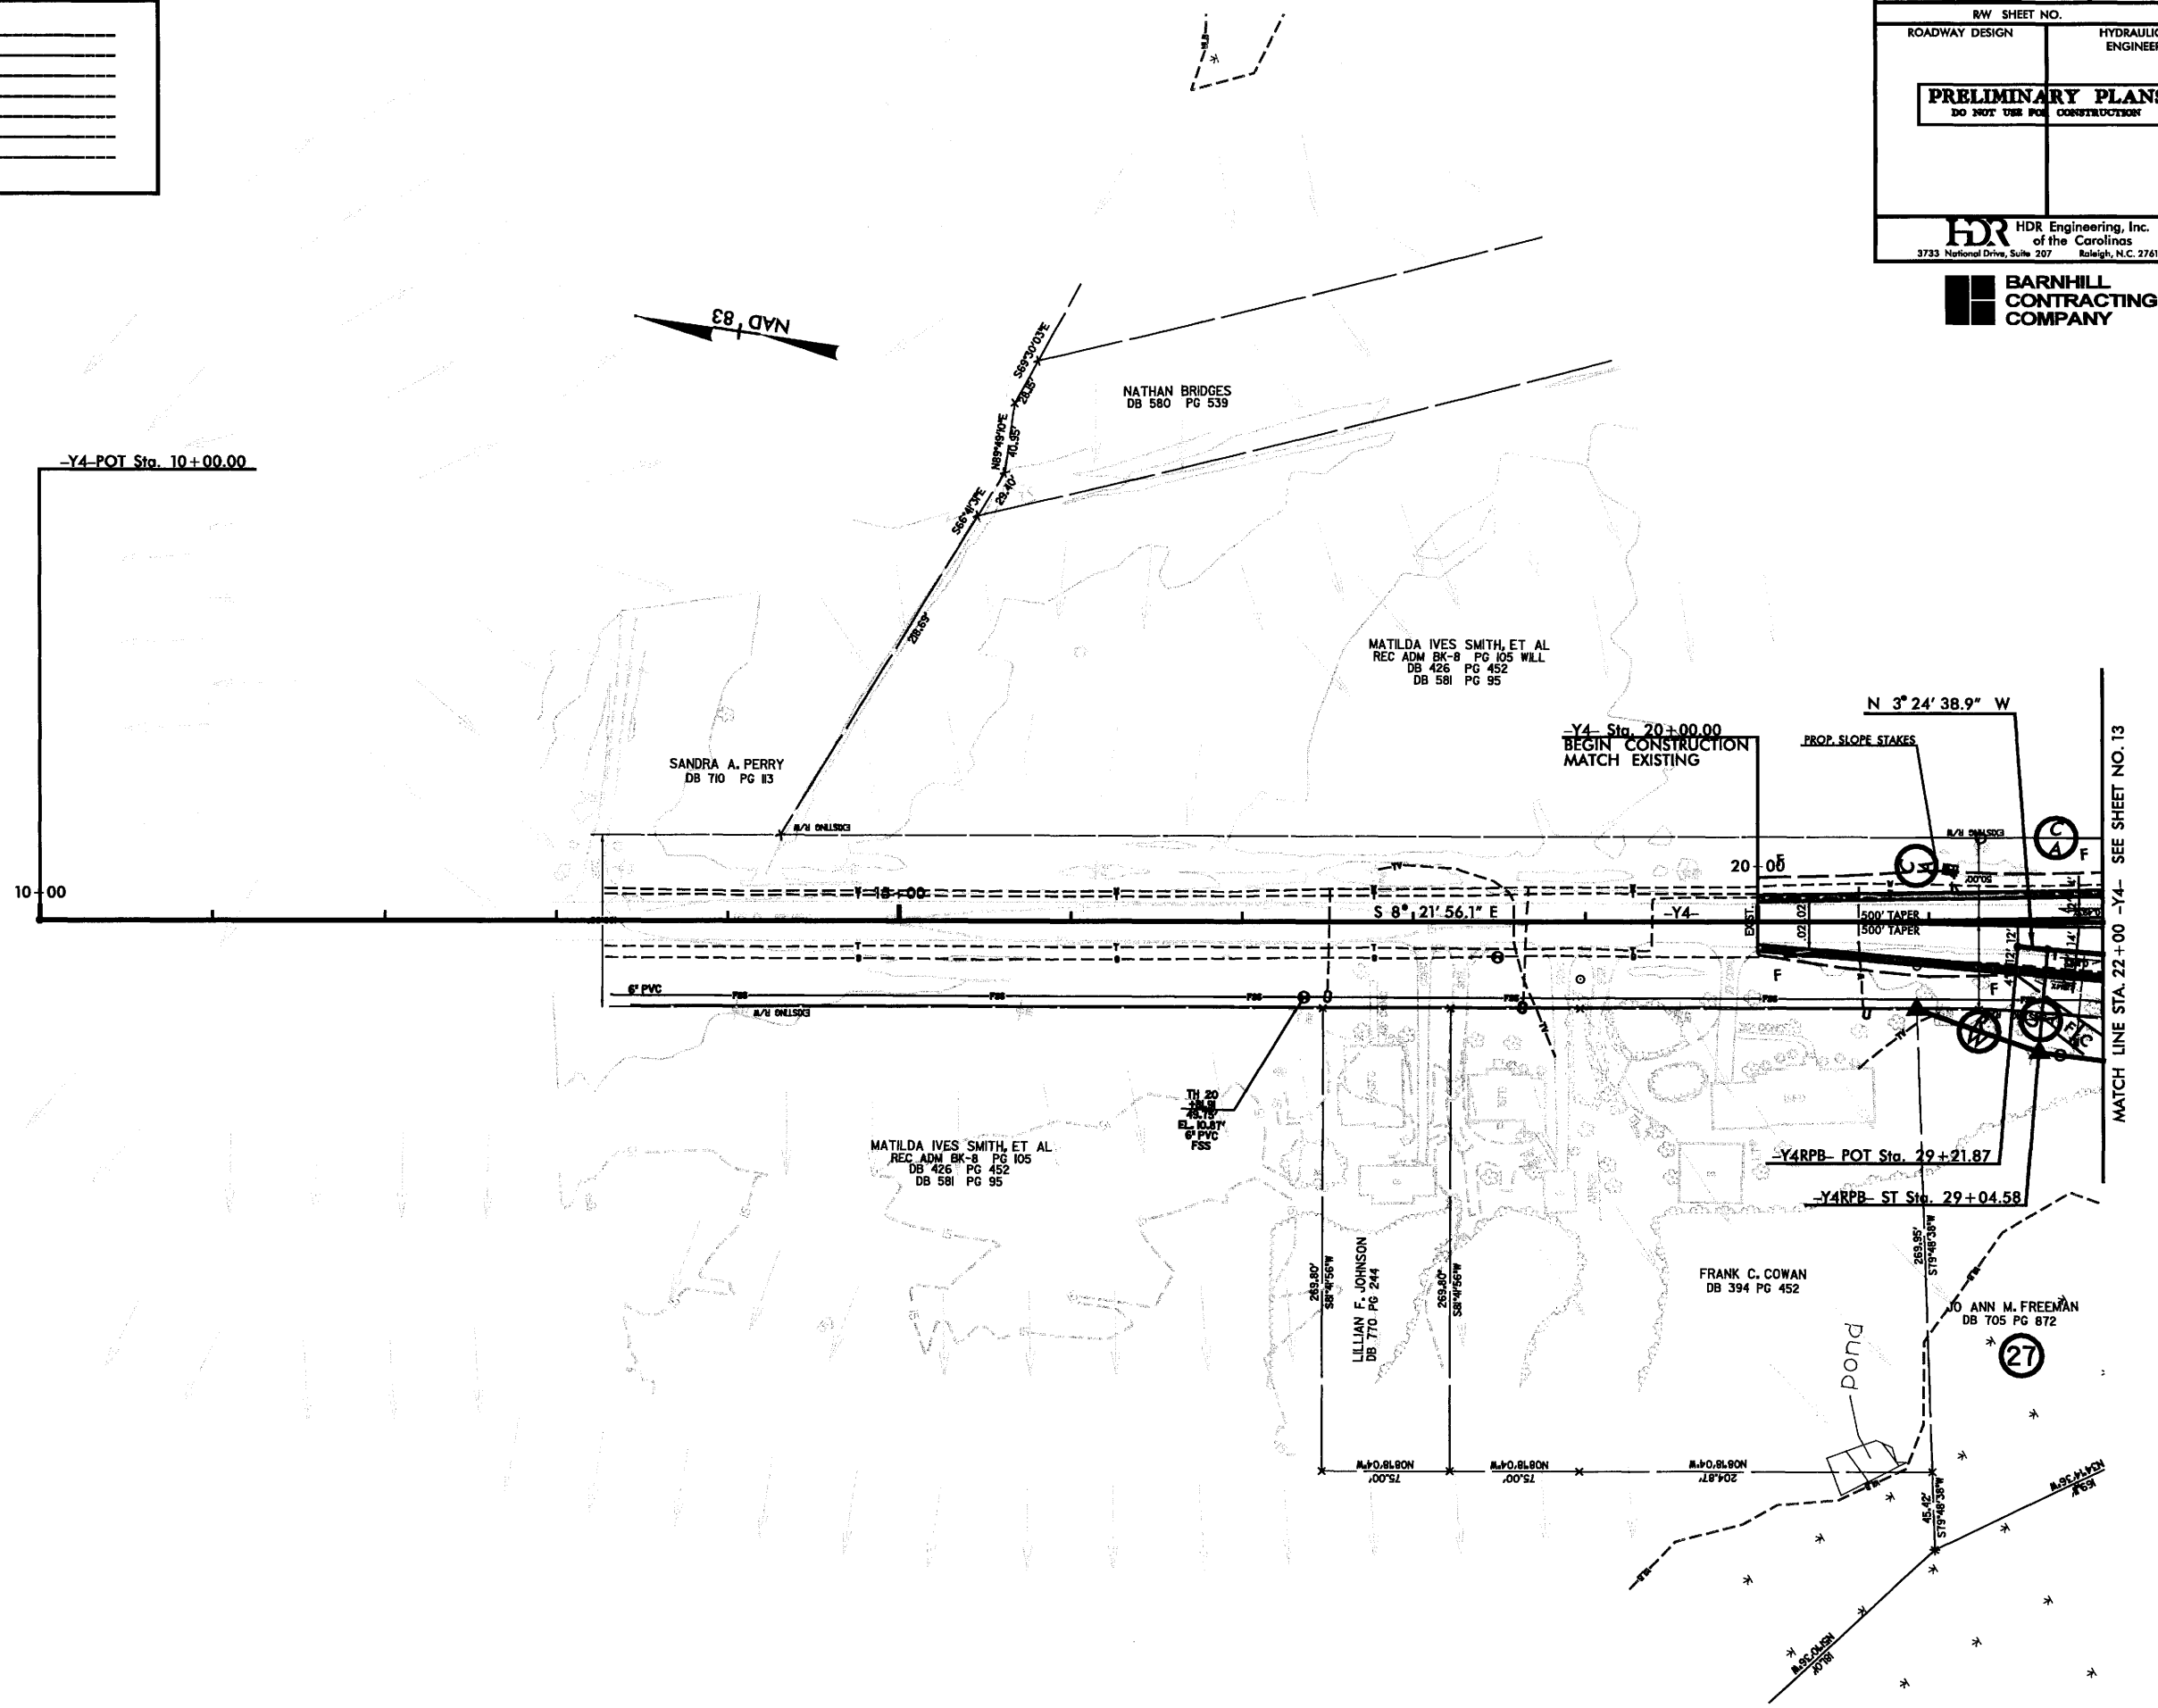

8/1/2005 10:50:06 AM 2404A\Drawings\Baseline\plan\2404A_rwd\Baseline_rwb_44.dwg

NOTES: SEE SHEET NO. 76 FOR -Y4- PROFILE.

REVISIONS

PROJECT REFERENCE NO. R-2404A	SHEET NO. 46
RAW SHEET NO.	
ROADWAY DESIGN	HYDRAULICS ENGINEER
PRELIMINARY PLANS DO NOT USE FOR CONSTRUCTION	
HDR Engineering, Inc. of the Carolinas 3733 National Drive, Suite 207 Raleigh, N.C. 27612	
BARNHILL CONTRACTING COMPANY	



- 229 2G(B)
Sta. 16+93 LT
D.A. = 0.93 Ac
Grate El= 33.90 ft
Invert= 22.30 ft
Depth= 11.60
- 234 OPEN END
Sta. 20+15 LT
D.A. = 50.49 Ac
Grate El= 24.33 ft
Invert= 24.33 ft
Depth= 0.0

-Y5DET-
 PI = 11+41.27
 D = 22° 35' 42.2" (LT)
 Dc = 8° 06' 08.2"
 L = 278.87'
 T = 141.27'
 R = 707.16'


-Y5-
 PI = 15+42.54
 Δ = 28° 43' 39.1" (RT)
 Dc = 5° 54' 24.4"
 Δs = 5° 54' 24.4"
 Ls = 200.00'
 Ts = 348.80'
 Lc = 286.35'
 Rc = 970.00'
 LT = 133.41'
 ST = 66.73'
 e = 0.08
 DS = 55 mph

-Y5DET-
 PI = 18+49.27
 D = 23° 37' 35.6" (RT)
 Dc = 5° 54' 24.4"
 L = 399.99'
 T = 202.88'
 R = 970.00'

SITE 9

PROPOSED DITCH
 DA..... 1.49 AC
 Q10..... 3.25 CFS
 V10..... 2.79 FFS
 SS..... 3:1
 DEPTH.. 0.62 FT

PROPOSED DITCH
 DA..... 1.94 AC
 Q10..... 5.22 CFS
 V10..... 3.15 FFS
 SS..... 3:1
 DEPTH.. 0.74 FT

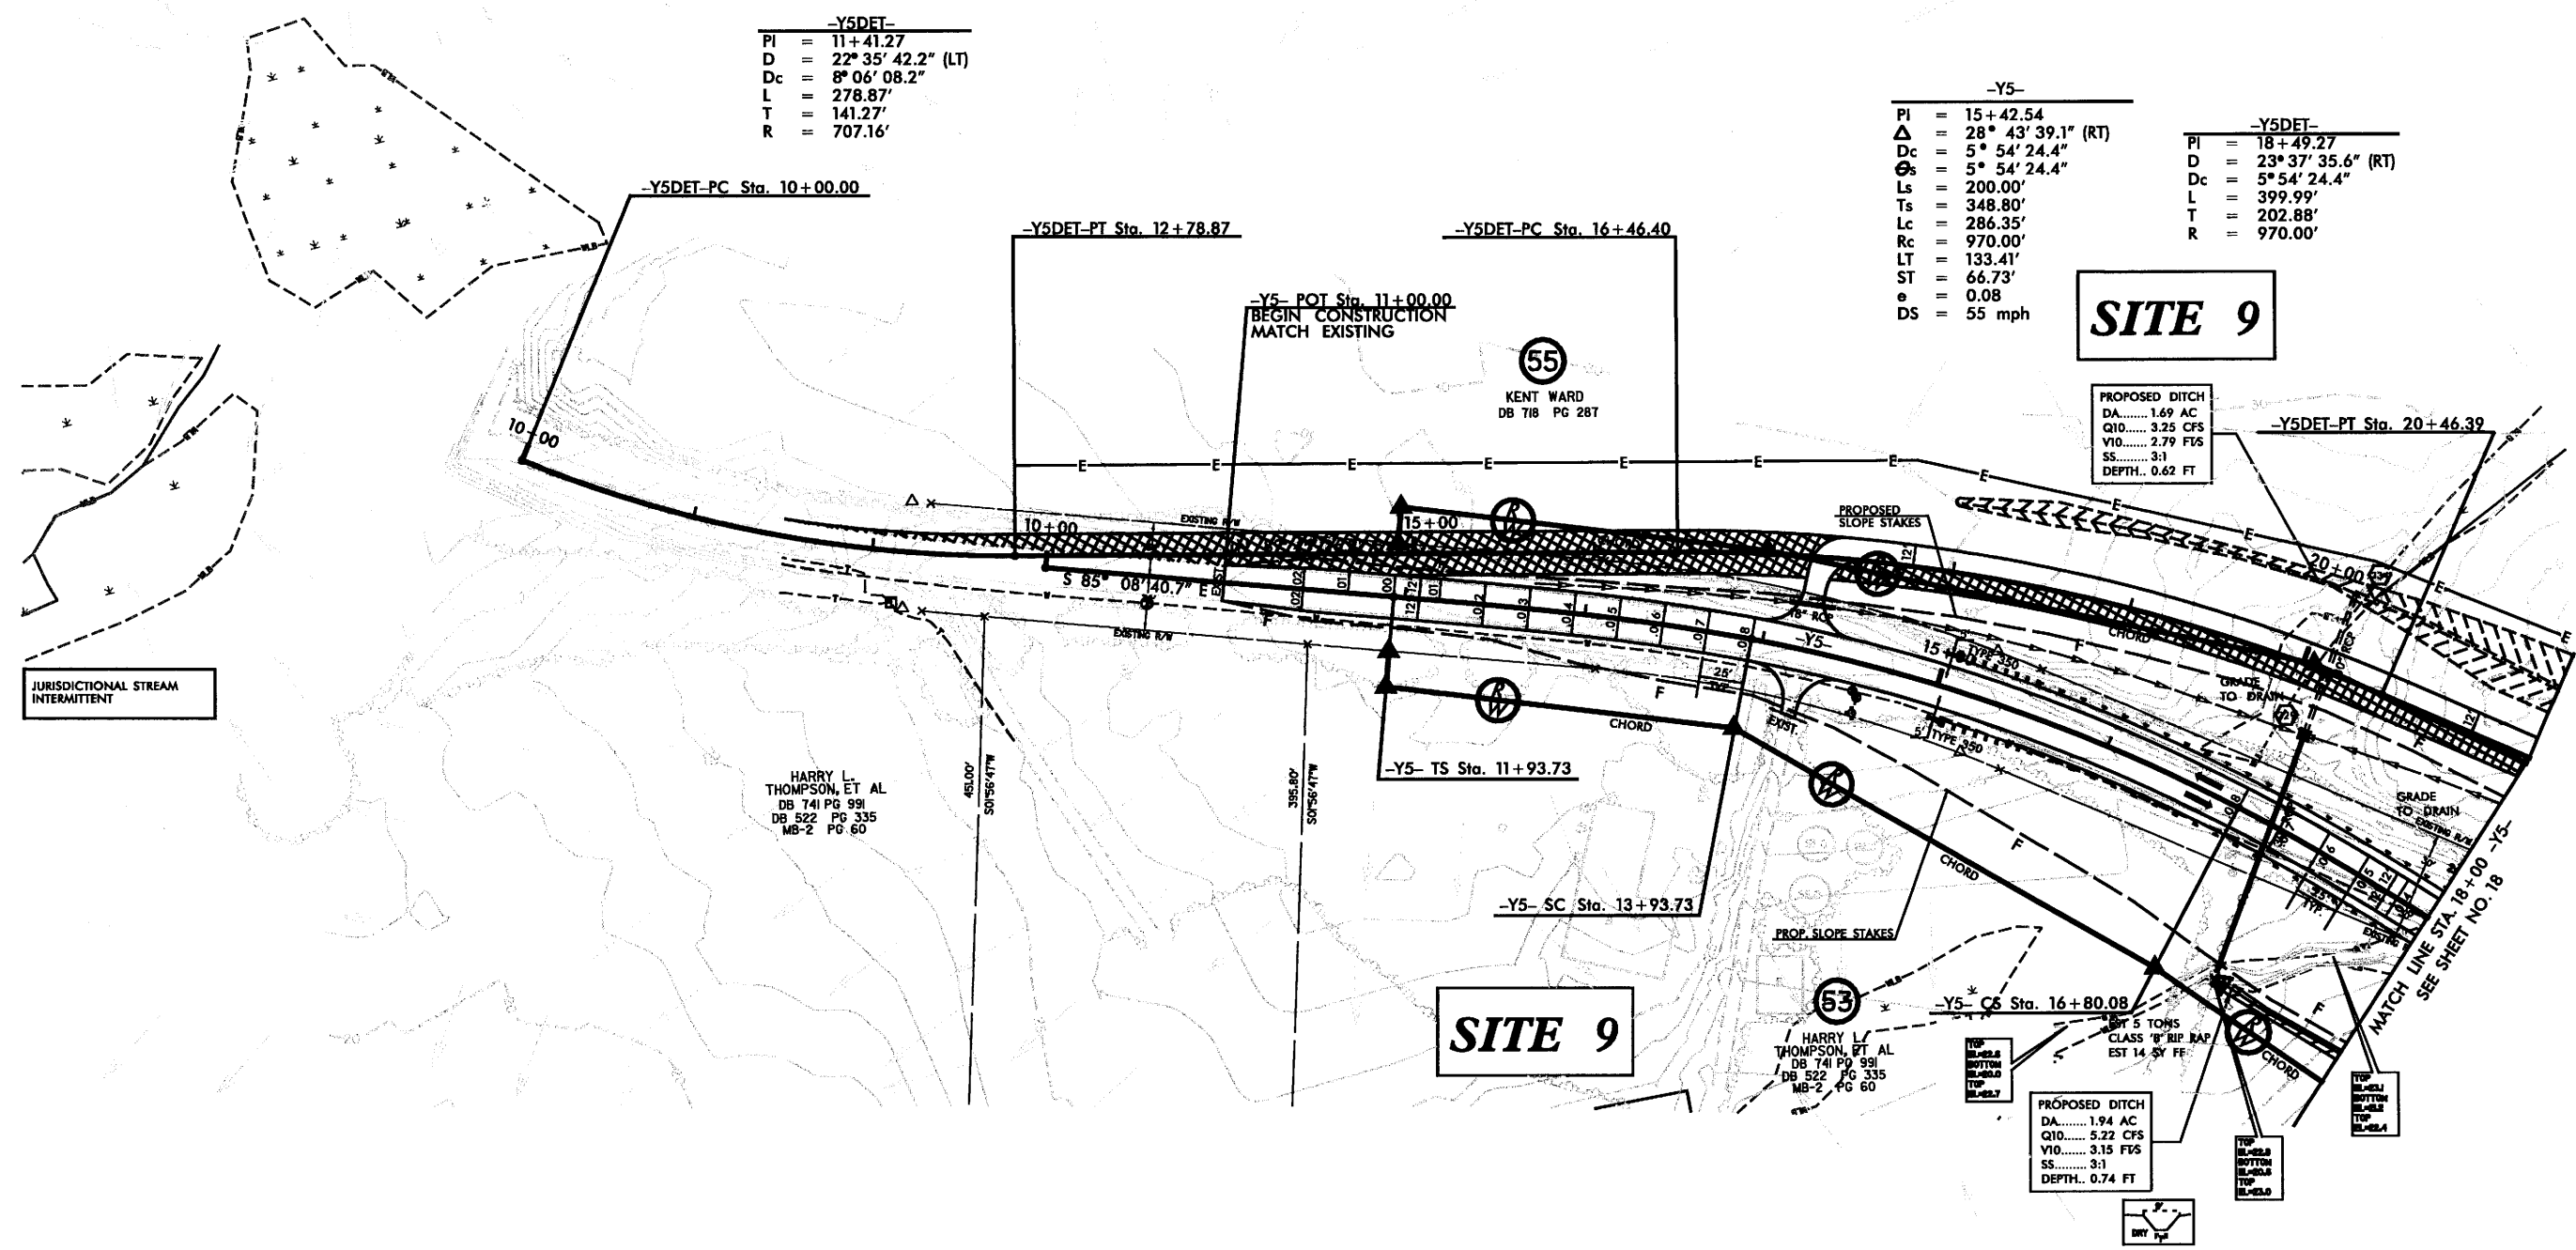



JURISDICTIONAL STREAM
INTERMITTENT


SITE 9

NOTES: SEE SHEET NO. 82 FOR -Y5- PROFILE.
 ALL DRIVEWAY RADII ARE 20' UNLESS OTHERWISE NOTED.
 DO NOT PLACE ROCK IN BED OF JURISDICTIONAL STREAMS.

8/1/2005 10:25:25 AM 2402510001\Roadline - signmaster\122404.tbl R:\dms\ast_46.dwg


REVISIONS

PROJECT REFERENCE NO. R-2404A	SHEET NO. 47
RW SHEET NO.	
ROADWAY DESIGN	HYDRAULICS ENGINEER
PRELIMINARY PLANS DO NOT USE FOR CONSTRUCTION	
 HDR Engineering, Inc. of the Carolinas 3733 National Drive, Suite 207 Raleigh, N.C. 27612	
 BARNHILL CONTRACTING COMPANY	

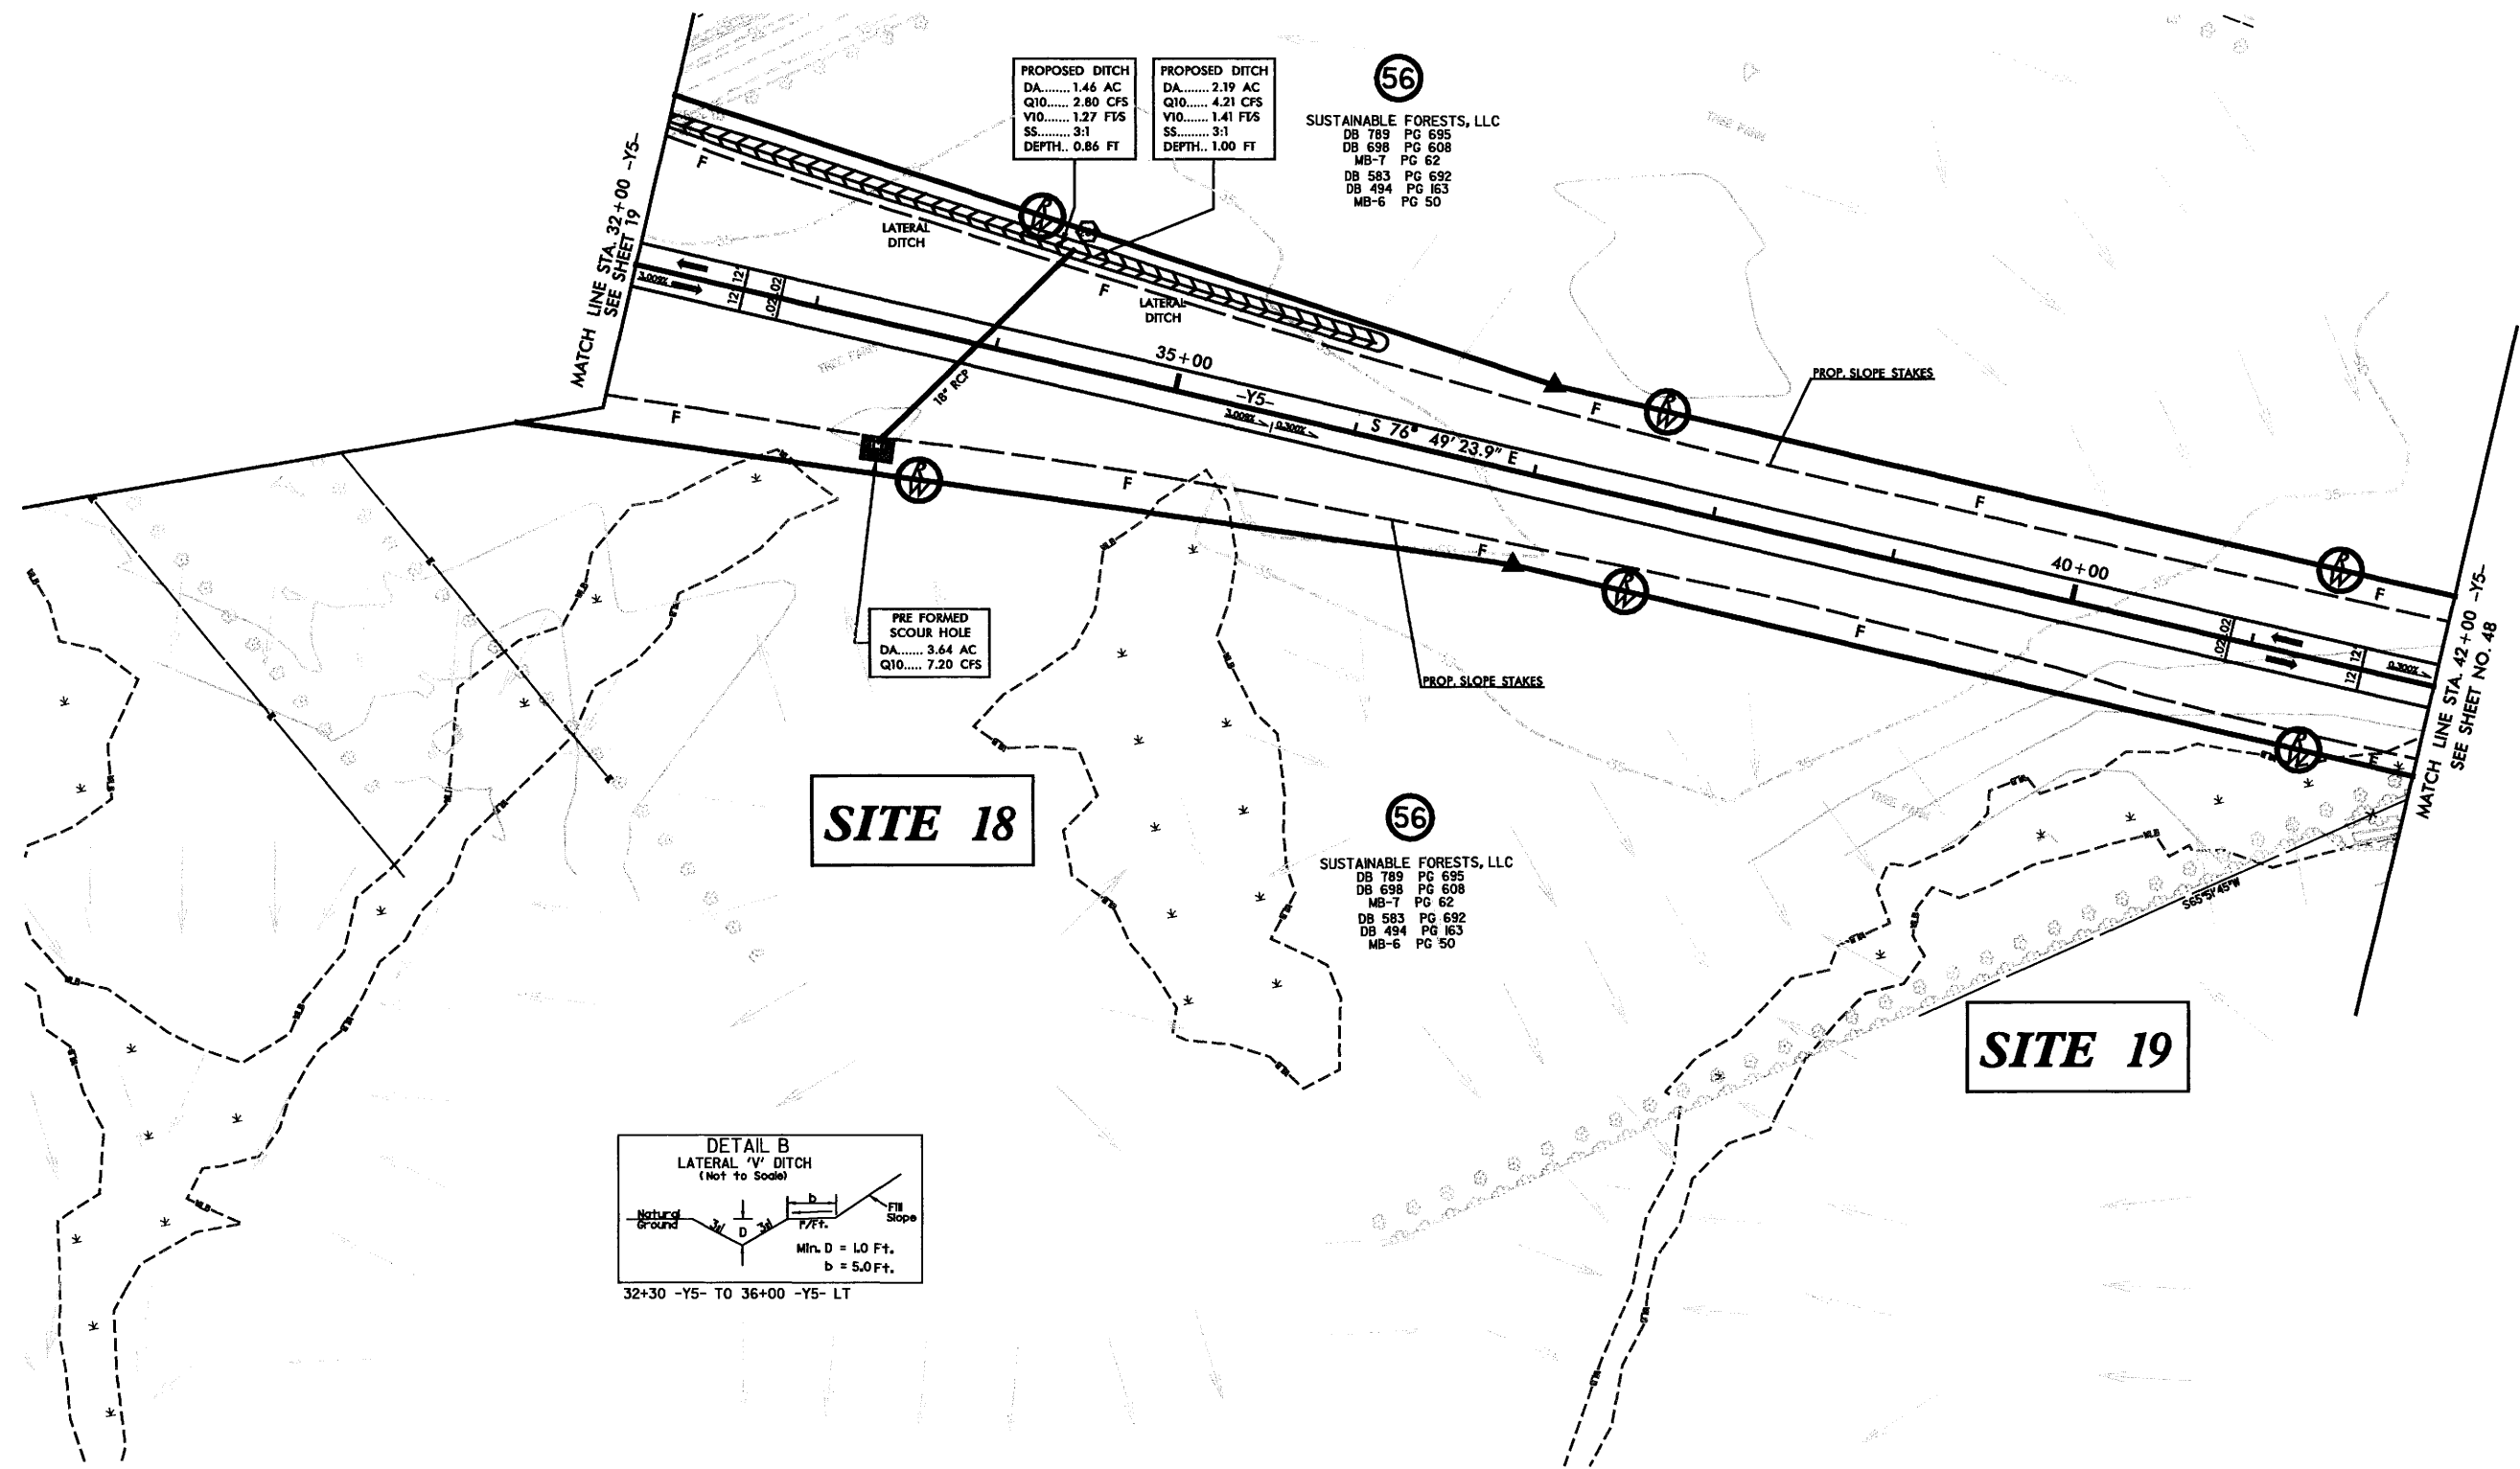

SITE 18


SITE 19

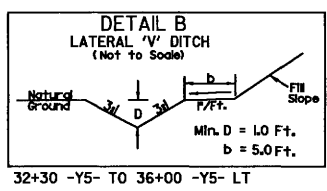

NOTES: SEE SHEET NO. 83 FOR -Y5- PROFILE.

8/1/2005
 C:\Users\jw\Documents\2404A\2404A.dwg
 2404A.dwg

(56)
SUSTAINABLE FORESTS, LLC
DB 789 PG 695
DB 698 PG 608
MB-7 PG 62
DB 583 PG 692
DB 494 PG 163
MB-6 PG 50

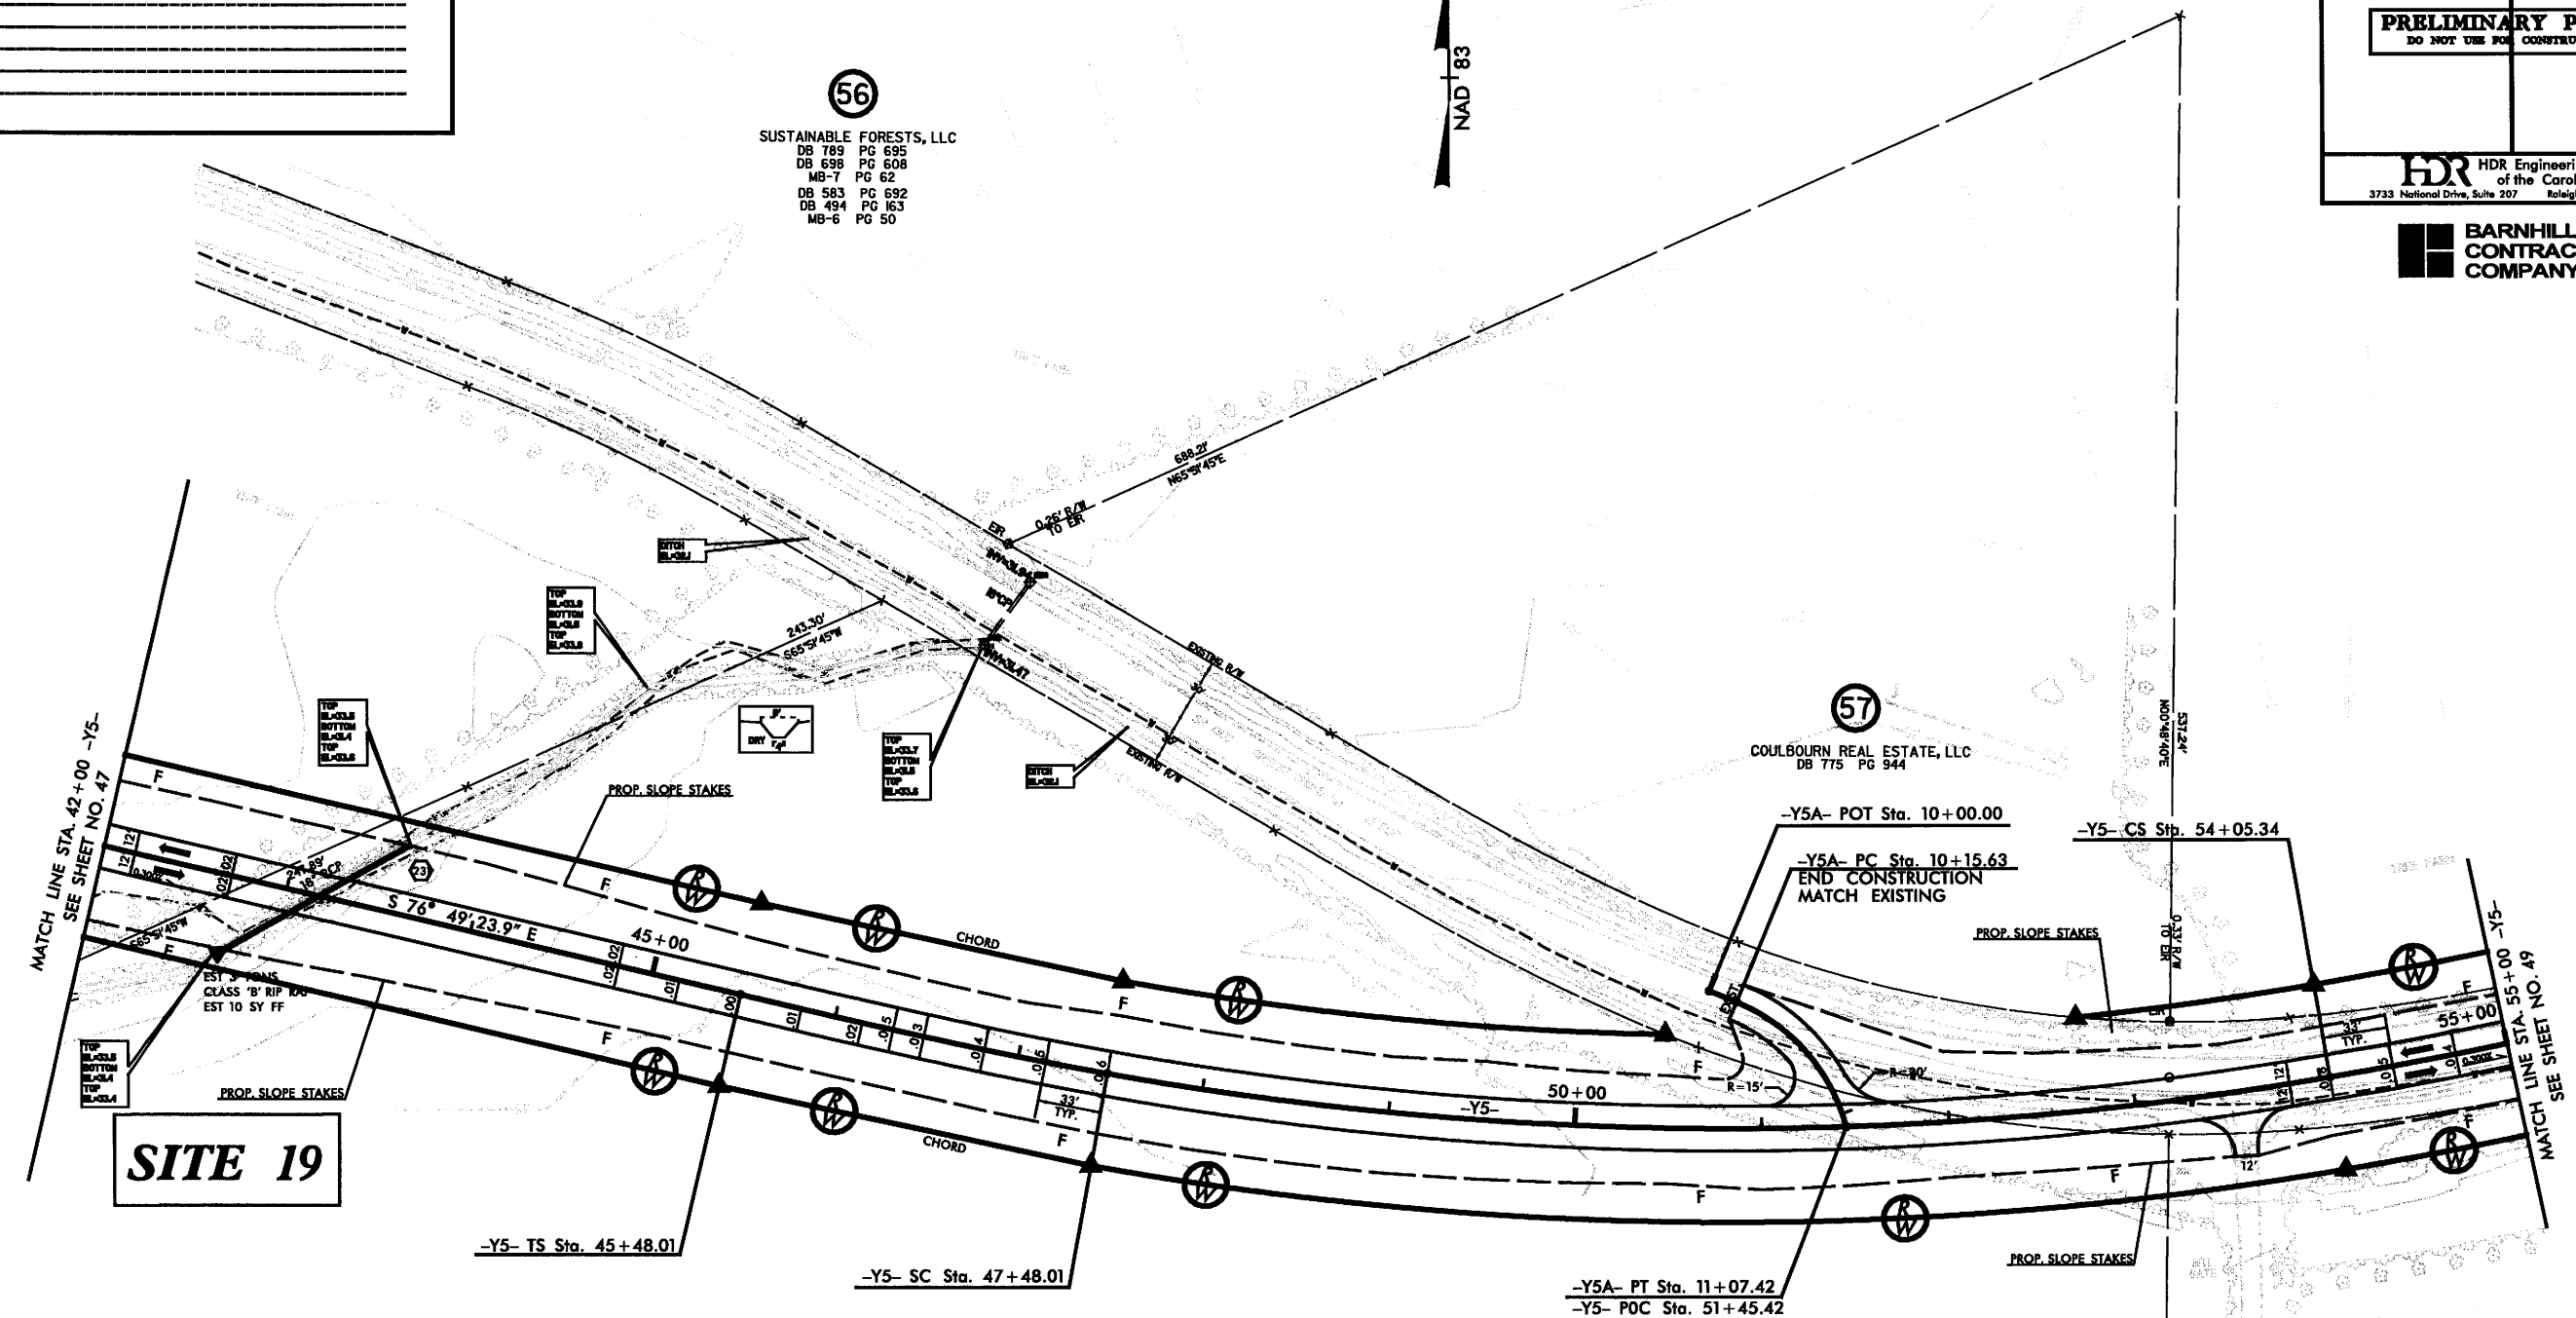

SITE 19

-Y5-

PI	=	50+84.29
Δ	=	25° 51' 12.2" (LT)
Dc	=	3° 00' 56.0"
Es	=	3° 00' 56.0"
Ls	=	200.00'
Ts	=	536.28'
Lc	=	657.33'
Rc	=	1,900.00'
LT	=	133.35'
ST	=	66.68'
e	=	0.06
DS	=	55 mph

-Y5A-



PI	=	10+65.05
Δ	=	52° 35' 28.9" (RT)
Dc	=	57° 17' 44.8"
L	=	91.79'
T	=	49.41'
R	=	100.00'
e	=	NC


(57)
COULBOURN REAL ESTATE, LLC
DB 775 PG 944

8/1/2005 10:53:43 AM \\sdc\hwy\p\2404a\hwy\res\msh-48.dwg

NOTES: SEE SHEET NO. 83 FOR -Y5- PROFILE.
ALL DRIVEWAY RADII ARE 20'
UNLESS OTHERWISE NOTED.

REVISIONS

PROJECT REFERENCE NO. R-2404A	SHEET NO. 49
RW SHEET NO.	
ROADWAY DESIGN	HYDRAULICS ENGINEER
PRELIMINARY PLANS DO NOT USE FOR CONSTRUCTION	
 HDR Engineering, Inc. of the Carolinas 3733 National Drive, Suite 207 Raleigh, N.C. 27612	
 BARNHILL CONTRACTING COMPANY	

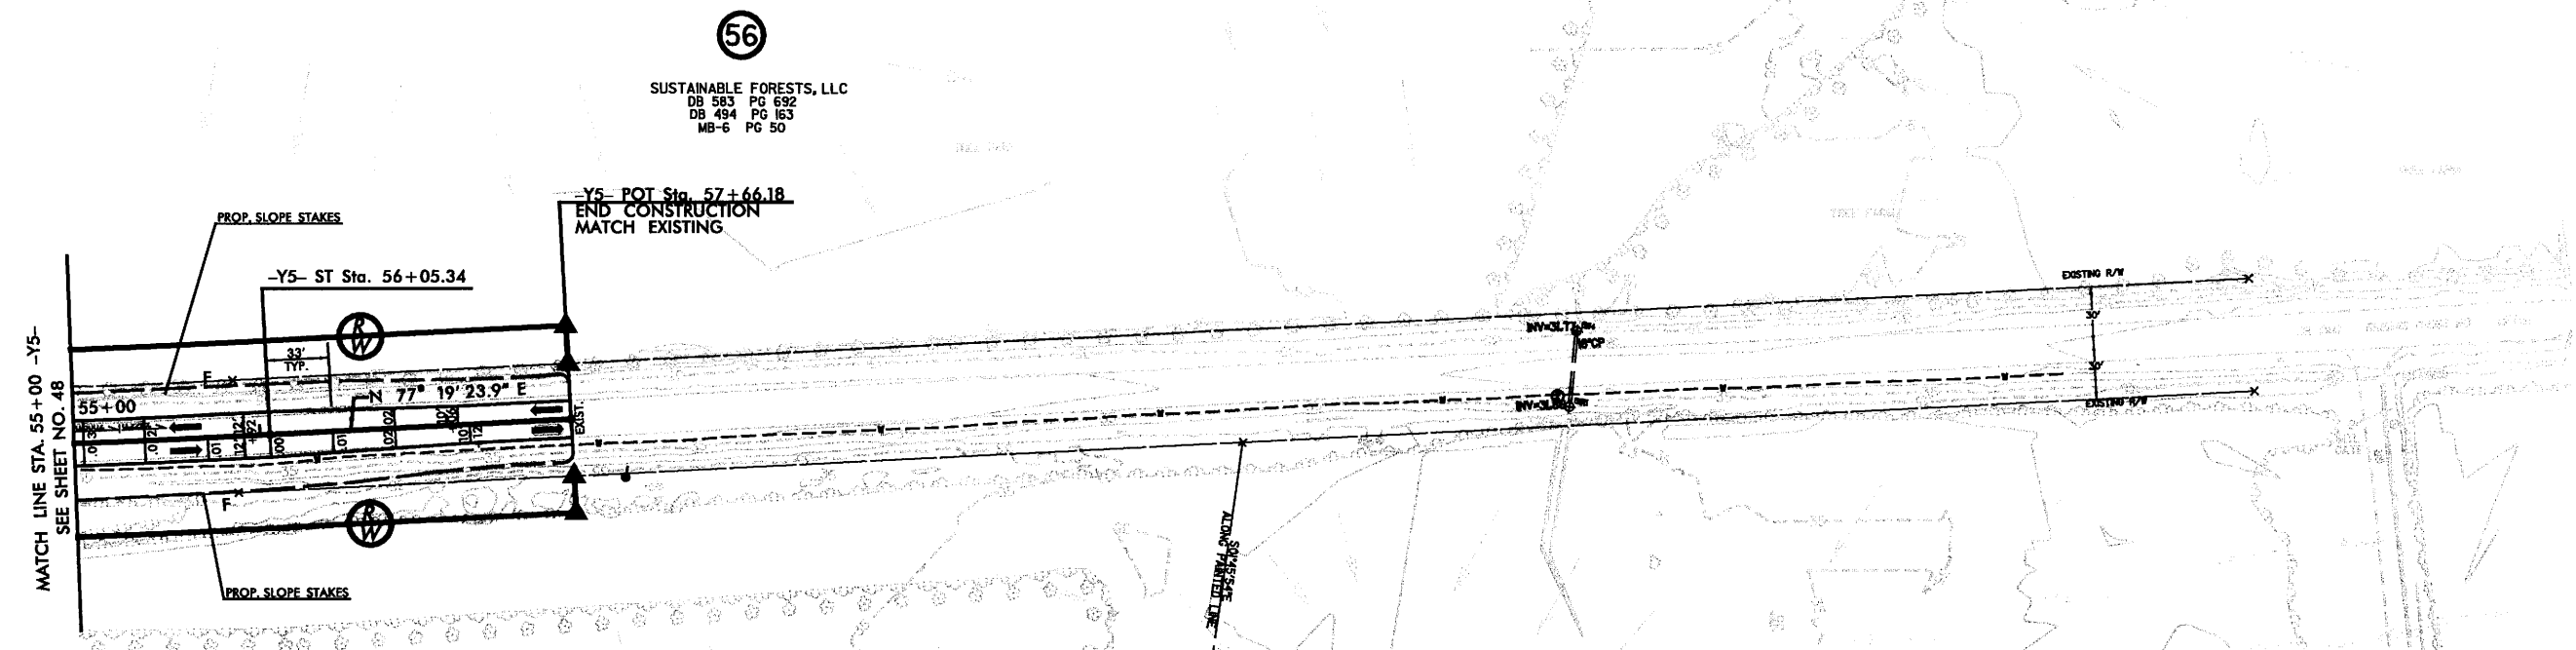

-Y5-

PI	=	50+84.29
Δ	=	25° 51' 12.2" (LT)
Dc	=	3° 00' 56.0"
Sc	=	3° 00' 56.0"
Ls	=	200.00'
Ts	=	536.28'
Lc	=	657.33'
Rc	=	1,900.00'
LT	=	133.35'
ST	=	66.68'
e	=	0.06
DS	=	55 mph



(56)


SUSTAINABLE FORESTS, LLC
DB 583 PG 692
DB 494 PG 163
MB-6 PG 50

8/7/2005 10:55:36 AM \\s01\work\2404\2404a\2404a_rwd\2404a_rwd.dwg 49.dwg

NOTES: SEE SHEET NO. 83 FOR -Y5- PROFILE.

REVISIONS

PROJECT REFERENCE NO. R-2404A	SHEET NO. 50
RW SHEET NO.	REVISIONS
ROADWAY DESIGN	HYDRAULICS ENGINEER
PRELIMINARY PLANS DO NOT USE FOR CONSTRUCTION	
 HDR Engineering, Inc. of the Carolinas 3733 National Drive, Suite 207 Raleigh, N.C. 27612	
 BARNHILL CONTRACTING COMPANY	

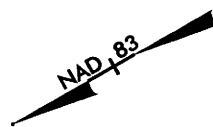

-Y6-POT Sta. 10+00.00

PROPOSED DITCH
DA..... 1.40 AC
Q10..... 3.43 CFS
V10..... 0.96 FFS
SS..... 3:1
DEPTH.. 1.09 FT

-Y6-
PI = 16+02.24
 Δ = 2° 08' 26.1" (RT)
Dc = 0° 14' 56.8"
L = 859.29'
T = 429.70'
R = 23,000.00'
e = 0.025
DS = 55 mph

-Y6-POC Sta. 16+00.00
BEGIN CONSTRUCTION
MATCH EXISTING

PROPOSED DITCH
DA..... 0.50 AC
Q10..... 1.23 CFS
V10..... 0.71 FFS
SS..... 3:1
DEPTH.. 0.76 FT


-Y6-PC Sta. 11+72.54

-Y6-PT Sta. 20+31.83

(56)
SUSTAINABLE FORESTS, LLC
DB 583 PG 251
DB 494 PG 163
MB 26 PG 01

(56)
SUSTAINABLE FORESTS, LLC
DB 583 PG 251
DB 494 PG 163
MB 02 PG 01

SITE 14

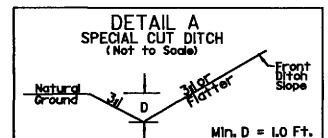

10+50 -Y6DET- TO 14+00 -Y6DET- LT
10+00 -Y6DET- TO 12+00 -Y6DET- RT

MATCH LINE STA. 20+50 -Y6- SEE SHEET NO. 28

8/7/2005 9:42:49 AM 240404A.dwg 2404A.dwg Resilience web_50.dwg

NOTES: SEE SHEET NO. 84 FOR -Y6- PROFILE.

REVISIONS

PROJECT REFERENCE NO. R-2404A	SHEET NO. 51
R/W SHEET NO.	REVISIONS
ROADWAY DESIGN	HYDRAULICS ENGINEER
PRELIMINARY PLANS DO NOT USE FOR CONSTRUCTION	

HDR HDR Engineering, Inc.
of the Carolinas
3733 National Drive, Suite 207 Raleigh, N.C. 27612

BARNHILL CONTRACTING COMPANY

MICHAEL R. COBB
DB 783 PG 615
DB 783 PG 613

JR&P ENTERPRISES, INC.
DB 717 PG 953

SHELBY D. LILLEY
DB 689 PG 323

(58)
ARC, INC.
DB 666 PG 419

GREEN'S CROSS BAPTIST CHURCH
DB 665 PG 293

MARIAN M. CRISCO
DB 603 PG 98
PB 90-E PG -60


DAISY M. WHITE
DB 73-E PG -14
PB 473 PG 134

INTERNATIONAL PAPER CO.
DB 546 PG 667
DB 780 PG 956
PC B PG 352

STATE OF NORTH CAROLINA
DB 525 PG 572


(56)
SUSTAINABLE FORESTS, LLC
DB 583 PG 251
DB 494 PG 163
MB 02 PG 01

- Y6-**
- PI = 43+37.96
 - Δ = 0° 09' 33.2" (LT)
 - Dc = 0° 17' 11.3"
 - L = 55.58'
 - T = 27.79'
 - R = 20,000.00'
 - e = 0.025
 - DS = 55 mph

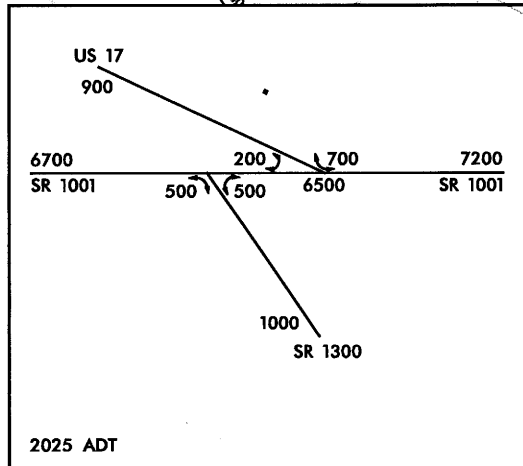



NOTES: SEE SHEET NO. 85 FOR -Y6- PROFILE.

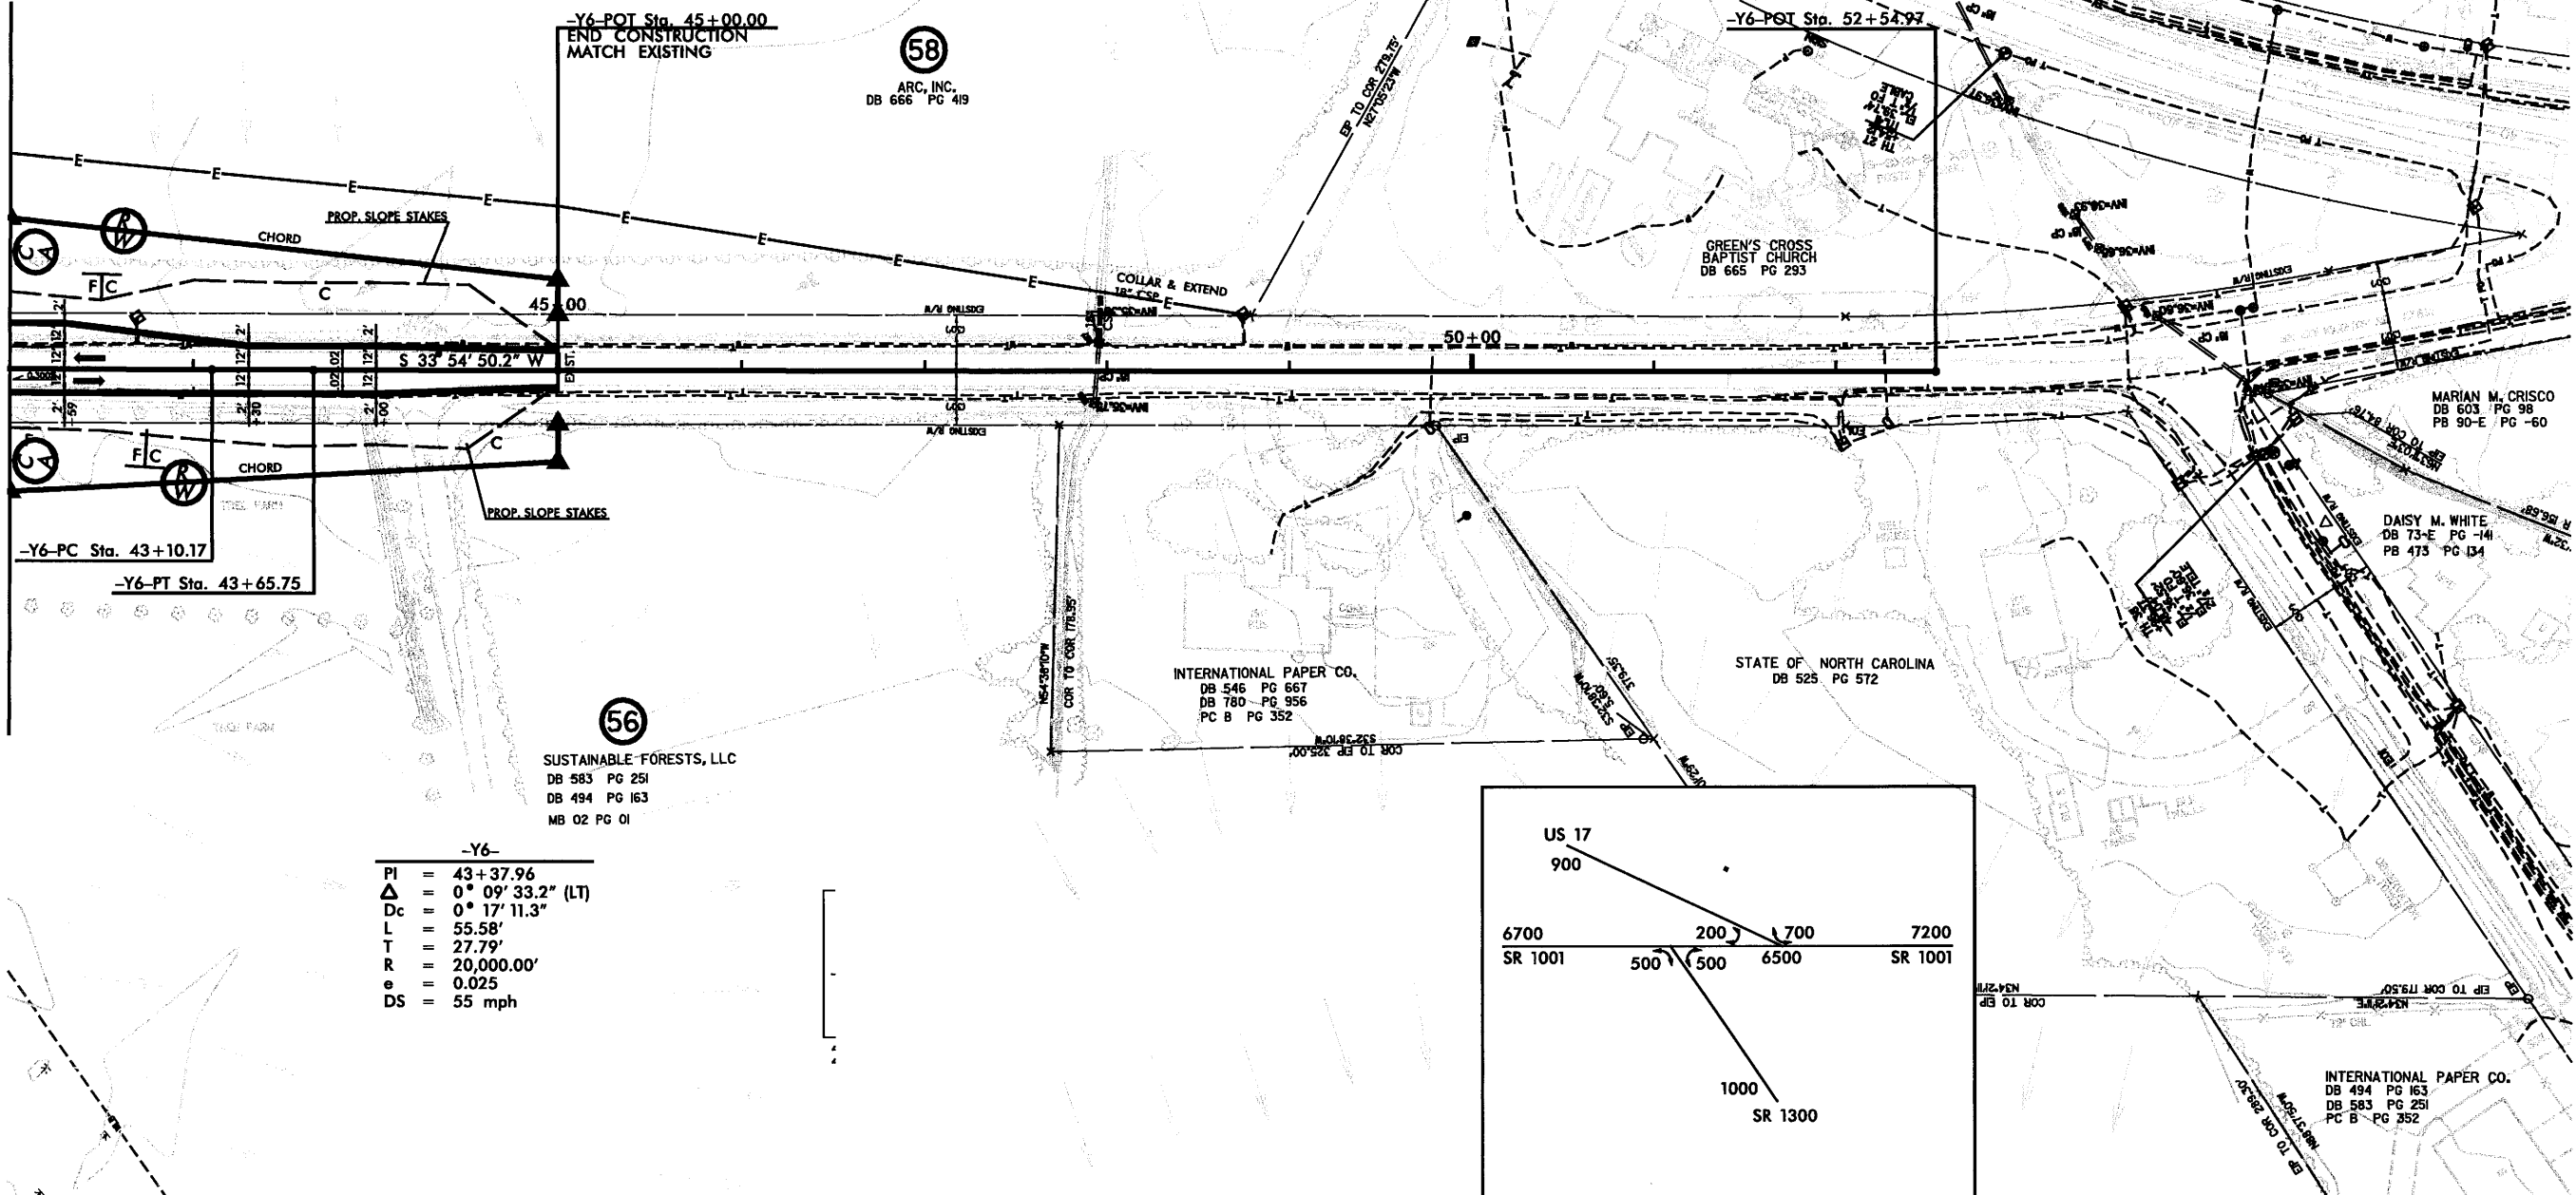MATCH LINE STA. 42+00 -Y6-
SEE SHEET NO. 28






2/2/2015 10:54:25 AM 105425 11/11/2015 10:54:25 AM 105425 11/11/2015 10:54:25 AM 105425 11/11/2015 10:54:25 AM

REVISIONS

PROJECT REFERENCE NO. R-2404A	SHEET NO. 52
RW SHEET NO.	
ROADWAY DESIGN	HYDRAULICS ENGINEER
PRELIMINARY PLANS DO NOT USE FOR CONSTRUCTION	
 HDR Engineering, Inc. of the Carolinas 3733 National Drive, Suite 207 Raleigh, N.C. 27612	
 BARNHILL CONTRACTING COMPANY	

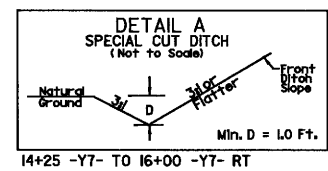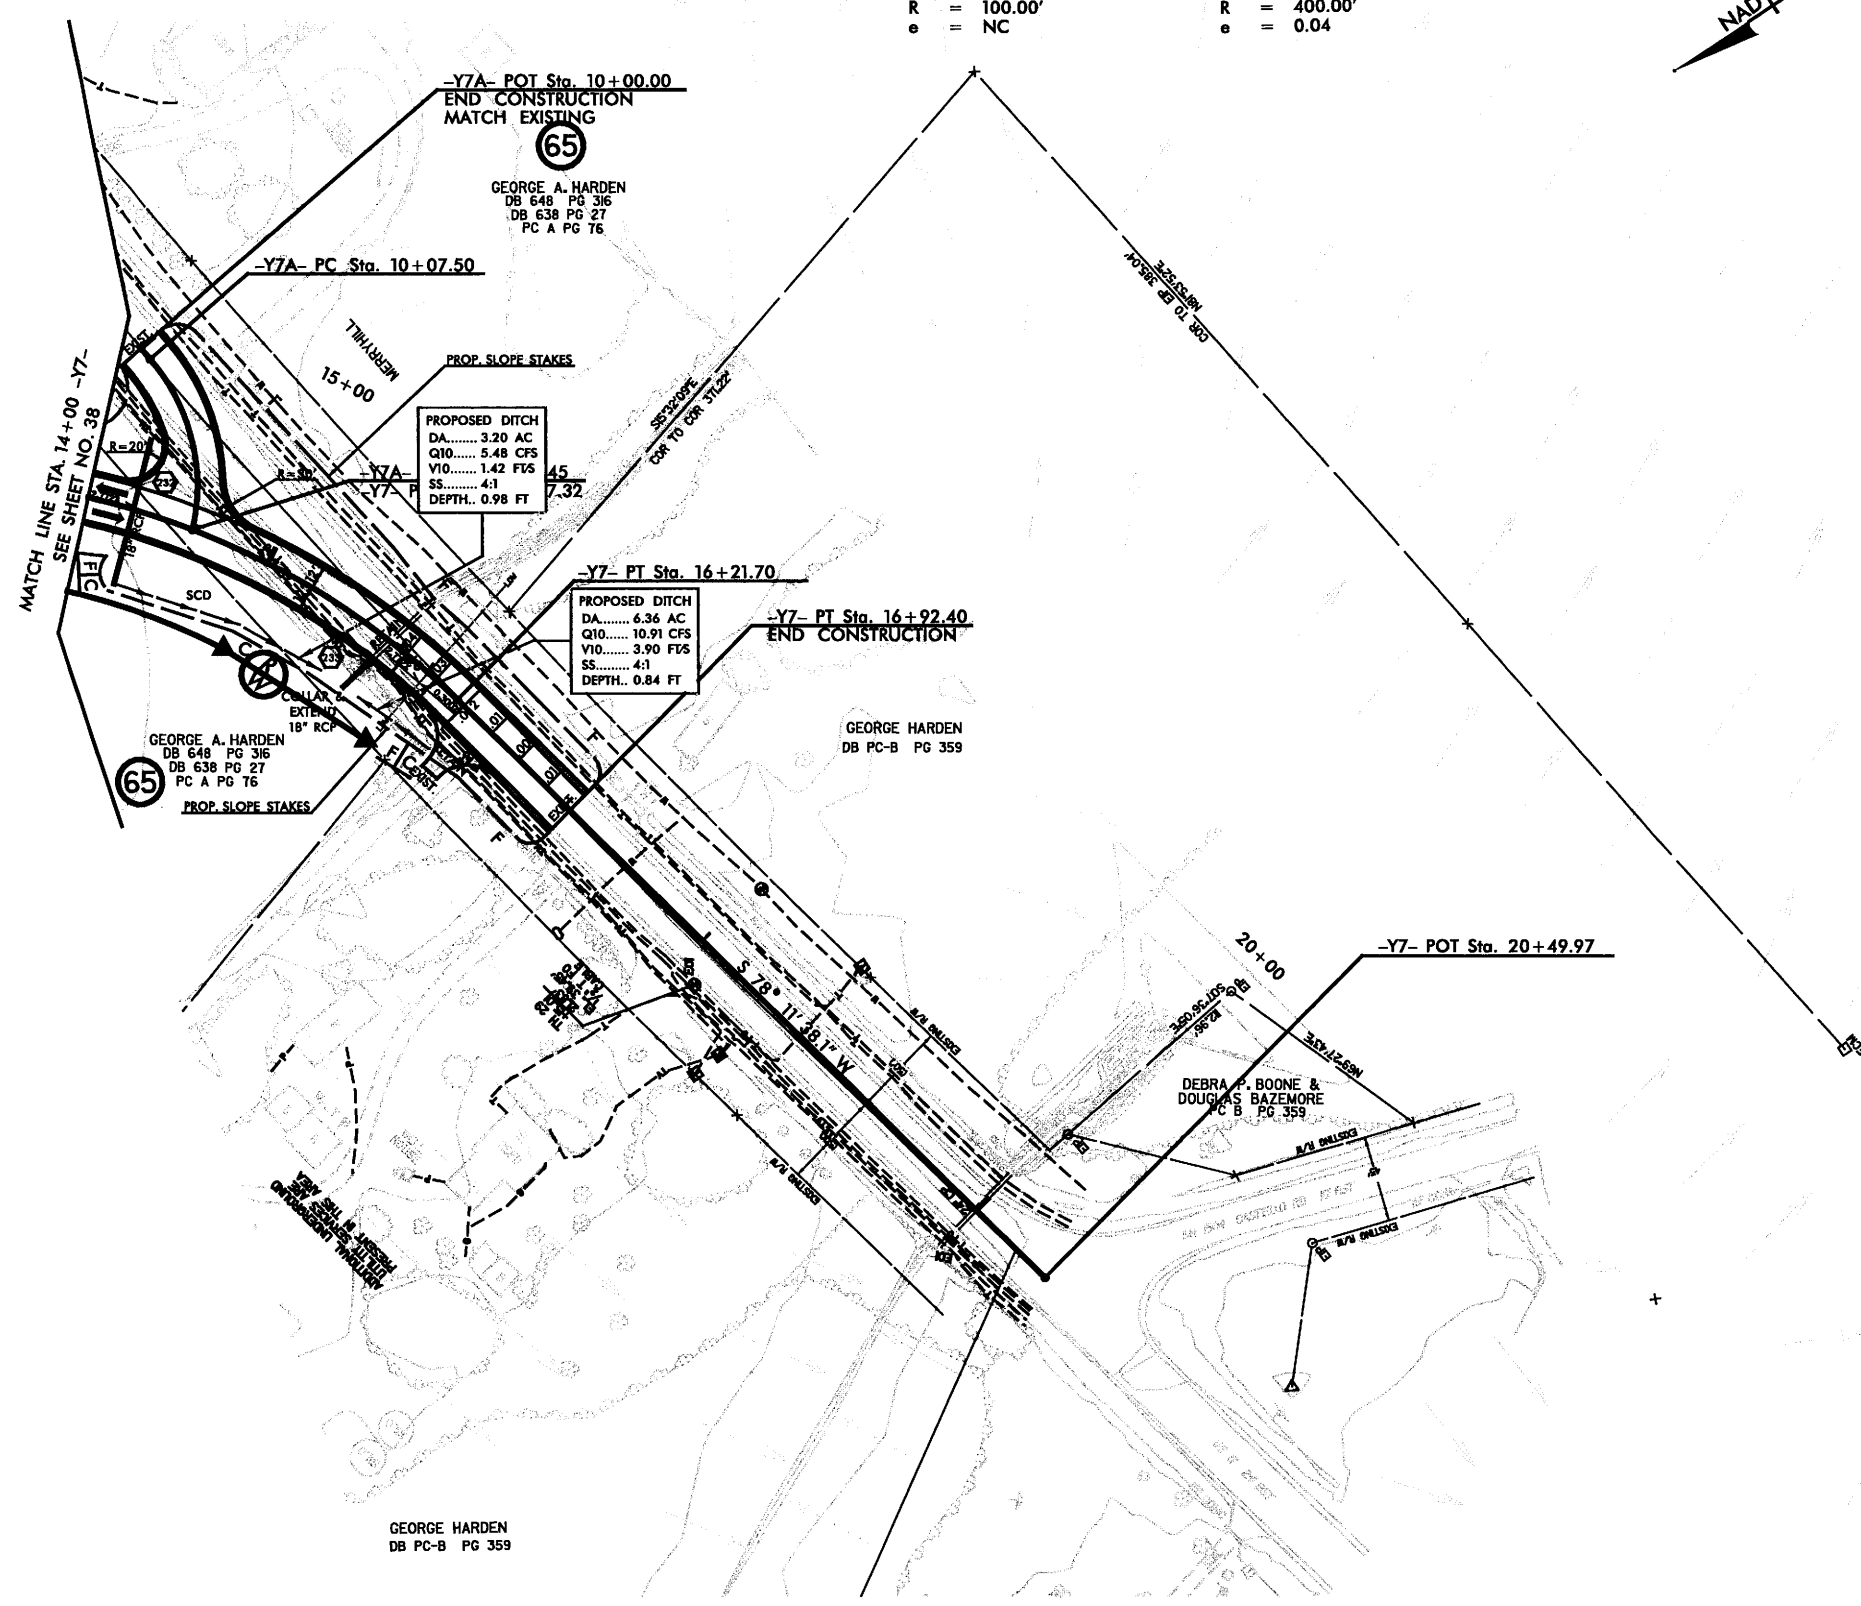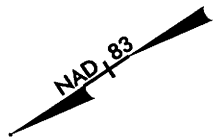

<p>-Y7A-</p> <p>PI = 10+58.89 Δ = 54° 24' 16.1" (RT) Dc = 57° 17' 44.8" L = 94.95' T = 51.40' R = 100.00' e = NC</p>	<p>-Y7-</p> <p>PI = 14+41.82 Δ = 56° 38' 47.4" (RT) Dc = 14° 19' 26.2" L = 395.47' T = 215.59' R = 400.00' e = 0.04</p>
---	--



NOTES: SEE SHEET NO. 90 FOR -Y7- PROFILE.
 ALL DRIVEWAY RADII ARE 20'
 UNLESS OTHERWISE NOTED.

8/1/2005 10:54:47 AM
 2404510033122041.rvt:R:\dms\pjh_05.dwg

REVISIONS

PROJECT REFERENCE NO. R-2404A	SHEET NO. Y5DET-1
RW SHEET NO.	
ROADWAY DESIGN	HYDRAULICS ENGINEER
PRELIMINARY PLANS DO NOT USE FOR CONSTRUCTION	
 HDR Engineering, Inc. of the Carolinas 3733 National Drive, Suite 207 Raleigh, N.C. 27612	
 BARNHILL CONTRACTING COMPANY	

-Y5DET-


PI	=	11+41.27
D	=	22° 35' 42.2" (LT)
Dc	=	8° 06' 08.2"
L	=	278.87'
T	=	141.27'
R	=	707.16'
e	=	0.08
DS	=	55 mph

-Y5-

PI	=	15+42.54
Δ	=	28° 43' 39.1" (RT)
Dc	=	5° 54' 24.4"
Os	=	5° 54' 24.4"
Ls	=	200.00'
Ts	=	348.80'
Lc	=	286.35'
Rc	=	970.00'
LT	=	133.41'
ST	=	66.73'
e	=	0.08
DS	=	55 mph

-Y5DET-



PI	=	18+49.27
D	=	23° 37' 35.6" (RT)
Dc	=	5° 54' 24.4"
L	=	399.99'
T	=	202.88'
R	=	970.00'
e	=	0.08
DS	=	55 mph

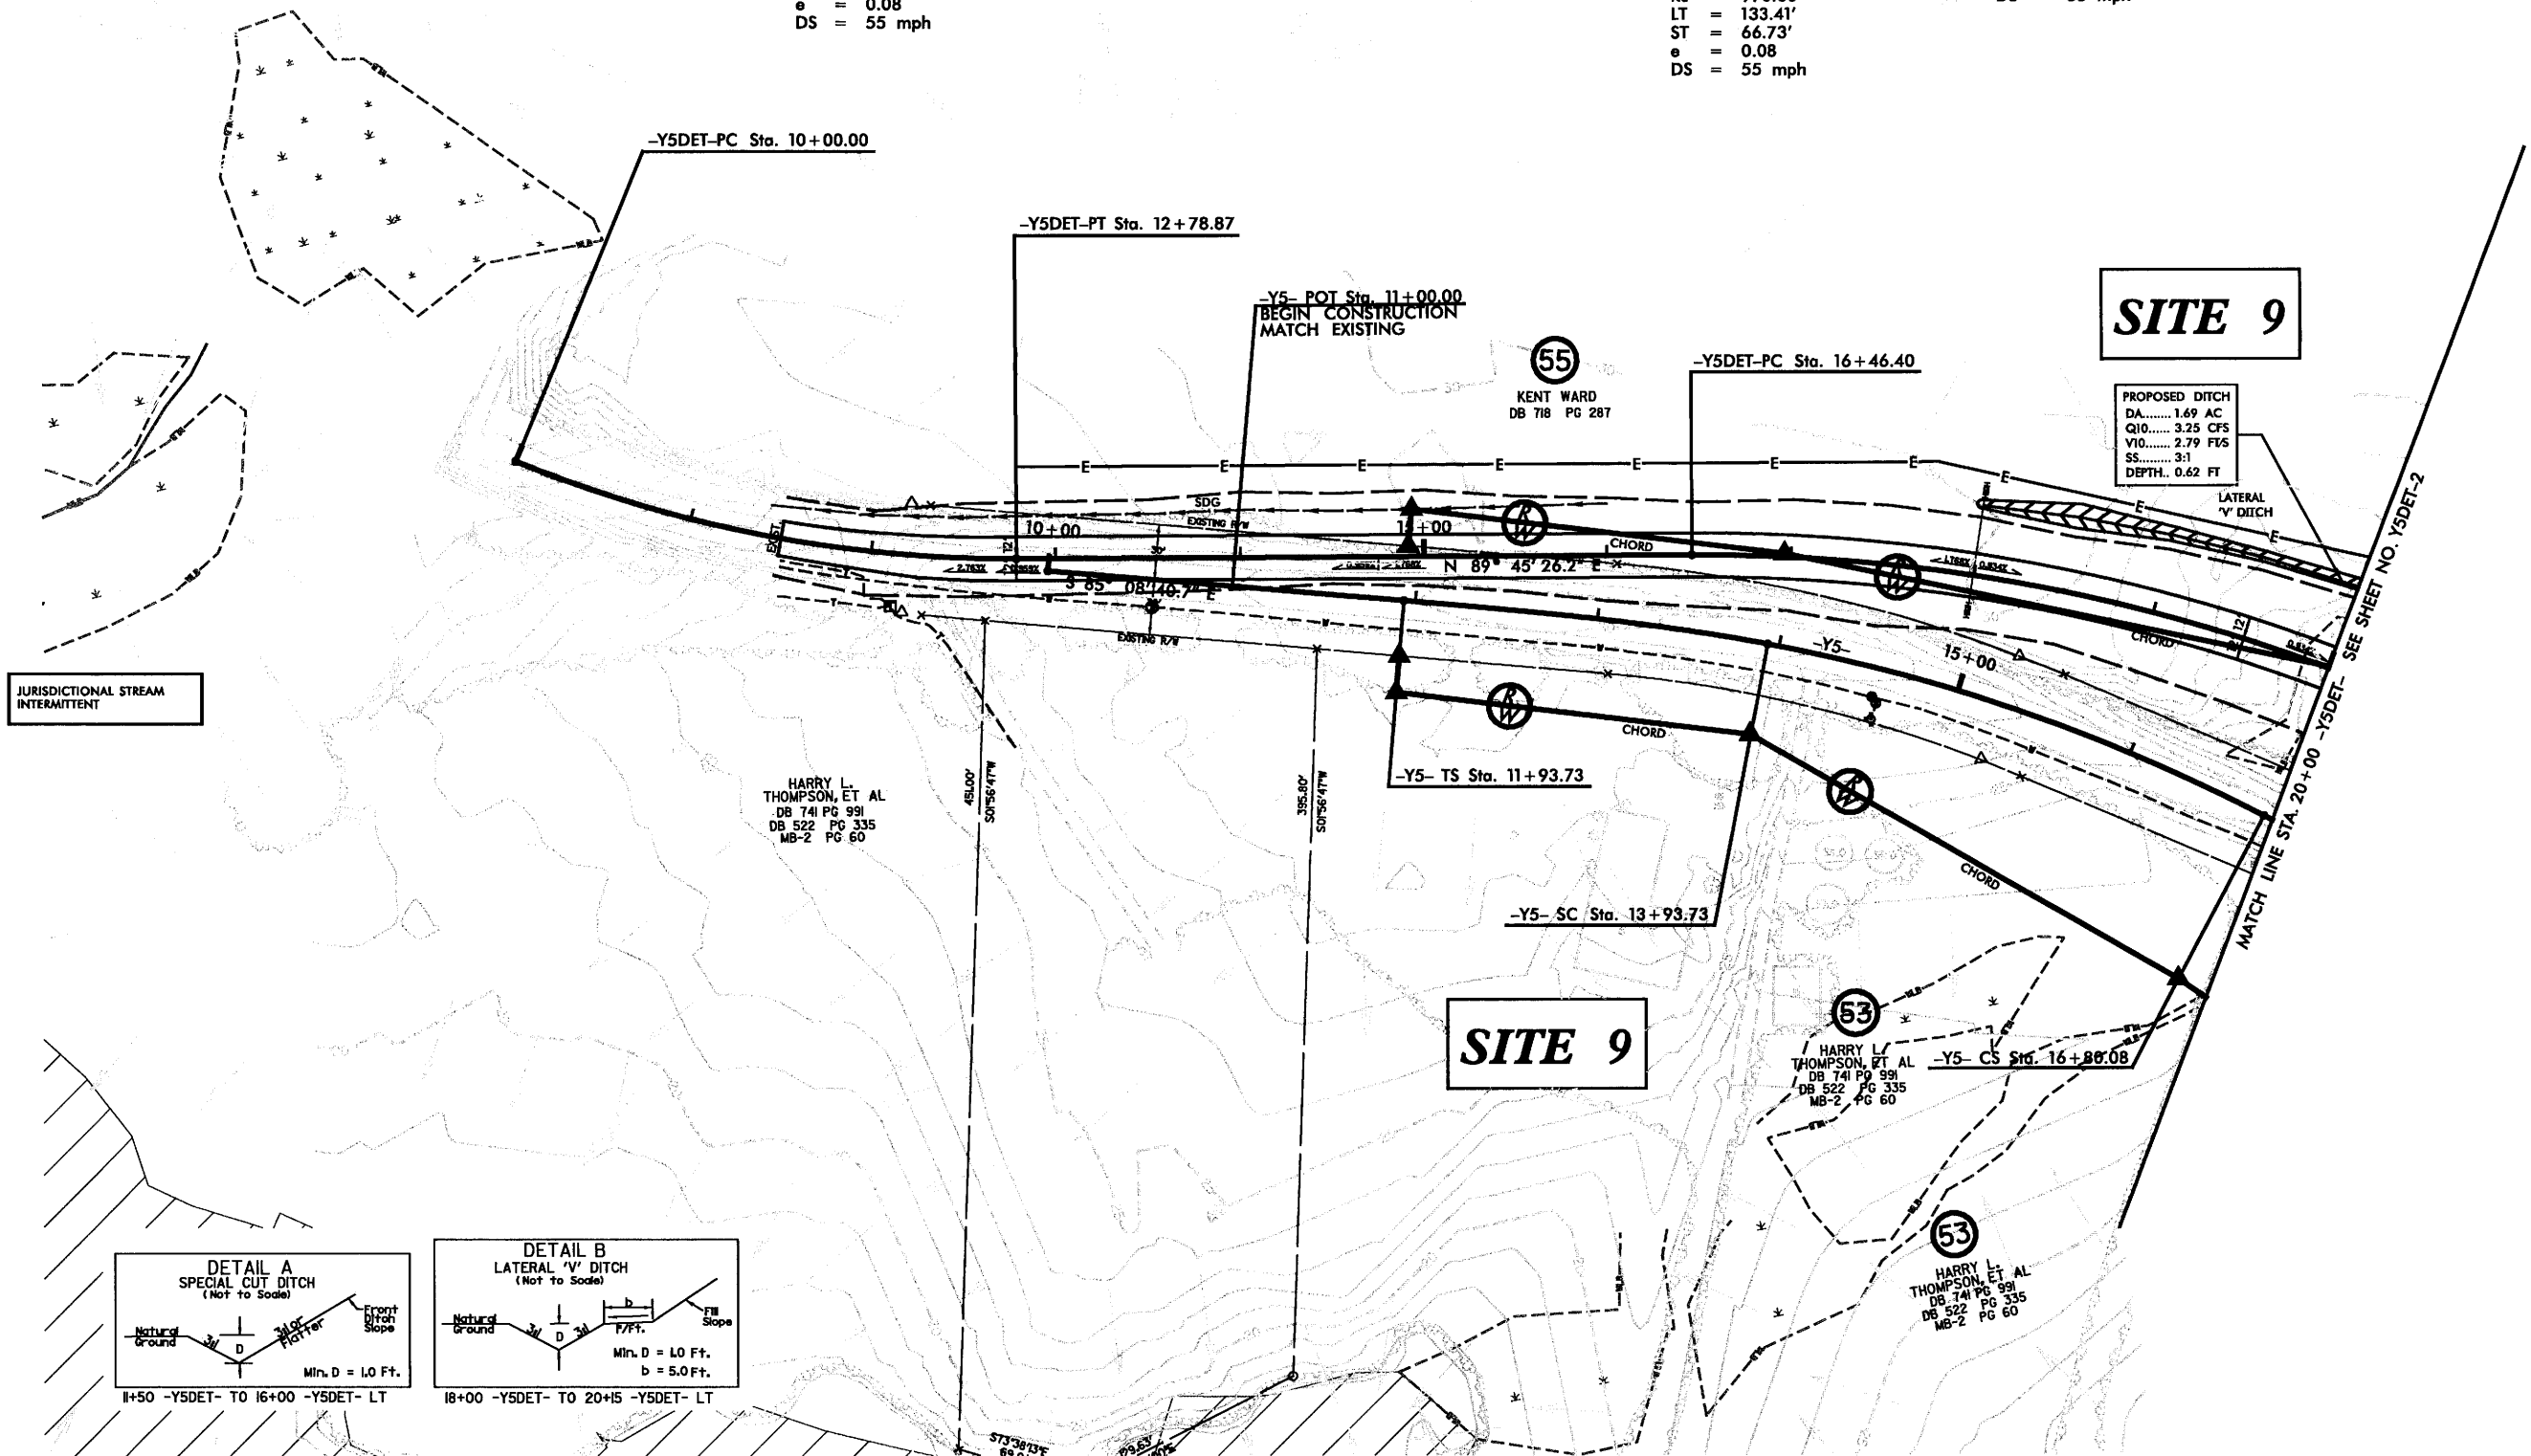

SITE 9

SITE 9

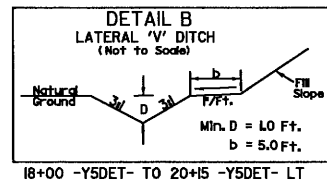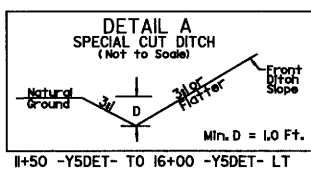

PROPOSED DITCH
 DA..... 1.69 AC
 Q10..... 3.25 CFS
 V10..... 2.79 FVS
 SS..... 3:1
 DEPTH. 0.62 FT






JURISDICTIONAL STREAM
INTERMITTENT

MATCH LINE STA. 20+00 -Y5DET- SEE SHEET NO. Y5DET-2

REVISIONS


PROJECT REFERENCE NO. R-2404A	SHEET NO. Y5DET-2
RW SHEET NO.	
ROADWAY DESIGN	HYDRAULICS ENGINEER
PRELIMINARY PLANS DO NOT USE FOR CONSTRUCTION	
 HDR Engineering, Inc. of the Carolinas 3733 National Drive, Suite 207 Raleigh, N.C. 27612	
 BARNHILL CONTRACTING COMPANY	

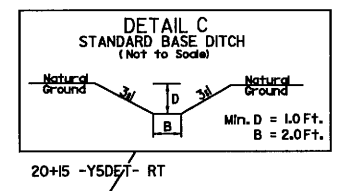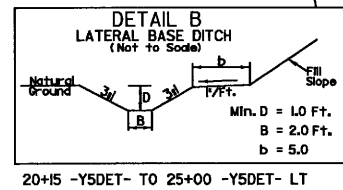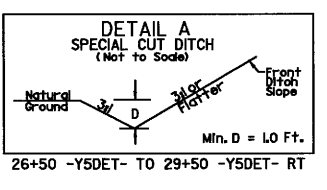

PROPOSED DITCH
DA..... 33.35 AC
Q10..... 6.31 CFS
V10..... 1.11 FFS
SS..... 3:1
DEPTH.. 1.08 FT

- Y5-**
- PI = 15+42.54
 - Δ = 28° 43' 39.1" (RT)
 - Dc = 5° 54' 24.4"
 - ⊙ = 5° 54' 24.4"
 - Ls = 200.00'
 - Ts = 348.80'
 - Lc = 286.35'
 - Rc = 970.00'
 - LT = 133.41'
 - ST = 66.73'
 - e = 0.08
 - DS = 55 mph

- Y5DET-**
- PI = 27+05.18
 - D = 22° 32' 53.2" (LT)
 - Dc = 5° 54' 24.4"
 - L = 381.73'
 - T = 193.37'
 - R = 970.00'
 - e = 0.08
 - DS = 55 mph

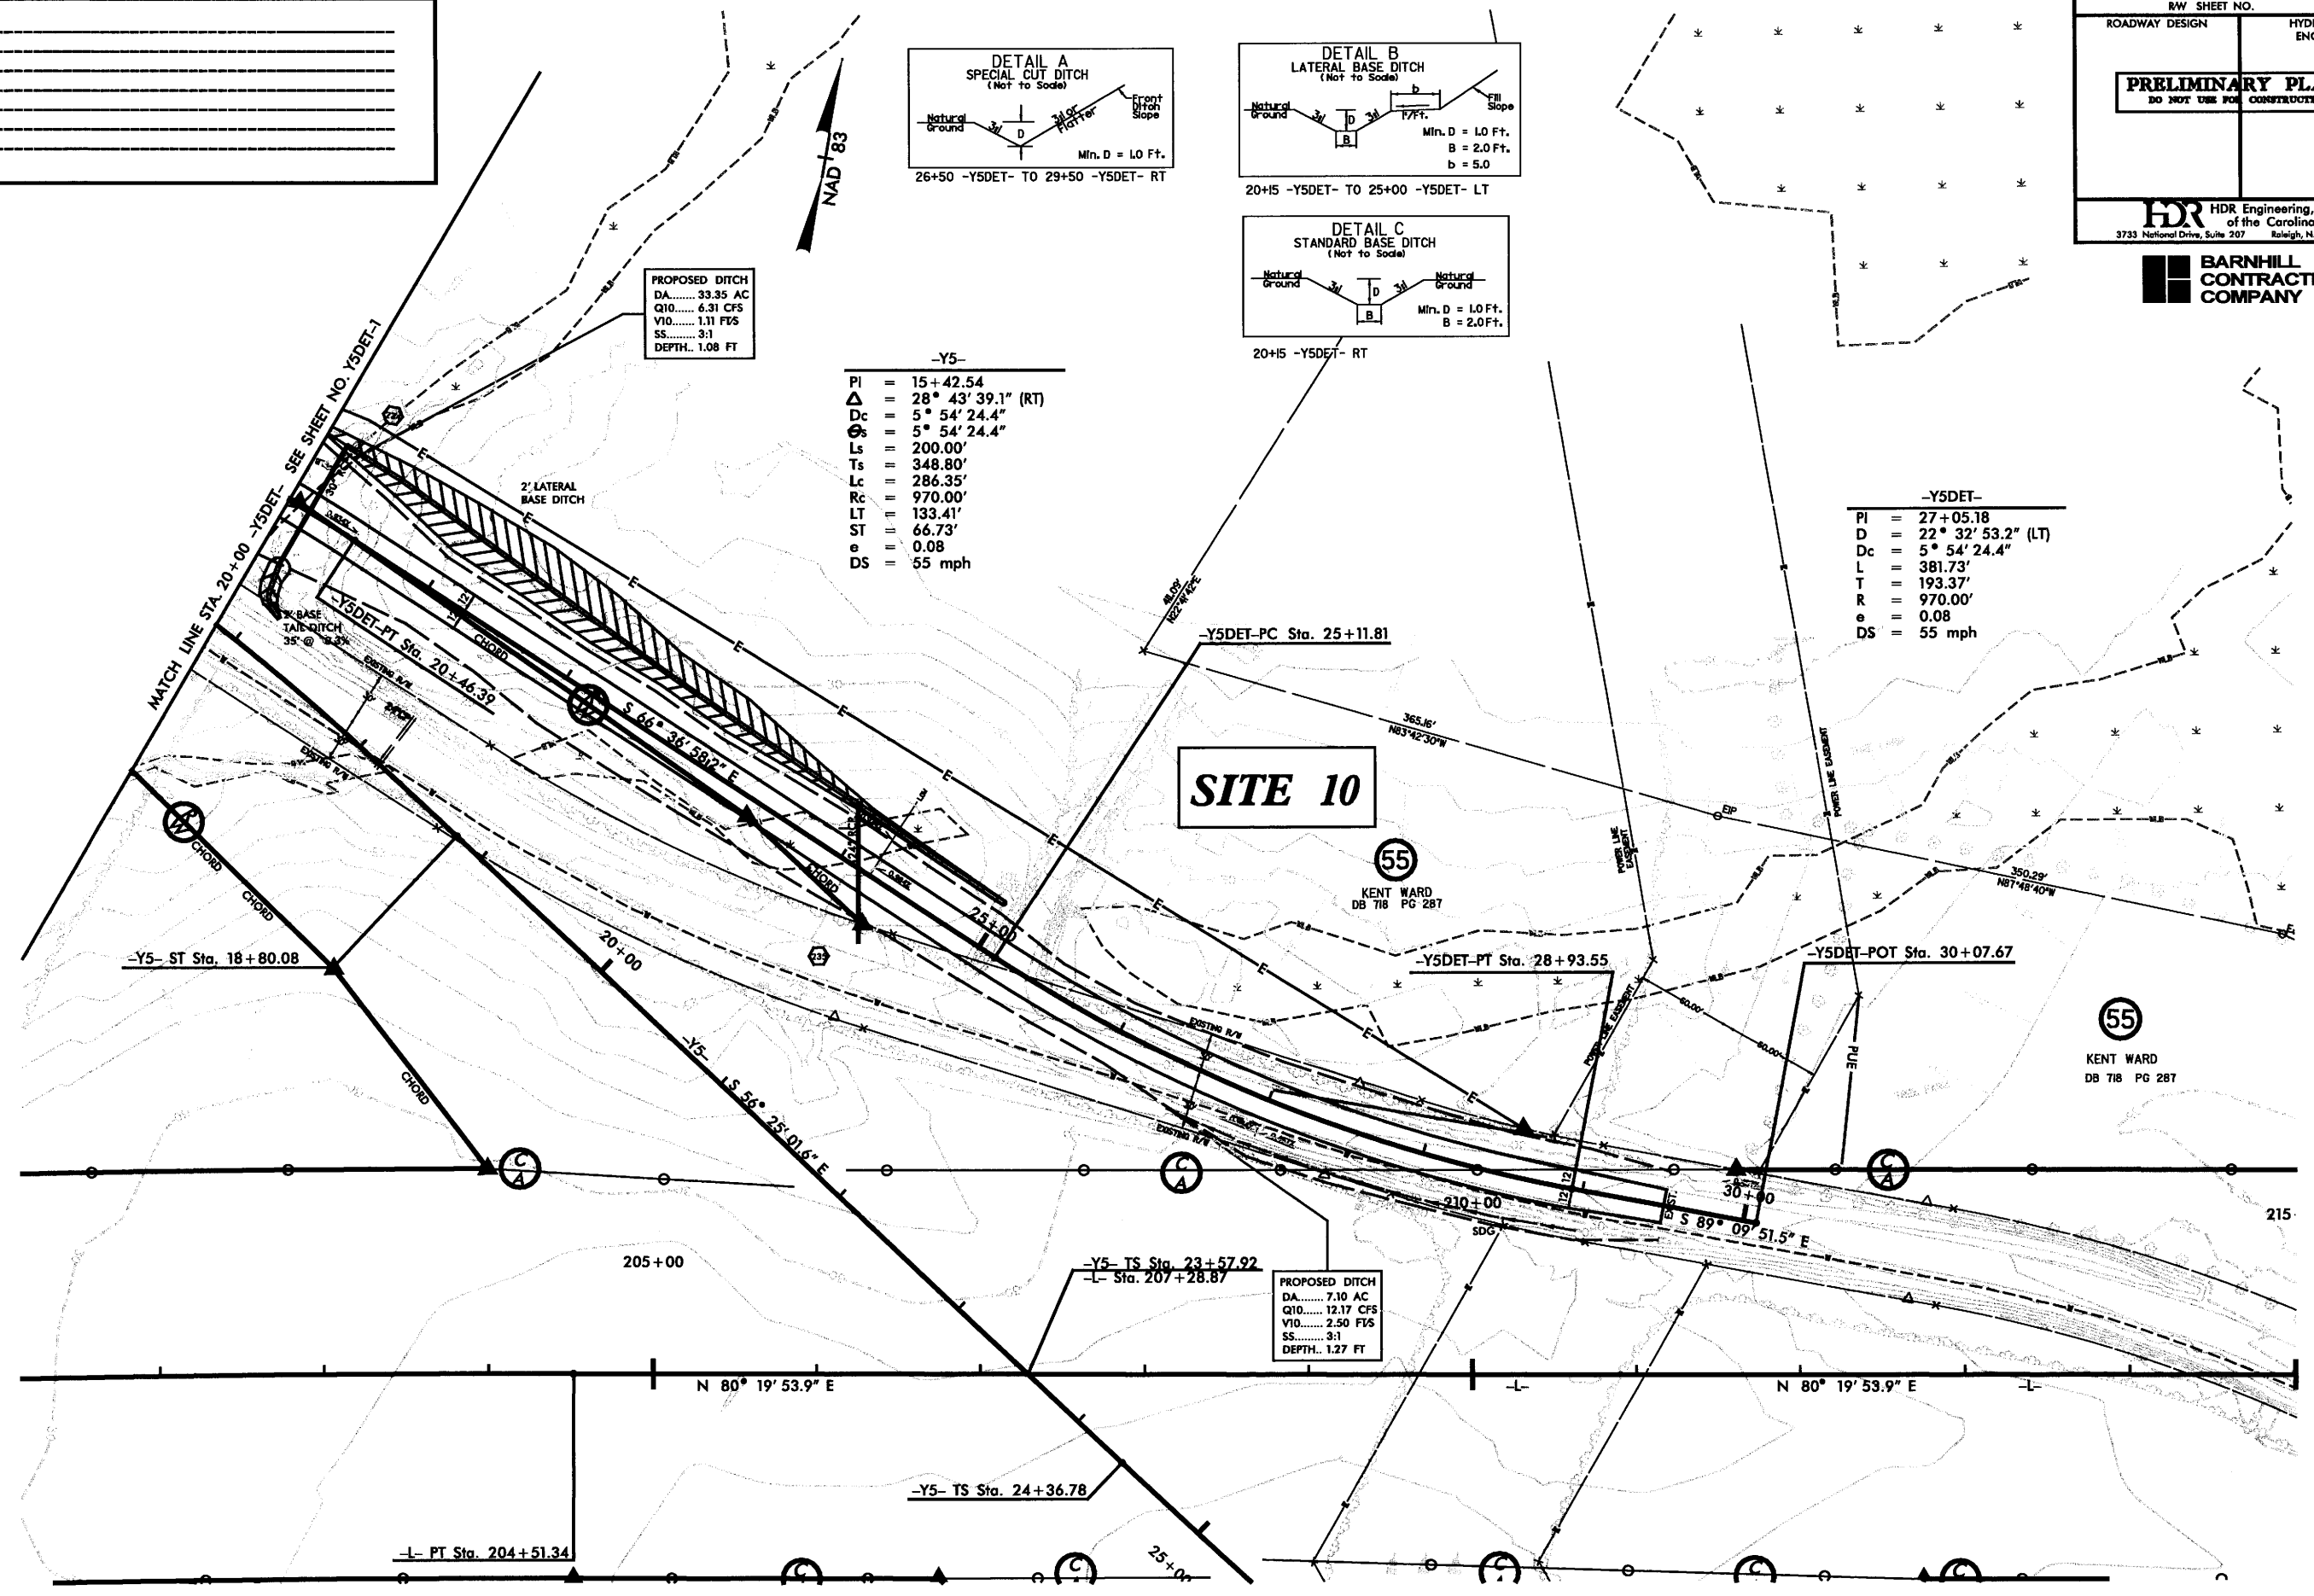

SITE 10

55
KENT WARD
DB 718 PG 287

55
KENT WARD
DB 718 PG 287

N 80° 19' 53.9" E

N 80° 19' 53.9" E

-L- PT Sta. 204+51.34

-Y5- TS Sta. 24+36.78

-Y5- TS Sta. 23+57.92
-L- Sta. 207+28.87

PROPOSED DITCH
DA..... 7.10 AC
Q10..... 12.17 CFS
V10..... 2.50 FFS
SS..... 3:1
DEPTH.. 1.27 FT

-Y5- ST Sta. 18+80.08



-Y5DET-PC Sta. 25+11.81


-Y5DET-PT Sta. 28+93.55

-Y5DET-POT Sta. 30+07.67

215

REVISIONS

PROJECT REFERENCE NO. R-2404A	SHEET NO. Y6DET-1
RW SHEET NO.	
ROADWAY DESIGN	HYDRAULICS ENGINEER
PRELIMINARY PLANS DO NOT USE FOR CONSTRUCTION	
 HDR Engineering, Inc. of the Carolinas 3723 National Drive, Suite 207 Raleigh, N.C. 27612	
 BARNHILL CONTRACTING COMPANY	

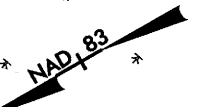

-Y6LPD-

Pls Sta 1+32.92	PI Sta 4+90.14	Pls Sta 6+97.49
Fs = 0°34' 10.9"	D = 98°30' 03.5" (LT)	Fs = 22°55' 05.9"
Fs = 22°55' 27.3"	D = 22°55' 05.9"	Ls = 200.00'
Ls = 200.00'	L = 429.79'	LT = 134.47'
LT = 132.92'	T = 290.14'	ST = 67.70'
ST = 69.41'	R = 260.00'	
	e = 0.08	
	DS = 30 mph	

-Y6DET-

PI = 17+40.04
Δ = 3° 28' 33.5" (RT)
Dc = 1° 25' 56.6"
L = 240.34'
T = 120.21'
R = 4,000.00'
e = 0.04
DS = 55 mph

-Y6DET-

PI = 12+51.45
Δ = 7° 11' 38.8" (LT)
Dc = 1° 25' 56.6"
L = 502.24'
T = 251.45'
R = 4,000.00'
e = 0.04
DS = 55 mph

-Y6-

PI = 16+02.24
Δ = 2° 08' 26.1" (RT)
Dc = 0° 14' 56.8"
L = 859.29'
T = 429.70'
R = 23,000.00'
e = 0.025
DS = 55 mph

-Y6-POT Sta. 10+00.00
-Y6DET-PC Sta. 10+00.00


PROPOSED DITCH
DA.....1.40 AC
Q10.....3.43 CFS
V10.....0.96 FVS
SS.....3:1
DEPTH..1.09 FT

PROPOSED DITCH
DA.....0.50 AC
Q10.....1.23 CFS
V10.....0.71 FVS
SS.....3:1
DEPTH..0.76 FT

(56)
SUSTAINABLE FORESTS, LLC
DB 583 PG 251
DB 494 PG 163
MB 26 PG 01

(56)
SUSTAINABLE FORESTS, LLC
DB 583 PG 251
DB 494 PG 163
MB 02 PG 01

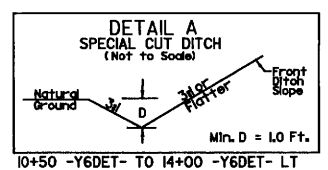

SITE 14



10+50 -Y6DET- TO 14+00 -Y6DET- LT

MATCHLINE STA. -Y6DET- 24+00.00
SEE SHEET Y6DET-2


REVISIONS

PROJECT REFERENCE NO. R-2404A	SHEET NO. Y6DET-2
RW SHEET NO.	
ROADWAY DESIGN	HYDRAULICS ENGINEER
PRELIMINARY PLANS DO NOT USE FOR CONSTRUCTION	
 HDR Engineering, Inc. of the Carolinas 3733 National Drive, Suite 207 Raleigh, N.C. 27612	
 BARNHILL CONTRACTING COMPANY	



-Y6DET-
 *PI = Sta 26+95.94
 $\Delta = 9^{\circ} 24' 03.0''$ (RT)
 Dc = $2^{\circ} 51' 53.2''$
 L = 328.15'
 T = 164.44'
 R = 2,000.00'
 e = 0.06
 DS = 55 mph

MATCHLINE STA. -Y6DET- 24+00.00
SEE SHEET Y6DET-1

MATCHLINE STA. -Y6DET- 37+00.00
SEE SHEET Y6DET-2

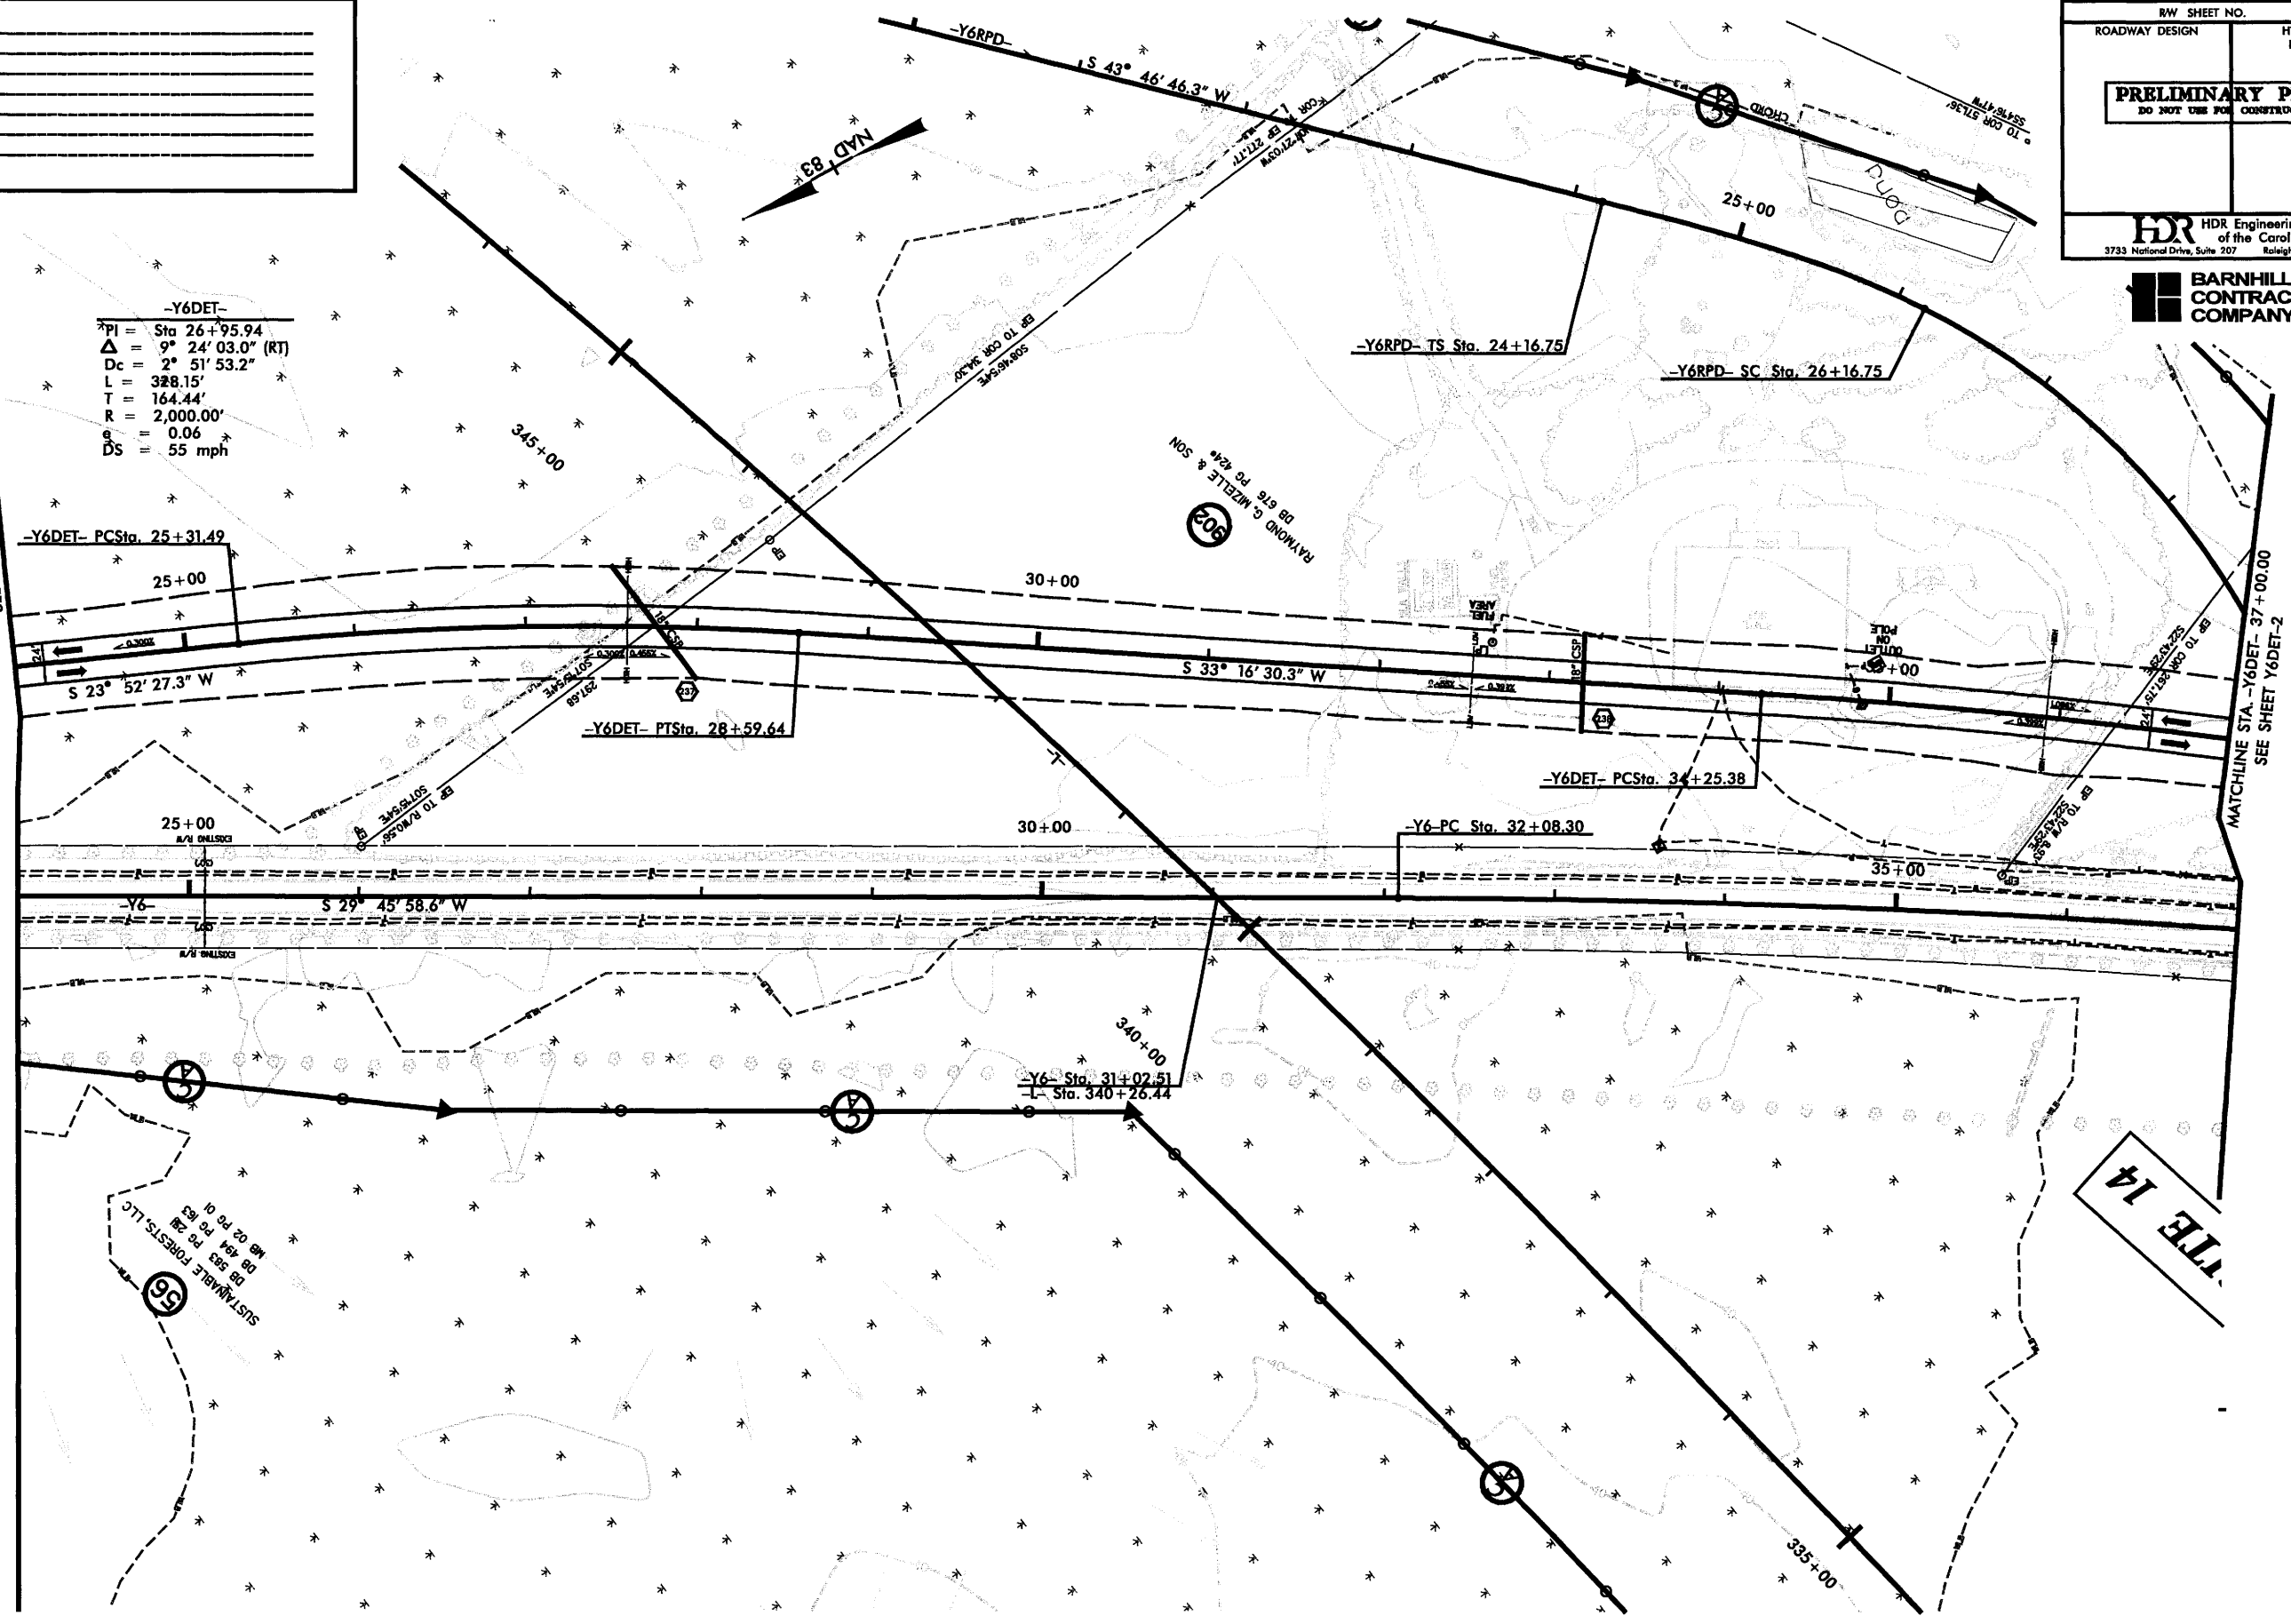

SHEET 14

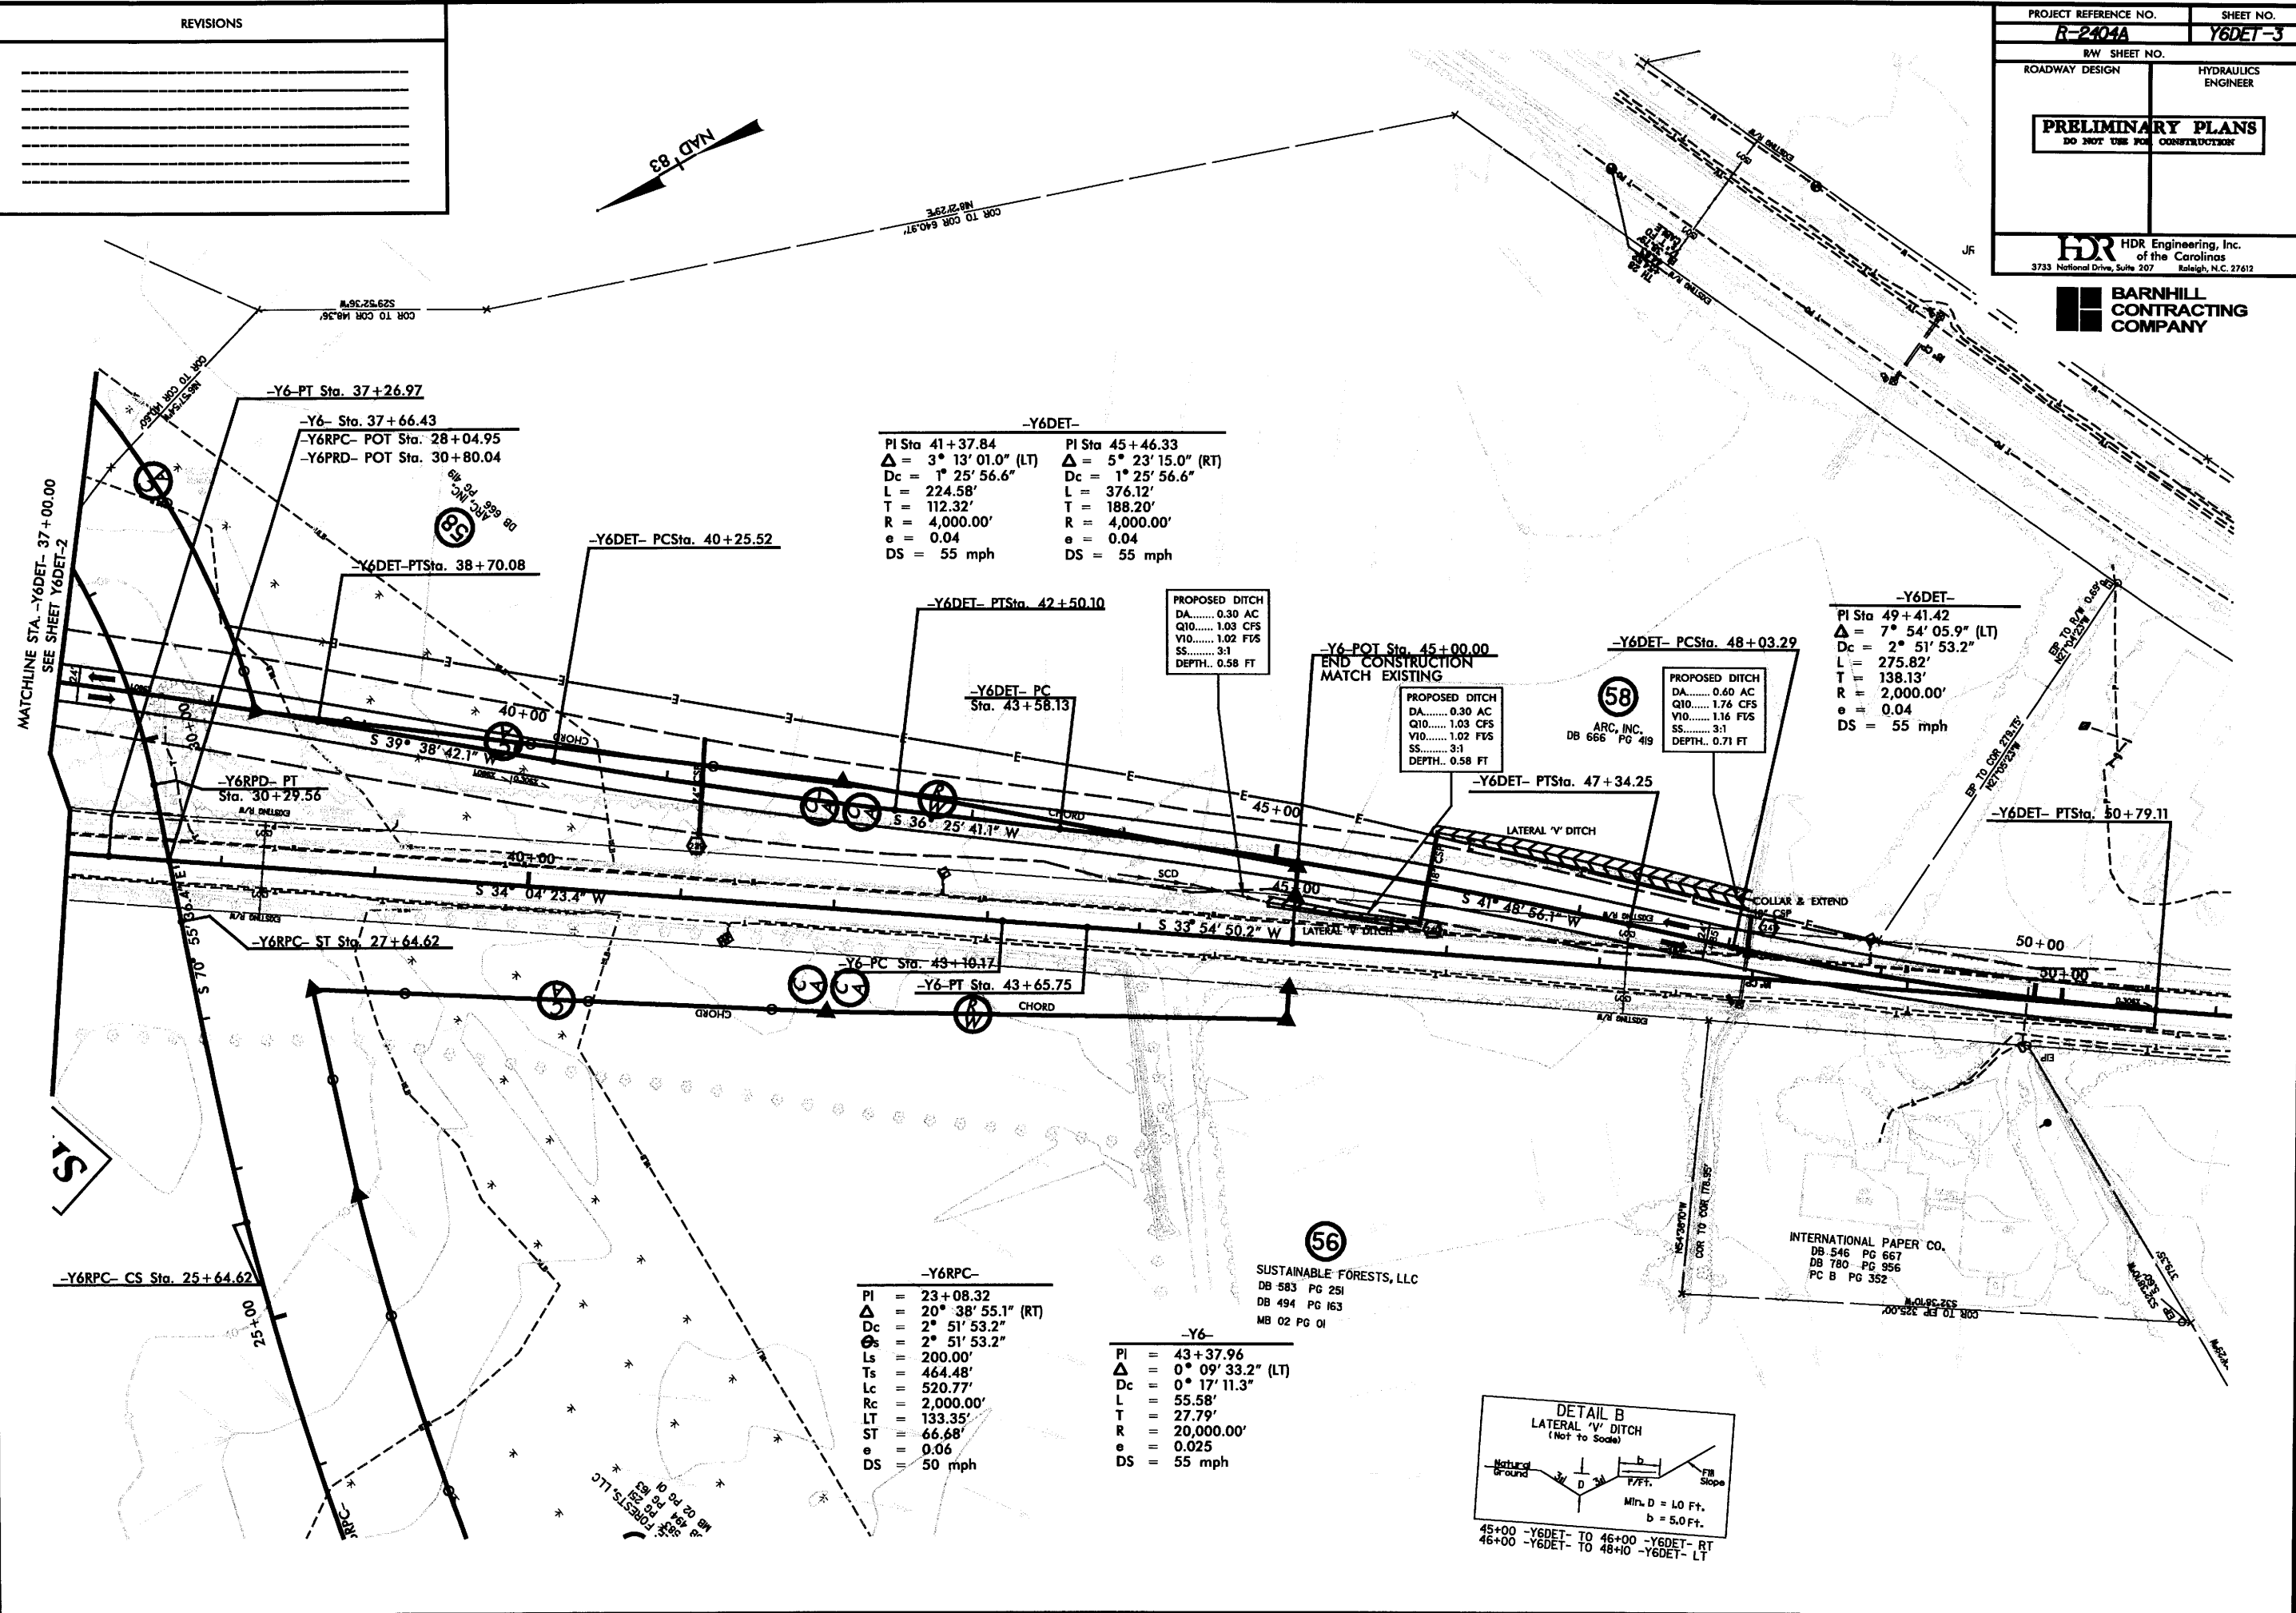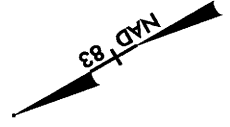

PROPOSED DITCH
DA.....0.30 AC
Q10.....1.03 CFS
V10.....1.02 FTS
SS.....3:1
DEPTH..0.58 FT

PROPOSED DITCH
DA.....0.30 AC
Q10.....1.03 CFS
V10.....1.02 FTS
SS.....3:1
DEPTH..0.58 FT


PROPOSED DITCH
DA.....0.60 AC
Q10.....1.76 CFS
V10.....1.16 FTS
SS.....3:1
DEPTH..0.71 FT

-Y6DET-
PI Sta 49+41.42
Δ = 7° 54' 05.9" (LT)
Dc = 2° 51' 53.2"
L = 275.82'
T = 138.13'
R = 2,000.00'
e = 0.04
DS = 55 mph

-Y6DET-
PI Sta 41+37.84 PI Sta 45+46.33
Δ = 3° 13' 01.0" (LT) Δ = 5° 23' 15.0" (RT)
Dc = 1° 25' 56.6" Dc = 1° 25' 56.6"
L = 224.58' L = 376.12'
T = 112.32' T = 188.20'
R = 4,000.00' R = 4,000.00'
e = 0.04 e = 0.04
DS = 55 mph DS = 55 mph

-Y6RPC-
PI = 23+08.32
Δ = 20° 38' 55.1" (RT)
Dc = 2° 51' 53.2"
Ls = 200.00'
Ts = 464.48'
Lc = 520.77'
Rc = 2,000.00'
LT = 133.35'
ST = 66.68'
e = 0.06
DS = 50 mph

-Y6-
PI = 43+37.96
Δ = 0° 09' 33.2" (LT)
Dc = 0° 17' 11.3"
L = 55.58'
T = 27.79'
R = 20,000.00'
e = 0.025
DS = 55 mph

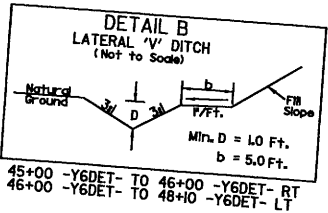

45+00 -Y6DET- TO 46+00 -Y6DET- RT
46+00 -Y6DET- TO 48+10 -Y6DET- LT