



STATE OF NORTH CAROLINA
DEPARTMENT OF TRANSPORTATION

MICHAEL F. EASLEY
GOVERNOR

LYNDO TIPPETT
SECRETARY

March 8, 2006

U.S. Army Corps of Engineers
Wilmington Regulatory Field Office
Post Office Box 1890
Wilmington, NC 28402-1890

Attention: Mr. Richard Spencer
NCDOT Coordinator, Division 8

Subject: **Additional Information for Section 404 Individual Permit and Section 401 Water Quality Certification** for US 421/NC 87 Bypass from East of SR 1521 to east of NC 42, Lee County; Federal Aid Project No. STP-NHF-421(2), WBS Element No. 34431.1.1, Division 8, **TIP No. R-2417AB**

Reference: - USACE Section 404 Individual Permit (Action ID No. 200220899) dated May 29, 2002

- NCDENR-DWQ Section 401 Water Quality Certification (DWQ Project No. 001432) dated April 10, 2002

The purpose of this letter is to provide the US Army Corps of Engineers (USACE) and the NC Division of Water Quality (DWQ) with additional information regarding the North Carolina Department of Transportation's (NCDOT) activities to address an on-going erosion problem at the inlet side of Permit Site 10 (Station 18+62 SR4 LT / Station 33+50 Y). The erosion is occurring at the 36-inch (900 mm) CSP outlet pipe, located approximately 50 feet from the jurisdictional stream, that outlets stormwater drainage. Despite attempts to stabilize the area with riprap, scour hole, etc., there is continued erosion. The NCDOT will be extending the outlet to the stream in a pipe system with drainage structures that have drops in elevation. The drops will act to dissipate energy. The outlet pipe will be placed at 0.00% to minimize velocity. The 10-year outlet velocity is estimated at 3.1 feet per second (ft/s). The placement of the additional approximately 66-foot long section of pipe will be within the footprint of the permitted impacts. As such, no additional impacts will occur.

Four (4) figures are attached, including a location map (showing the location of Permit Site 10), and figures depicting the pipe extension and a Detail sheet are attached to this letter. The NCDOT respectfully requests these sheets be incorporated into the referenced permit and certification.

MAILING ADDRESS:
NC DEPARTMENT OF TRANSPORTATION
PROJECT DEVELOPMENT AND ENVIRONMENTAL ANALYSIS
NATURAL ENVIRONMENT UNIT
1598 MAIL SERVICE CENTER
RALEIGH NC 27699-1598

TELEPHONE: 919-715-1334 or
919-715-1335

FAX: 919-715-5501


WEBSITE: WWW.NCDOT.ORG

LOCATION:
PARKER LINCOLN BUILDING
2728 CAPITAL BLVD. SUITE 240
RALEIGH NC 27604

The placement of the additional section of pipe does not result in any changes to the permitted jurisdictional impacts. As such, a permit modification is not warranted. The information contained in this letter, along with the attached sheets, is provided as a Permit Addendum. Two (2) copies of this letter are being provided to DWQ for their use.

Thank you for your assistance with this project. If you have any questions or need additional information, please call Bill Barrett at (919) 715-1624.

Sincerely,

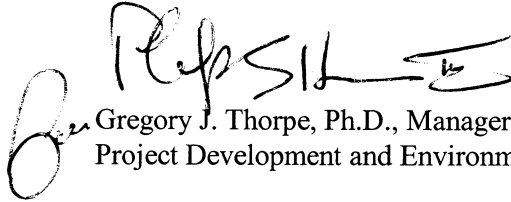A handwritten signature in black ink, appearing to read 'Gregory J. Thorpe', is written over a faint, larger version of the same signature.

Gregory J. Thorpe, Ph.D., Manager
Project Development and Environmental Analysis Branch

cc:

w/attachment

Mr. John Hennessy, NCDWQ (2 Copies)
Mr. Travis Wilson, NCWRC
Ms. Becky Fox, USEPA – Whittier, NC
Mr. Ronald Mikulak, USEPA – Atlanta, GA
Mr. Clarence W. Coleman, P.E., FHWA
Mr. Gary Jordan, USFWS
Dr. David Chang, P.E., Hydraulics
Mr. Mark Staley, Roadside Environmental
Mr. Greg Perfetti, P.E., Structure Design
Tim Johnson, P.E., Division 8 Engineer
Mr. Art King, Division 8 Environmental Officer

w/o attachment

Mr. Jay Bennett, P.E., Roadway Design
Mr. Majed Alghandour, P. E., Programming and TIP
Mr. Art McMillan, P.E., Highway Design
Mr. Scott McLendon, USACE, Wilmington
Mr. Jay McInnis, P.E., PDEA Project Planning Engineer

STATE OF NORTH CAROLINA
DIVISION OF HIGHWAYS

LEE COUNTY




ALL DIMENSIONS IN THESE
PLANS ARE IN METERS
UNLESS OTHERWISE
NOTED

| STATE | STATE PROJECT REFERENCE NO. | SHEET NO. | TOTAL SHEETS |
|-----------------|-----------------------------|--------------|--------------|
| N.C. | 6.549009T | 1 | |
| STATE PROJ. NO. | F.A. PROJ. NO. | DESCRIPTION | |
| 8.T540402 | STPNHF-421(2) | P.E. | |
| 6.549006T | | R / W, UTIL. | |
| 6.549009T | | CONST. | |
| | | | |
| | | | |
| | | | |
| | | | |


ADDITIONAL INFO. SHEET 1 OF 4

LOCATION: U.S. 421 / NC 87 SANFORD BYPASS FROM WEST OF US 1 / 15-501
TO EAST OF US 1 / 15-501

TYPE OF WORK: WIDENING, DRAINAGE, GRADING, PAVING, CURB AND GUTTER,
SIGNING, STRUCTURES, CULVERTS, NOISE WALL, & SIGNALS

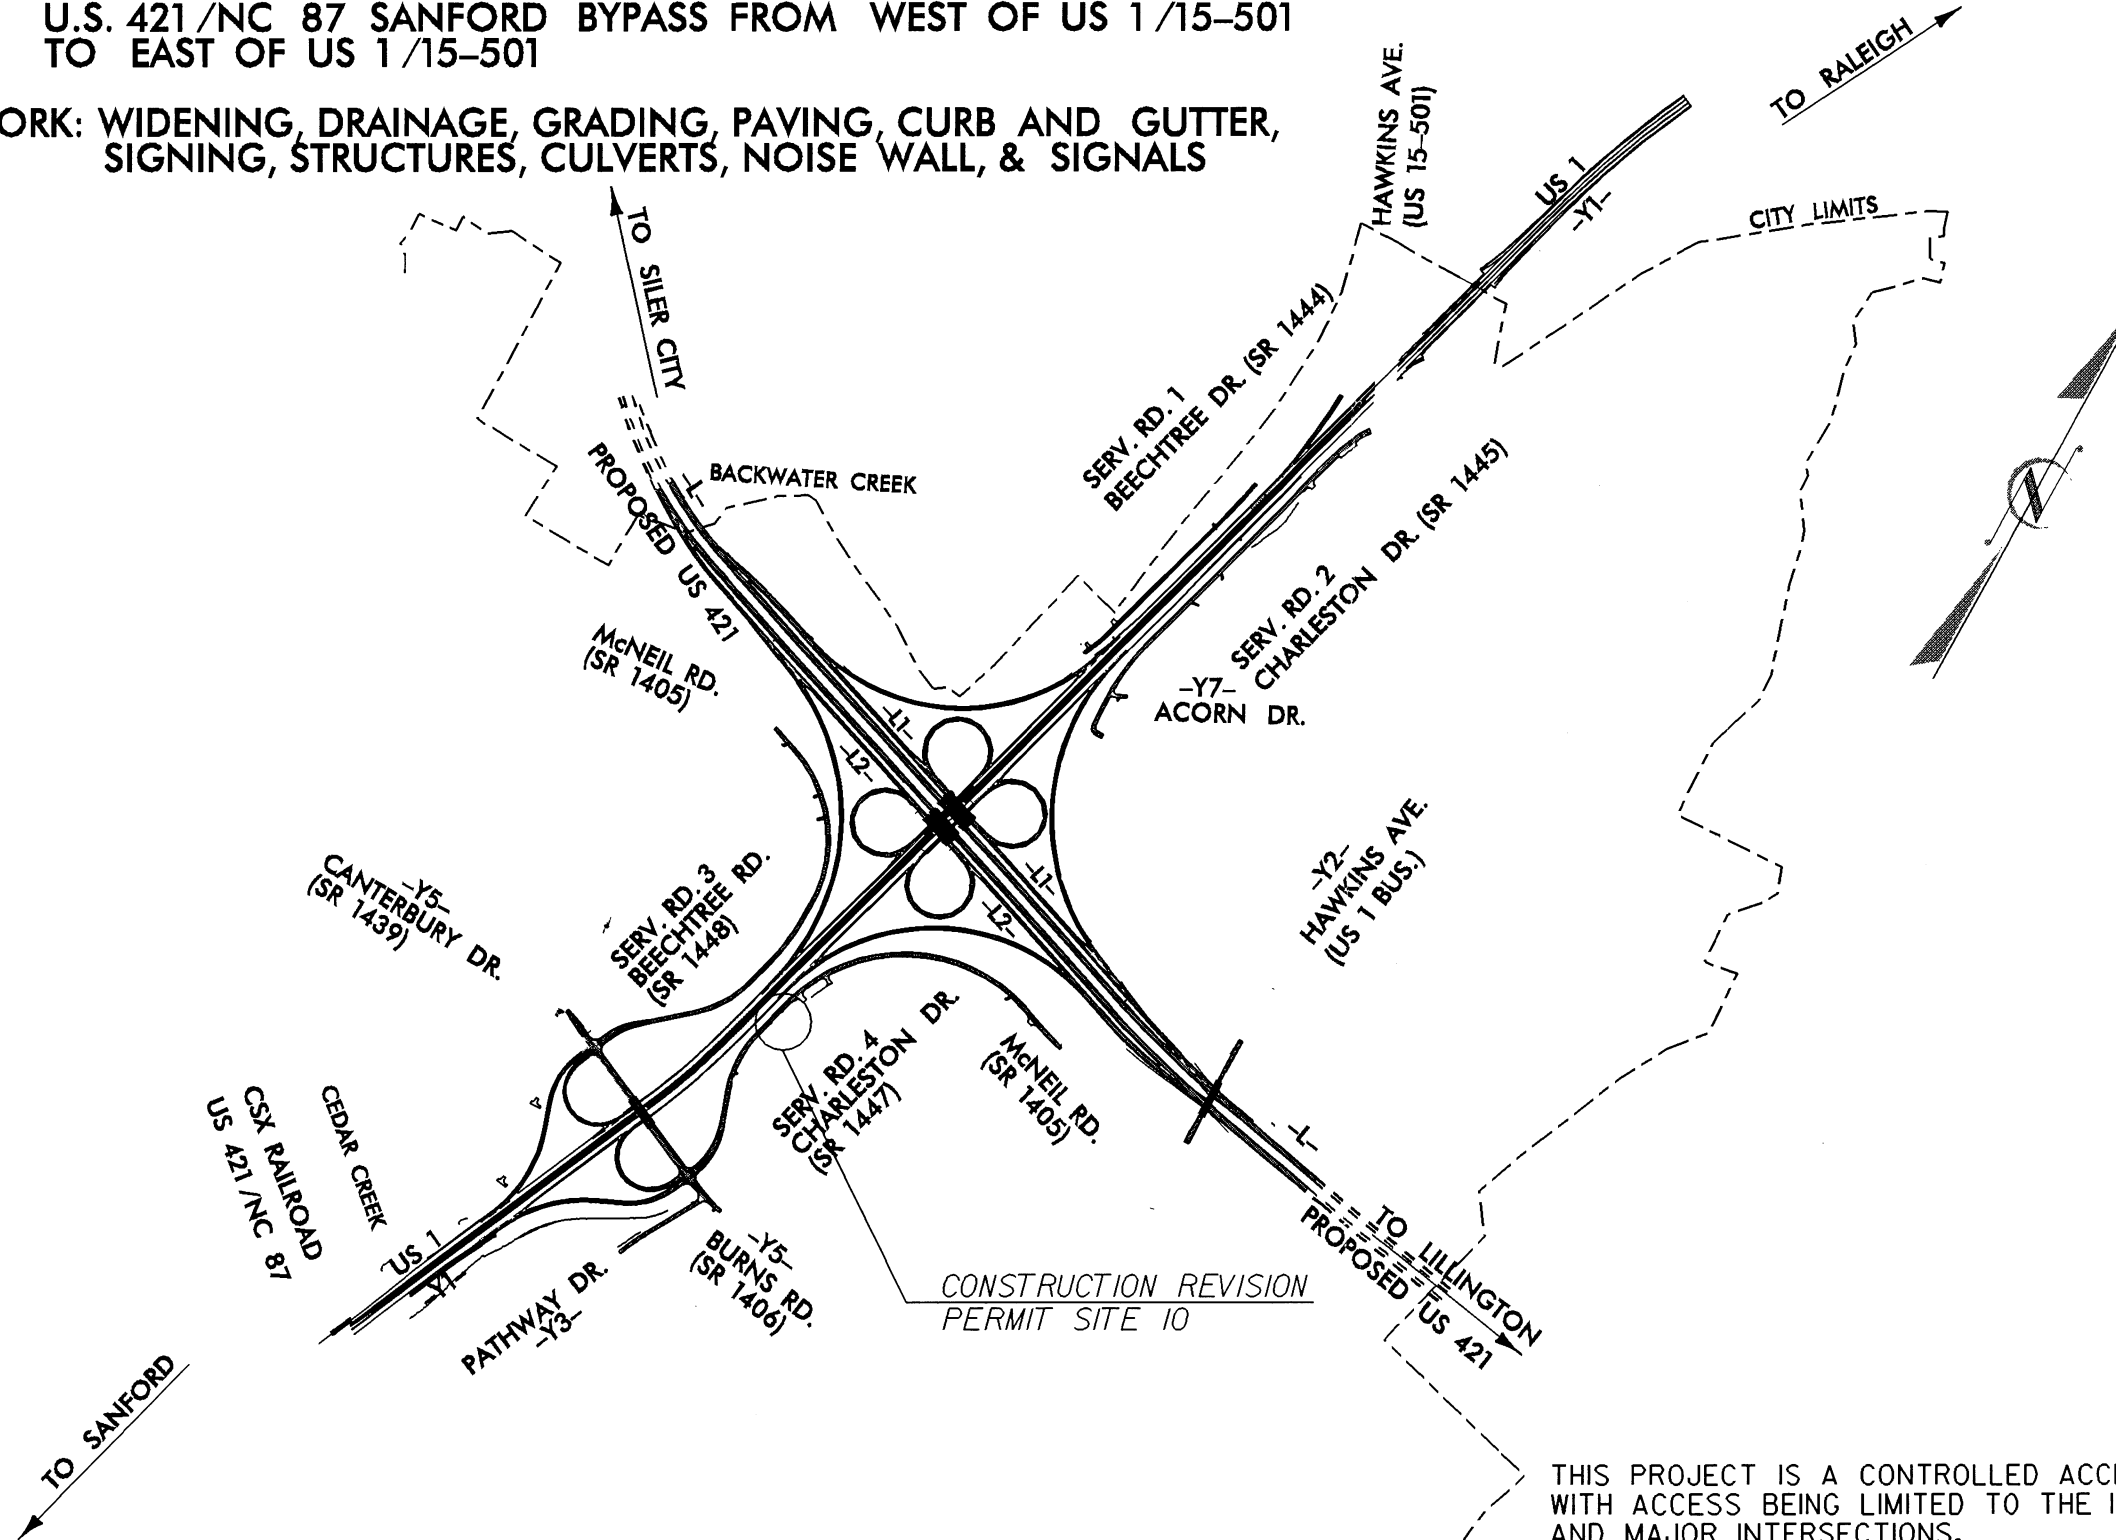


THIS PROJECT IS A CONTROLLED ACCESS PROJECT
WITH ACCESS BEING LIMITED TO THE INTERCHANGES
AND MAJOR INTERSECTIONS.

| | | |
|--|-------------------------|---------------------|
|  | PROJECT REFERENCE NO. | SHEET NO. |
| | R-2417AB | 18 |
| | HIGHWAY DESIGN ENGINEER | HYDRAULICS ENGINEER |
| CONST. REV. 4/29/05 | | |
| R/W REV. | | |

ADDITIONAL INFO SHEET 2 of 4

CONSTRUCTION REVISION - 04/29/05 - ADDED DOUBLE FACED CONCRETE BARRIER AND REVISED DRAINAGE ON -YI-

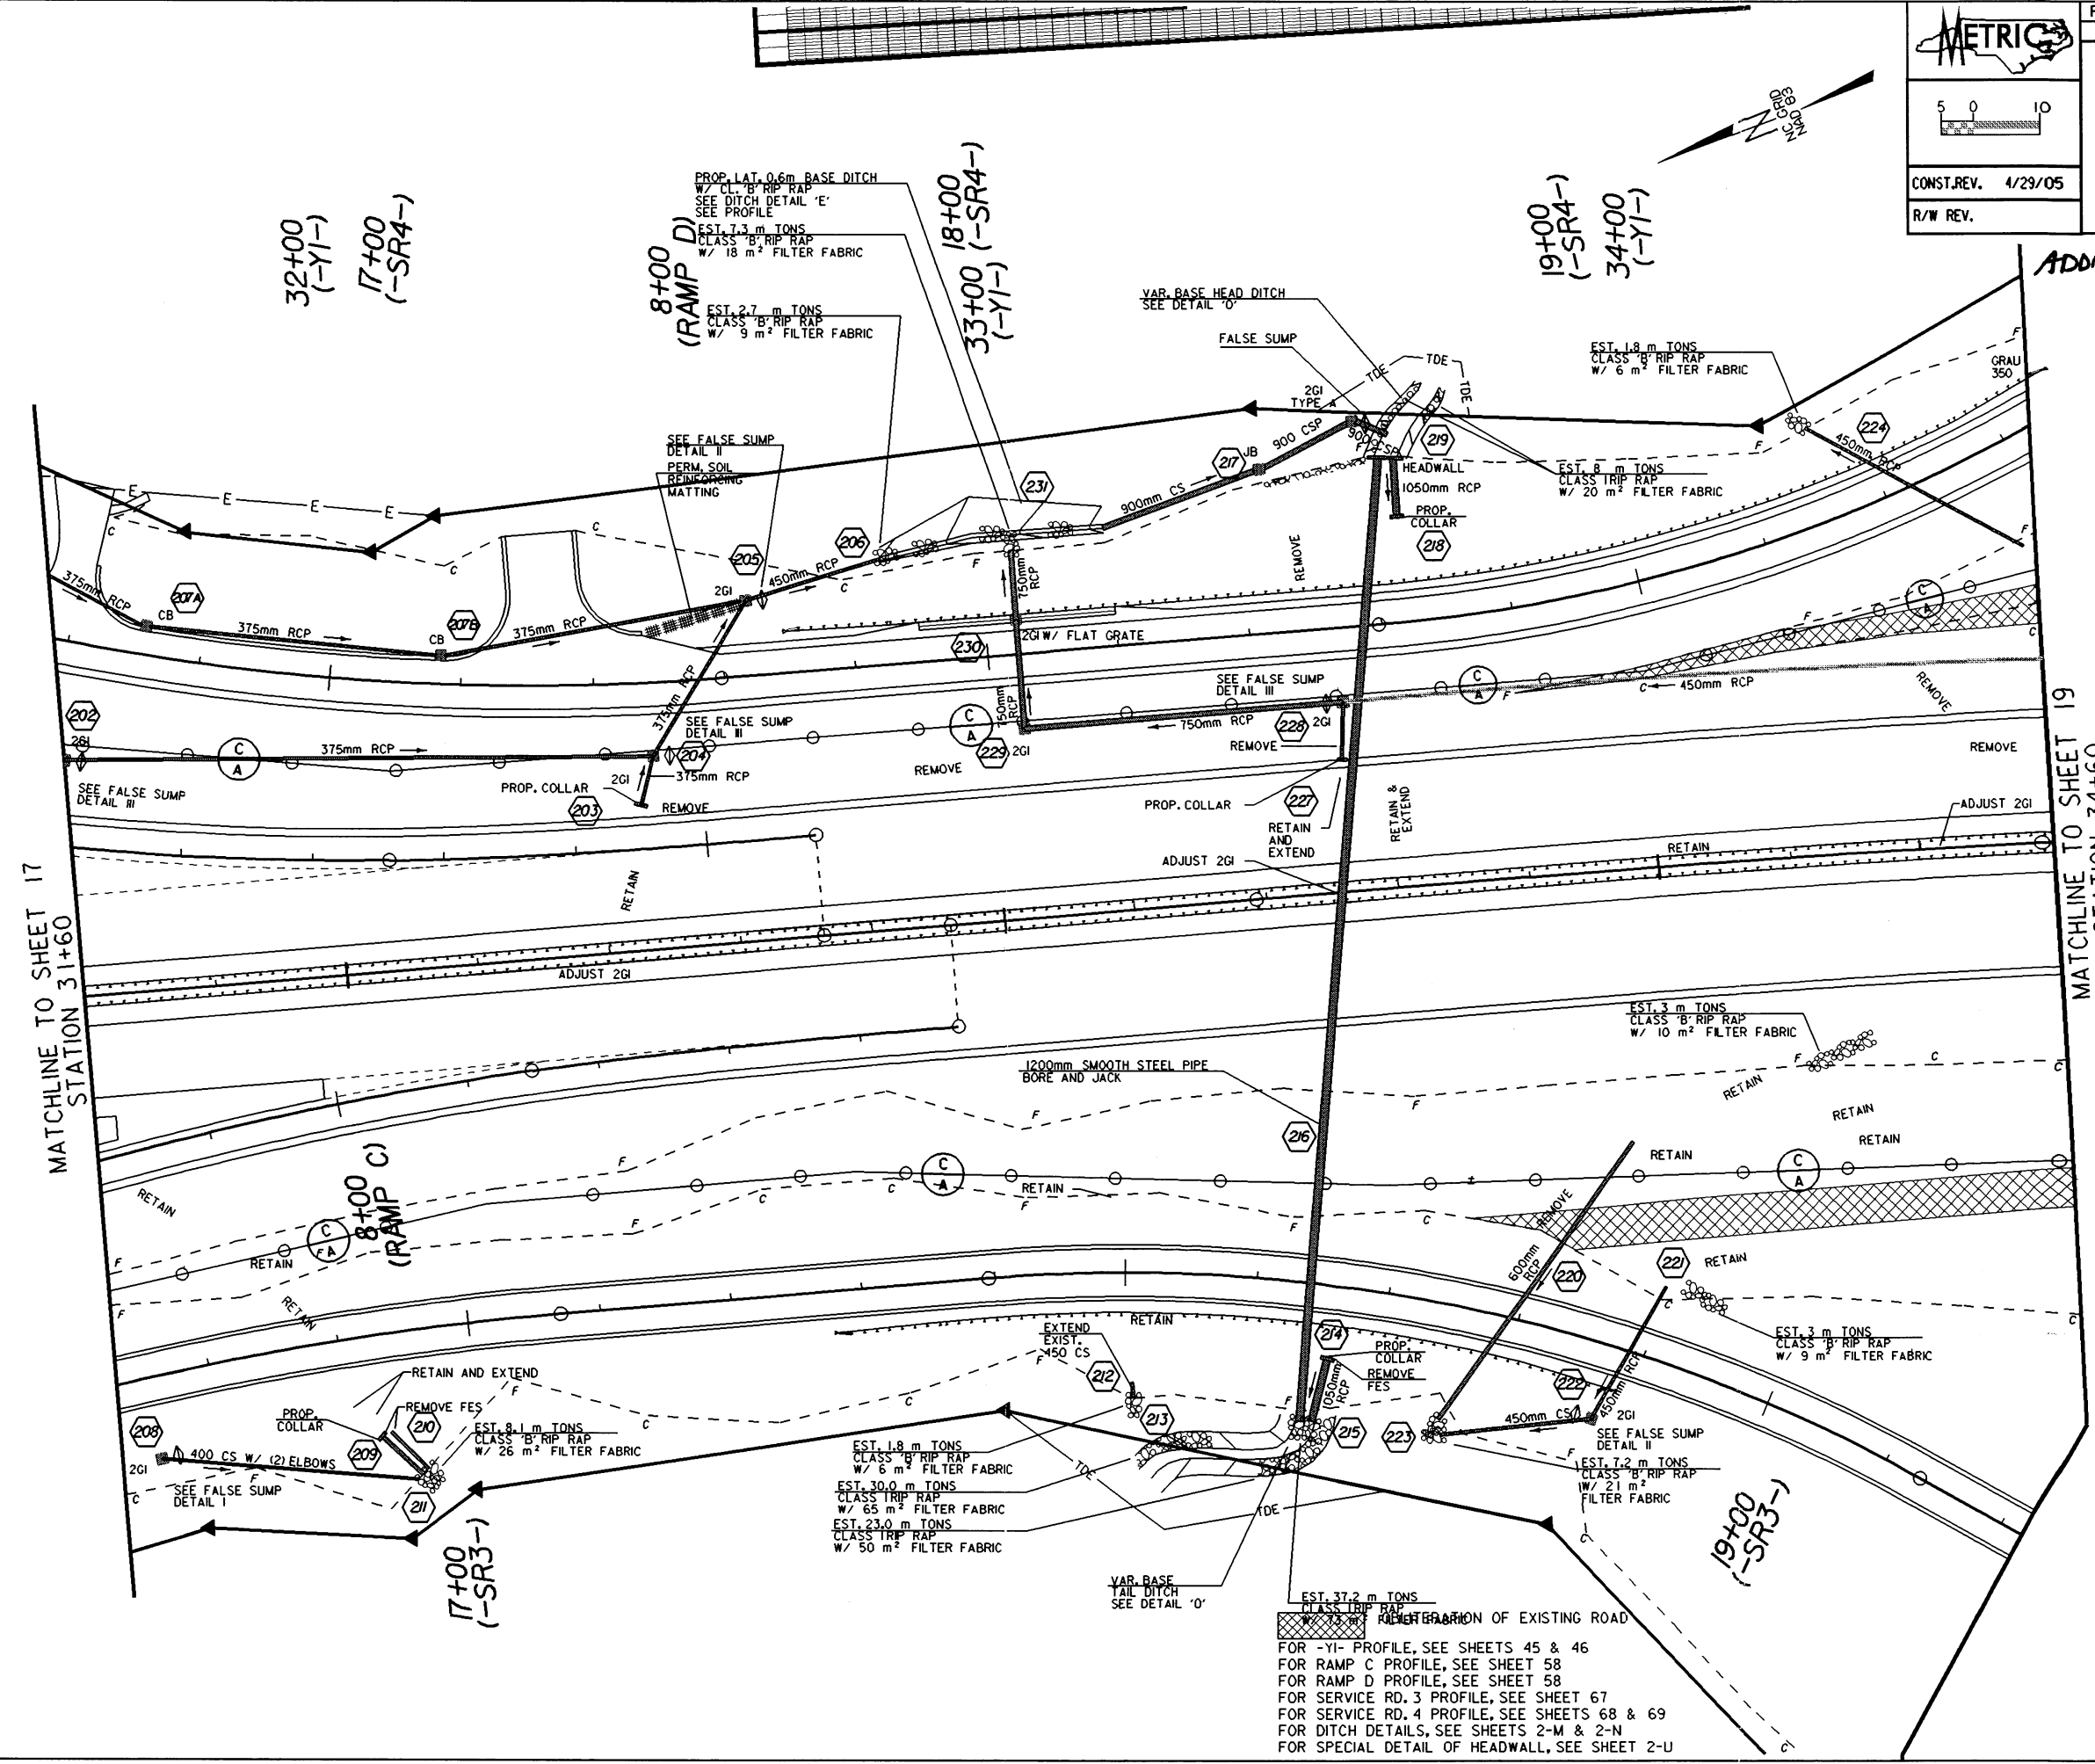

MATCHLINE TO SHEET 17
STATION 31+60


MATCHLINE TO SHEET 19
STATION 34+60

DATE: 04/29/05

FOR -YI- PROFILE, SEE SHEETS 45 & 46
 FOR RAMP C PROFILE, SEE SHEET 58
 FOR RAMP D PROFILE, SEE SHEET 58
 FOR SERVICE RD. 3 PROFILE, SEE SHEET 67
 FOR SERVICE RD. 4 PROFILE, SEE SHEETS 68 & 69
 FOR DITCH DETAILS, SEE SHEETS 2-M & 2-N
 FOR SPECIAL DETAIL OF HEADWALL, SEE SHEET 2-U

SUNGATE DESIGN GROUP
 95-A Jones Franklin Rd.
 Raleigh, N.C. 27606
 (919) 859-2243
 (919) 859-6258 (FAX)




BARBARA H. MULKEY ENGINEERING, INC.
 P. O. Box 3327
 Raleigh, N.C. 27636-3327
 (919) 859-1952
 (919) 859-1948 (FAX)




| | | |
|---------------------------------|----------------|--------------|
| PROJ. REFERENCE NO. R-2417AB | SHEET NO. | TOTAL SHEETS |
| STATE PROJ. NO. | F.A. PROJ. NO. | DESCRIPTION |

ADDITIONAL INFO SHEET 3 of 4

PERMIT SITE 10 (INLET)

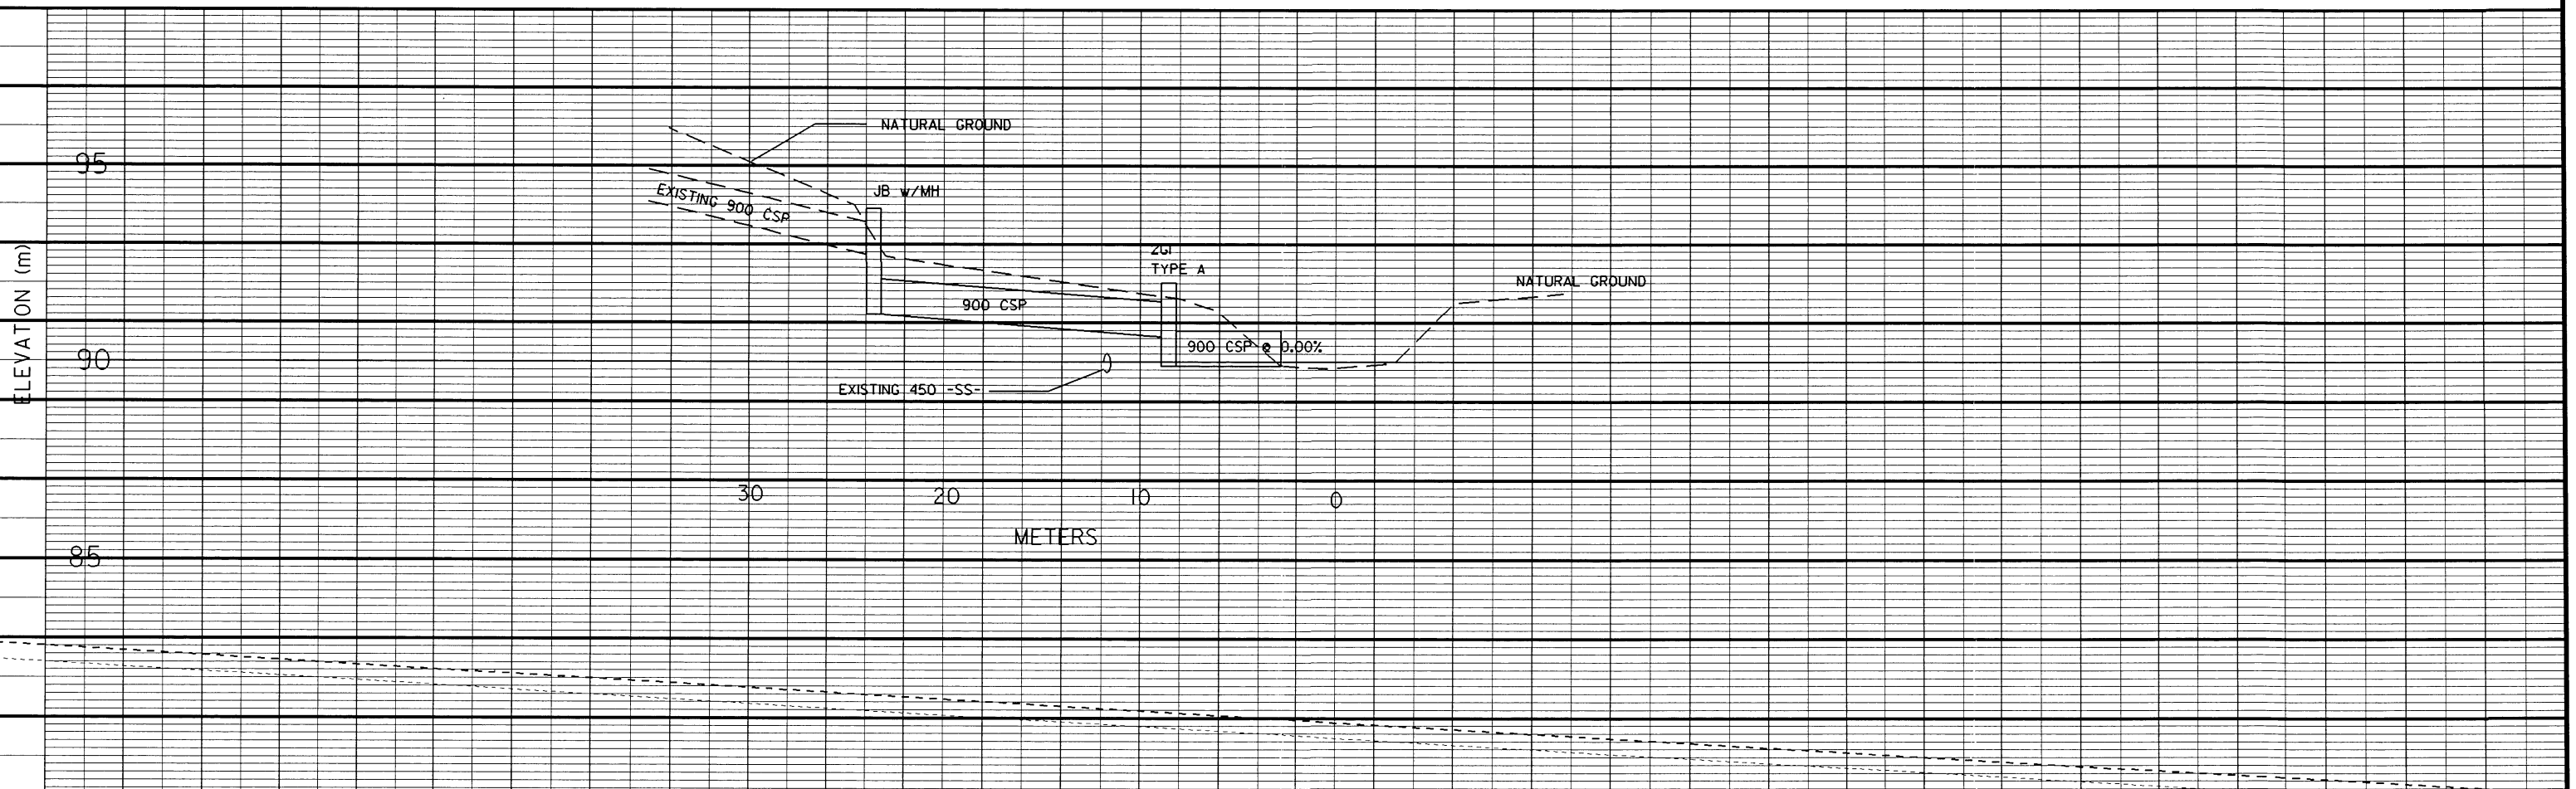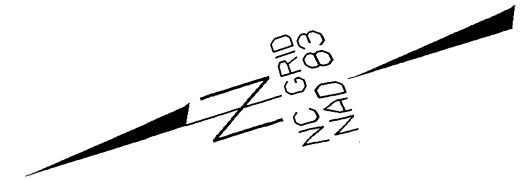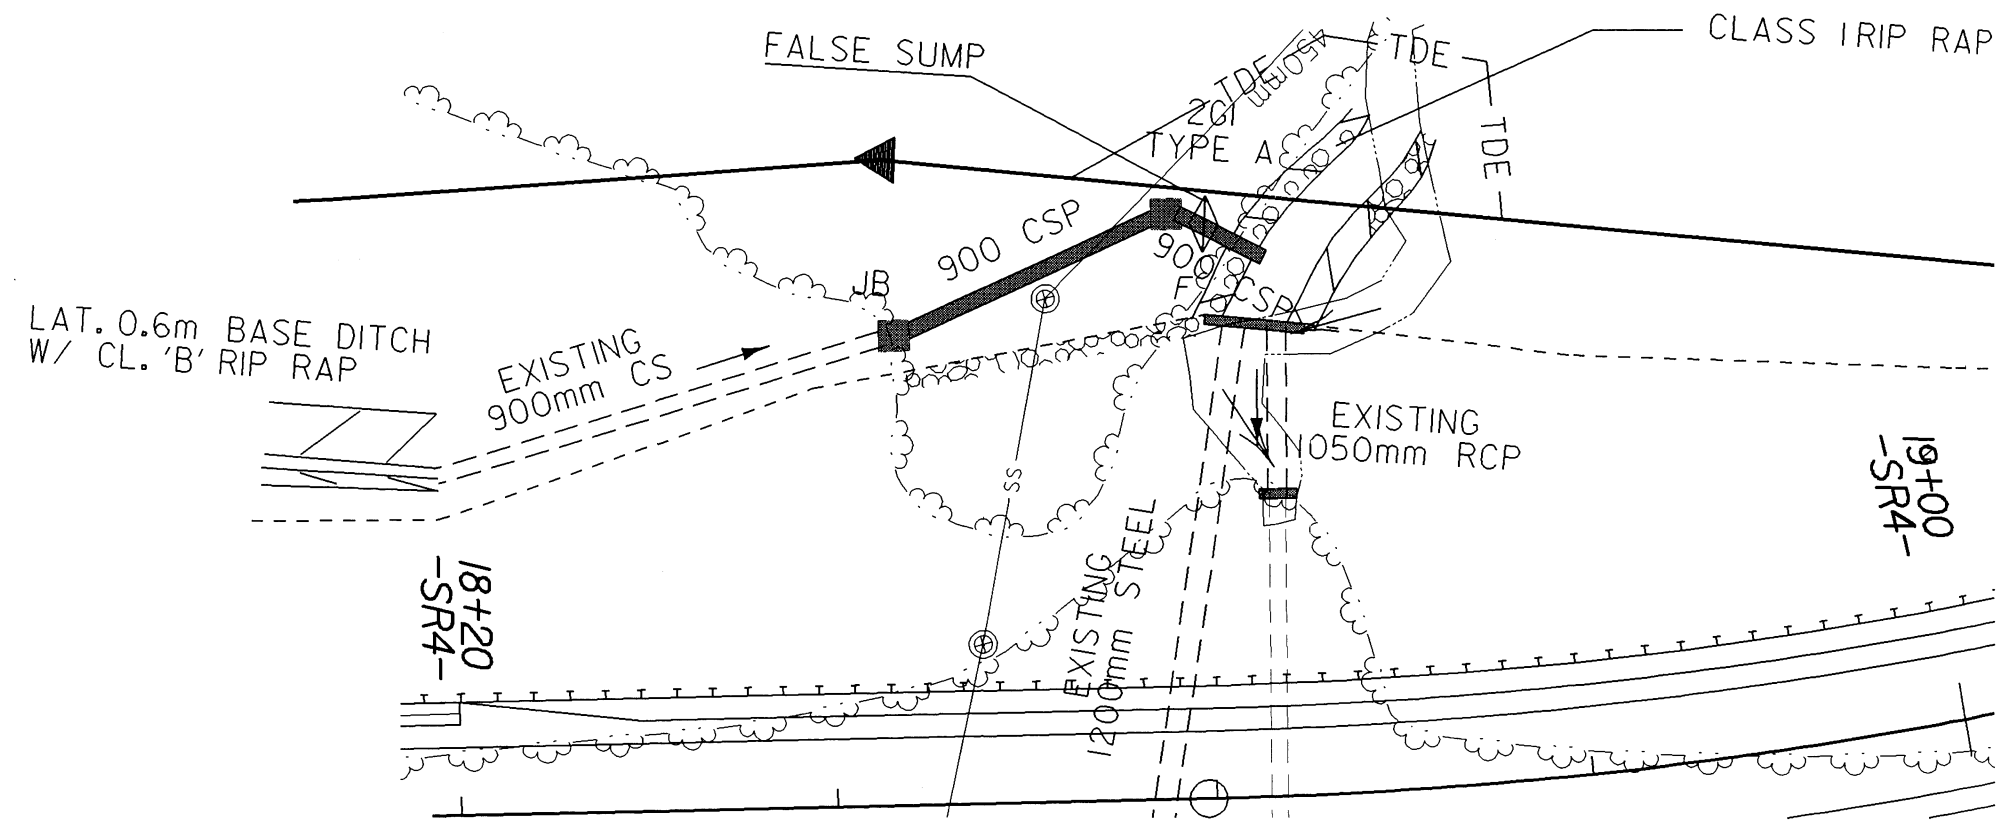


FALSE SUMP DETAIL I

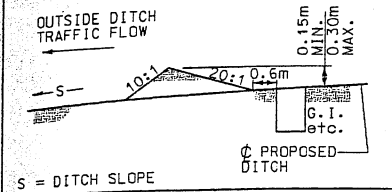


S = DITCH SLOPE

FALSE SUMP DETAIL II

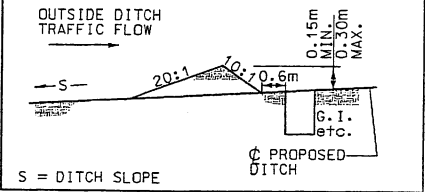

S = DITCH SLOPE


FALSE SUMP DETAIL III

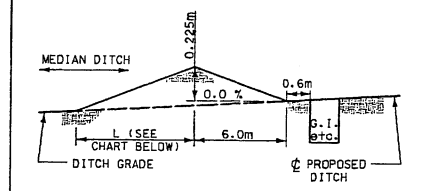

| DITCH GRADE | L | DITCH GRADE | L |
|-------------------|-----|-------------------|-----|
| 0.0% TO 2.0% | 20' | OVER 4.0% TO 6.0% | 40' |
| OVER 2.0% TO 4.0% | 30' | OVER 6.0% | 50' |

SPECIAL DITCH DETAIL

(NOT TO SCALE)

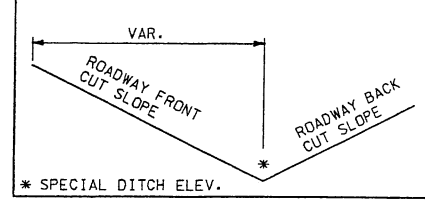

BARBARA H. MILKEY ENGINEERING, INC.
 P. O. Box 3327
 Raleigh, N.C. 27616-3227
 (919) 859-1922
 (919) 859-1928 FAX

SUNGATE DESIGN GROUP
 95-A Jones Franklin Rd.
 Raleigh, N.C. 27606
 (919) 859-2243
 (919) 859-6258 FAX

PROJECT REFERENCE NO. R-2417AB SHEET NO. 2-M

HIGHWAY DESIGN ENGINEER HYDRAULICS ENGINEER


CONST. REV. R/W REV.

3/11/03

ADDITIONAL INFO SHEET 4 OF 4

DITCH DETAIL 'A'


TOE PROTECTION ALONG FILL SLOPE (NOT TO SCALE)

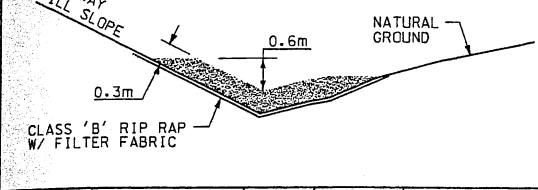

| LINE | STA. TO STA. | RIP RAP (m TONS) | FILTER FABRIC (m ²) |
|-------------|-------------------|------------------|---------------------------------|
| -L- | 69+81 - 70+40 RT. | 52.7 | 149.6 |
| -Y1- | 42+60 - 43+05 RT. | 86.2 | 196.1 |
| -Y1- LP 'A' | 2+90 - 3+12 RT. | 49.8 | 120.6 |
| -Y1- LP 'B' | 2+90 - 3+12 LT. | 48.7 | 117.8 |
| -SR4- | 18+44 - 18+60 LT. | 44.2 | 96.9 |

FALSE CUT DITCH DETAIL 'B'


(NOT TO SCALE)

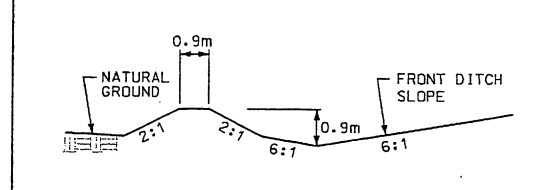

| LINE | STATION TO STATION |
|------|--------------------|
| -L2- | 1+42 - 1+52 RT. |
| -L- | 86+80 - 87+00 LT. |

DITCH DETAIL 'C'


LATERAL 'V' DITCH W/ CLASS 'B' RIP RAP (NOT TO SCALE)

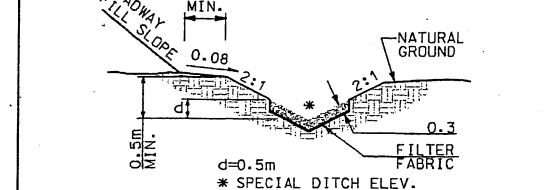

| LINE | STA. TO STA. | D.D.E. (m ³) | RIP RAP (m TONS) | FILTER FABRIC (m ²) |
|-------------|-------------------|--------------------------|------------------|---------------------------------|
| -L- | 69+80 - 69+96 LT. | 9.6 | 17.2 | 46.5 |
| -L- | 74+40 - 74+80 RT. | 52.4 | 42.9 | 116.3 |
| -Y1- | 42+40 - 43+08 LT. | 493.4 | 73.0 | 197.7 |
| -Y1- RP 'A' | 4+40 - 4+88 RT. | 42.5 | 51.5 | 139.5 |
| -Y5- RP 'D' | 3+15 - 3+73 LT. | 68.5 | 62.3 | 58.0 |

DITCH DETAIL 'D'


LATERAL 0.6m BASE DITCH (NOT TO SCALE)

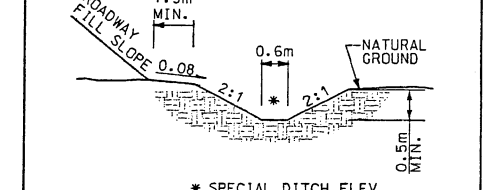

| LINE | STA. TO STA. | D.D.E. (m ³) |
|----------|-------------------|--------------------------|
| -L- | 70+40 - 70+75 LT. | 40.5 |
| SER.RD.4 | 12+60 - 14+00 LT. | 452.9 |
| SER.RD.4 | 13+50 - 14+80 RT. | 765.4 |
| -Y1- | 13+95 - 14+17 LT. | 13.6 |

DITCH DETAIL 'E'


LATERAL 0.6m BASE DITCH W/ CLASS 'B' RIP RAP (NOT TO SCALE)

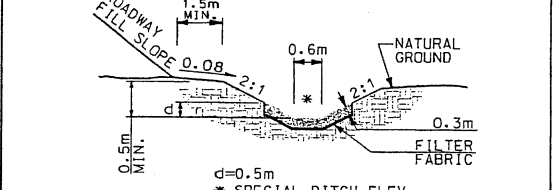

| LINE | STA. TO STA. | D.D.E. (m ³) | RIP RAP (m TONS) | FILTER FABRIC (m ²) |
|----------|-------------------|--------------------------|------------------|---------------------------------|
| -L- | 70+75 - 71+40 LT. | 543.5 | 88.2 | 226.9 |
| -L- | 74+18 - 74+35 LT. | 12.4 | 23.1 | 59.3 |
| -L- | 83+60 - 83+80 RT. | 14.1 | 27.1 | 69.8 |
| SER.RD.4 | 15+20 - 15+37 LT. | 23.9 | 23.1 | 59.3 |
| SER.RD.4 | 17+85 - 18+20 LT. | 139.7 | 47.5 | 122.2 |

DITCH DETAIL 'F'


0.6m BASE HEAD/TAI DITCH (NOT TO SCALE)

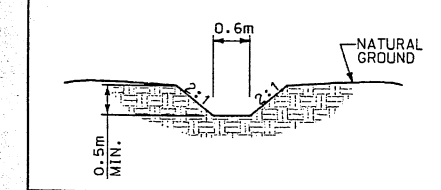

| LINE | STA. TO STA. | D.D.E. (m ³) |
|-------------|--------------|--------------------------|
| -L- | 74+15 RT. | 4.5 |
| -Y1- RP 'B' | 5+10 LT. | 11.0 |
| -Y5- LP 'A' | 1+60 LT. | 9.0 |

DITCH DETAIL 'G'


'V' HEAD DITCH W/ CLASS 'B' RIP RAP (NOT TO SCALE)

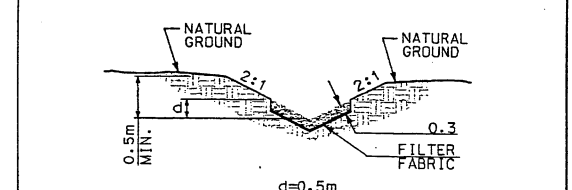

| LINE | STA. TO STA. | D.D.E. (m ³) | RIP RAP (m TONS) | FILTER FABRIC (m ²) |
|-------------|--------------|--------------------------|------------------|---------------------------------|
| -Y1- RP 'A' | 4+88 RT. | 5.9 | 4.9 | 21.2 |

DITCH DETAIL 'H'


LATERAL 0.9m BASE DITCH W/ CLASS 'B' RIP RAP (NOT TO SCALE)

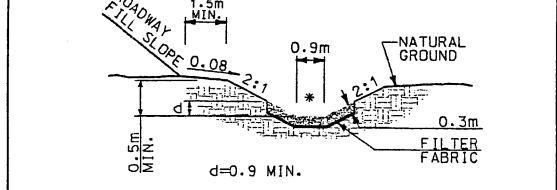

| LINE | STA. TO STA. | D.D.E. (m ³) | RIP RAP (m TONS) | FILTER FABRIC (m ²) |
|------|-------------------|--------------------------|------------------|---------------------------------|
| -L- | 79+90 - 80+15 LT. | 67.6 | 141.6 | 334.7 |

DITCH DETAIL 'I'


LATERAL 1.8m BASE DITCH (NOT TO SCALE)

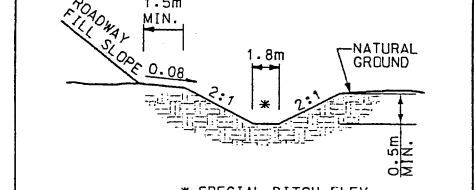

| LINE | STA. TO STA. | D.D.E. (m ³) |
|-------------|-----------------|--------------------------|
| -Y1- RP 'B' | 3+64 - 3+96 LT. | 473.1 |

DITCH DETAIL 'J'


LATERAL 'V' DITCH (NOT TO SCALE)

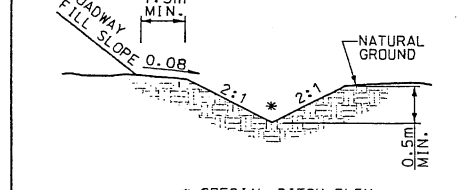

| LINE | STA. TO STA. | D.D.E. (m ³) |
|-----------------------|-------------------|--------------------------|
| -L- | 76+90 - 77+25 RT. | 109.7 |
| -L- | 81+22 - 81+29 RT. | 3.5 |
| MIN. DEPTH - NO GRADE | | |
| -Y1- | 22+07 - 22+47 RT. | 197.6 |
| SER.RD.2 | 18+10 - 18+50 LT. | 20.0 |
| SER.RD.3 | 20+03 - 20+20 LT. | 53.6 |

DITCH DETAIL 'K'


0.6m BASE HEAD/TAI DITCH W/ CLASS 'B' RIP RAP (NOT TO SCALE)

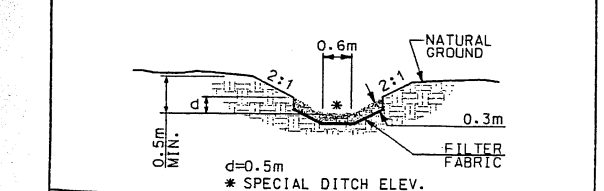

| LINE | STA. TO STA. | D.D.E. (m ³) | RIP RAP (m TONS) | FILTER FABRIC (m ²) |
|------|--------------|--------------------------|------------------|---------------------------------|
| -L- | 81+50 LT. | 8.0 | 11.0 | 40.8 |

DITCH DETAIL 'L'


CHANNEL CHANGE - 1.5m BASE DITCH (NOT TO SCALE)

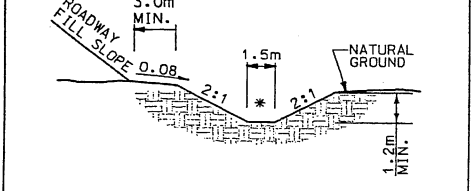

| LINE | STA. TO STA. | D.D.E. (m ³) |
|-------------|-----------------|--------------------------|
| -Y1- RP 'A' | 2+35 - 2+60 RT. | 125.0 |

DITCH DETAIL 'M'


DITCH CLEANOUT (NOT TO SCALE)

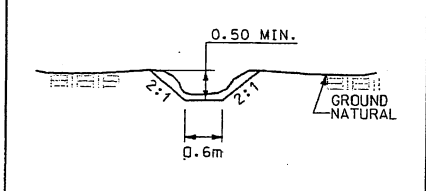

| LINE | STA. TO STA. | D.D.E. (m ³) |
|------|--------------|--------------------------|
| -Y1- | 41+50 RT. | 9.0 |

DITCH DETAIL 'N'


0.9m BASE HEAD/TAI DITCH (NOT TO SCALE)

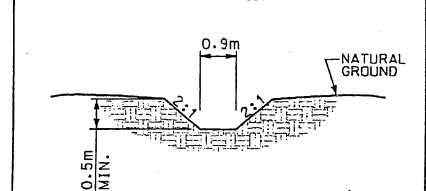

| LINE | STA. TO STA. | D.D.E. (m ³) |
|-------------|--------------|--------------------------|
| -Y1- | 21+80 LT. | 14.0 |
| -Y1- RP 'B' | 7+10 LT. | 19.0 |

DITCH DETAIL 'O'

VARIABLE BASE HEAD/TAI DITCH (NOT TO SCALE)

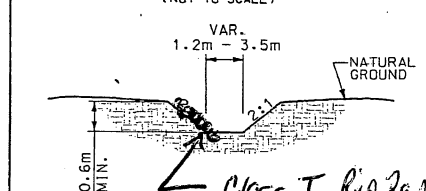

| LINE | STA. TO STA. | D.D.E. (m ³) |
|------------|--------------|--------------------------|
| -SER.RD.3- | 18+20 RT. | 100.0 |
| -SER.RD.4- | 18+60 LT. | 36.0 |

07/27/2003 08:56:23 AM C:\p\proj\99139\401\2417ab.rvt