



STATE OF NORTH CAROLINA  
DEPARTMENT OF TRANSPORTATION

BEVERLY EAVES PERDUE  
GOVERNOR

EUGENE A. CONTI, JR.  
SECRETARY

October 7, 2010

Mr. Ronnie Smith  
U.S. Army Corps of Engineers  
Wilmington Field Office  
P.O. Box 1890  
Wilmington, NC 28402-1890

**Subject: Permit Modification Request for Individual Section 404 Permit and Individual Water Quality Certification** for Fayetteville Outer Loop from I-95 South of Fayetteville to NC 24-87, Cumberland, Hoke, and Robeson Counties. Federal Aid Project No. NHF-DPR-0100(001), State Project No. 8.2441301, TIP Nos X-0002 B & C, and U-2519 AA, AB, BA, BB, CA, CB, DA, & E, Debit \$570 from WBS 35196.3.19

**Reference:** Section 404 and 401 Individual Permit Application requested April 25, 2008  
Section 404 Individual Permit issued October 23, 2008; USACE Permit No. SAW-2008-01413  
Section 401 Water Quality Certification issued October 6, 2008; NCDWQ Project No. 003278  
Section 404 and 401 Modification requested May 21, 2010  
Section 401 Modification issued June 3, 2010; DWQ Project No. 20080737 v.2

Dear Sir:

This modification request is relevant to section X-0002 C. The design of the proposed bridge at site 8 (Sta. 144+45-144+90 -L-) has been shortened due to updated geotechnical information that indicated a longer bridge was not required as previously determined. This has resulted in an increase of roadway fill in wetlands and an extension of the proposed pipe in the jurisdictional stream. Compensatory mitigation for the additional 0.21 acre of wetland impact and 410 feet of jurisdictional stream impacts were debited from the Privateer Wetland and Stream Mitigation Site (debit ledger also reflects mitigation credits debited from the previous modification requested May 21, 2010 for 0.24 acre resulting in a total of 0.45 acre). This brings total project wetland impacts to 48.88 acres (35.29 riparian, 13.59 non-riparian) and total project stream impacts to 13,642 feet. Please see the enclosed revised permit drawings, roadway plans, and a revised Privateer Wetland and Stream Mitigation Site Debit Ledger for the above referenced project.

Additionally, NCDOT has eliminated the 12-inch sill at the outlet of the pipe at site 6 (Sta. 135+55-137+00 -L-) due to lack of functionality. Instead, a junction box will be installed on the 60-inch pipe

**MAILING ADDRESS:**  
NC DEPARTMENT OF TRANSPORTATION  
PROJECT DEVELOPMENT AND ENVIRONMENTAL ANALYSIS  
1598 MAIL SERVICE CENTER  
RALEIGH NC 27699-1598

TELEPHONE: 919-431-2000  
FAX: 919-431-2002

WEBSITE: [WWW.NCDOT.ORG](http://WWW.NCDOT.ORG)

**LOCATION:**  
4701 ATLANTIC AVENUE  
SUITE 116  
RALEIGH NC 27604


and the pipe outlet will be set on a flat slope to slow velocity. This will not result in additional impacts.

Section 404 Permit: NCDOT requests that the U.S. Army Corps of Engineers (USACE) review this application and issue a modification for the Individual 404 Permit issued October 23, 2008, as required for the above-described activities.

Section 401 Permit: NCDOT requests that the NCDWQ review this application and issue a modification for the Individual 401 Certification issued October 6, 2008, as required for the above-described activities. In accordance with 15A NCAC 2H .0501(a) we are providing five copies of this modification request to the North Carolina Department of Environmental and Natural Resources for their approval and \$570 to act as payment for processing the permit modification (see subject line).

Thank you for your assistance with this project. If you have any questions or need additional information, please contact Tyler Stanton at [tstanton@ncdot.gov](mailto:tstanton@ncdot.gov) or (919) 431-6748.

Sincerely,

*for* 

Gregory J. Thorpe, Ph.D., Manager  
Project Development and Environmental Analysis Branch

Cc:

W/attachment

Mr. Brian Wrenn, NCDWQ (5 Copies)  
Ms. Jennifer Derby, USEPA

W/o attachment (see website for attachments)

Dr. David Chang, P.E., Hydraulics  
Mr. Greg Perfetti, P.E., Structure Design  
Mr. Victor Barbour, P.E., Project Services Unit  
Mr. Mark Staley, Roadside Environmental  
Mr. Greg Burns, P.E, Division 6 Engineer  
Mr. Jim Rerko, Division 6 Environmental Officer  
Mr. Jay Bennett, P.E., Roadway Design  
Mr. Majed Alghandour, P. E., Programming and TIP  
Mr. Art McMillan, P.E., Highway Design  
Mr. Scott McLendon, USACE, Wilmington  
Mr. Travis Wilson, NCWRC  
Mr. Gary Jordan, USFWS  
Ms. Anne Deaton, NCDMF  
Mr. Ron Sechler, NMFS  
Mr. Michael Penney, P.E., PDEA  
Mr. Phillip Ayscue, NCDOT External Audit Branch  
Mr. Drew Joyner, PE, Human Environment Unit Head  
Mr. Clarence W. Coleman, P.E., FHWA  
Ms. LeiLani Paugh, NEU

## Compensatory Mitigation

The Privateer Farms Restoration Site (Site) is located in Bladen and Cumberland Counties, North Carolina, approximately fourteen miles southeast of Fayetteville. Prior to restoration, land use on the Site over the past 20 years had been primarily row crop agriculture. Stream and riparian functions on the Site had been severely impacted as a result of agricultural conversion. Harrison Creek had historically meandered through the Site, but was channelized in the early 1980s to reduce flooding and provide a drainage outlet for the extensive network of ditches excavated across the Site. Subsequent to channelization, Harrison Creek existed as a large canal running straight through the Site.

Restoration activities for the Site involved moving the stream channel back to its historic location and elevation, and filling drainage ditches to raise the local water table and restore wetland and stream hydrology. The plan also included scarification of the fields and breaking of the local plow pan to increase surface water storage and provide a range of hydrologic conditions suitable for a variety of native wetland plant species. The restoration plan for the Site predicted the restoration of 405 acres of riverine wetlands, 25 acres of riverine wetland enhancement, and 33,985 linear feet (LF) of stream restoration. Following construction, the as-built data indicated that the total area of restored riverine wetlands was 402.5 acres (excluding 2.5 acres for road accesses), with 25 acres of enhanced riverine wetlands, and 34,005 LF of restored stream channel. As of fall 2009, the Site has met all prescribed hydrologic and vegetative monitoring criteria and been recommended for closeout.

To offset an additional .45 acres of unavoidable riverine wetland impacts and 410 feet of stream impacts associated with T.I.P. U-2519, the Privateer Farms Mitigation Site will be debited an additional 1.35 acres of riverine wetland restoration and 615 feet of stream restoration. These debits are reflected in the following ledger.

Site Name	River Basin	HUC	Mitigation Type	Transfer from EEP	Available	TIP Debit	TIP Debit
Privateer Site	Cape Fear	3030004				<b>U-2519</b>	<b>U-2519 MOD</b>
			Warm Stream Restoration	25,676	5,213	19,848	615
			Riverine Wetland Restoration	146.98	0.34	145.29	1.35

**WETLAND PERMIT IMPACT SUMMARY**

Site No.	Station (From/To)	Structure Size / Type	WETLAND IMPACTS						SURFACE WATER IMPACTS					
			Permanent Fill In Wetlands (ac)	Temp. Fill In Wetlands (ac)	Excavation in Wetlands (ac)	Mechanized Clearing in Wetlands (ac)	Hand Clearing in Wetlands (ac)	Permanent SW impacts (ac)	Temp. SW impacts (ac)	Existing Channel Impacts Permanent (ft)	Natural Stream Design (ft)			
1	83+50-85+00 -L-	72" RCP	1.11		0.03	0.10				0.04			279	
2	92+90-93+80 -L-	42" RCP	0.50		0.02	0.08								
3	105+15-105+70 -L-	2 @ 6' x 7' RCBC	0.76			0.05				0.86			775	
4	117+95-118+70 -L-	325' Bridge	0.36			0.08		0.55						
5	129+60-130+20 -L-	54" RCP	0.69			0.06				0.02			361	
6	135+55-137+00 -L-	60" RCP	1.68			0.09				0.04			479	
7	141+30-142+30 -L-	36" RCP	1.55			0.05				0.01			213	
8	144+45-144+90 -L-	48" RCP	0.29			0.03				0.11			919	
9	14+20 -Y-Rev	2 @ 6' x 7' RCBC								2.54			98	
10	13+66-14+06 -Y1-	48" RCP	0.19		0.01	0.04				0.01			207	
<b>TOTALS:</b>			7.12		0.06	0.59		0.55		3.63			3332	

SITE 10: LATERAL EFFECT ON WETLAND DUE TO EXCAVATION = 0.01 ac

FILL IN SURFACE WATERS (POND)

SITE 3: 0.73 ac  
 SITE 9: 2.53 ac

NC DEPARTMENT OF TRANSPORTATION  
 DIVISION OF HIGHWAYS  
 CUMBERLAND COUNTY  
 WBS - 35196.1.2 (X-0002C)

**WETLAND PERMIT IMPACT SUMMARY**

Site No.	Station (From/To)	Structure Size / Type	WETLAND IMPACTS					SURFACE WATER IMPACTS					
			Permanent Fill In Wetlands (ha)	Temp. Fill In Wetlands (ha)	Excavation in Wetlands (ha)	Mechanized Clearing in Wetlands (ha)	Hand Clearing in Wetlands (ha)	Permanent SW impacts (ha)	Temp. SW impacts (ha)	Existing Channel Impacts Permanent (m)	Natural Stream Design (m)		
1	83+50-85+00 -L-	1800 mm RCP	0.448		0.013	0.040			0.015			85	
2	92+90-93+80 -L-	1050 mm RCP	0.203		0.007	0.033							
3	105+15-105+70 -L-	2 @ 1.8m x 2.1m RCBC	0.306			0.022			0.347			236	
4	117+95-118+70 -L-	99m Bridge	0.145			0.034		0.223					
5	129+60-130+20 -L-	1350 mm RCP	0.280			0.025			0.008			110	
6	135+55-137+00 -L-	1500 mm RCP	0.680			0.038			0.018			146	
7	141+30-142+30 -L-	900 mm RCP	0.626			0.021			0.004			65	
8	144+45-144+90 -L-	1200 mm RCP	0.116			0.012			0.046			280	
9	14+20 -Y-Rev	2 @ 1.8m x 2.1m RCBC							1.027			30	
10	13+66-14+06 -Y1-	1200 mm RCP	0.076		0.004	0.015			0.004			63	
<b>TOTALS:</b>			2.880		0.024	0.240		0.223	1.469			1015	

SITE 10: LATERAL EFFECT ON WETLAND DUE TO EXCAVATION = 0.003 ha

**FILL IN SURFACE WATERS (POND)**

SITE 3: 0.297 ha  
 SITE 9: 1.023 ha

NC DEPARTMENT OF TRANSPORTATION  
 DIVISION OF HIGHWAYS  
 CUMBERLAND COUNTY  
 WBS - 35196.1.2 (X-0002C)

SHEET **REV.** 7/28/2010


**Permit Drawing**  
 Sheet **4** of **64**

9/09/09

**TIP PROJECT: X-0002CB**

**CONTRACT:**

See Sheet 1-A For Index of Sheets  
See Sheet 1-B For Conventional Symbols

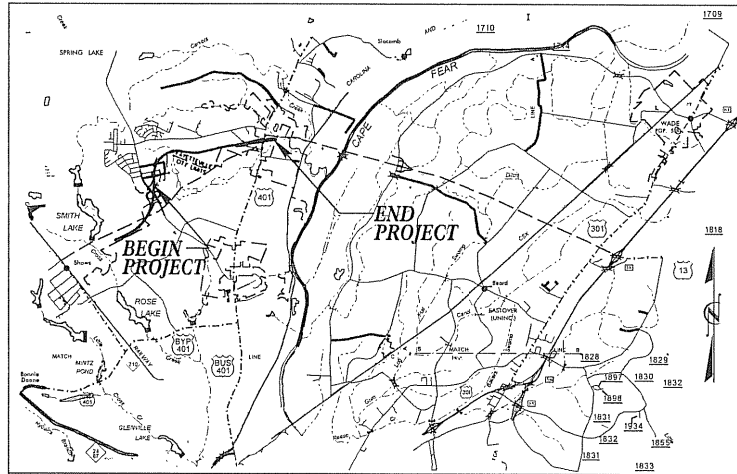

VICINITY MAP

STATE OF NORTH CAROLINA  
DIVISION OF HIGHWAYS

**CUMBERLAND COUNTY**

LOCATION: NC 24 EXTENSION (FAYETTEVILLE OUTER LOOP)  
FROM EAST OF SR1600 (MCARTHUR RD.)  
TO WEST OF US401( RAMSEY ST.)

TYPE OF WORK: GRADING, DRAINAGE, PAVING, STRUCTURES AND  
SIGNING


**METRIC**

ALL DIMENSIONS IN THESE PLANS ARE IN METERS

STATE	STATE PROJECT REFERENCE NO.	SHEET NO.	TOTAL SHEETS
N.C.	X-0002CB	1	
STATE PROJ. NO.	F.A. PROJ. NO.	DESCRIPTION	
35196.1.2	NHF-DPR-0100(002)	P.E.	
35196.2.4		ROW & UTIL CONST.	


**WETLAND/STREAM IMPACTS**

Permit Drawing Rev. 7/28/10  
Sheet 6 of 64

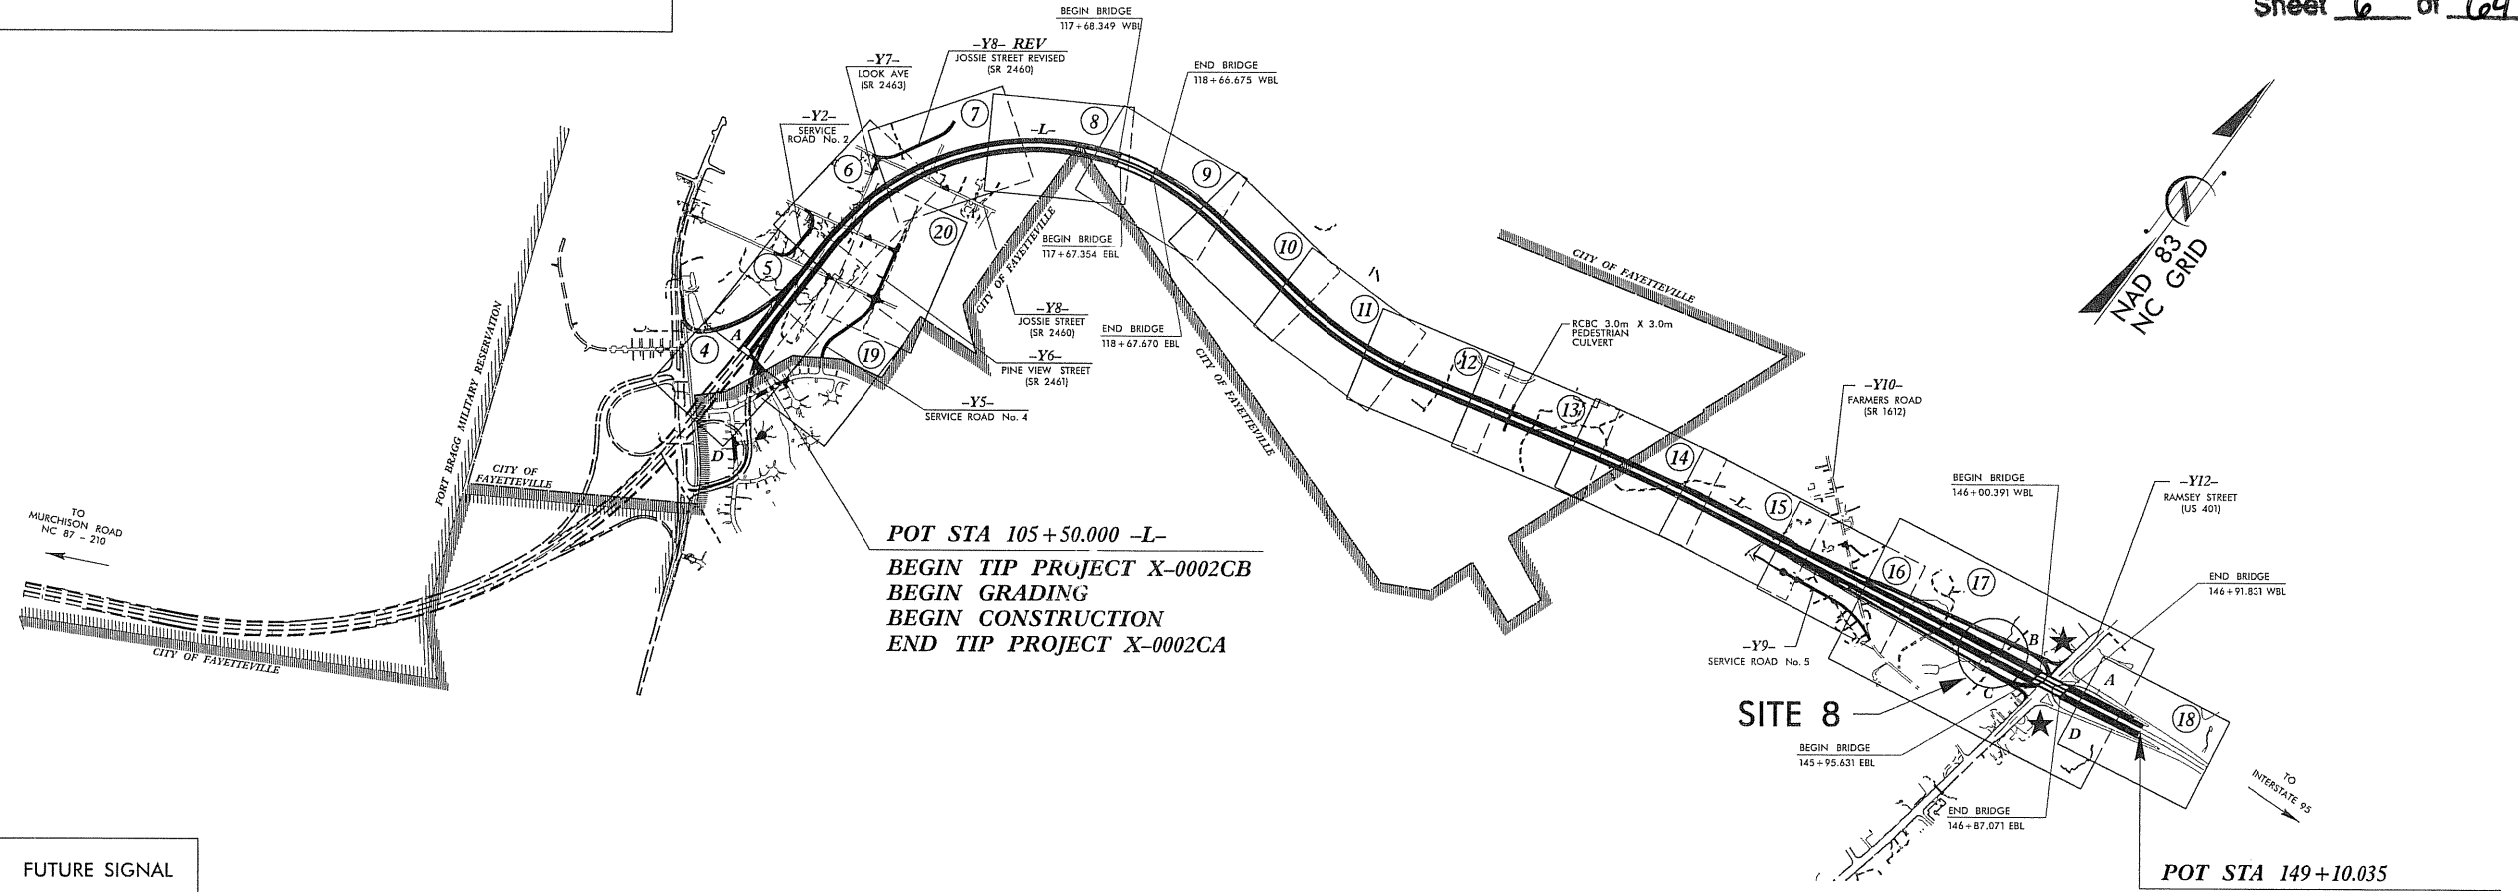

★ FUTURE SIGNAL

THIS IS A CONTROLLED ACCESS PROJECT  
WITH ACCESS LIMITED TO INTERCHANGES

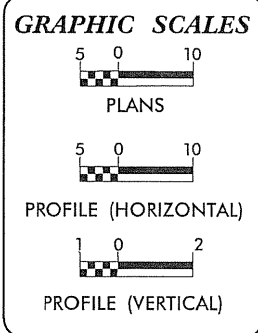

**DESIGN DATA**

ADT 2008	=	34,700
ADT 2030	=	59,600
DHV	=	9 %
D	=	55 %
T	=	10 % *
V	=	110 km/h
* (TTST 4 % DUAL 6 %)		
FUNC. CLASS	=	INTERSTATE

**PROJECT LENGTH**

LENGTH ROADWAY TIP PROJECT X-0002CB	=	4.170 km
LENGTH STRUCTURES TIP PROJECT X-0002CB	=	0.190 km
TOTAL LENGTH OF TIP PROJECT X-0002CB	=	4.360 km

Prepared in the Office of:

**MOFFATT & NICHOL**  
1616 EAST MILLBROOK ROAD, SUITE 160  
RALEIGH, NORTH CAROLINA 27609  
(919) 781-4626 VOICE (919) 781-4869 FAX  
NC License Number F-C105

FOR THE NORTH CAROLINA DEPARTMENT OF TRANSPORTATION

2006 METRIC STANDARD SPECIFICATIONS

RIGHT OF WAY DATE: MAY 31, 2006

LETTING DATE:

T.R. REID, P.E.  
PROJECT ENGINEER

T.E. HUFFMAN, P.E.  
PROJECT DESIGN ENGINEER

**HYDRAULICS ENGINEER**

**SDG**  
Sungate Design Group, P.A.  
Engineering - Landscape Architecture - Environmental  
915-A Jones Franklin Rd.  
Raleigh, N.C. 27605  
NC License Number C-0890

SIGNATURE:

**ROADWAY DESIGN ENGINEER**

**MOFFATT & NICHOL**  
1616 EAST MILLBROOK ROAD, SUITE 160  
RALEIGH, NORTH CAROLINA 27609  
(919) 781-4626 VOICE (919) 781-4869 FAX  
NC License Number F-C105

SIGNATURE:


**DIVISION OF HIGHWAYS  
STATE OF NORTH CAROLINA**

STATE HIGHWAY DESIGN ENGINEER


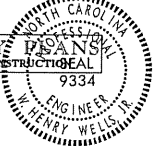

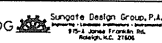
P.E.


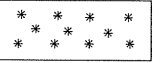
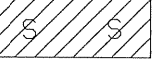
	PROJECT REFERENCE NO.	SHEET NO.
	2-0002-B	7
	R/W SHEET NO.	24 (2-0002C)
	ROADWAY DESIGN ENGINEER	HYDRAULICS ENGINEER
CONTRACT NO.		
R/W REV.		

NAD 83  
 NC GRID

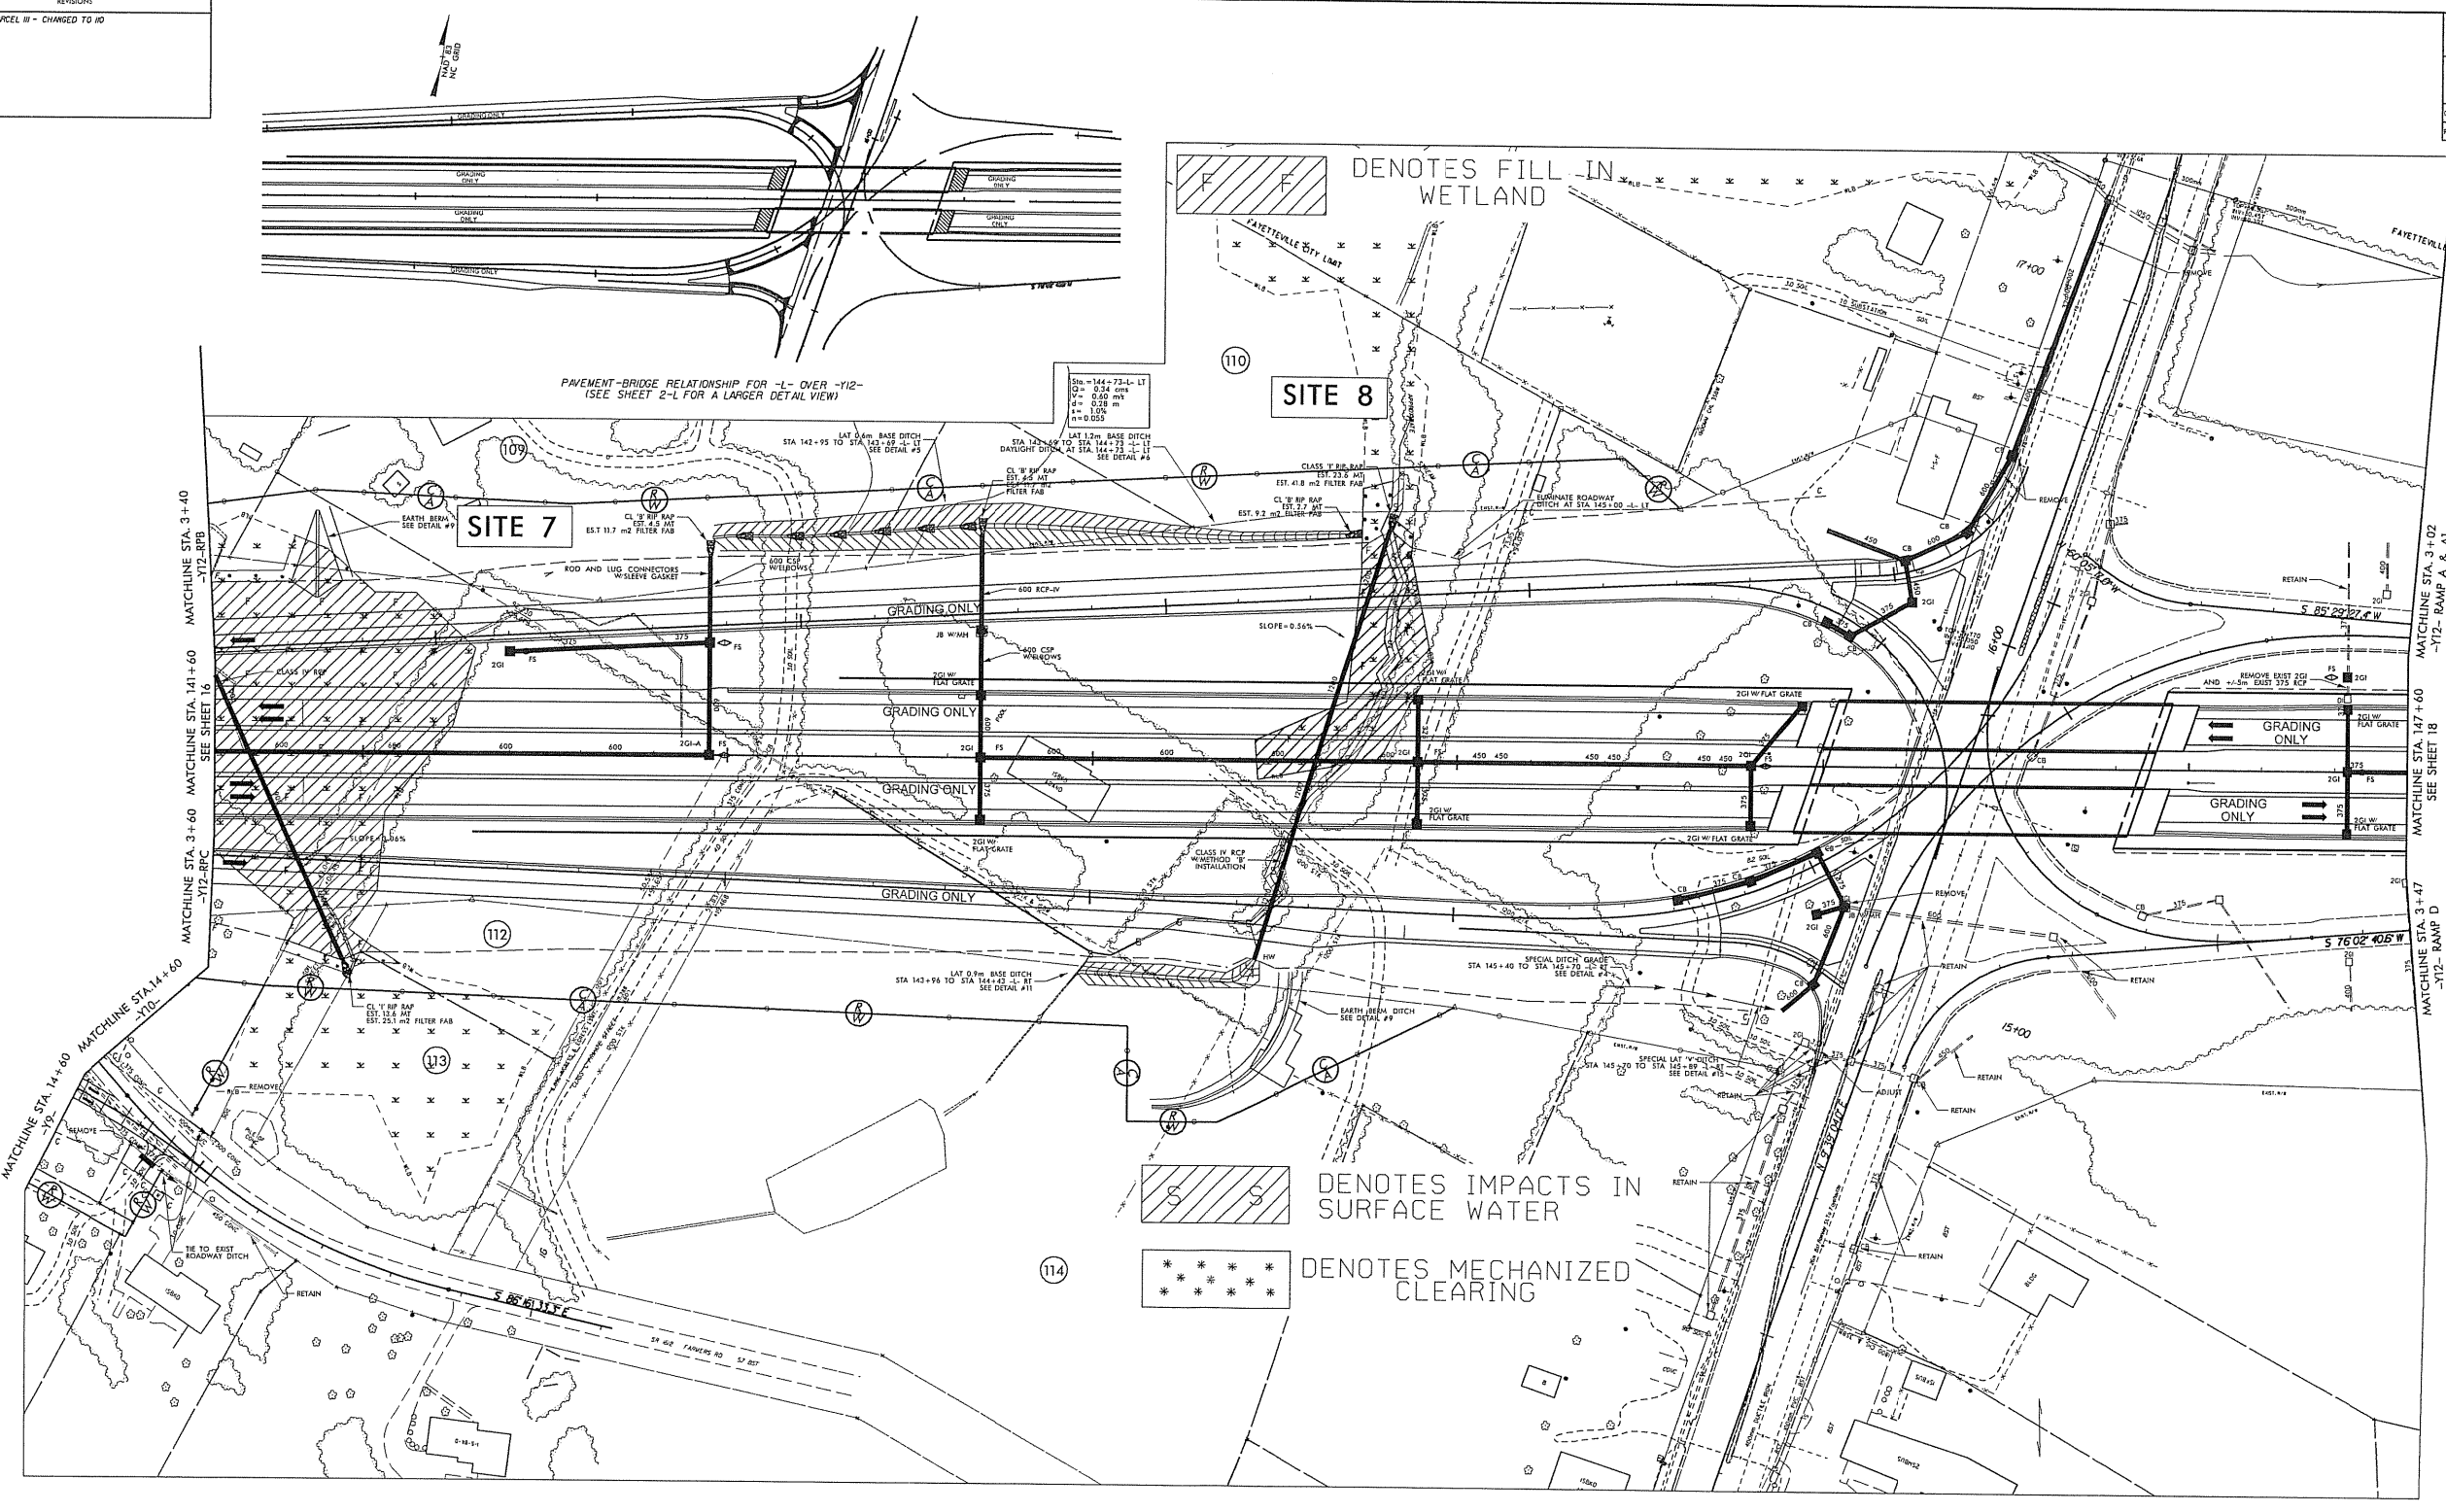

LOCATION:  
 US 401 RAMSEY STREET I-77-1  
 INTERCHANGE W/ OUTER LOOP (1-L-1)  
 RFP NO. 2-0002-B COUNTY: COMBEE  
 DESIGNED BY: T. J. RUPPEL DATE: 7/28/00  
 CHECKED BY: T. RUPPEL DATE: 7/28/00

PROJECT REFERENCE NO. X-0002CB		SHEET NO. BLOW UP	
R/W SHEET NO.			
ROADWAY DESIGN ENGINEER		HYDRAULICS ENGINEER	
			
CONST. REV.		R/W REV.	
			

 DENOTES FILL IN WETLAND  
 DENOTES MECHANIZED CLEARING  
 DENOTES IMPACTS IN SURFACE WATER

110

**SITE 8**


NAD 83  
 NC GRID

Sta. = 144+73-L- LT  
 $Q = 0.34 \text{ cms}$   
 $V = 0.60 \text{ m/s}$   
 $d = 0.28 \text{ m}$   
 $s = 1.0\%$   
 $n = 0.055$

LAT 0.6m BASE DITCH  
 STA 142+95 TO STA 143+69 -L- LT  
 SEE DETAIL #5  
 LAT 1.2m BASE DITCH  
 STA 143+69 TO STA 144+73 -L- LT  
 DAYLIGHT DITCH AT STA. 144+73 -L- LT  
 SEE DETAIL #6

CL 'B' RIP RAP  
 EST. 4.5 MT  
 EST. 11.7 m<sup>2</sup>  
 FILTER FAB  
 CLASS 'I' RIP RAP  
 EST. 23.6 MT  
 EST. 41.8 m<sup>2</sup>  
 FILTER FAB  
 CL 'B' RIP RAP  
 EST. 2.7 MT  
 EST. 9.2 m<sup>2</sup>  
 FILTER FAB


ELIMINATE ROADWAY  
 DITCH AT STA 145+00 -L- LT

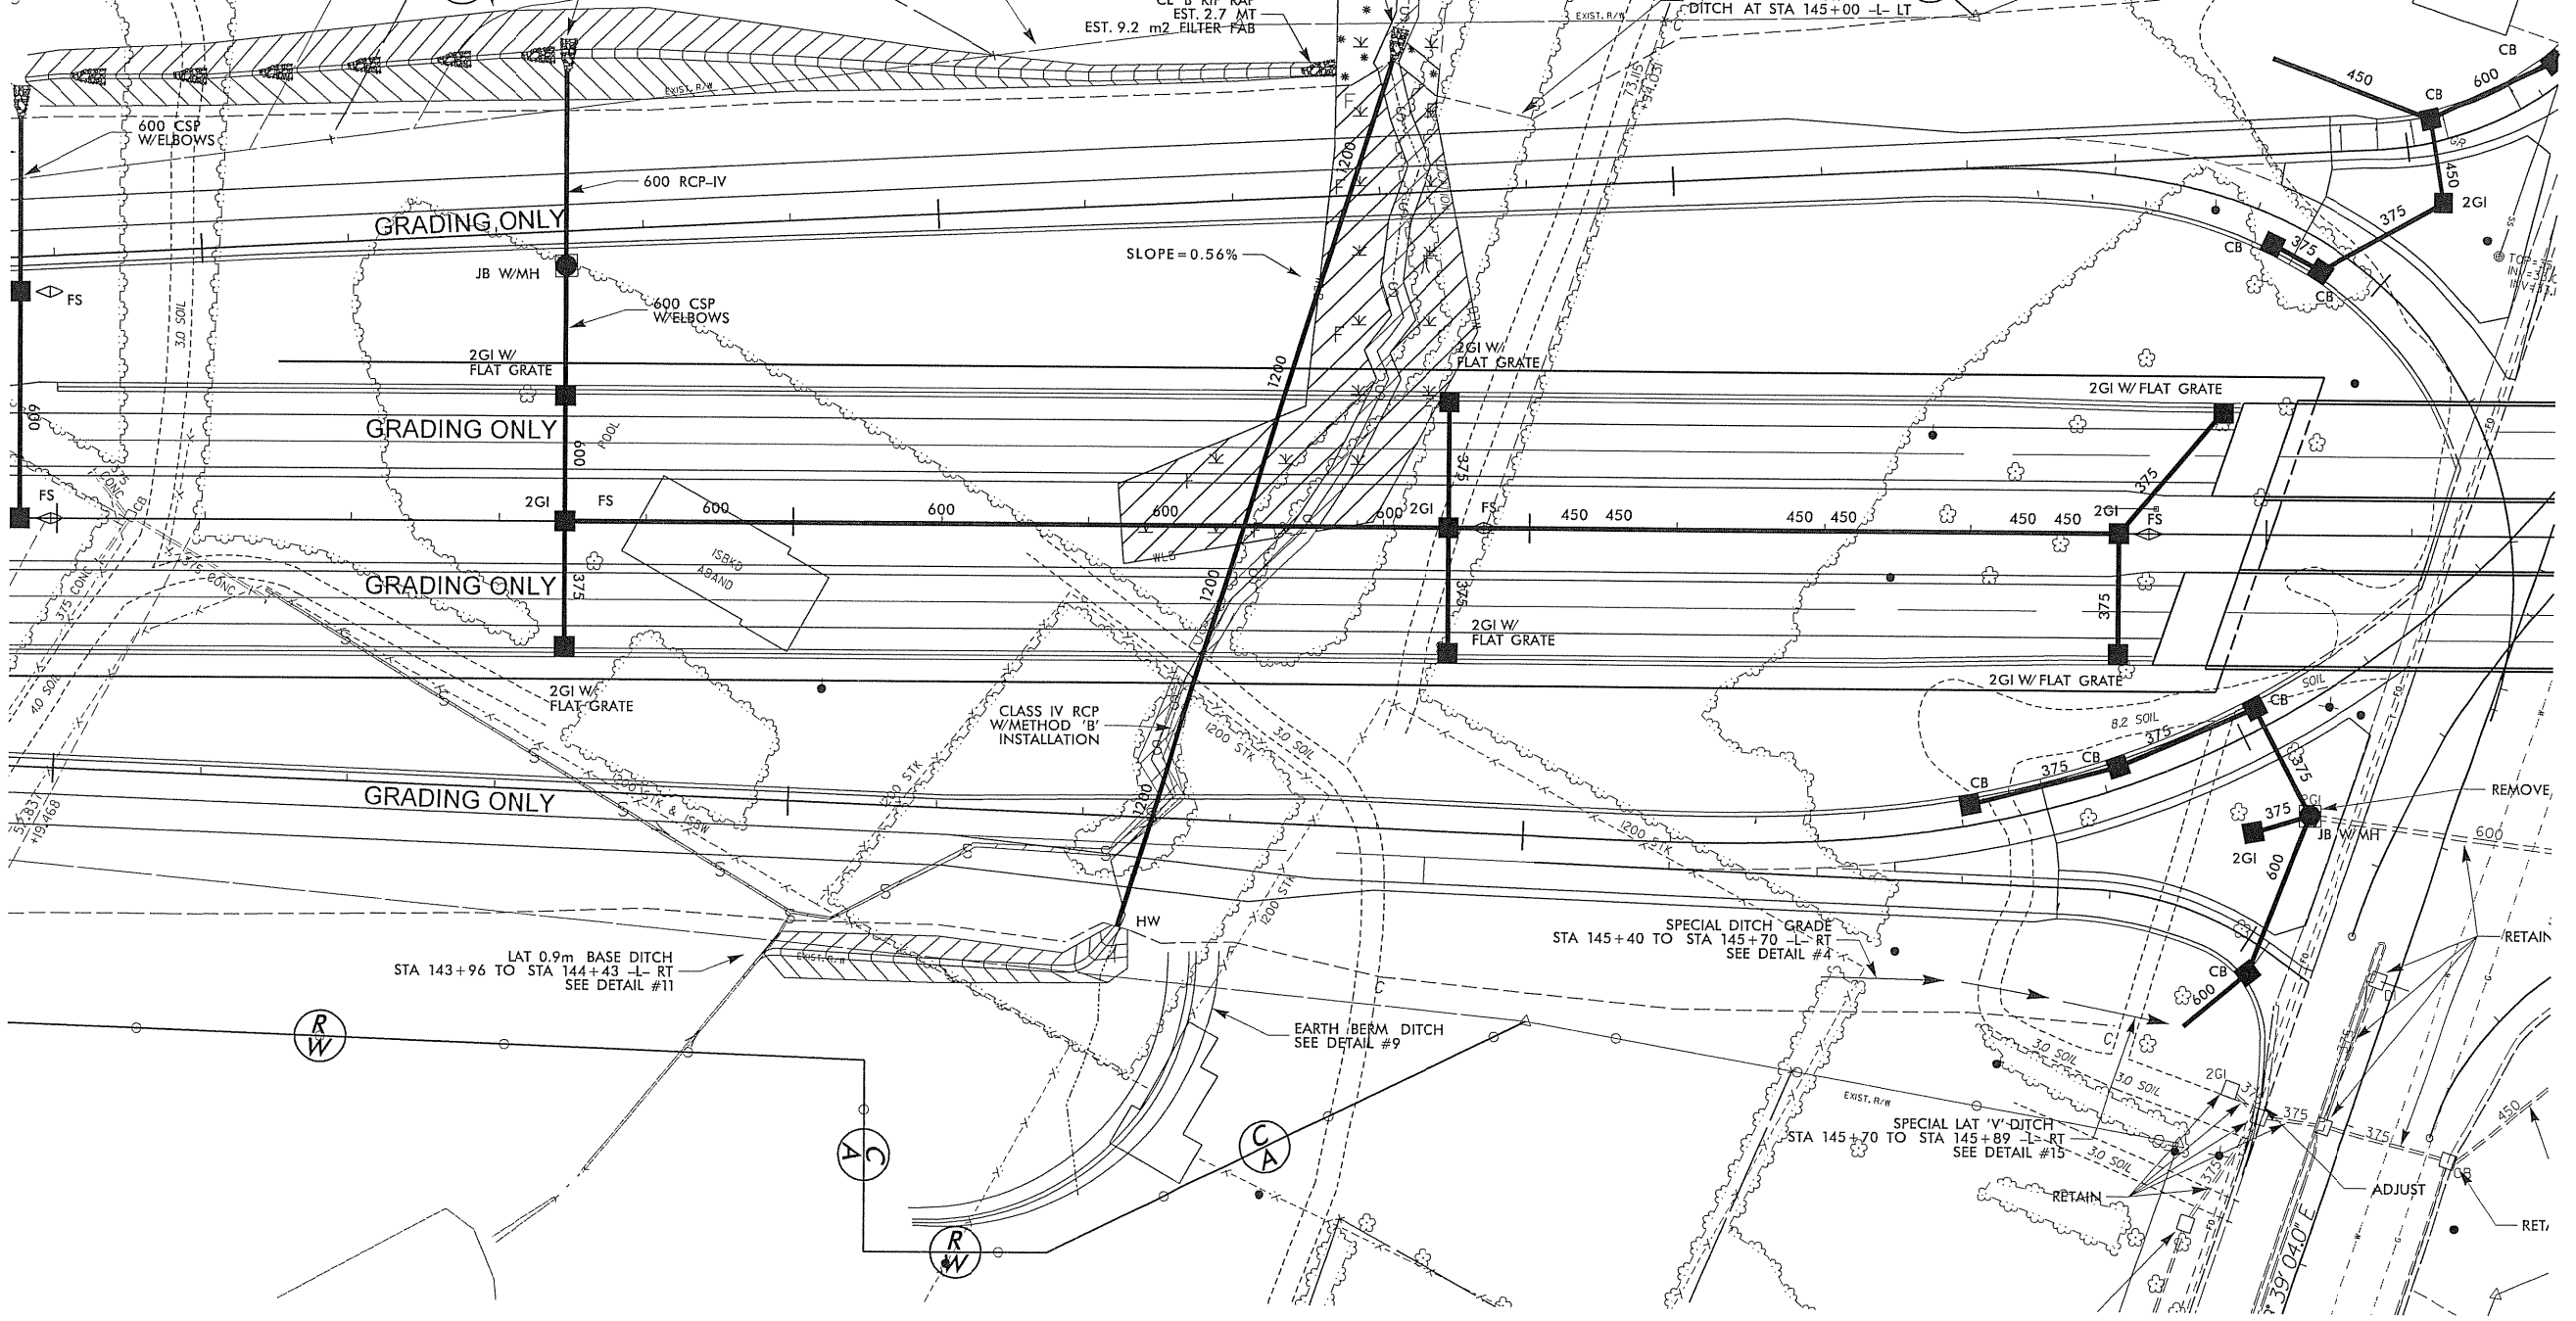


SYSTEM TIME  
 11/11/10 11:11 AM  
 11/11/10 11:11 AM



DATE: 07/25/2011

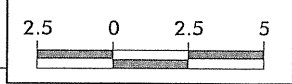

Permit Drawing  
Sheet 60 of 64  
REV. 7/25/11

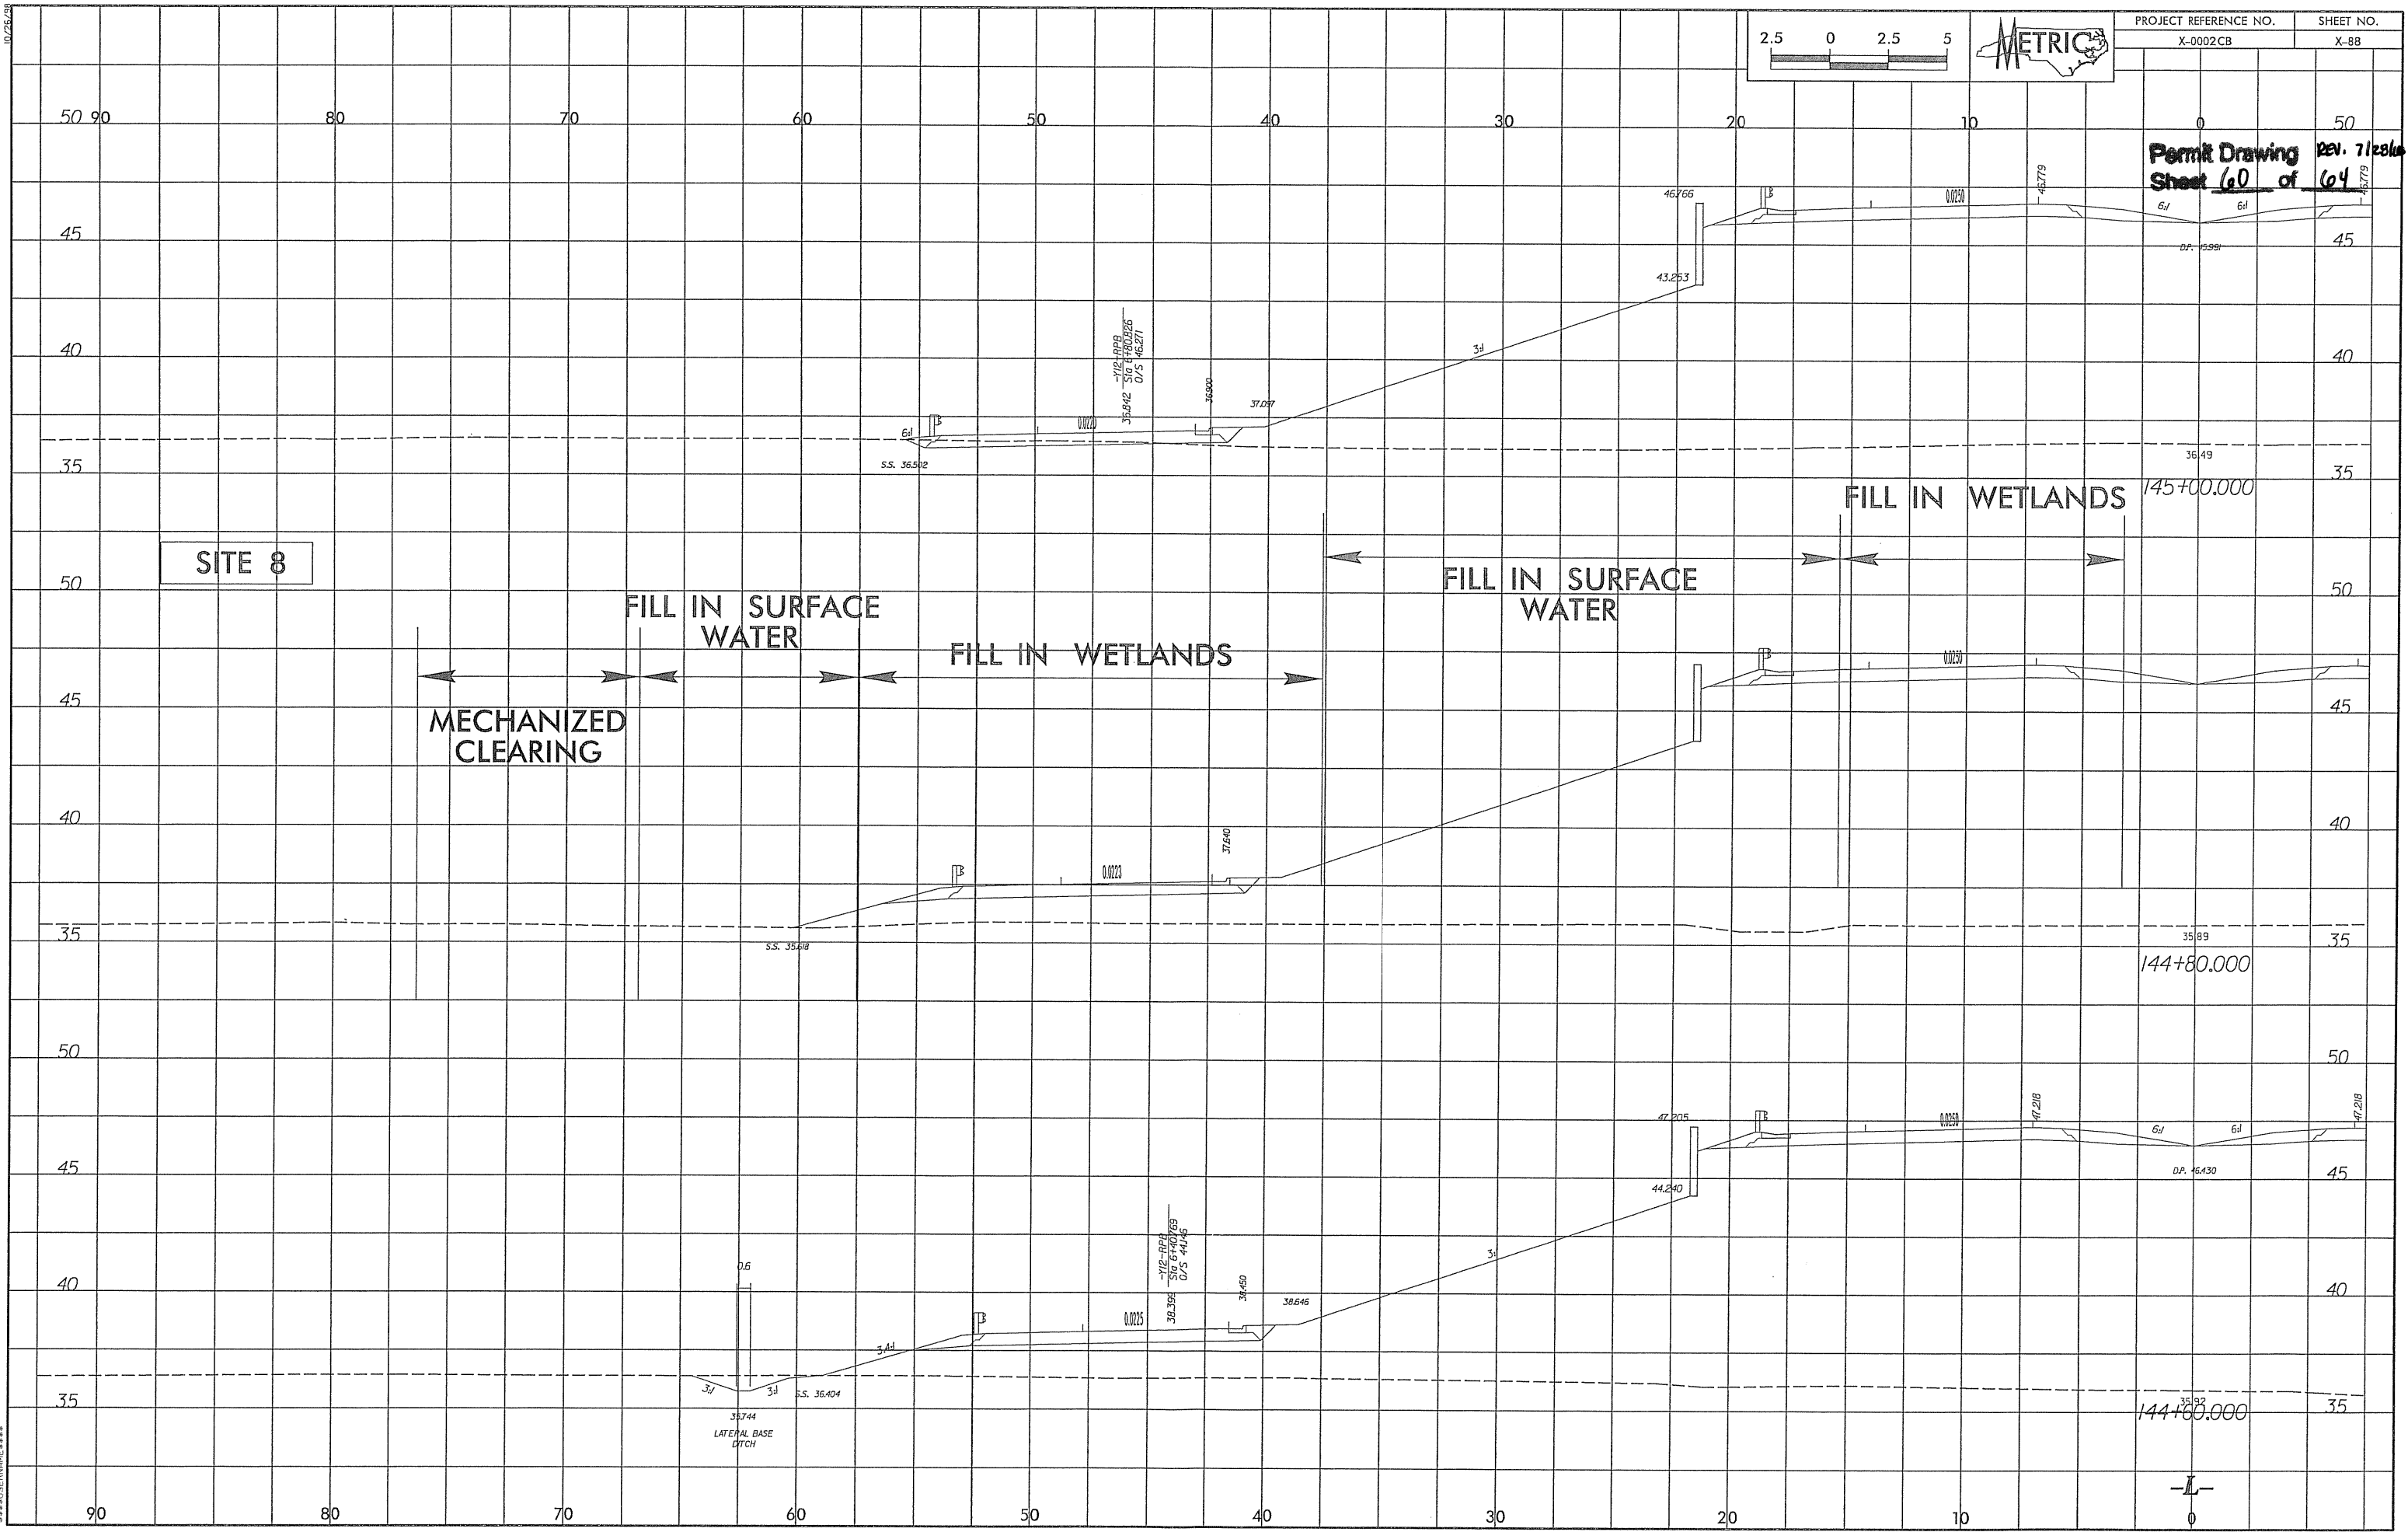

**SITE 8**

**MECHANIZED CLEARING**

**FILL IN SURFACE WATER**

**FILL IN WETLANDS**

**FILL IN SURFACE WATER**

**FILL IN WETLANDS**

144+80.000

144+60.000



PROJECT REFERENCE NO. I-77/2008/24  
SHEET NO. 24 (1-1000)  
ROADWAY DESIGN  
ENGINEER  
CONSULTANT  
DATE  
SCALE

TRAFFIC DIAGRAM

28,680 38,800	-Y12-	2008 ADT 2030 ADT
8,820 13,400	-L-	10040 13200
29,270 50,300	-Y12-	11,020 18,300
		28,810 49,400

TRAFFIC DIAGRAM

28,680 38,800	-Y12-	2008 ADT 2030 ADT
8,820 13,400	-L-	10040 13200
29,270 50,300	-Y12-	11,020 18,300
		28,810 49,400

TRAFFIC DIAGRAM

28,680 38,800	-Y12-	2008 ADT 2030 ADT
8,820 13,400	-L-	10040 13200
29,270 50,300	-Y12-	11,020 18,300
		28,810 49,400

TRAFFIC DIAGRAM



28,680 38,800	-Y12-	2008 ADT 2030 ADT
8,820 13,400	-L-	10040 13200
29,270 50,300	-Y12-	11,020 18,300
		28,810 49,400

TRAFFIC DIAGRAM

28,680 38,800	-Y12-	2008 ADT 2030 ADT
8,820 13,400	-L-	10040 13200
29,270 50,300	-Y12-	11,020 18,300
		28,810 49,400

FOR DITCH DETAILS SEE SHEET 2-L  
FOR INTERSECTION DETAILS SEE SHEET 2-18 2-  
FOR 1-1 PROFILE SEE SHEET 17 AND 18  
FOR 1-9 PROFILE SEE SHEET 12  
FOR 1-12-RPB PROFILE SEE SHEET 33 & 34  
FOR 1-12-RPB PROFILE SEE SHEET 35  
FOR 1-12-RPC PROFILE SEE SHEET 35  
FOR 1-12-RPD PROFILE SEE SHEET 35  
SEE S-1 THRU 5 FOR STRUCTURE PLANS  
SEE W-1 THRU W-5 FOR WALL PLANS

LOCATION:  
US 401 RAMPWAY STREET (I-77) INTERCHANGE W/ OUTER LOOP (I-17)  
SHEET NO. I-77/2008/24 COUNTY QUAMERLAND  
DESIGNED BY: T. REED, P.E. DATE: 1/28/08  
CHECKED BY: T. REED, P.E. DATE: 2/10/08

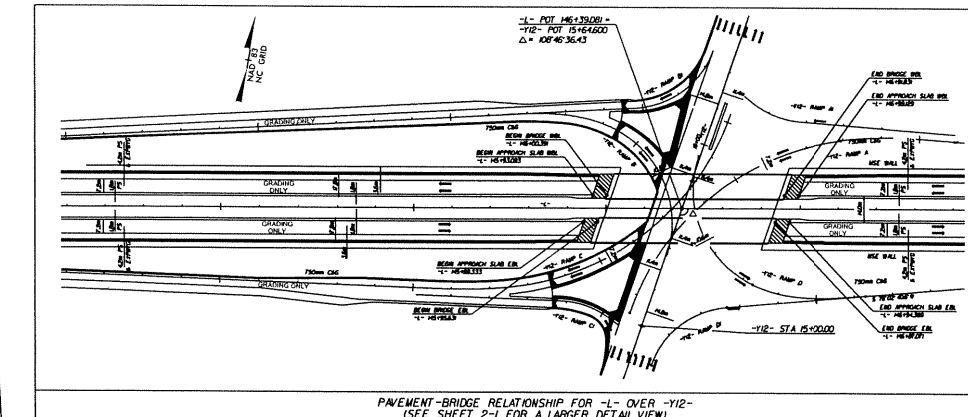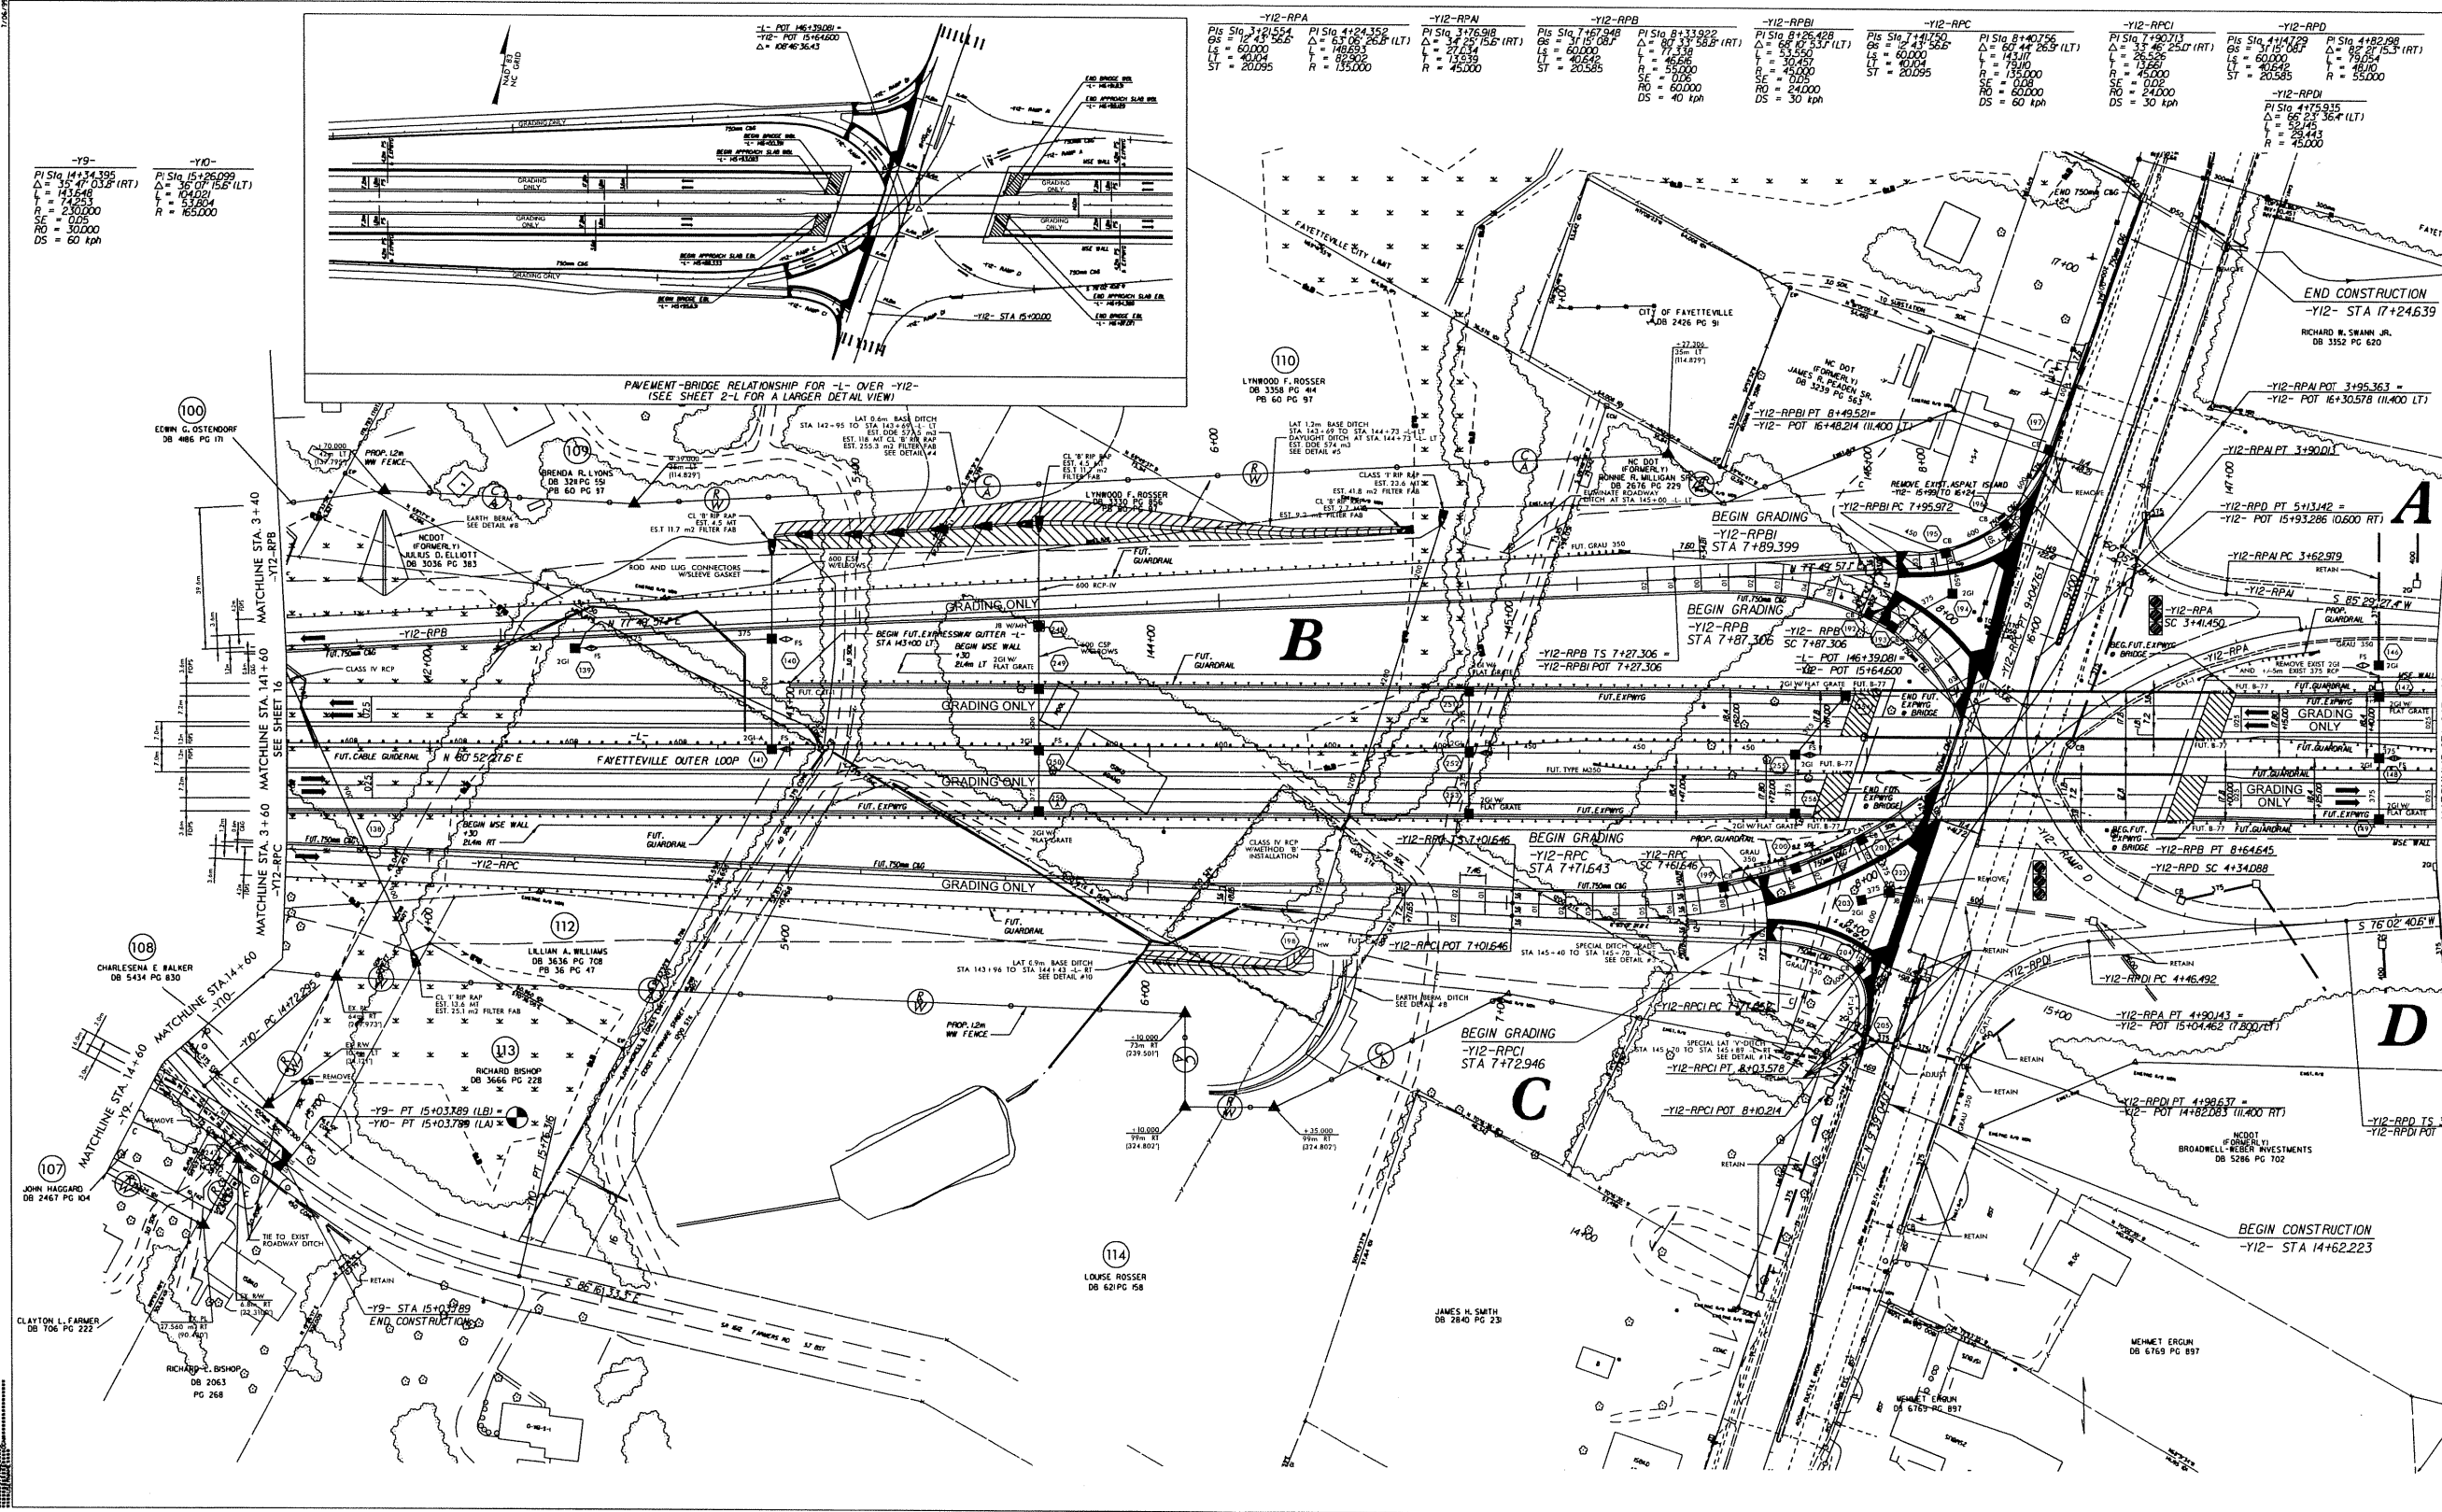

<b>-Y12-RPA</b> PI Sta. 3+21.554 OS = 12.45 L = 40.04 R = 20.995 ST = 20.995	<b>-Y12-RPA</b> PI Sta. 4+24.352 OS = 63.06 L = 88.92 R = 135.000	<b>-Y12-RPB</b> PI Sta. 7+67.948 OS = 31.15 L = 60.000 R = 40.000 ST = 20.585	<b>-Y12-RPB</b> PI Sta. 8+13.922 OS = 87.17 L = 7.138 R = 55.000 ST = 20.585	<b>-Y12-RPB</b> PI Sta. 8+26.428 OS = 88.52 L = 3.750 R = 45.000 ST = 20.585	<b>-Y12-RPC</b> PI Sta. 7+41.750 OS = 12.41 L = 60.000 R = 78.000 ST = 20.995	<b>-Y12-RPC</b> PI Sta. 8+40.756 OS = 14.11 L = 14.110 R = 135.000 ST = 20.995	<b>-Y12-RPC</b> PI Sta. 7+90.713 OS = 13.46 L = 26.25 R = 45.000 ST = 20.995	<b>-Y12-RPD</b> PI Sta. 4+14.729 OS = 31.15 L = 60.000 R = 45.000 ST = 20.585	<b>-Y12-RPD</b> PI Sta. 4+82.098 OS = 82.37 L = 98.674 R = 55.000 ST = 20.585
---	---	--	---	---	--	---	---	--	--

<b>-Y9-</b> PI Sta. 14+34.388 OS = 15.46 L = 143.648 R = 230.000 ST = 0.025 DS = 50.000 DS = 60 kph	<b>-Y10-</b> PI Sta. 15+26.099 OS = 36.07 L = 154.001 R = 165.000 ST = 0.025 DS = 50.000 DS = 60 kph
--	---

<b>-Y10-</b> PI Sta. 15+26.099 OS = 36.07 L = 154.001 R = 165.000 ST = 0.025 DS = 50.000 DS = 60 kph	<b>-Y11-</b> PI Sta. 16+19.000 OS = 15.46 L = 143.648 R = 230.000 ST = 0.025 DS = 50.000 DS = 60 kph
---	---

<b>-Y11-</b> PI Sta. 16+19.000 OS = 15.46 L = 143.648 R = 230.000 ST = 0.025 DS = 50.000 DS = 60 kph	<b>-Y12-</b> PI Sta. 17+24.639 OS = 15.46 L = 143.648 R = 230.000 ST = 0.025 DS = 50.000 DS = 60 kph
---	---

<b>-Y12-</b> PI Sta. 17+24.639 OS = 15.46 L = 143.648 R = 230.000 ST = 0.025 DS = 50.000 DS = 60 kph	<b>-Y13-</b> PI Sta. 18+20.279 OS = 15.46 L = 143.648 R = 230.000 ST = 0.025 DS = 50.000 DS = 60 kph
---	---

<b>-Y13-</b> PI Sta. 18+20.279 OS = 15.46 L = 143.648 R = 230.000 ST = 0.025 DS = 50.000 DS = 60 kph	<b>-Y14-</b> PI Sta. 19+25.919 OS = 15.46 L = 143.648 R = 230.000 ST = 0.025 DS = 50.000 DS = 60 kph
---	---

<b>-Y14-</b> PI Sta. 19+25.919 OS = 15.46 L = 143.648 R = 230.000 ST = 0.025 DS = 50.000 DS = 60 kph	<b>-Y15-</b> PI Sta. 20+21.559 OS = 15.46 L = 143.648 R = 230.000 ST = 0.025 DS = 50.000 DS = 60 kph
---	---

<b>-Y15-</b> PI Sta. 20+21.559 OS = 15.46 L = 143.648 R = 230.000 ST = 0.025 DS = 50.000 DS = 60 kph	<b>-Y16-</b> PI Sta. 21+27.199 OS = 15.46 L = 143.648 R = 230.000 ST = 0.025 DS = 50.000 DS = 60 kph
---	---

<b>-Y16-</b> PI Sta. 21+27.199 OS = 15.46 L = 143.648 R = 230.000 ST = 0.025 DS = 50.000 DS = 60 kph	<b>-Y17-</b> PI Sta. 22+22.839 OS = 15.46 L = 143.648 R = 230.000 ST = 0.025 DS = 50.000 DS = 60 kph
---	---

<b>-Y29-</b> PI Sta. 34+00.519 OS = 15.46 L = 143.648 R = 230.000 ST = 0.025 DS = 50.000 DS = 60 kph	<b>-Y30-</b> PI Sta. 35+06.159 OS = 15.46 L = 143.648 R = 230.000 ST = 0.025 DS = 50.000 DS = 60 kph
---	---