



STATE OF NORTH CAROLINA  
DEPARTMENT OF TRANSPORTATION

ROY COOPER  
GOVERNOR

J. ERIC BOYETTE  
SECRETARY

November 24, 2020

U.S. Army Corps of Engineers  
3331 Heritage Trade Drive, Suite 105  
Wake Forest, NC 27587-4346

ATTN: Mr. Monte Matthews  
NCDOT Coordinator

**Subject: Request for Modification to Section 404 Individual Permit and Section 401 Water Quality Certification** for the I-40/I-77 interchange improvements including I-40 from west of SR 2003 (Radio Road) to SR 2158 (Old Mocksville Road) and I-77 from south of SR 2321 (East Broad Street) to south of SR 2171 (Jane Sowers Road) in Iredell County. Division 12, TIP No. I-3819B. Debit \$570.00 from WBS 34192.3.2.

**References:** 1) Section 404 Individual Permit, Action ID No. SAW-2018-01504, issued January 21, 2020; 2) Section 401 Water Quality Certification No. WQC004203, NCDWR Project No. 20191006, issued November 19, 2019 and revised January 30, 2020.

Dear Sir:

The purpose of this letter is to request a modification to the United States Army Corps of Engineers (USACE) Section 404 Individual Permit and associated North Carolina Division of Water Resources (NCDWR) Section 401 Water Quality Certification for the above referenced project. This request letter includes a variance request for specific cross-pipes that will not be embedded, revisions to the drainage design, and modifications to permitted impacts.

A variance is requested for cross-pipes which will not be set below the elevation of the streambed. This relates directly to General Condition 1/Project Specific Condition 8 of the 401 Water Quality Certification. A list of the applicable locations, and justification for the variance request at each location is provided on the following page (Table 1).

*Mailing Address:*  
NC DEPARTMENT OF TRANSPORTATION  
ENVIRONMENTAL ANALYSIS UNIT  
1598 MAIL SERVICE CENTER  
RALEIGH, NC 27699-1598

*Telephone:* (919) 707-6000  
*Fax:* (919) 250-4224  
*Customer Service:* 1-877-368-4968

*Website:* [ncdot.gov](http://ncdot.gov)

*Location:*  
1000 BIRCH DRIVE  
RALEIGH, NC 27610

**Table 1. Description of cross-pipe locations for the variance request.**

<b>Location</b>	<b>Permit Site</b>	<b>Size</b>	<b>Type</b>	<b>Reason for Variance Request</b>
Y_S 37+39	16, 17	54" Reinforced Concrete Pipe and 42" Welded Steel Pipe	Supplement and Extend existing (US and DS)	The existing cross pipe is not embedded below the stream elevation. Due to this existing configuration, the pipe will be lined, but not embedded. The existing pipe will be supplemented with a 42" welded steel pipe via bore and jack set 1 foot higher than existing pipe.
Y_S 46+51	18, 19	54" Reinforced Concrete Pipe	Extension (US and DS)	The existing cross pipe will be extended and the replacement pipe will connect to a closed drainage network. As such, there will be no jurisdictional features upstream of this pipe, and it cannot be set below the streambed due to the configuration as a closed network.
Y_S 71+00	21, 22	3 @ 9' X 11' Reinforced Concrete Box Culvert	Extension (US and DS)	The existing culvert is not embedded below the stream bed elevation. Due to this existing configuration, and the need to satisfy FEMA floodplain requirements, it is not feasible to embed the proposed extension.
Y_S 94+06	24, 25	66" Reinforced Concrete Pipe	Extension (US and DS)	The existing cross pipe is not embedded below the stream elevation. Due to this existing configuration, and the installation of junction boxes to tie in adjacent drainage networks, it is not feasible to embed the proposed extension.
Y_N 211+51	27	60" Reinforced Concrete Pipe	Extension (DS only)	The existing cross pipe is not embedded below the stream elevation. Due to this existing configuration, and the proposed extension on only the downstream end, it is not feasible to embed the proposed extension.

Revisions resulting in changes to permitted impacts have been made to nine impact sites (Sites 2, 5, 16, 17, 19, 21, 22, 23, and 25) and are discussed in detail below. Three new impact sites are also discussed below (Sites 9A, 28, and U-4).

In addition, permitted impact Sites 9 (Permit Drawing Sheet 10 through 13) and 27 (Permit Drawing Sheets 62 through 65) are included in the revised permit drawings to highlight the changes to the drainage design from previously approved permit drawings. At Utility Site U-2, the replacement transmission tower in this location, which was originally proposed to be a metal lattice structure with four 4'x4' concrete footings, was altered to instead be a single steel 56" diameter pole (Utility Permit Drawing Sheets 4 through 7). The design changes at Sites 9, 27, and Utility Site U-2 will not result in any additional changes to the amount, type, or location of previously permitted impacts and are not discussed further.

Previously permitted stream impacts included 3,194 linear feet of permanent stream impacts (which includes 1,019 linear feet of stream bank stabilization) and 394 linear feet (0.07 acre) of temporary stream impacts. Previously permitted wetland impacts for roadway construction included 1.39 acres of permanent wetland impacts (1.06 acres of permanent fill and 0.33 acre of mechanized clearing) and 2.56 acres of hand clearing in wetlands. Previously permitted impacts associated with utilities included 0.02 acre of mechanized clearing and 0.27 acre of temporary wetland fill impacts (permanent fill in wetlands and hand clearing impacts were <0.01 acre). The total permanent wetland impacts previously permitted for roadway construction and utilities was 1.41 acres.



The revised stream impacts for the project total 3,213 linear feet of permanent stream impacts (which includes 1,047 linear feet of stream bank stabilization impacts) and 471 linear feet (0.10 acre) of temporary stream impacts. The revised wetland impacts for roadway construction include 1.39 acres of permanent wetland impacts (1.06 acres of permanent fill and 0.33 acre of mechanized clearing), and 2.66 acre of temporary fill in wetlands impacts. The revised utilities impacts included 0.16 acre of mechanized clearing and 0.27 acre of temporary wetland fill impacts (permanent fill in wetlands and hand clearing impacts were <0.01 acre). The revised total permanent wetland impacts proposed for roadway construction and utilities is 1.55 acres.

This modification will result in 0.14 acre of additional mechanized clearing impacts, 2.66 acres of additional temporary wetland fill impacts, 28 linear feet of additional stream bank stabilization impacts, and 77 linear feet (0.02 acre) of additional temporary stream impacts. There will be 2.56 acres less hand clearing impacts and 9 linear feet less permanent channel impacts than previously permitted. A summary of the changes is shown in Table 2 below.

**Table 2 – Summary of changes to impacts\***

<b>Impact Type</b>	<b>Original Permitted Impacts</b>	<b>Proposed Permit Modification</b>	<b>Difference</b>
<b>Roadway Impacts</b>			
Permanent Stream Impacts <sup>1</sup>	3,194	3,213	+19
<i>Bank Stabilization Impacts</i>	<i>1,019</i>	<i>1,047</i>	<i>+28</i>
Temporary Stream Impacts	394	471	+77
Permanent Wetland Fill	1.06	1.06	0
Mechanized Clearing in Wetlands	0.33	0.33	0
Hand Clearing in Wetlands	2.56	0	-2.56
Temporary Wetland Fill	0	2.66	+2.66
<b>Utility Impacts</b>			
Permanent Wetland Fill	< 0.01	< 0.01	0
Mechanized Clearing in Wetlands	0.02	0.16	+0.14
Hand Clearing in Wetlands	< 0.01	< 0.01	0
Temporary Wetland Fill	0.27	0.27	0

\*Stream impacts are in linear feet. Wetland impacts are in acres.

<sup>1</sup>Totals include bank stabilization impacts. Permanent stream impacts requiring mitigation decreased by 9 linear feet.

Please see the enclosed DWR Pre-Filing Meeting Request Form, revised DMS acceptance letter, revised permit drawings, and revised roadway plans where drainage revisions and/or field changes resulted in changes to permitted impacts. Note the three additional impact sites: Sites 9A and 28 are included in the revised roadway permit drawings and Utility Site U-4 is shown in the revised utility permit drawing. Permit impact sites where no changes were made to the drainage design or impacts are not included in the revised permit drawings. All changes to previously permitted impacts and the three additional impact sites are summarized below.

### **Summary of Impacts to Waters of the U.S.**

Tables 3 through 5 summarize the permitted and revised impacts to jurisdictional water resources for the project. Changes to permitted impacts are shown with a strikethrough and revisions are shown in red text. A narrative describing the revisions made to each permit impact site are presented in the following section.

**Table 3 – I-3819B Wetland Impacts\***

Permit Site	Wetland Number	Wetland Size ac	Permanent Fill in Wetlands ac	Temporary Fill in Wetlands <sup>1</sup> ac	Mechanized Clearing ac	Hand Clearing ac	Impacts Requiring Mitigation ac
2	WC	2.94	0.32		0.09	--	0.41
2	WC/WD	2.94/9.57	0.02	0.62	0.02	<del>0.62</del>	0.05
3	WF	0.31	<0.01		0.01	--	0.02
4	WD	9.57	--		0.02	--	0.02
5	WD	9.57	0.03	2.04	0.05	<del>1.94</del>	0.09
8	WH	0.08	<0.01		<0.01	--	0.01
9	WK	1.20	0.40		0.08	--	0.47
11	WAN	0.21	0.19		0.02	--	0.21
26	WI	0.13	0.09		0.04	--	0.13
<b>Total Wetland Impacts</b>			<b>1.06<sup>1</sup></b>	<b>2.66</b>	<b>0.33<sup>1</sup></b>	<b><del>2.56</del> 0</b>	<b>1.39<sup>2</sup></b>

\*All wetlands impacted are riparian

<sup>1</sup>Temporary fill impacts will result from the use of mats and crane barges

<sup>2</sup>Values are based on rounding, due to calculating totals with actual numbers to the thousandths

**Table 4 – I-3819B Stream Impacts**

Permit Site	Stream Name/ NRTR ID	Status/ Class	Permanent		Temporary Channel Impacts ac (lf)	USACE Required Mitigation lf	NCDWR Required Mitigation lf
			Channel Impacts lf (ac)	Bank Stabilization lf (ac)			
2	UT to Fourth Creek SJ	Perennial C	--	42 (<0.01)	<0.01 (20)	--	--
3	UT to Fourth Creek SI	Perennial C	206 (0.02)	--	<0.01 (10)	206	--
5	UT to Fourth Creek SJ	Perennial C	--	--	<del>&lt;0.01 (40)</del> 0.02 (77)	--	--
6	Fourth Creek	Perennial C	--	12 (<0.01)	<0.01 (20)	--	--
7	Fourth Creek	Perennial C	--	12 (<0.01)	<0.01 (20)	--	--
9	UT to Fourth Creek SL	Perennial C	747 (0.07)	--	<0.01 (10)	747	747
9A	UT to Fourth Creek SK	Perennial C	--	--	0.01 (50)	--	--
10	UT to Fourth Creek SK	Perennial C	--	25 (<0.01)	<0.01 (20)	--	--
12	UT to Fourth Creek SK	Perennial C	10 (<0.01)	--	0.01 (54)	10	--
13	UT to Fourth Creek SL	Perennial C	17 (<0.01)	44 (<0.01)	<0.01 (10)	17	17

**Table 4 – I-3819B Stream Impacts (continued)**

Permit Site	Stream Name/ NRTR ID	Status/ Class	Permanent		Temporary Channel Impacts ac (lf)	USACE Required Mitigation lf	NCDWR Required Mitigation lf
			Channel Impacts lf (ac)	Bank Stabilization lf (ac)			
14	UT to Fourth Creek SX	Intermittent C	17 (<0.01)	--	<0.01 (10)	17	--
15	UT to Fourth Creek SX	Intermittent C	--	11 (<0.01)	<0.01 (20)	--	--
16	UT to Fourth Creek SX	Intermittent C	<del>112</del> <del>(0.01)</del> 113 (0.01)	--	<0.01 (10)	<del>112</del> 113	--
17	UT to Fourth Creek SX	Perennial C	<del>115</del> 114 (0.02)	--	<0.01 (14)	<del>115</del> 114	--
18	UT to Fourth Creek SW	Perennial C	72 (0.01)	--	<0.01 (10)	72	--
19	UT to Fourth Creek SW	Perennial C	34 (<0.01)	--	--	34	--
20	UT to Fourth Creek SBA	Perennial C	61 (0.01)	--	<0.01 (10)	61	--
21	UT to Fourth Creek ST	Perennial C	176 <del>(0.06)</del> (0.10)	--	<0.01 (21)	176	176
22	UT to Fourth Creek ST	Perennial C	<del>467</del> <del>(0.14)</del> 455 (0.18)	<del>873</del> <del>(0.23)</del> 901 (0.34)	<del>&lt;0.01</del> <del>(10)</del>	467 455	467 455
23	UT to Fourth Creek ST	Perennial C	--	--	<0.01 (33)	--	--
24	UT to Fourth Creek SU	Perennial C	49 (<0.01)	--	0.01 (10)	49	--
25	UT to Fourth Creek SU	Perennial C	<del>44</del> <del>(0.01)</del> 31 (<0.01)	--	<del>&lt;0.01</del> <del>(32)</del> <0.01 (21)	44 31	--
27	UT to Fourth Creek SR	Perennial C	48 (0.01)	--	<0.01 (10)	48	--
28	UT to Beaver Creek SO	Perennial C	16 (<0.01)	--	<0.01 (11)	16	--
Total Stream Impacts			2175 2166	1019 1047	0.07* (394)	2175 2166	1407 1395
			3194 3213		0.10* (471)		

\* Values are based on rounding

**Table 5 – I-3819B Utility Wetland Impacts**

Permit Site	Wetland ID	Impact Type	Temporary Impacts ac	Permanent Fill ac	Mechanized Clearing ac	Hand Clearing ac	Mitigation Requirement ac
U-1	WJ	Utility	0.02	--	--	--	--
U-2	WD	Utility	0.25	<0.01	0.02	--	0.02
U-3	WH	Utility	--	--	--	<0.01	--
U-4	WU	Utility	--	--	0.14	--	0.14
<b>TOTAL IMPACTS</b>			<b>0.27</b>	<b>&lt;0.01</b>	<del>0.02</del> <b>0.16</b>		<del>0.02</del> <b>0.16</b>

**Permit Impact Site Modifications (shown in revised permit drawings):**

Site 2 (Permit Drawing Sheet 2) – Although hand clearing occurred within the approved permitted boundaries in wetland WC, the 0.62 acre of hand clearing impacts in wetlands have been revised to temporary fill in wetlands to account for impacts associated with the use of timber mats and crane barges during construction.

Site 5 (Permit Drawing Sheet 46) – This site has been updated to incorporate unauthorized impacts to wetland WD and stream SJ that occurred inadvertently during construction. The 40 linear feet of permitted temporary stream impacts to stream SJ on the east side of the bridge alignment have been eliminated because the temporary pipe was not needed. However, there were 77 linear feet of unauthorized temporary stream impacts to stream SJ. Therefore, temporary stream impacts increased from 40 linear feet to 77 linear feet, which is 37 linear feet of additional temporary stream impacts. There are no permanent stream impacts proposed for this site.

Permitted hand clearing impacts have been converted to temporary wetland fill impacts in areas where mats and barges are being used during construction. In addition, 0.10 acre of temporary wetland fill outside of previously permitted hand clearing impacts were added to account for the unauthorized temporary impacts within wetland WD. Impacts for hand clearing in wetlands decreased from 1.94 acres to 0 acre, and 2.04 acres of temporary wetland fill impacts are now included. There will be no additional permanent impacts at this location.

On-site restoration was performed to mitigate for the unauthorized impacts that included 0.23 acre of temporary impacts to wetland WD (0.10 acre were outside of previously permitted hand clearing impacts) and 77 linear feet of temporary impacts to stream SJ. To restore the areas, the stream banks and a section of wetland WD were regraded and stabilized with erosion control matting. Native grass seeding and mulching were used for all temporarily impacted wetland areas and stream banks. On June 3, 2020, Lane Construction met on-site with Donna Hood with NCDWR and Matthew Evans with NCDOT to inspect the restoration areas and review the progress of restoration activities. A response to the Notice of Deficiency and the wetland restoration plan for the unauthorized impacts were submitted on June 25, 2020 to NCDWR and was accepted by NCDWR and USACE on June 30, 2020 as indicated through coordination with Donna Hood.

Site 16 (Permit Drawing Sheet 26) – Similar to the previous design, the impacts to stream SX at this site are due to the extension and supplement of an existing 54” reinforced concrete pipe (RCP) cross pipe. However, the pipe is now proposed to be lined. Otherwise there are no significant variations to the proposed design. Due to minor adjustments to the slope stake and headwall

configuration the impacts resulting from the pipe extension have increased from 13 linear feet to 15 linear feet, which is 2 feet of additional impacts. The permanent impacts due to bed stabilization have decreased from 99 linear feet to 98 linear feet. Overall, there is 1 foot of additional permanent stream impacts being proposed at this site compared to the previously permitted impacts. The design change will not result in any additional temporary stream impacts at this location.

Site 17 (Permit Drawing Sheet 26) – Similar to Site 16, the impacts at this site are due to extension and supplement of an existing 54” RCP cross pipe. However, the pipe is now proposed to be lined. Otherwise there are no significant variations to the proposed design. Due to minor adjustments to the slope stake and headwall configuration, the impacts resulting from the pipe extension have increased by 3 linear feet from 17 linear feet to 20 linear feet. The permanent impacts due to bed stabilization have decreased from 98 linear feet to 94 linear feet. Overall, there is 1 foot less of permanent stream impacts being proposed at this site compared to the previously permitted impacts. The design change will not result in any additional temporary stream impacts at this location.

Site 19 (Permit Drawing Sheet 26) – The design proposes to extend the existing 54” RCP and cover the existing stream channel with the roadway fill slope. The originally permitted permanent stream impacts were misclassified as 54” RCP extension and have been updated as roadway fill. The reclassification of impact type will not result in any additional permanent stream impacts at this location.

Site 21 (Permit Drawing Sheet 30) – There will be no changes to the design or proposed activities at this site from the approved permit; however, the jurisdictional stream boundaries of stream ST have been revised to more accurately follow the surveyed topographic contours. This revision will not result in any changes to the linear feet of permanent and temporary stream impacts. The total acreage of permanent stream impacts increased from 0.08 acre to 0.10 acre as a result of the revised jurisdictional stream boundary; temporary stream impacts will remain <0.01 acre.

Site 22 (Permit Drawing Sheet 30) – The jurisdictional stream boundaries of stream ST have been revised from those shown in the approved permit to more accurately follow the surveyed topographic contours. This revision will not result in any changes to the linear feet of permanent stream impacts for Site 22. Other revisions to impacts at Site 22 are as follows: in the approved permit, the permanent stream bed stabilization impacts were incorrectly calculated to extend 12 linear feet outside of the riprap in stream ST for the pipe outlet channel stabilization located at Station Number 83+85+00-Y. Also, in this location the permanent stream bank stabilization impacts should have been extended to the end of the riprap shown on the stream bank immediately adjacent to the channel, therefore the permit drawings have been revised to show an additional 16 linear feet of permanent stream bank stabilization impacts. Permanent stream bed impacts will decrease from 467 linear feet to 455 linear feet and bank stabilization impacts will increase from 873 linear feet to 901 linear feet. The previously approved 10 linear feet of temporary stream impacts were no longer needed and have been removed.

Site 23 (Permit Drawing Sheet 30) – There will be no changes to the design or proposed activities at this site from the approved permit; however, the jurisdictional stream boundaries of stream ST have been revised to more accurately follow the surveyed topographic contours. This revision will not result in any changes to the linear feet or acreage of temporary stream impacts at this location.

Site 25 (Permit Drawing Sheet 37) – In the approved permit, the drainage design included retaining an existing 15” RCP and connecting it to an existing 66” RCP, which carries stream SU, through a series of two junction boxes. The revised design includes replacing the 15” RCP and extending the pipe to discharge directly to stream SU instead of connecting to the existing 66” RCP. This revision will not result in any additional impacts.

Also, the detention basin shown in the original design impacting stream SU has been removed. The depth to the water table and proximity to the adjacent floodplain made the construction and operation of the detention basin infeasible. Permanent stream impacts decreased from 44 linear feet to 31 linear feet, which is a 13 linear foot decrease in impacts. Temporary stream impacts will decrease from 32 linear feet to 21 linear feet, which is an 11 linear foot decrease in impacts.

**New Permit Impact Sites (shown in revised permit drawings):**

Site 9A (Permit Drawing Sheet 11 and 14) – At this site, a temporary work bridge that spans from top of bank to top of bank was installed for construction access to Site 9. In the approved permit, no impacts were included for the temporary work bridge, however, impacts have been revised to include 50 linear feet (0.01 acre) of temporary stream impacts to account for any temporary impacts to stream SK that may occur as a result of the temporary work bridge. There will be no permanent stream impacts at this location.

Site 28 (Permit Drawing Sheet 21a) – This site was added after it was determined the end of the existing 42” RCP outfall was structurally deficient and in need of replacement. The replacement of this section of pipe and installation of riprap outlet protection requires impacts to stream SO. At the outlet of the replacement pipe, Class I riprap will be installed in the stream bed and along the banks of stream SO for stabilization. The existing outlet in this location is perched which is being addressed through the use of a manhole drop structure in order to lower the proposed outlet to the streambed elevation. This will result in 16 linear feet of permanent stream impacts and 11 linear feet of temporary stream impacts that were not previously permitted.

Utility Site U-4 (Utility Permit Drawing Sheet 3a) – During the construction of an access road for City of Statesville Power’s 334 circuit relocation work, the contractor inadvertently allowed clearing in wetland WU. This activity resulted in 0.14 acre of mechanized clearing impacts to wetland WU. The cleared wetland has been replanted with wetland seed mix following NCDOT’s Roadside Environmental Unit guidance and standard procedures. The revised utility permit drawings and summary table have been updated to include the 0.14 acre of mechanized clearing impacts that were not previously permitted.

**Revised Compensatory Mitigation**


The North Carolina Division of Mitigation Services (NCDMS) previously provided compensatory mitigation for 2,175 linear feet of permanent stream impacts and 1.41 acres of permanent riparian wetland impacts, as referenced in the issued Section 404 Individual Permit from the USACE on January 21, 2020 and the Section 401 WQC modification from NCDWR on January 30, 2020.

Of the revised permanent stream impacts totaling 3,213 linear feet for this modification, 1,047 linear feet are the result of bank stabilization and are not considered loss of waters and therefore do not require mitigation from USACE or NCDWR. After the revisions to the drainage design, permanent stream impacts that require mitigation from USACE for this project now total 2,166 linear feet, which is 9 linear feet less than previously needed. The revised permanent wetland impacts for this project total 1.55 acres and therefore this modification will require additional mitigation for 0.14 acres of permanent riparian wetland impacts. A revised DMS acceptance letter reflecting these changes was issued and received on November 23, 2020 (attached).

NCDOT requests to modify the permit for this project. Application is hereby made for modification of the USACE 404 permit and the 401 WQC from NCDWR as required for the above-described activities. We have provided a method of debiting \$570.00 to be submitted to the NCDWR for processing the WQC renewal for I-3819B, as noted in the subject line of this application.

A copy of this permit application and its distribution list will be posted in the NCDOT website at <http://connect.ncdot.gov/resources/Environmental>. Thank you for your assistance with this project. If you have any questions or need additional information, please contact Erin Cheely at either [ekcheely@ncdot.gov](mailto:ekcheely@ncdot.gov) or (919) 707-6108.

Sincerely,

  
for Philip S. Harris III, P.E., C.P.M.  
Environmental Analysis Unit Head

cc:  
NCDOT Permit Application Standard Distribution List

# DWR Pre-Filing Meeting Request Form



**ID#\*** 20191006 **Version\*** 2

**Regional Office\*** Mooresville Regional Office - (704) 663-1699

**Reviewer List\*** Donna Hood

## Pre-Filing Meeting Request submitted 9/26/2020

**Contact Name\*** Erin Cheely

**Contact Email Address\*** ekcheely@ncdot.gov

**Project Name\*** I-3819B

**Project Owner\*** NCDOT

**Project County\*** Iredell

**Owner Address:**

<b>Street Address</b>	
1598 Mail Service Center	
<b>Address Line 2</b>	
<b>City</b>	<b>State / Province / Region</b>
Raleigh	NC
<b>Postal / Zip Code</b>	<b>Country</b>
27699	United States of America

**Is this a transportation project?\*** ☒ Yes ☐ No

### Type(s) of approval sought from the DWR:

- |   |  |
|---|--|
| <input checked="" type="checkbox"/> 401 Water Quality Certification - Regular | <input type="checkbox"/> 401 Water Quality Certification - Express |
| <input checked="" type="checkbox"/> Individual Permit                         | <input checked="" type="checkbox"/> Modification                   |
| <input type="checkbox"/> Shoreline Stabilization                              |  |

**Does this project have an existing project ID#?\***

☒ Yes ☐ No

**Please list all existing project ID's associated with this projects.\***

20191006

**Do you know the name of the staff member you would like to request a meeting with?**

No meeting is requested.

**Please give a brief project description below.\***



I-3819B is the proposed improvements to the I-40 and I-77 interchange in Iredell County. NCDOT does not request a meeting.

Modification to the existing permit is anticipated at sites 2, 5, 16, 17, 19, 22, and 25 with two new permit sites, 28 and U-4.

Please give a couple of dates you are available for a meeting.

---

**Please attach the documentation you would like to have the meeting about.**

pdf only

**By digitally signing below, I certify that I have read and understood that per the Federal Clean Water Act Section 401 Certification Rule the following statements:**

- This form completes the requirement of the Pre-Filing Meeting Request in the Clean Water Act Section 401 Certification Rule.
- I understand by signing this form that I cannot submit my application until 30 calendar days after this pre-filing meeting request.
- I also understand that DWR is not required to respond or grant the meeting request.

Your project's thirty-day clock started upon receipt of this application. You will receive notification regarding meeting location and time if a meeting is necessary. You will receive notification when the thirty-day clock has expired, and you can submit an application.

**Signature**

A rectangular box containing a handwritten signature in black ink that reads "ERIN CHEELY".

**Submittal Date**

9/26/2020



NORTH CAROLINA  
Environmental Quality

ROY COOPER  
Governor

MICHAEL S. REGAN  
Secretary

TIM BAUMGARTNER  
Director

November 23, 2020

Mr. Philip S. Harris, III, P.E., CPM  
Environmental Analysis Unit  
North Carolina Department of Transportation  
1598 Mail Service Center  
Raleigh, North Carolina 27699-1598

Dear Mr. Harris:

Subject: DMS Mitigation Acceptance Letter:

**I-3819B**, Statesville – I-40 / I-77 Interchange – I-40 from SR 2003 (Indian Ridge Road) to SR 2158 (Old Mocksville Road) and I-77 from SR 2171 (Jane Sowers Road) to SR 2321 (East Broad Street), Iredell County

References: USACE 404 Individual Permit issued January 21, 2020 (USACE Action ID 2018-01504)

NCDWR 401 Water Quality Certification issued November 19, 2019 (NCDWR ID 2019-1006)

The purpose of this letter is to notify you that the Division of Mitigation Services (DMS) will provide the additional riparian wetland mitigation and make any necessary debit adjustments to the stream mitigation for the subject project. Based on the information supplied by you on November 20, 2020, the impacts are located in CU 03040102 of the Yadkin River basin in the Central Piedmont (CP) and Central Piedmont (CP) Eco-Regions, and are as follows:

**Table 1 – Additional Impacts (feet / acres)**

Yadkin 03040102 CP	Stream			Wetlands			Buffer (Sq. Ft.)	
	Cold	Cool	Warm	Riparian	Non-Riparian	Coastal Marsh	Zone 1	Zone 2
Impacts (feet/acres)	0	0	0	0.14	0	0	0	0

\*NOTE: Some of the impacts may be proposed to be mitigated at a 1:1 mitigation ratio. See permit application for details.

This additional impact and associated mitigation needs were not projected by the NCDOT in the 2020 impact data. DMS is currently providing stream and riparian wetland mitigation for the impacts associated with this project located in cataloging unit 03040102 of the Yadkin River basin as required by the 404 and 401 permits issued in 2019 and 2020, as shown in the below table (in mitigation credits):



**Table 2 – Current Permitted Impacts and Associated Mitigation Requirements provided by DMS (based on issued permits) and Revised Anticipated Impacts (based on mitigation request)**

Impact Type	Total Permitted Impacts (feet / acre / sq ft)	Mitigation Provided by DMS per Issued Permits (Credits)	Additional Impact (for approval)	Revised Total Impacts*
Stream (warm)	2,175.0	4,350.0	-9.0	2,166.0
Riparian Wetland	1.41	2.82	0.14	1.55

\*Some of the additional impacts may be proposed to be mitigated at a 1:1 mitigation ratio. See permit application for details. DMS will provide the amount of mitigation as determined by the regulatory agencies.

**This mitigation acceptance letter replaces the mitigation acceptance letter issued on May 20, 2018 and July 12, 2019.** DMS commits to implementing additional riparian wetland mitigation credits to offset the impacts associated with this project as determined by the regulatory agencies using the delivery timeline listed in Section F.3.c.iii of the In-Lieu Fee Instrument dated July 28, 2010. Also, the stream impacts associated with the project are anticipated to decrease. The stream mitigation requirements for this project were debited at the time of permit issuance. DMS will adjust the mitigation debits if necessary once the modified permits are issued and received. If the above referenced impact amounts are revised, then this mitigation acceptance letter will no longer be valid and a new mitigation acceptance letter will be required from DMS.

If you have any questions or need additional information, please contact Ms. Beth Harmon at 919-707-8420.

Sincerely,



James B. Stanfill  
DMS Asset Management Supervisor

cc: Mr. Monte Matthews, USACE – Raleigh Regulatory Field Office  
Ms. Amy Chapman, Division of Water Resources, Wetlands/401 Unit  
File: I-3819B Additional




# STATE OF NORTH CAROLINA DIVISION OF HIGHWAYS

***IREDELL COUNTY***


**LOCATION: I-40/I-77 INTERCHANGE INCLUDING I-40 FROM WEST OF  
SR 2003 (RADIO RD.) TO SR 2158 (OLD MOCKSVILLE RD.) & I-77 FROM SOUTH OF  
SR 2321 (EAST BROAD ST.) TO SOUTH OF SR 2171 (JANE SOWERS RD.)**

***TYPE OF WORK: GRADING, DRAINAGE, PAVING, STRUCTURES,  
RETAINING WALLS, NOISE WALLS, AND TRAFFIC CONTROL***

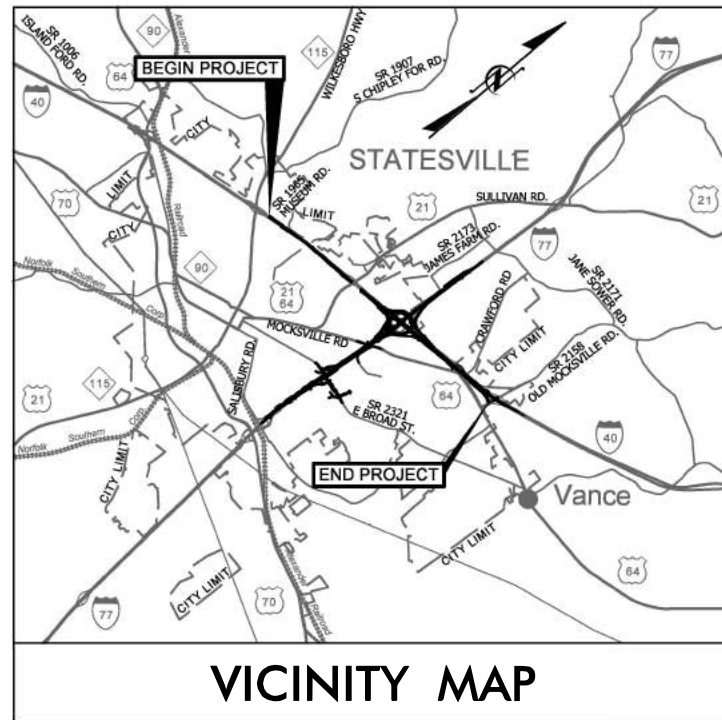

## VICINITY MAP

THIS PROJECT IS WITHIN THE MUNICIPAL  
BOUNDARIES OF THE CITY OF STATESVILLE  
AND THE TOWNSHIP OF BETHANY

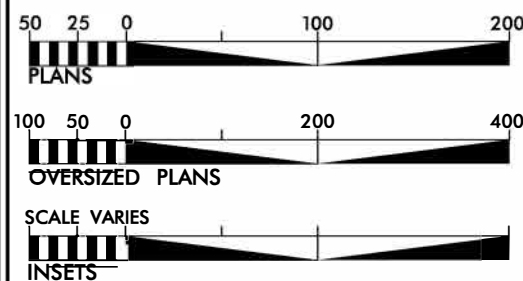

**BEGIN TIP PROJECT I-3819B**  
**-L- STA. 7+83.00**

BEGIN SEGMENT "A"  
END SEGMENT "B"  
-L- STA. 92+00

BEGIN SEGMENT "A"  
END SEGMENT "B"  
-Y S- STA. 111+00

BEGIN SEGMENT "B"  
-Y S- STA. 25+00.09

CLEARING ON THIS PROJECT SHALL BE PERFORMED TO THE LIMITS ESTABLISHED BY METHOD III.

THIS IS A CONTROLLED ACCESS PROJECT  
WITH ACCESS BEING LIMITED TO INTERCHANGES

**END SEGMENT "A"**  
**BEGIN SEGMENT "B"**  
**-Y N- STA. 175+00**

END CONSTRUCTION  
-Y- POT STA. 205+00.00

## WETLAND AND SURFACE WATER IMPACT PERMITS

**DATE:** November 2, 2020  
(Note: The sites highlighted in RED are modified in this submittal.)

PERMIT DRAWING  
SHEET 1 OF 67  
Rev. 11/02/2020

**END SEGMENT "A"**  
**BEGIN SEGMENT "B"**  
**-L- STA. 178 + 50**

**END TIP PROJECT I-3819B**  
~~-L- STA. 219 + 50.00~~

**LANE**

**INCOMPLETE PLANS**  
DO NOT USE FOR R/W ACQUISITION

## GRAPHIC SCALES

**SEE ABOVE**

<b>DESIGN DATA</b>		
	<b>I-40</b>	<b>I-77</b>
<b>ADT 2018 =</b>	<b>57,300</b>	<b>62,900</b>
<b>ADT 2040 =</b>	<b>72,500</b>	<b>77,500</b>
<b>DHV =</b>	<b>5,800</b>	<b>6,200</b>
<b>D =</b>	<b>55 %</b>	<b>55 %</b>
<b>T =</b>	<b>16 % *</b>	<b>19 % **</b>
<b>V =</b>	<b>60 MPH</b>	<b>60 MPH</b>
<b>* TTST 13 +</b>	<b>DUAL 3 (I-40)</b>	
<b>** TTST 16 +</b>	<b>DUAL 3 (I-77)</b>	
<b>CLASSIFICATION: INTERSTATE</b>		

<b>PROJECT LENGTH</b>			
LENGTH ROADWAY TIP PROJECT	I-3819B	=	3.885
LENGTH STRUCTURES TIP PROJECT	I-3819B	=	<u>0.124</u>
TOTAL LENGTH OF TIP PROJECT	I-3819B	=	4.009

<p>Prepared In the Office of:</p> <p><b>WSP</b></p> <p>1001 Morehead Square Dr., Suite 610, Charlotte, NC 28203</p> <p>NC LIC NO. F-0165</p>	
<p>2018 STANDARD SPECIFICATIONS</p>	<p><u>RIGHT OF WAY DATE:</u></p> <p><u>OCTOBER 30, 2018</u></p> <p><u>LETTING DATE:</u></p> <p><u>OCTOBER 30, 2018</u></p>
<p><u>CHRISTOPHER D. DAVIS, P.E.</u></p> <p>PROJECT ENGINEER</p> <p><u>ERIC W. SECKINGER, P.E.</u></p> <p>PROJECT DESIGN ENGINEER</p>	

---

**HYDRAULICS ENGINEER**

**SIGNATURE:** \_\_\_\_\_ **P.E.**

**ROADWAY DESIGN  
ENGINEER**

**SIGNATURE:** \_\_\_\_\_ **P.E.**

## DIVISION OF HIGHWAYS STATE OF NORTH CAROLINA



P.E.

---



STATE HIGHWAY DESIGN ENGINEER







17/02/2020 10:00 AM C:\Users\jgibson\OneDrive\Documents\106+50.00 -L- SEE SHEET NO. 9A.dwg  
-MATCHLINE- STA. 106+50.00 -L- SEE SHEET NO. 9A

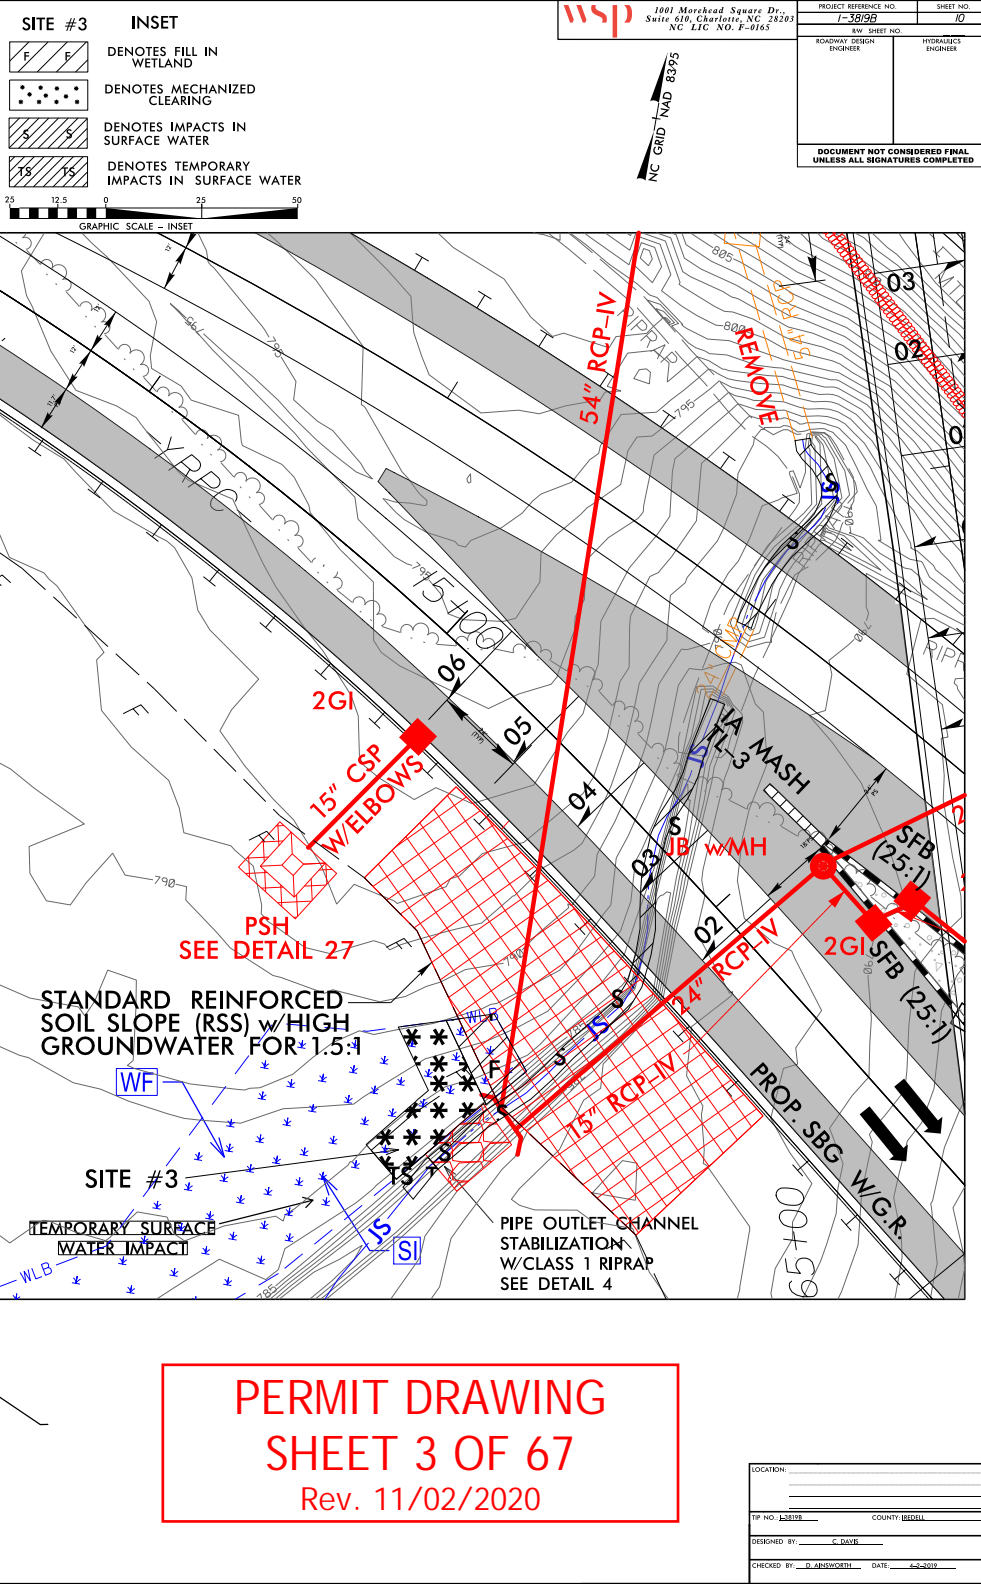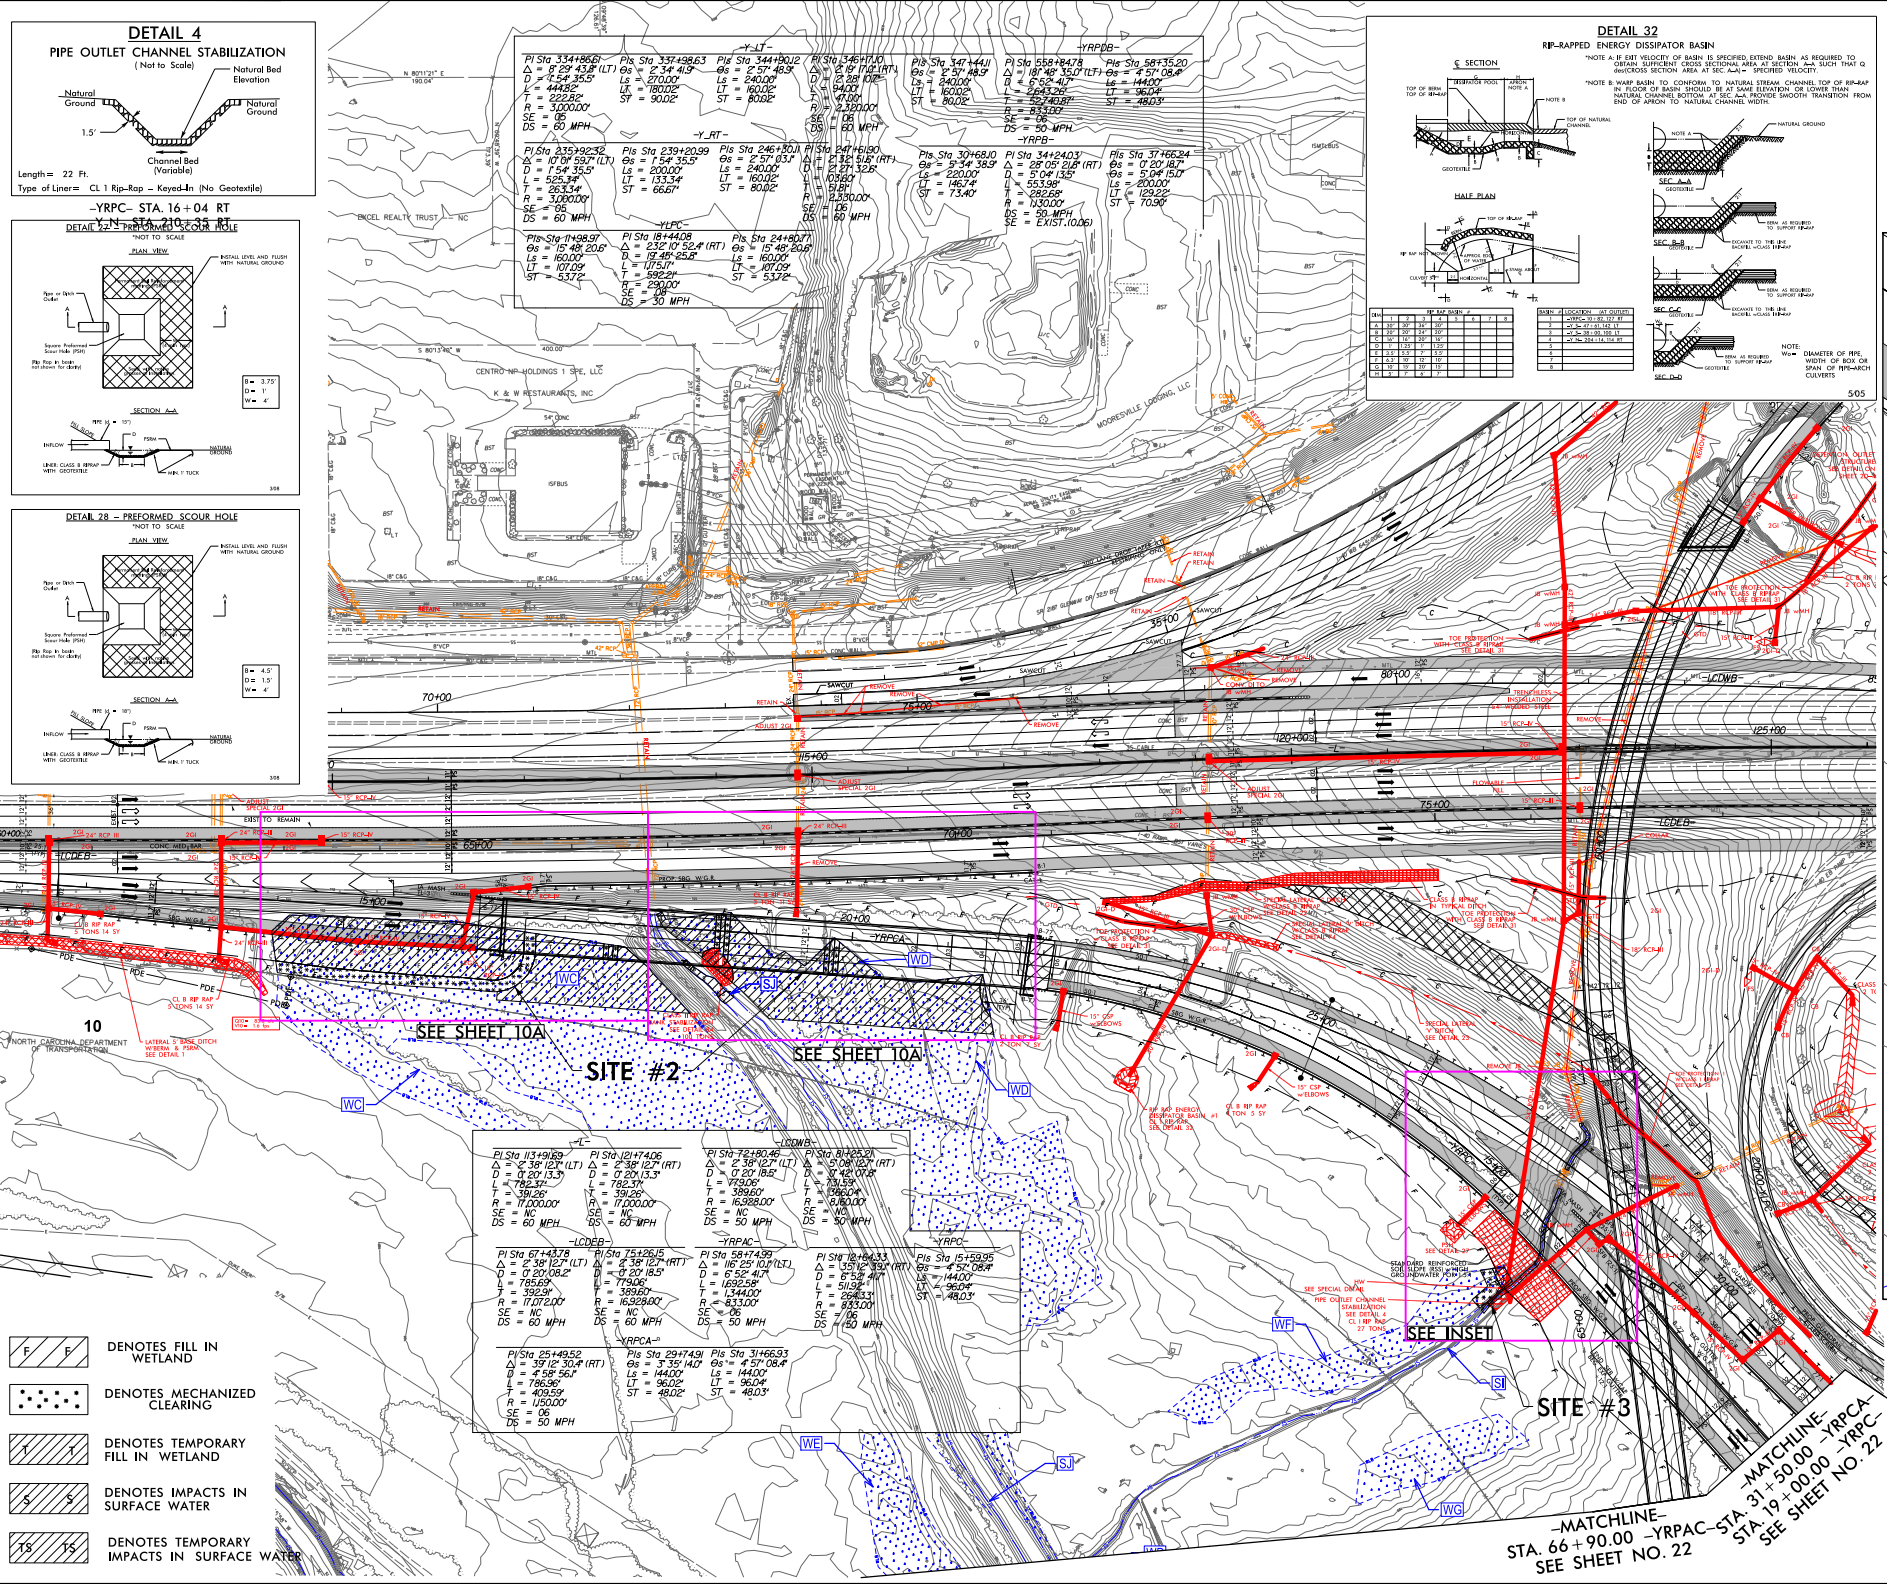

PERMIT DRAWING  
SHEET 3 OF 67  
Rev. 11/02/2020

PROJECT REFERENCE NO. 106+50.00 -L- SEE SHEET NO. 9A		SHEET NO. 03	
DESIGNED BY: J. GIBSON		CHECKED BY: J. GIBSON	
DATE: 11/02/2020		DATE: 11/02/2020	
LOCATION: 106+50.00 -L- SEE SHEET NO. 9A		COUNTY: ISDELL	
DESIGNED BY: J. GIBSON		CHECKED BY: J. GIBSON	
DATE: 11/02/2020		DATE: 11/02/2020	



**WSP** 1001 Morehead Square Dr.,  
Suite 610, Charlotte, NC 28203  
NC LIC NO. F-0165


**DETAIL 84**  
**RIP RAP BANK STABILIZATION**  
 (Not to Scale)

See plan  
 1.0' min.  
 Ex. or Pr. Grade  
 d\*  
 Do not disturb bed or opposite bank

Type of Liner = CL 1 or CL 2 Rip Rap (see plan)  
 \*d = 18" for CL 1 and 30" for CL 2 (No Geotextile)

TEMPORARY FILL  
IN WETLAND  
(MATTING FOR  
CONSTRUCTION  
ACCESS – BRIDGE  
STRUCTURE #12)

PERMIT DRAWING  
SHEET 4 OF 67  
Rev. 11/02/2020

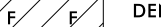- 

— TEMPORARY FILL  
IN WETLAND  
(MATTING FOR  
CONSTRUCTION  
ACCESS – BRIDGE  
STRUCTURE #12)





GRAPHIC SCALE – INSET

0/22/2020  
c:\projectwise\pb\projectwise\becker\jw\d0339329\13819\_hyd-prm-pshl0A-L10650-13550.dgn  
becker.jw

SITE #2


**wsp** 1001 Morehead Square Dr.,  
Suite 610, Charlotte, NC 28203  
NC LIC NO. F-0165

PROJECT REFERENCE NO.	SHEET NO.
1-3819B	10A
R/W SHEET NO.	
ROADWAY DESIGN ENGINEER	HYDRAULICS ENGINEER
DOCUMENT NOT CONSIDERED FINAL UNLESS ALL SIGNATURES COMPLETED	

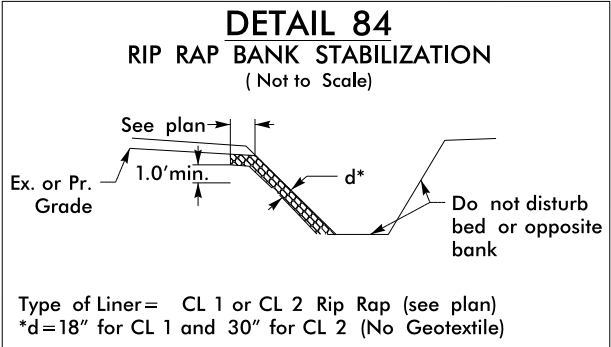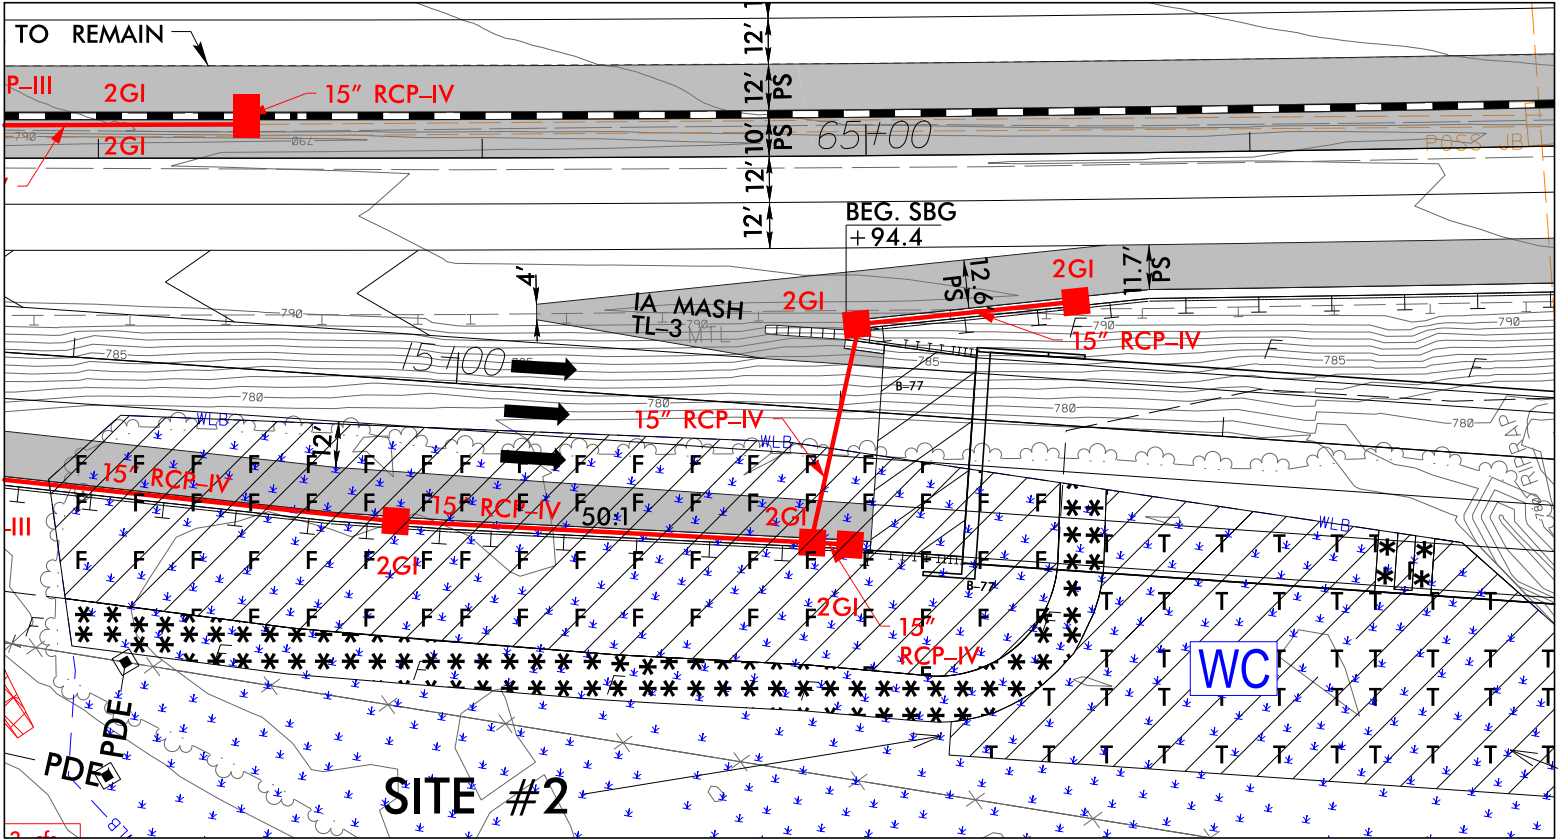

-YRPCA- STA. 18+65 RT  
-YRPCA- STA. 77+00 RT

TEMPORARY FILL  
IN WETLAND  
(MATting FOR  
CONSTRUCTION  
ACCESS - BRIDGE  
STRUCTURE #12)

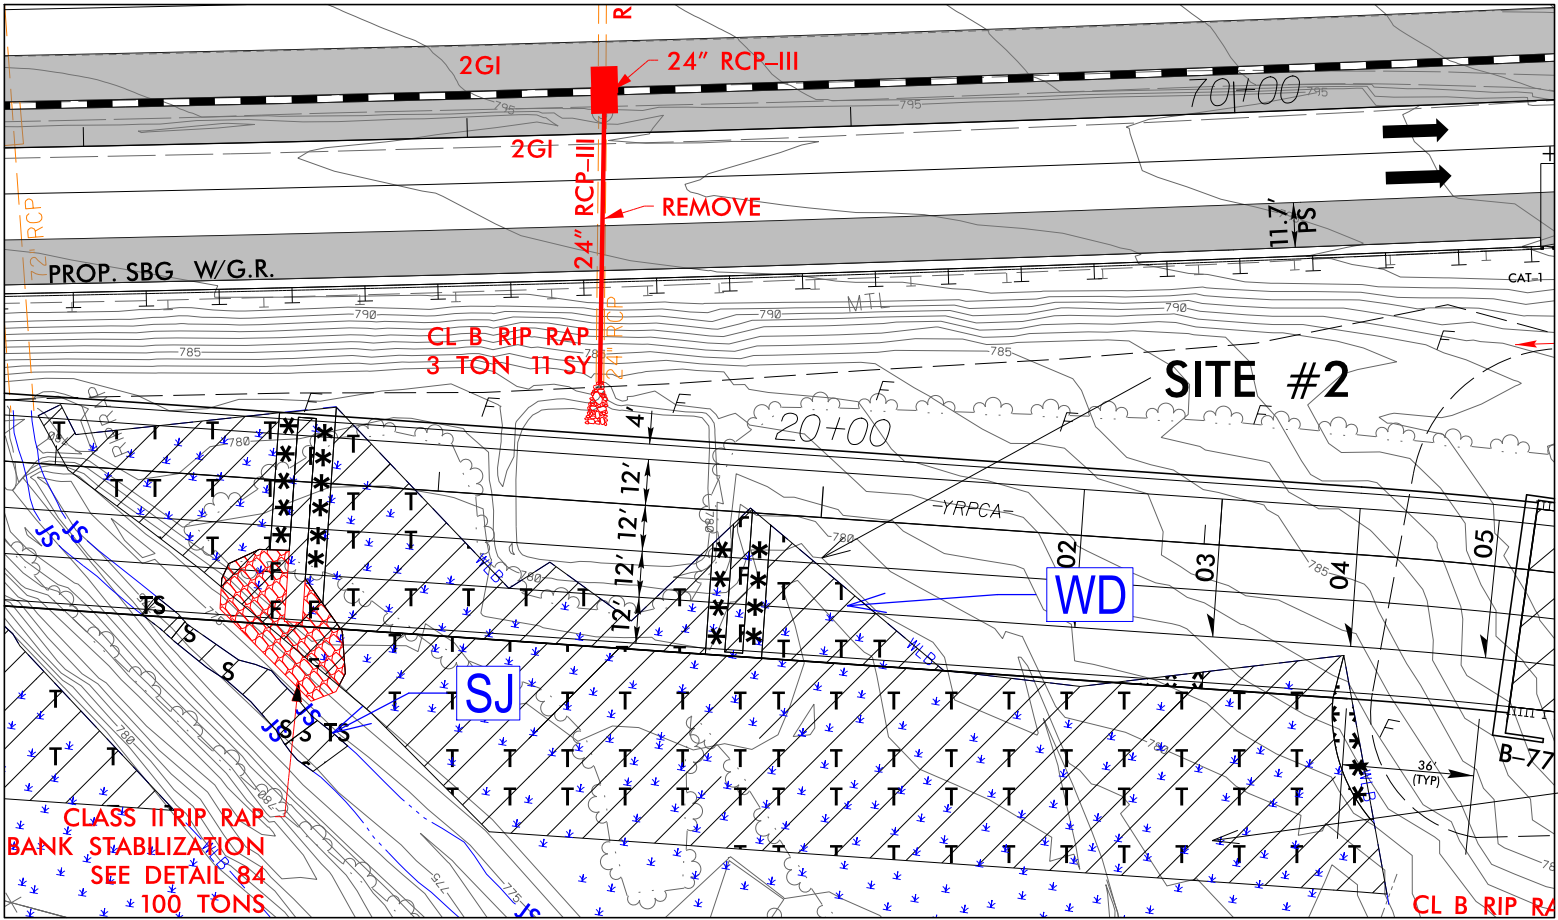


**PERMIT DRAWING**  
**SHEET 5 OF 67**  
Rev. 11/02/2020

- DENOTES FILL IN WETLAND
- DENOTES MECHANIZED CLEARING
- DENOTES TEMPORARY FILL IN WETLAND

TEMPORARY FILL  
IN WETLAND  
(MATting FOR  
CONSTRUCTION  
ACCESS - BRIDGE  
STRUCTURE #12)

NC GRID NAD 8395

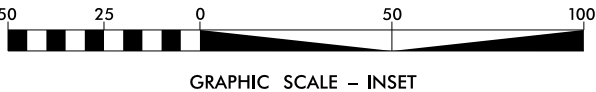




6/2/2020  
10:20:20  
C:\Users\jgibson\OneDrive\Documents\1001 Marshhead Square Dr., Suite 610, Charlotte, NC 28203  
NC LIC. NO. F-0165


1001 Marshhead Square Dr.,  
Suite 610, Charlotte, NC 28203  
NC LIC. NO. F-0165

PROJECT REFERENCE NO.	1-3819B
DATE	11/02/2020
ENGINEER	HYDRAULICS
DESIGNER	HYDRAULICS
CHECKER	HYDRAULICS
APPROVER	HYDRAULICS
DOCUMENT NOT CONSIDERED FINAL UNLESS ALL SIGNATURES COMPLETED	

NC GRID NAD 83/95

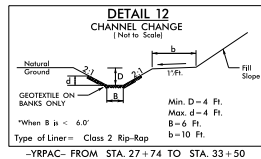

PERMIT DRAWING  
SHEET 10 OF 67  
Rev. 11/02/2020

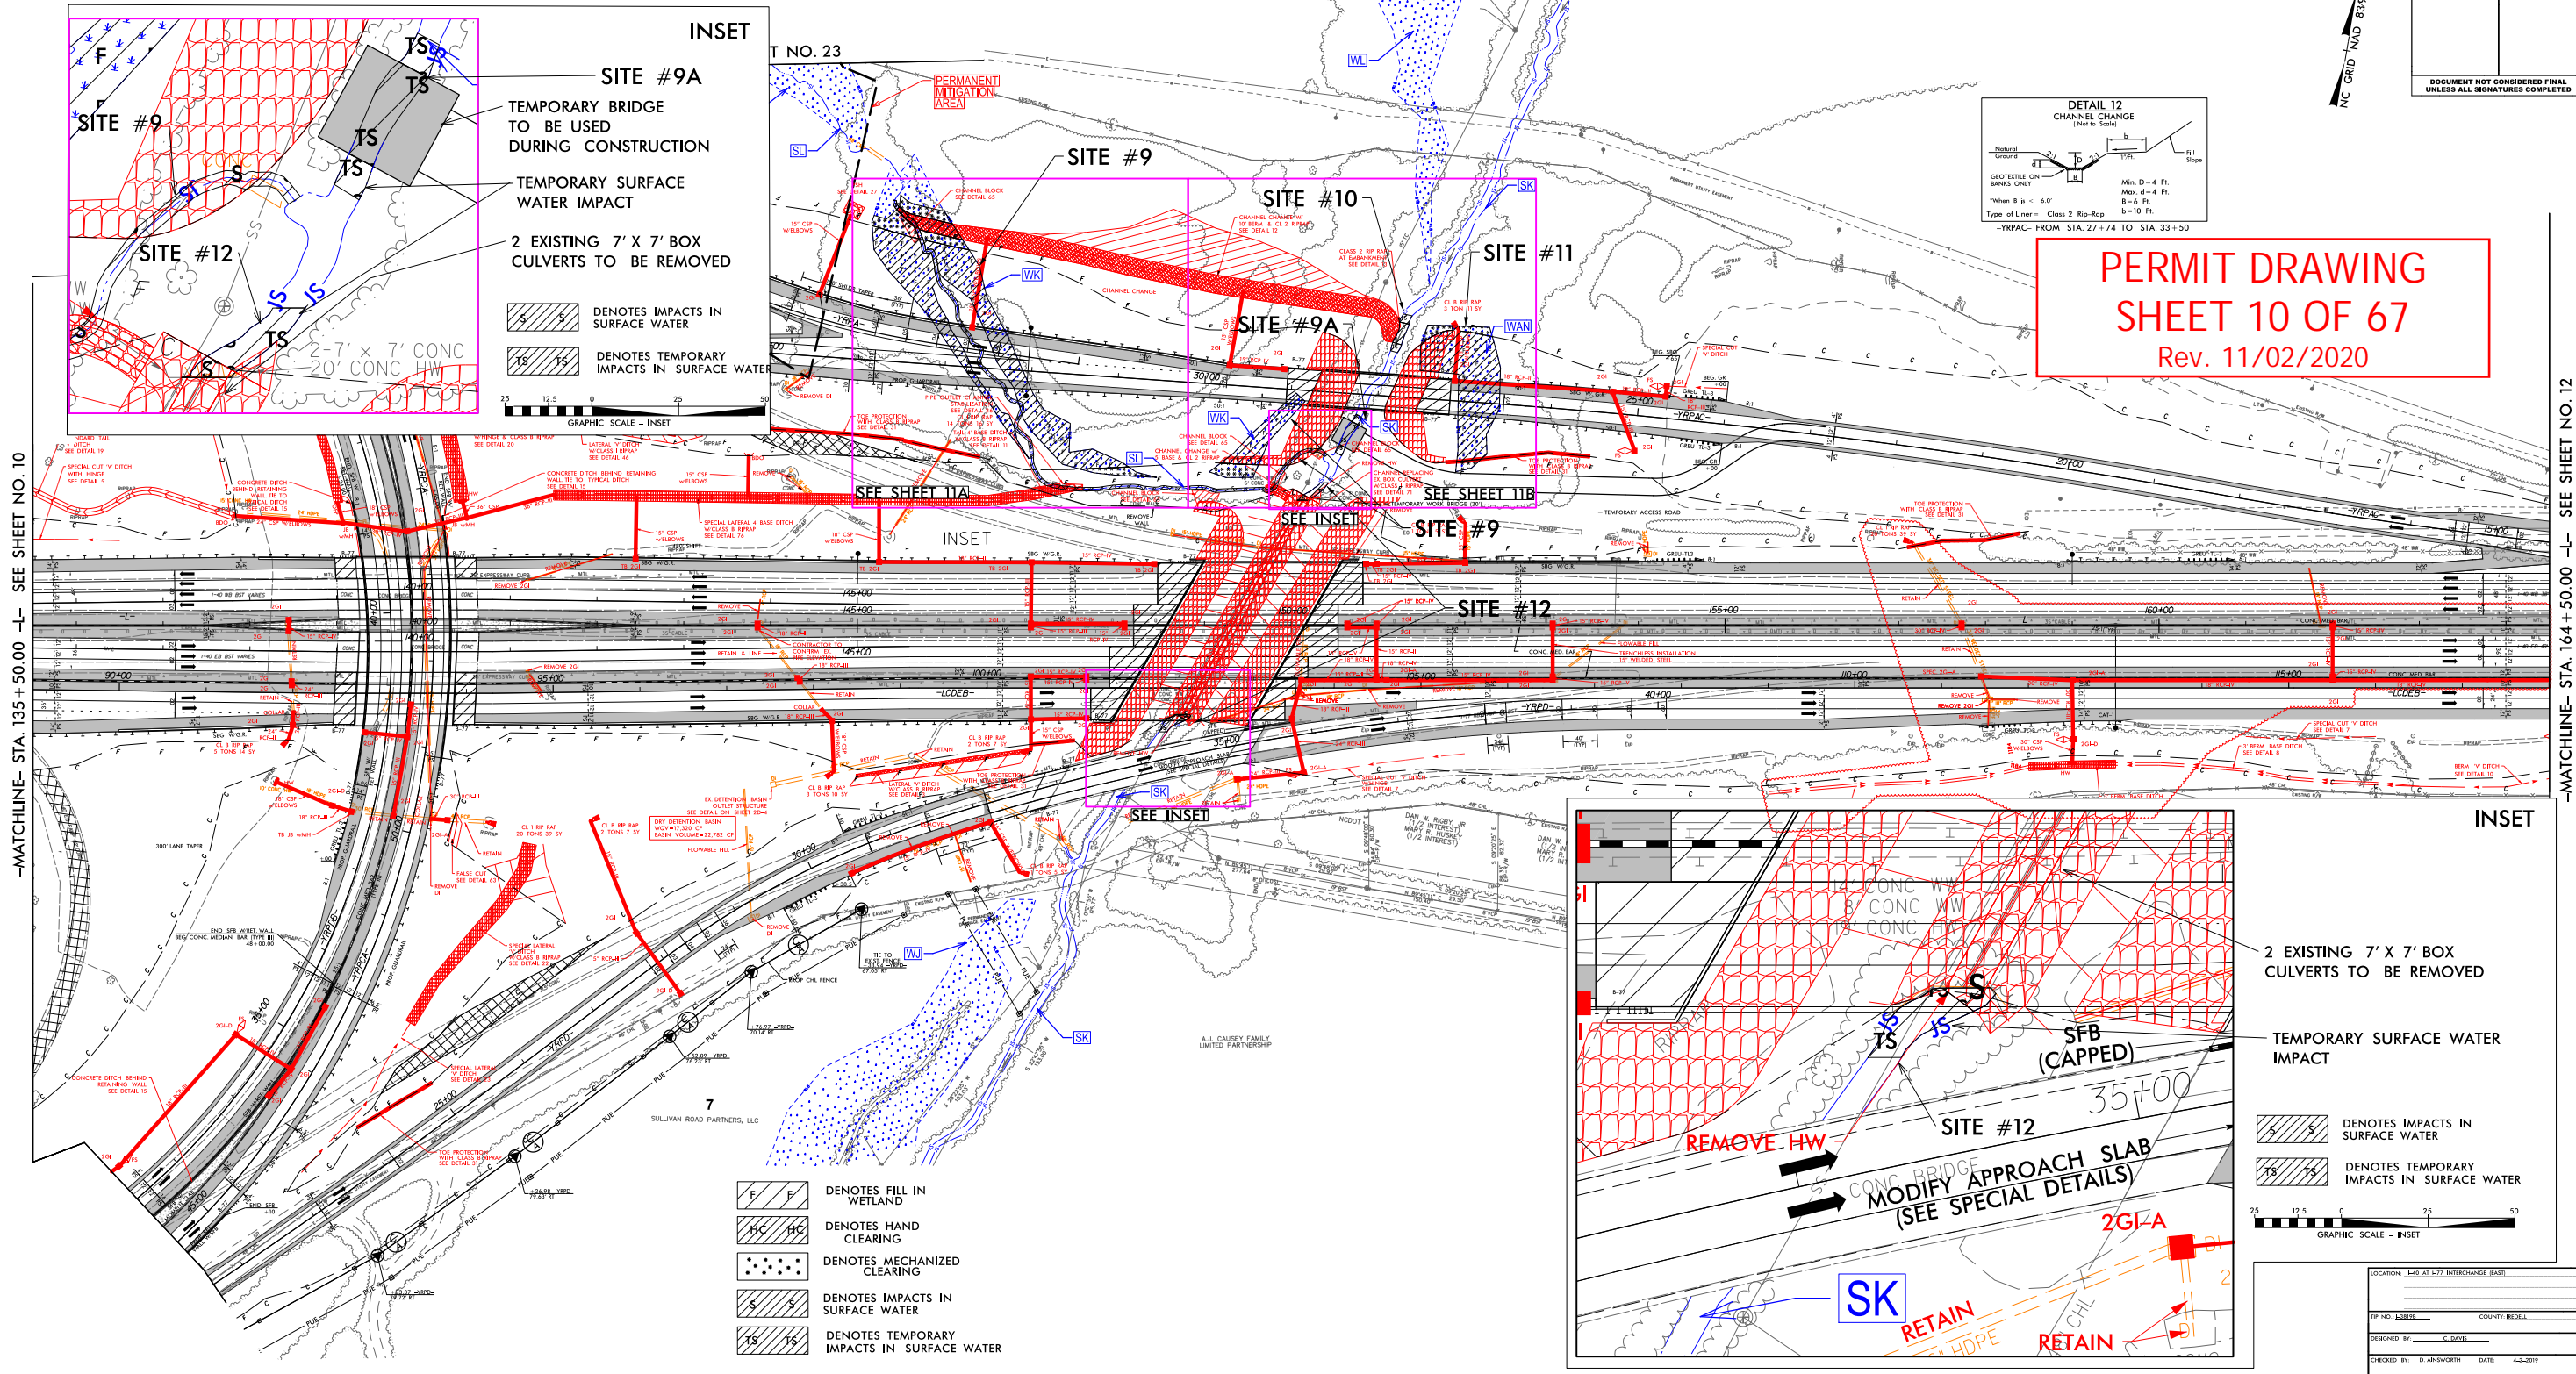

-WATCHLINE- STA. 135+50.00 -L- SEE SHEET NO. 10

-WATCHLINE- STA. 164+50.00 -L- SEE SHEET NO. 12



**DETAIL 12**  
**CHANNEL CHANGE**  
(Not to Scale)

Natural Ground

GEOTEXTILE ON BANKS ONLY

When  $B < 6.0'$

Type of Liner = Class 2 Rip-Rap

Min.  $D = 4$  Ft.  
Max.  $d = 4$  Ft.  
 $B = 6$  Ft.  
 $b = 10$  Ft.

Fill Slope

1.5:1

$b$



$D$

$d$

$B$


—YRPAC— FROM STA. 27 + 74 TO STA. 33 + 50

-MATCHLINE- STA. 164+50.00 -L- SEE SHEET NO. 12

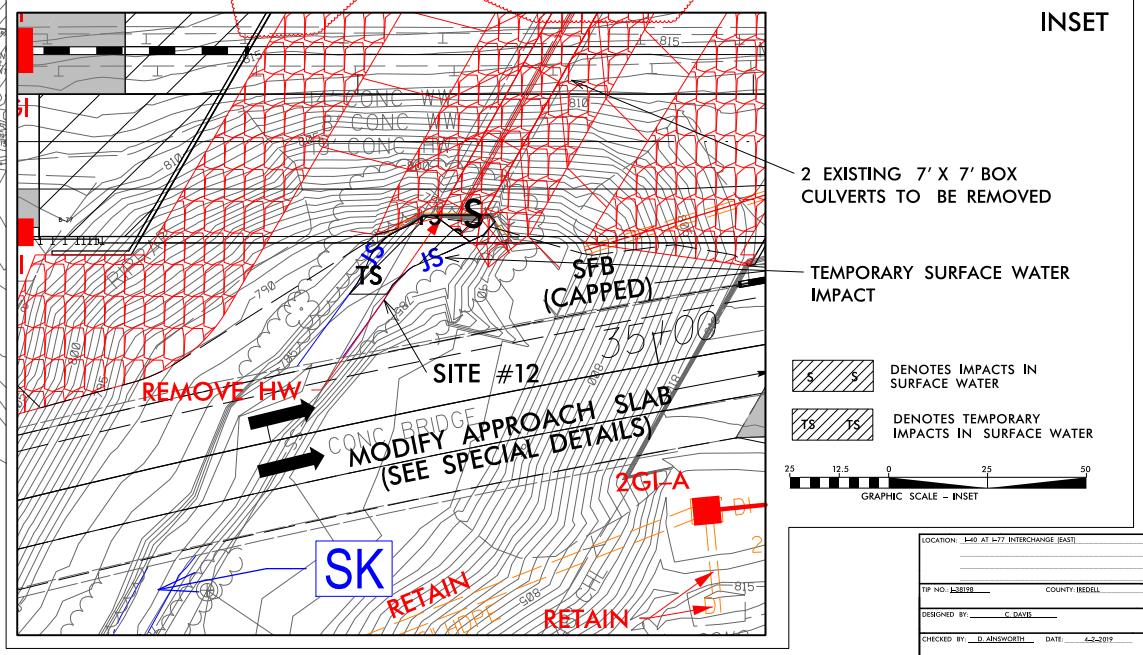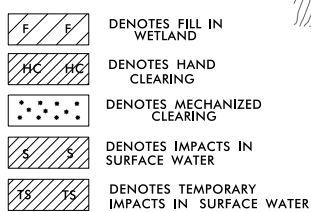




## Rev. 11/02/2020

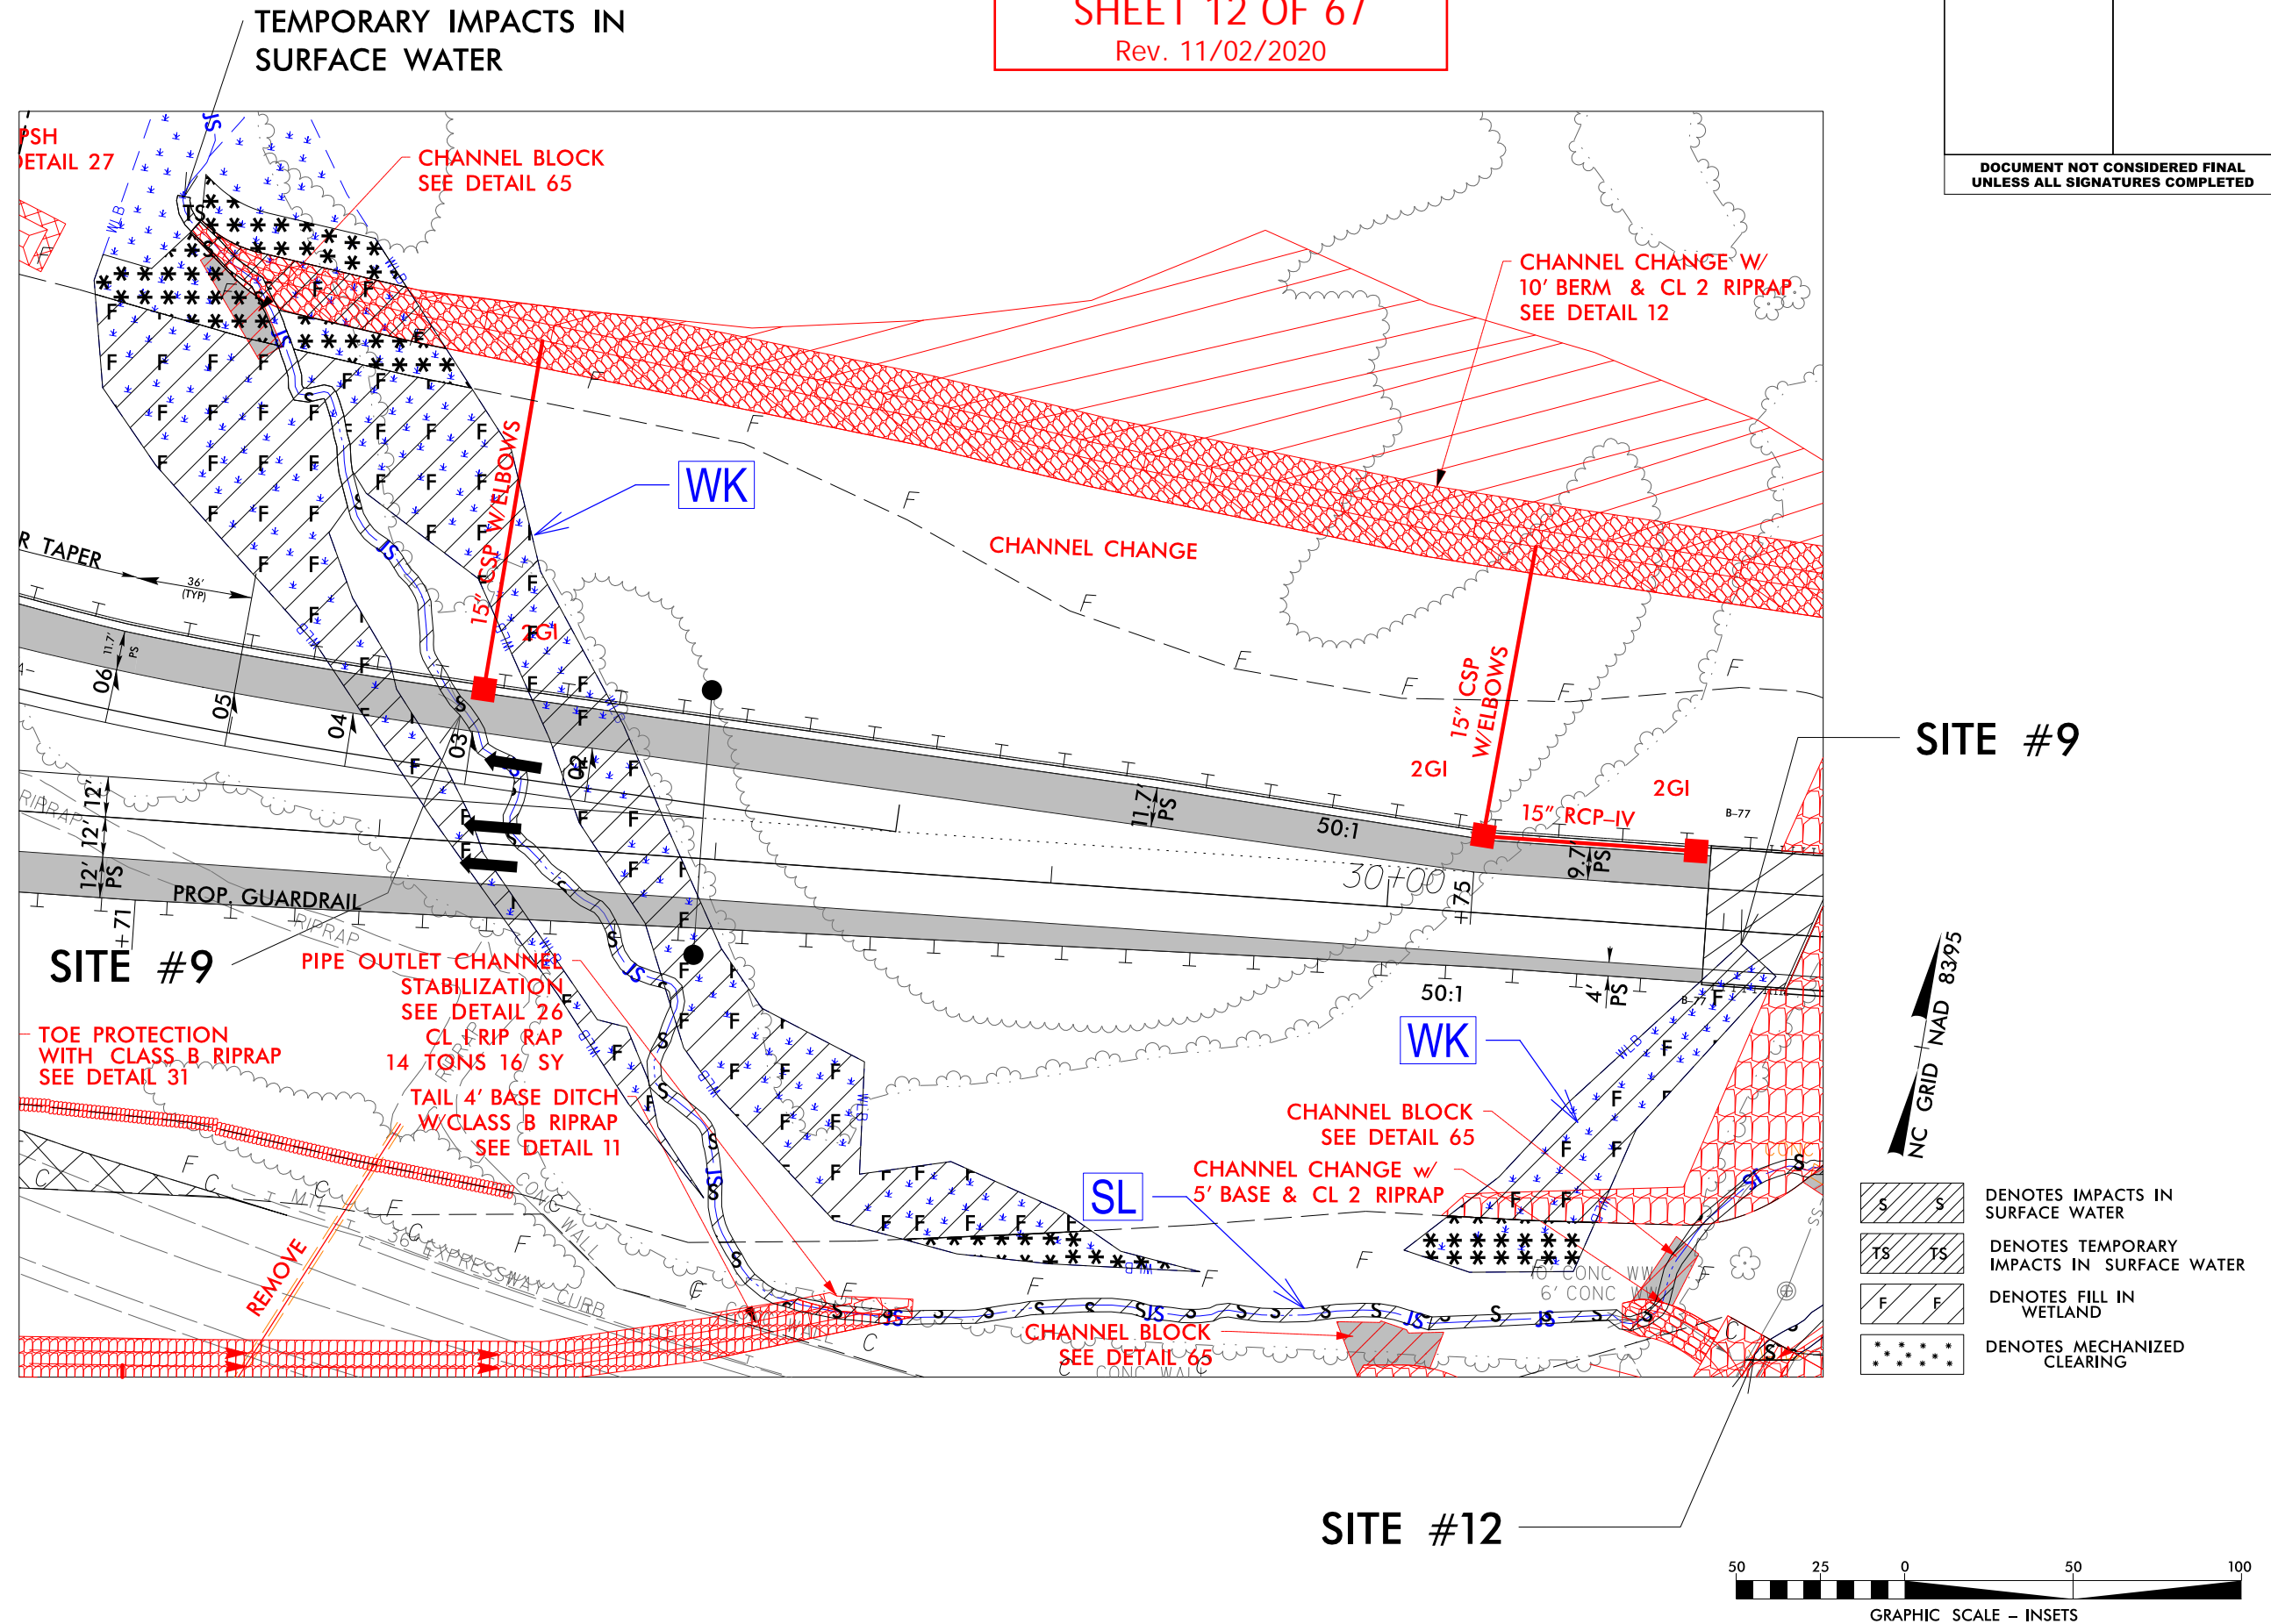

PERMIT DRAWING  
SHEET 13 OF 67  
Rev. 11/02/2020


 


**WSP** 1001 Morehead Square Dr.,  
Suite 610, Charlotte, NC 28203  
NC LIC NO. F-0165

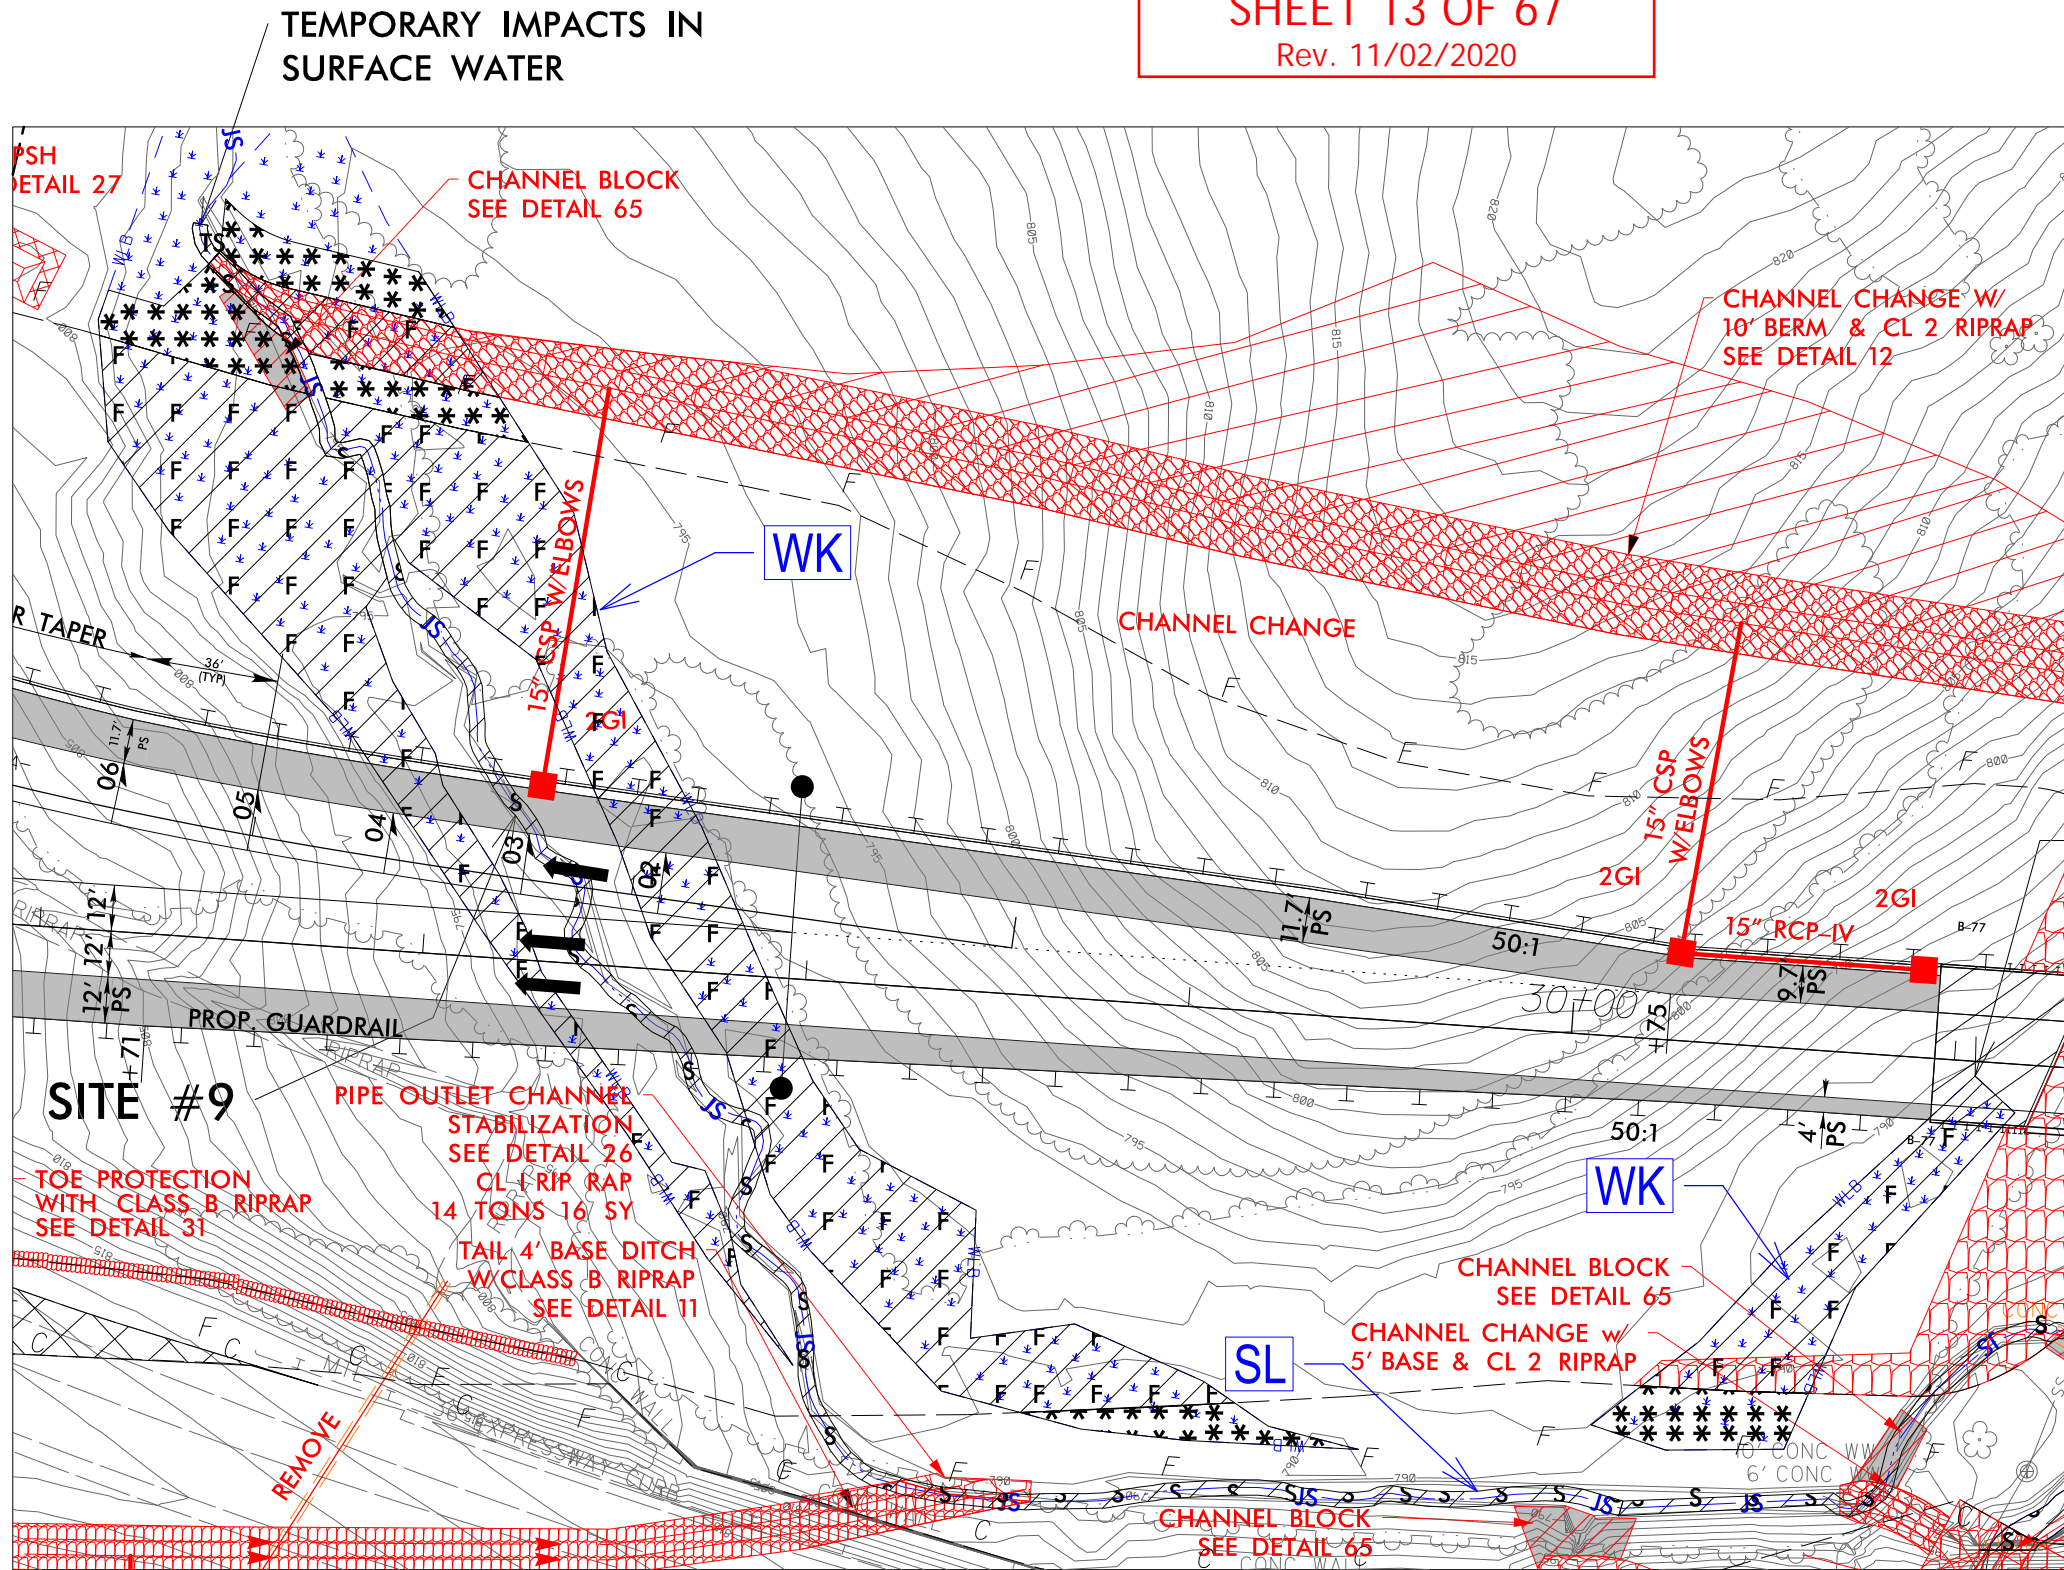PROJECT REFERENCE NO.	SHEET NO.
1-3819B	11A
R/W SHEET NO.	
ROADWAY DESIGN ENGINEER	HYDRAULICS ENGINEER
<p align="center"><b>DOCUMENT NOT CONSIDERED FINAL UNLESS ALL SIGNATURES COMPLETED</b></p>	



# SITE #9

NC GRID + NAD 83/95

- |   |  |
|---|--|
|  | DENOTES IMPACTS IN SURFACE WATER           |
|  | DENOTES TEMPORARY IMPACTS IN SURFACE WATER |
|  | DENOTES FILL IN WETLAND                    |
|  | DENOTES MECHANIZED CLEARING                |

# SITE #12









PERMIT DRAWING  
SHEET 14 OF 67  
Rev. 11/02/2020

**wsp** 1001 Morehead Square Dr.,  
Suite 610, Charlotte, NC 28203  
NC LIC NO. F-0165

PROJECT REFERENCE NO.		SHEET NO.
1-3819B		11B
RW SHEET NO.		
ROADWAY DESIGN ENGINEER		HYDRAULICS ENGINEER
DOCUMENT NOT CONSIDERED FINAL UNLESS ALL SIGNATURES COMPLETED		

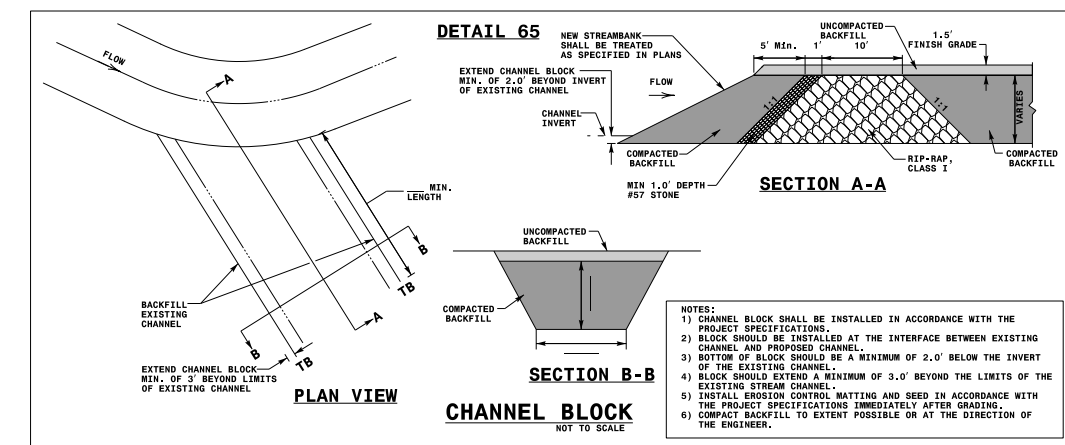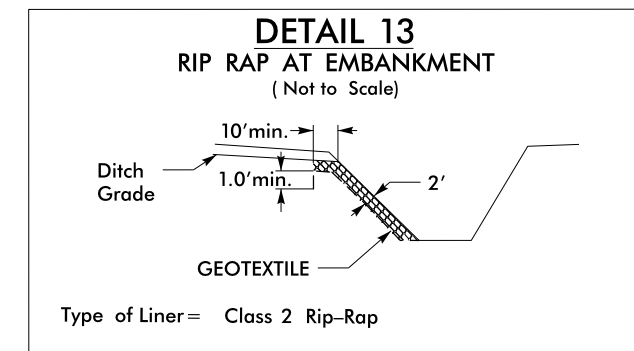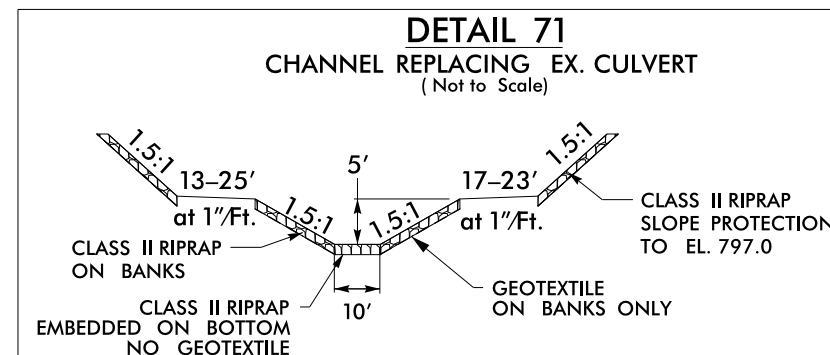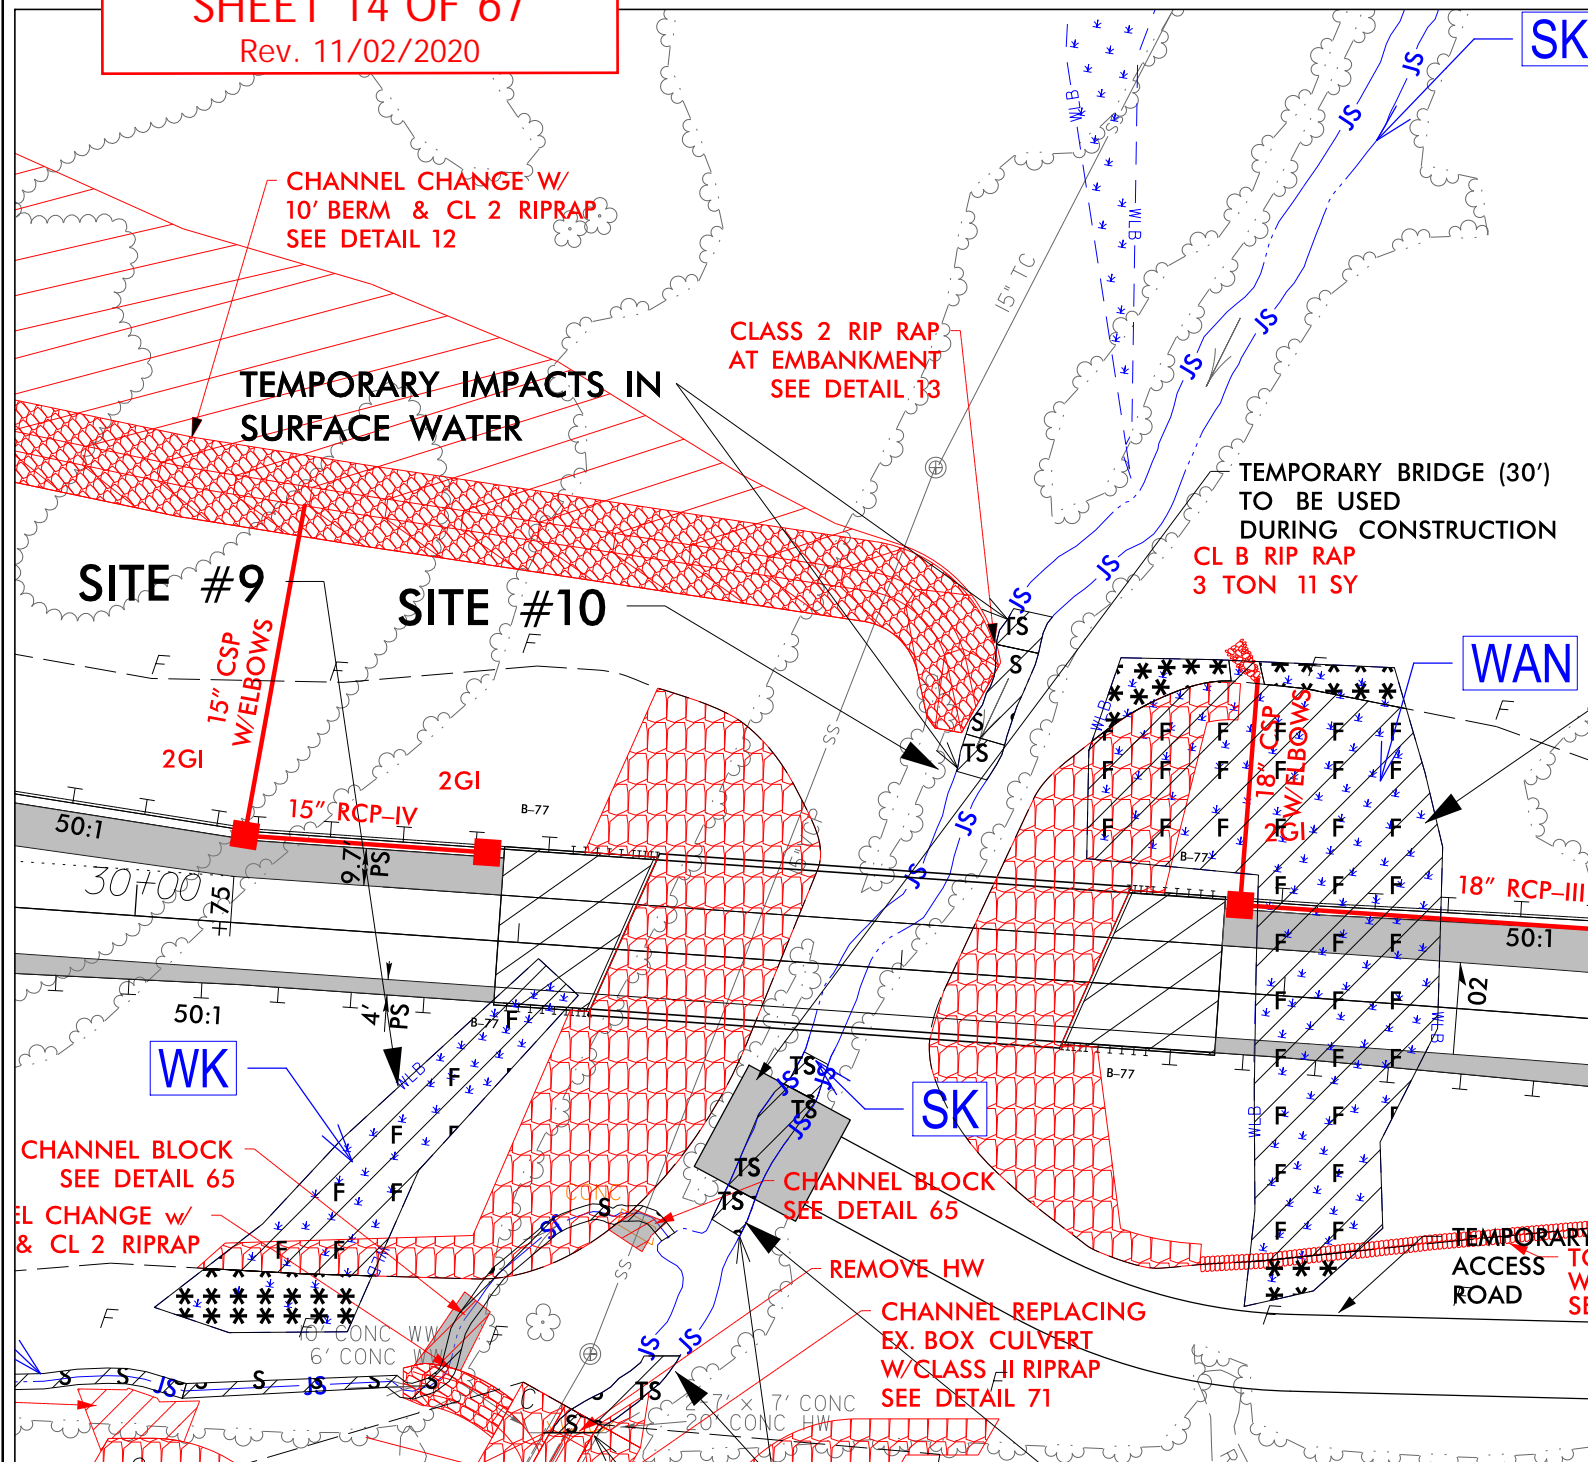

- DENOTES IMPACTS IN SURFACE WATER
- DENOTES TEMPORARY IMPACTS IN SURFACE WATER
- DENOTES FILL IN WETLAND
- DENOTES MECHANIZED CLEARING





10/21/2020  
c:\projects\wise\pb\project\wise\becker\_jw\40339329\13819\_hyd.prm-phh1B.L13550-16450.dgn  
becker\_jw



PERMIT DRAWING  
SHEET 15 OF 67  
Rev. 11/02/2020

**wsp** 1001 Morehead Square Dr.,  
Suite 610, Charlotte, NC 28203  
NC LIC NO. F-0165

PROJECT REFERENCE NO.		SHEET NO.
1-3819B		11B
RW SHEET NO.		
ROADWAY DESIGN ENGINEER		HYDRAULICS ENGINEER
DOCUMENT NOT CONSIDERED FINAL UNLESS ALL SIGNATURES COMPLETED		

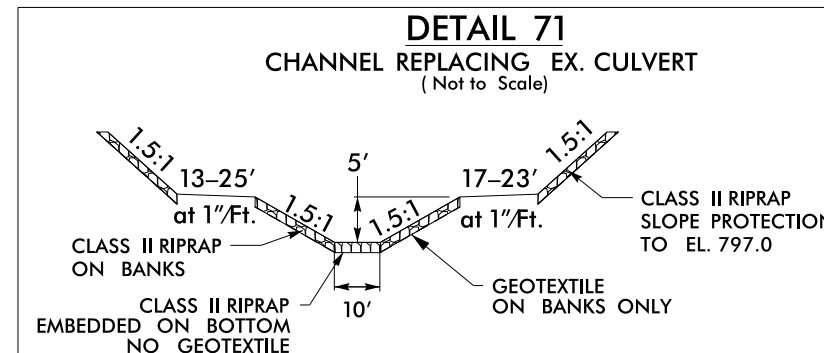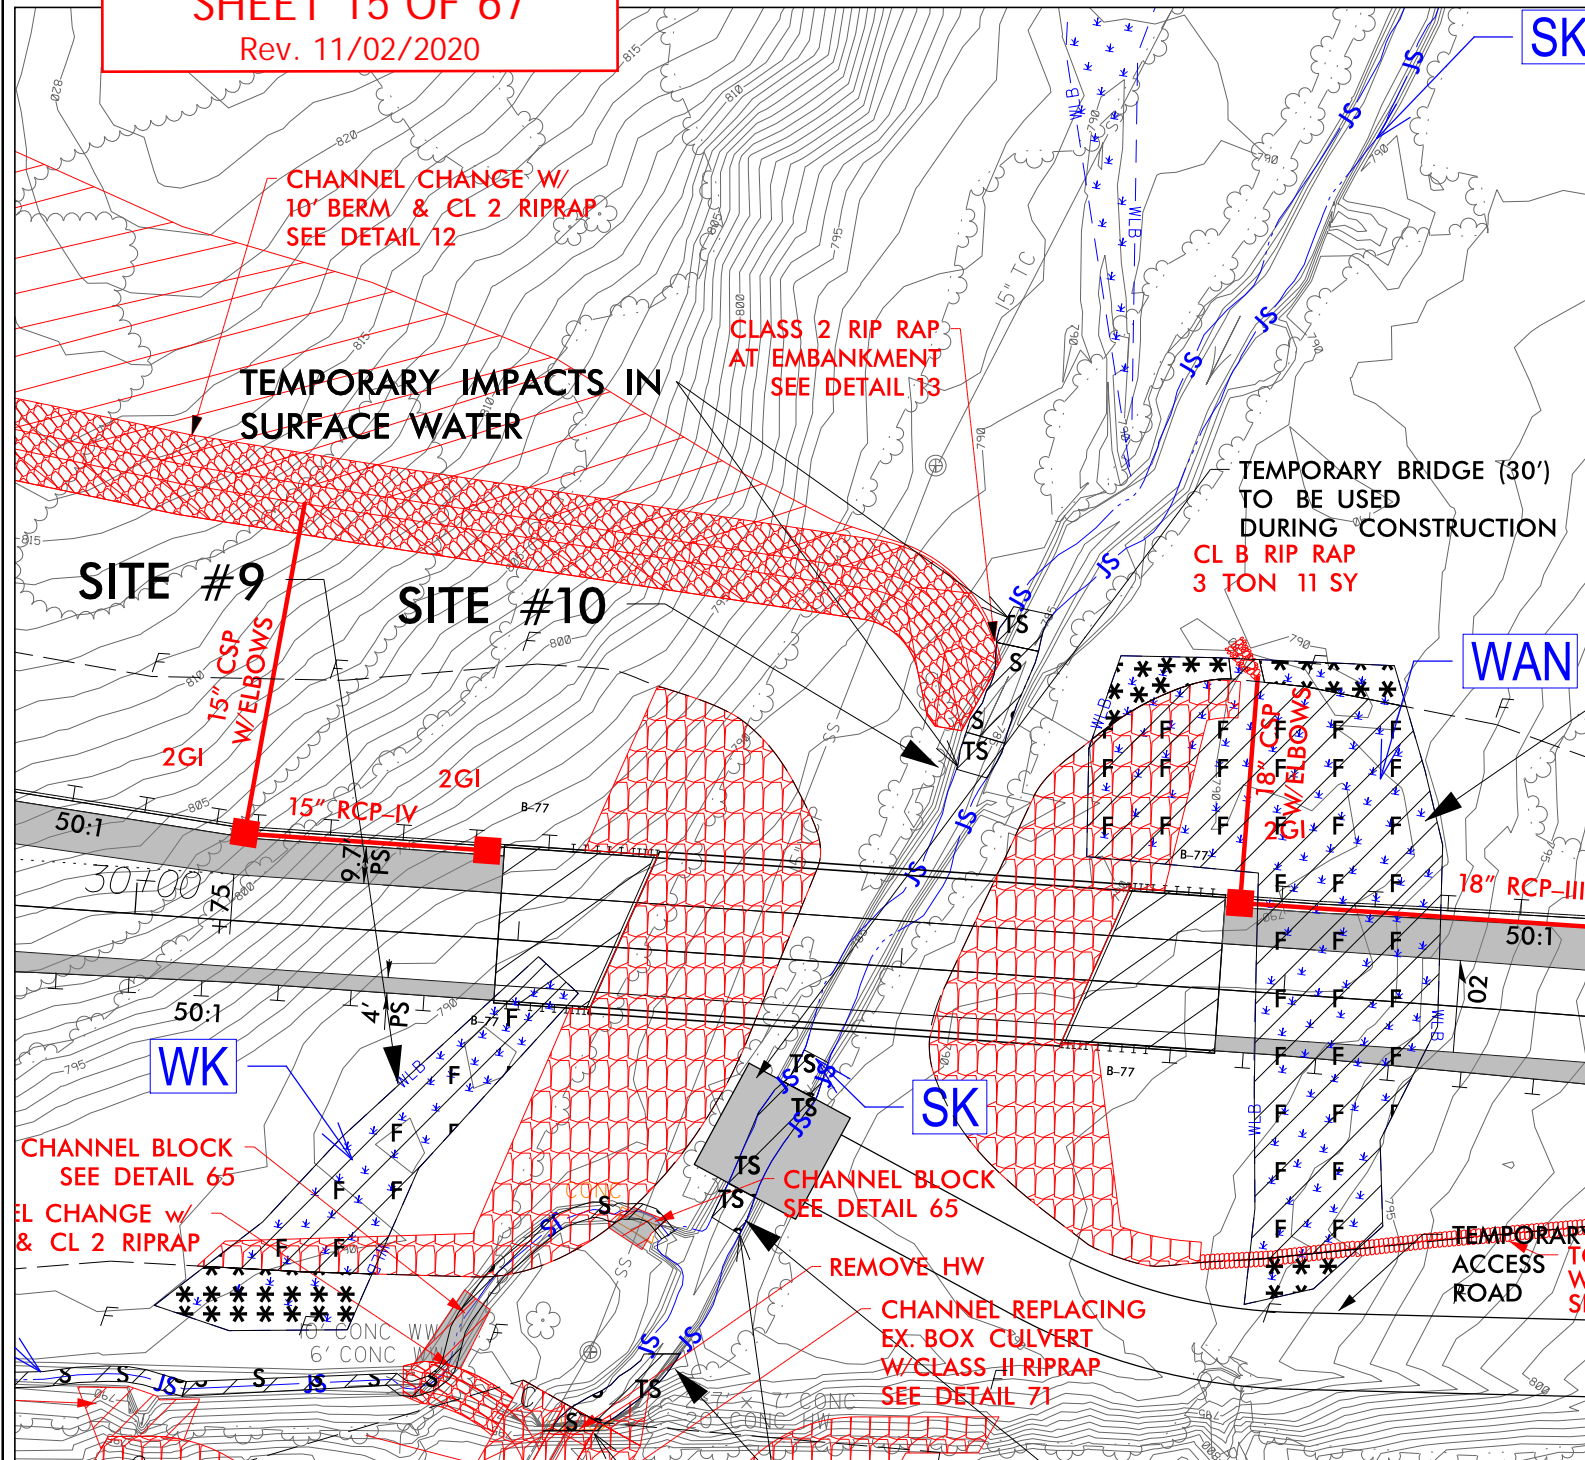

-L- STA. 149+36

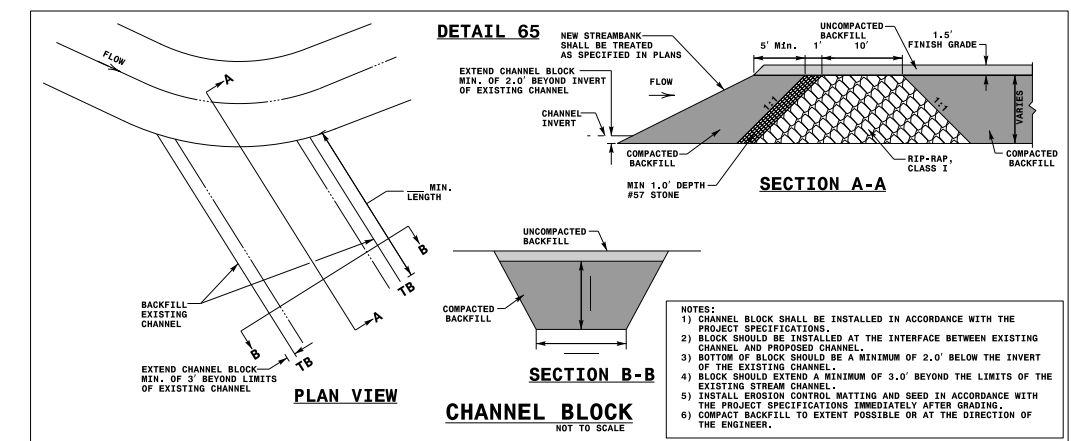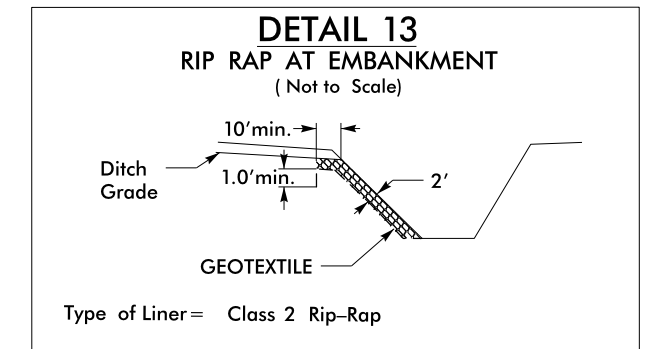


- DENOTES IMPACTS IN SURFACE WATER
- DENOTES TEMPORARY IMPACTS IN SURFACE WATER
- DENOTES FILL IN WETLAND
- DENOTES MECHANIZED CLEARING



GRAPHIC SCALE - INSETS




PERMIT DRAWING  
SHEET 21a OF 67  
Rev. 11/02/2020

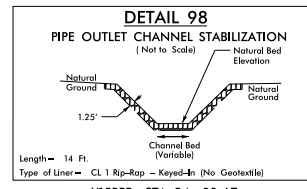

wsp 1001 Morehead Square Dr.,  
Suite 610, Charlotte, NC 28203  
NC LIC NO. F-0165

A.G. & MARIE C. CAMPBELL  
IRREVOCABLE LIVING TRUST

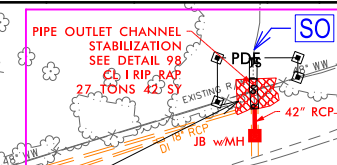

PROJECT REFERENCE NO.	SHEET NO.
1-3819B	15
R/W SHEET NO.	
ROADWAY DESIGN ENGINEER	HYDRAULICS ENGINEER
DOCUMENT NOT CONSIDERED FINAL UNLESS ALL SIGNATURES COMPLETED	




DENOTES TEMPORARY  
IMPACTS IN SURFACE WATER



DENOTES IMPACTS IN  
SURFACE WATER

SITE #28

SEE INSET

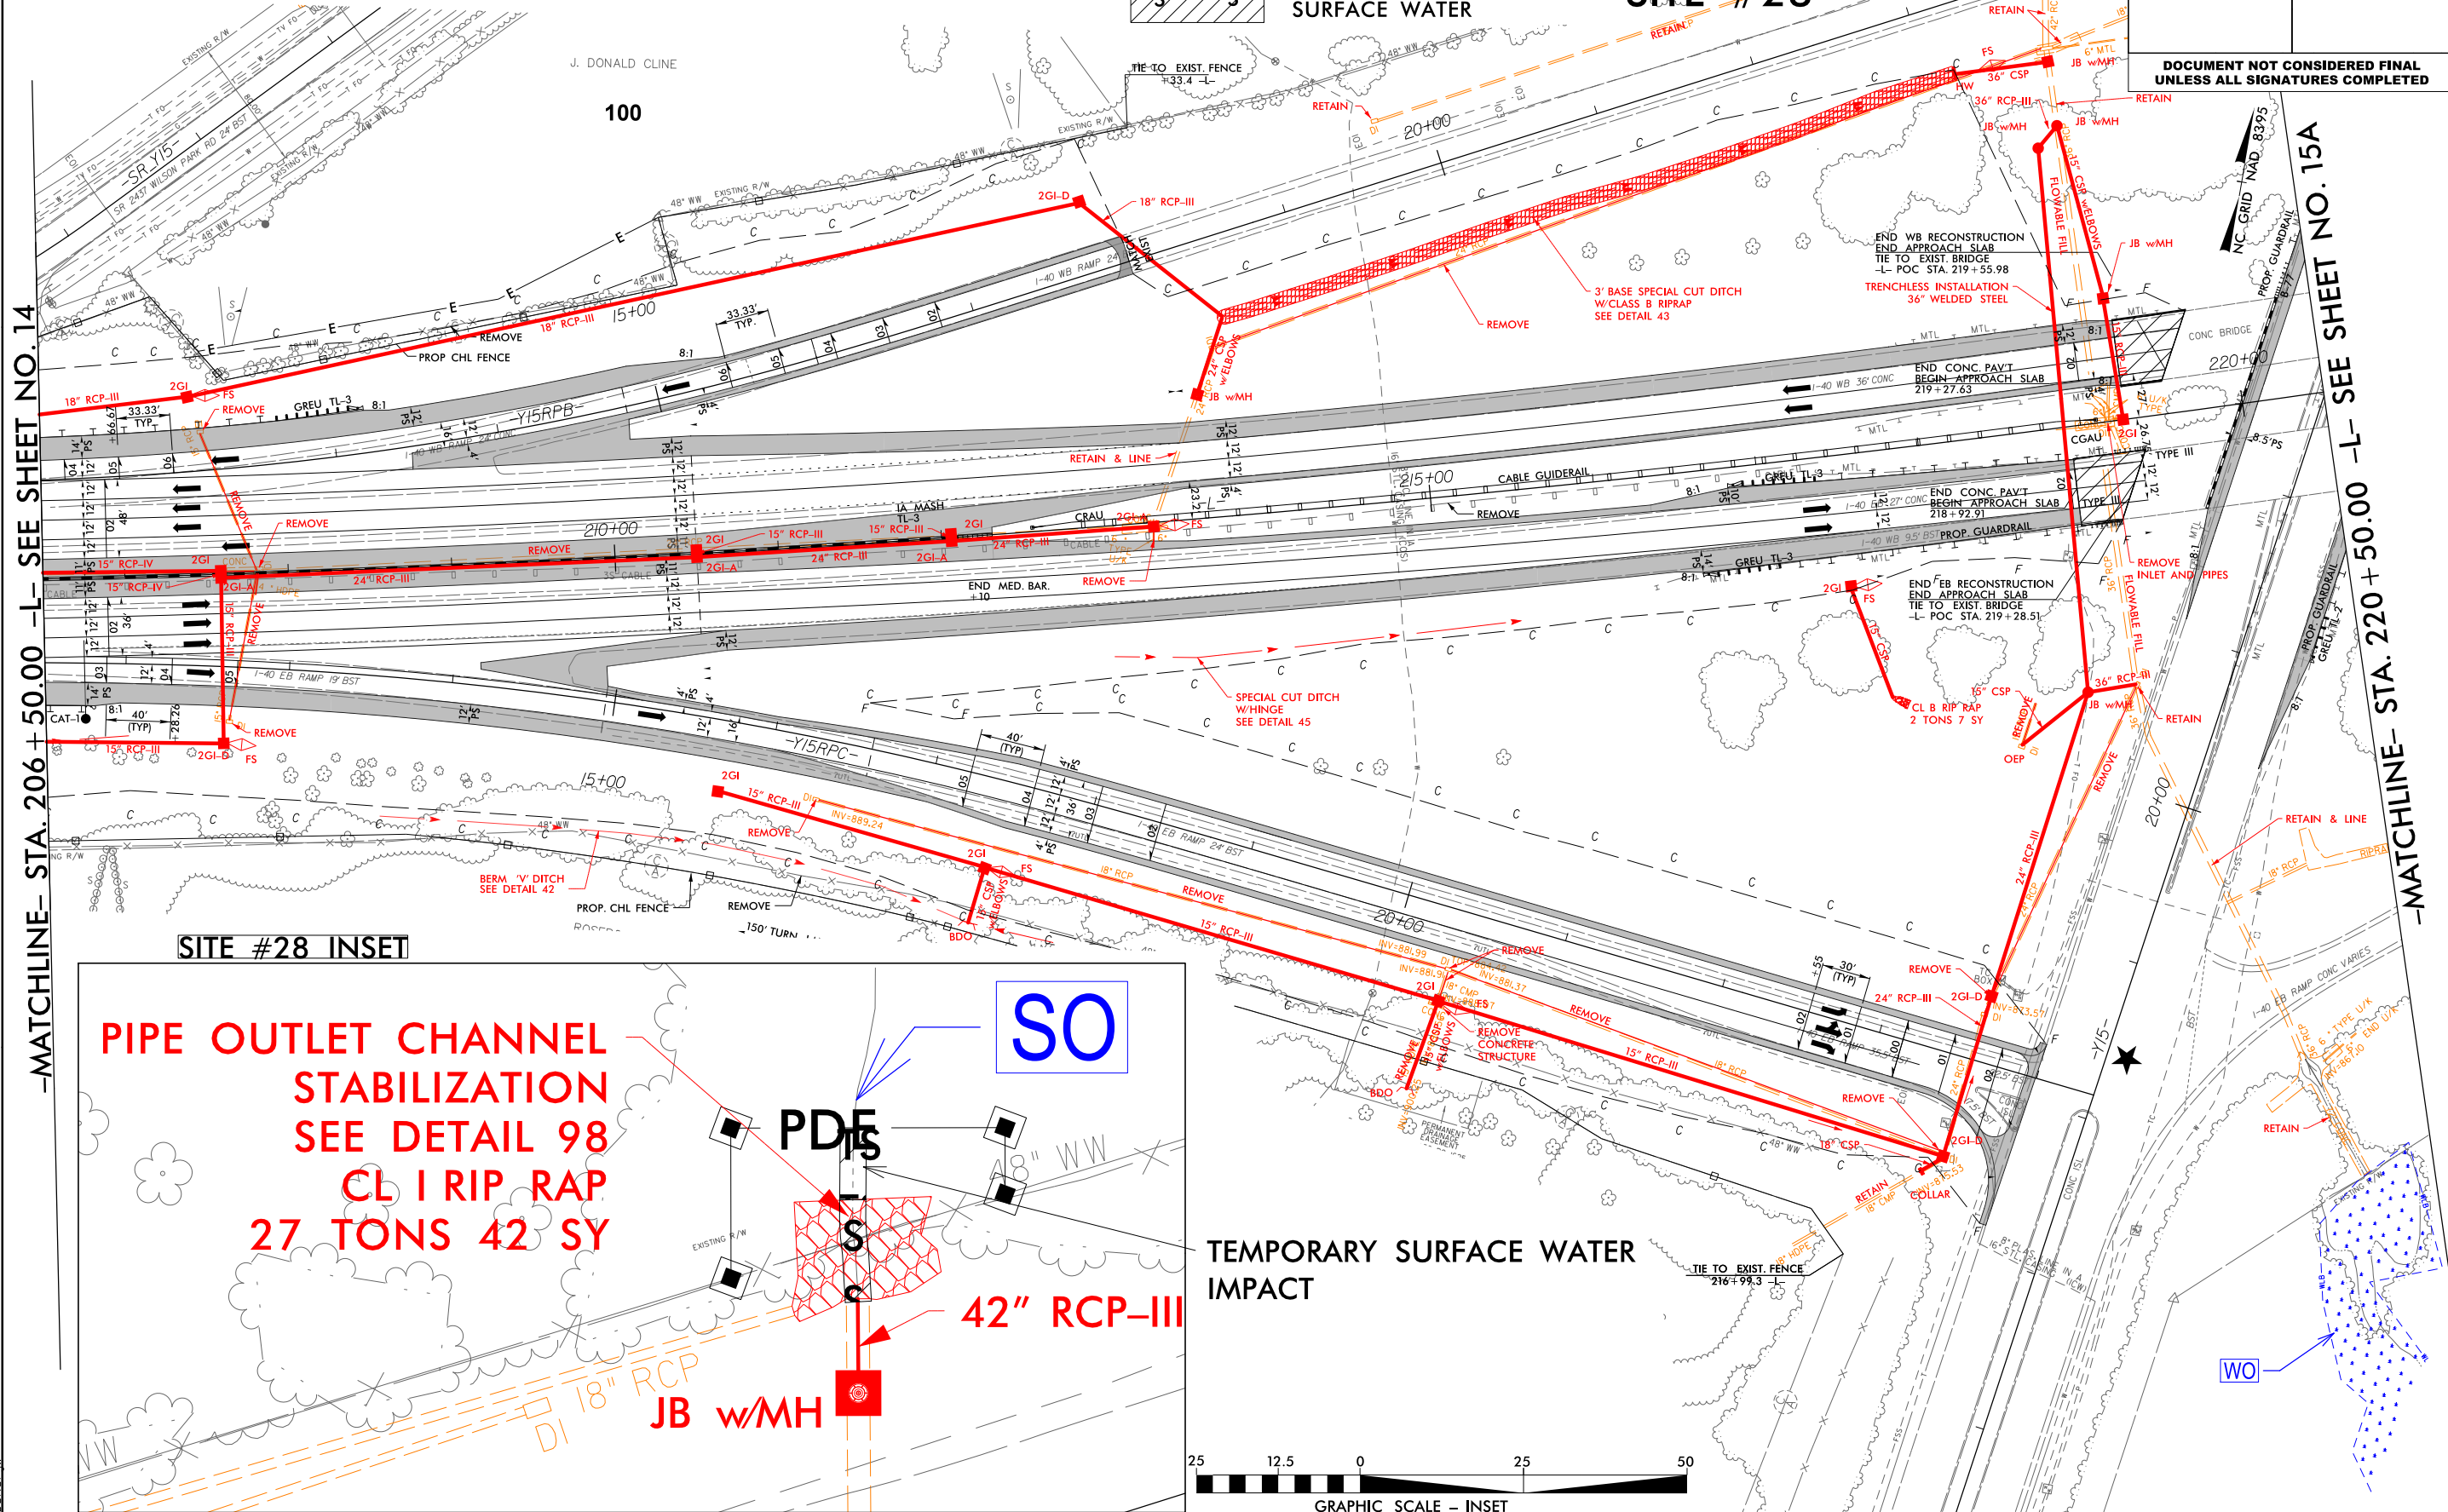

SITE #28 INSET

PIPE OUTLET CHANNEL  
STABILIZATION  
SEE DETAIL 98  
CL 1 RIP RAP  
27 TONS 42 SY

SO

PDE

42\"/>

JB w/MH


TEMPORARY SURFACE WATER  
IMPACT




10/21/2020  
c:\projectwise\pb\projectwise\nt\becker\_jw\40339329\13819\_hyd\_prm\_pah15.L20650-21770.dgn  
becker\_jw



PERMIT DRAWING  
SHEET 21b OF 67  
Rev. 11/02/2020

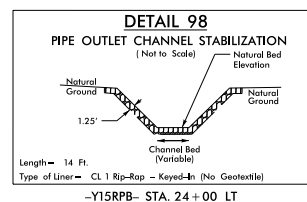

wsp 1001 Morehead Square Dr.,  
Suite 610, Charlotte, NC 28203  
NC LIC NO. F-0165

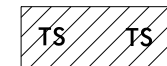

DENOTES TEMPORARY  
IMPACTS IN SURFACE WATER



DENOTES IMPACTS IN  
SURFACE WATER

SITE #28


SEE INSET

PROJECT REFERENCE NO.	SHEET NO.
I-3819B	15
RW SHEET NO.	
ROADWAY DESIGN ENGINEER	HYDRAULICS ENGINEER

DOCUMENT NOT CONSIDERED FINAL  
UNLESS ALL SIGNATURES COMPLETED

-MATCHLINE- STA. 206+50.00 -L- SEE SHEET NO. 14

SITE #28 INSET

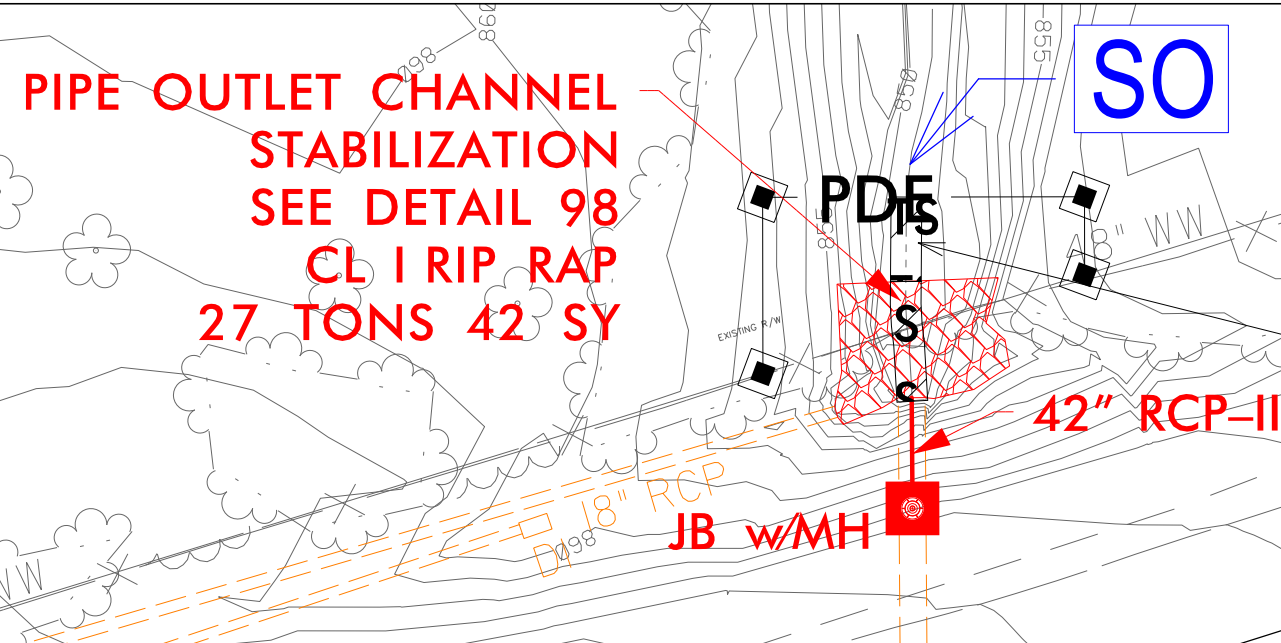


TEMPORARY SURFACE WATER  
IMPACT




-MATCHLINE- STA. 220+50.00 -L- SEE SHEET NO. 15A



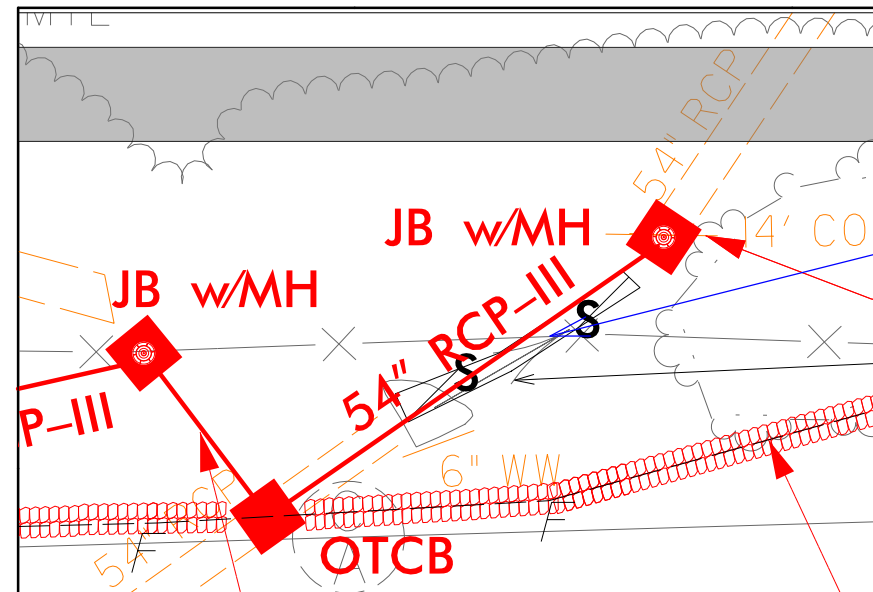


## INSET


## SITE #19

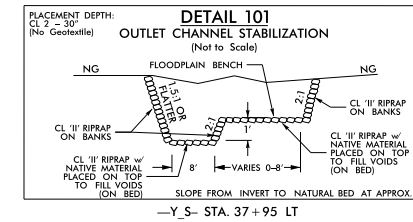

NC GRID NAD 83/95

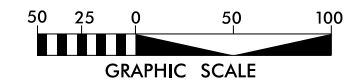


PERMIT DRAWING  
SHEET 26 OF 67  
Rev. 11/02/2020

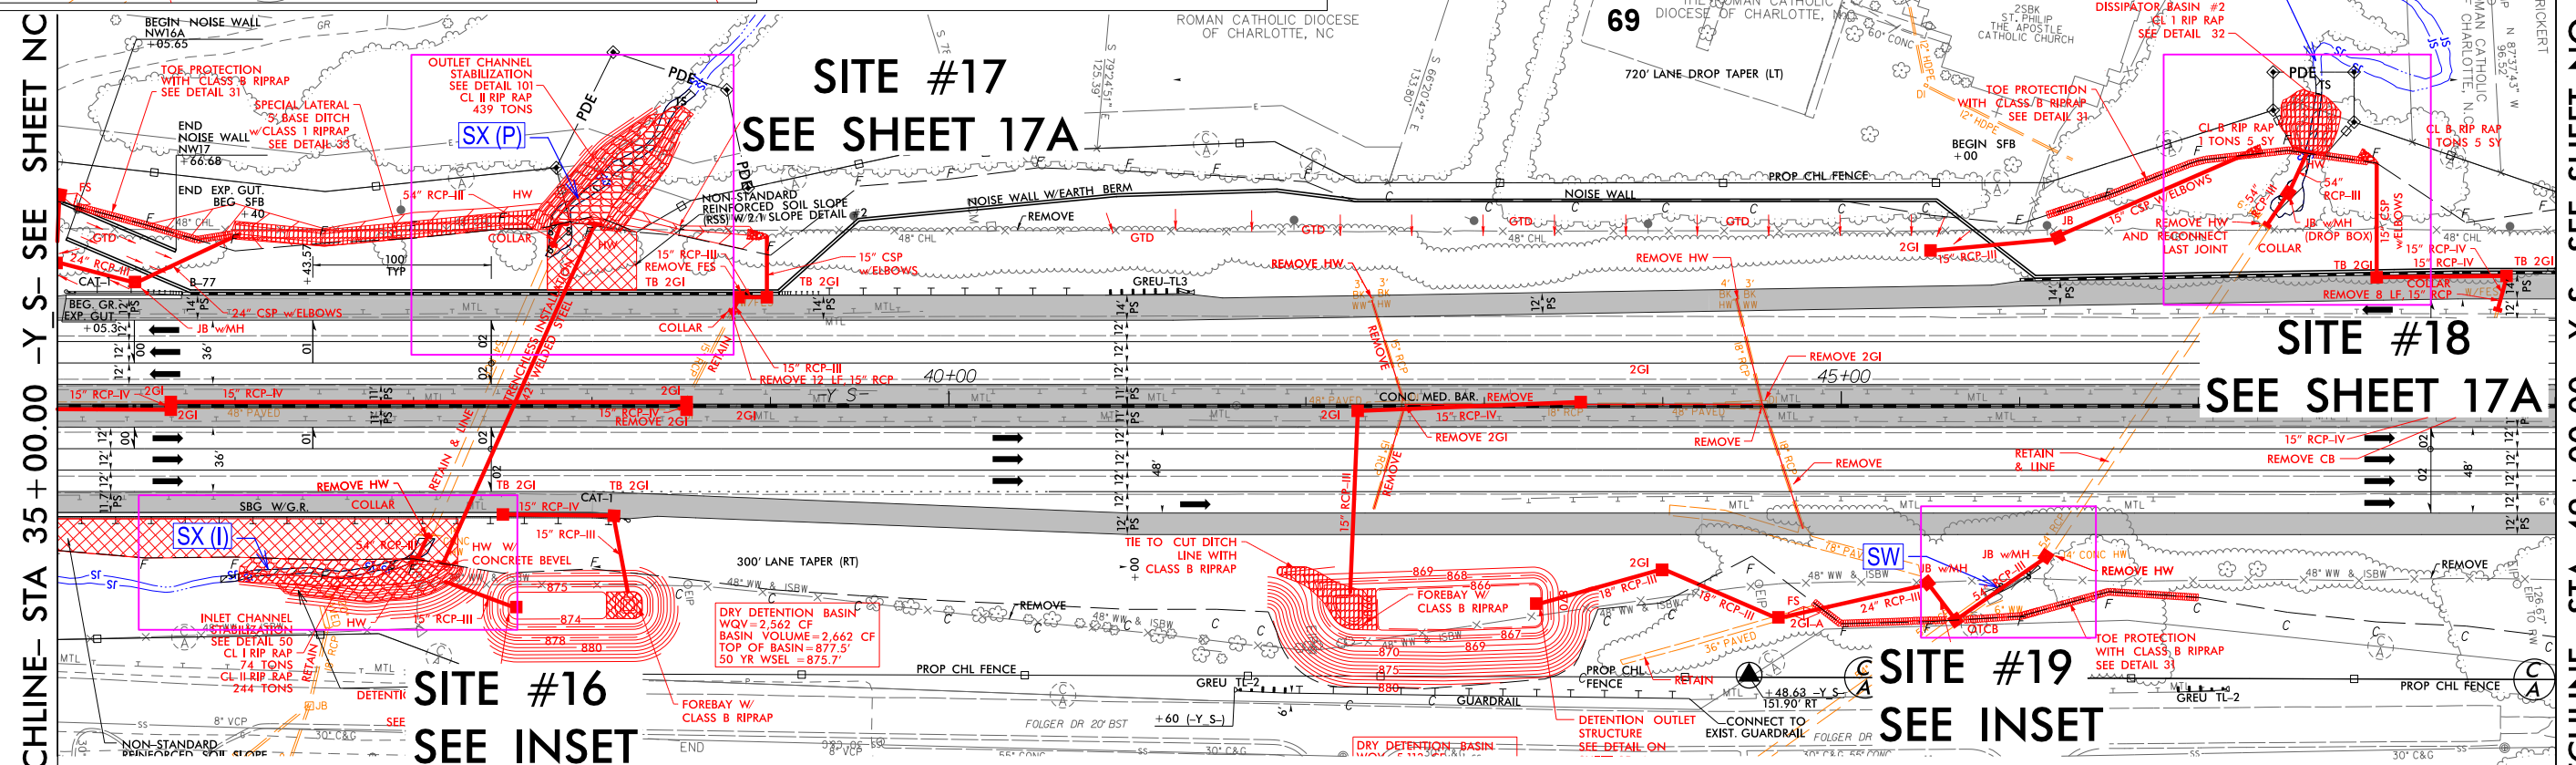


—MATCHLINE— STA 35 + 00.00 —Y S— SEE SHEET NC


-MA1CHLINE- SIA 49+00.00 -Y 5- SEE SHEET NO. 18

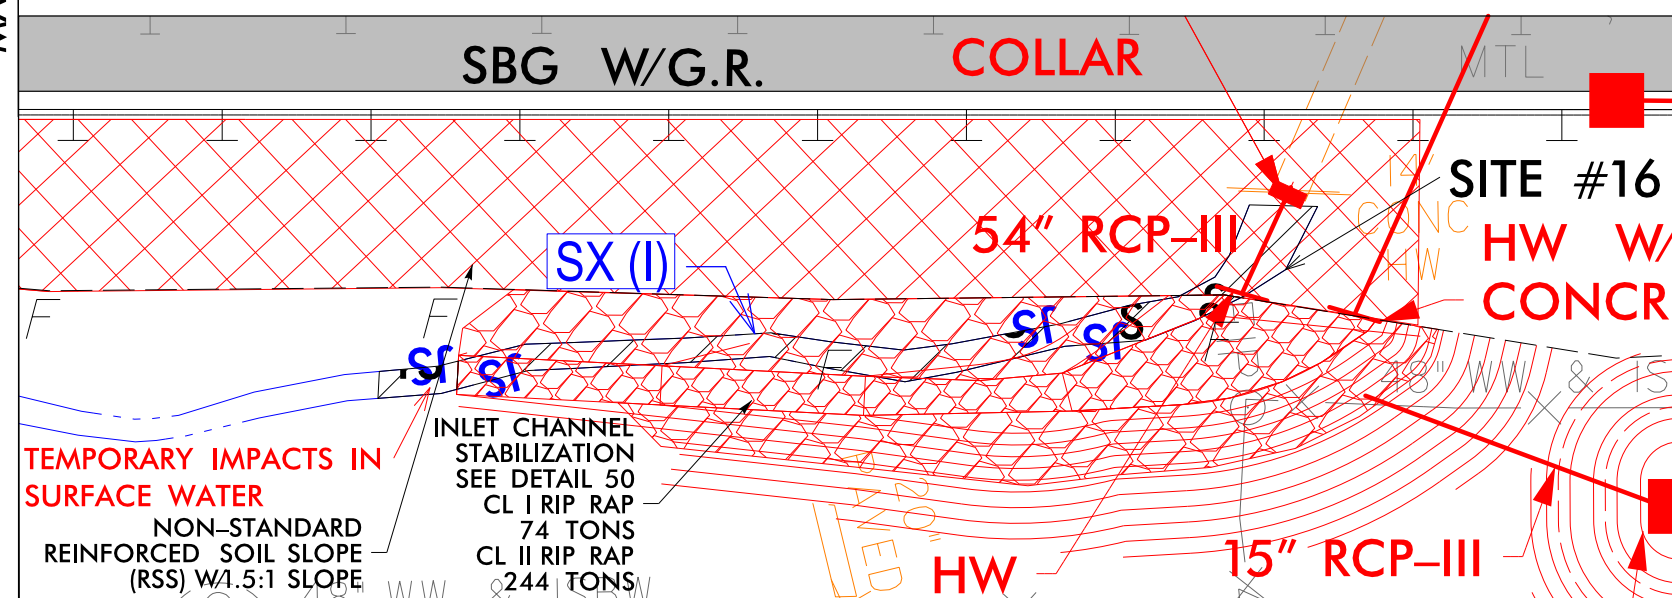

## INSET

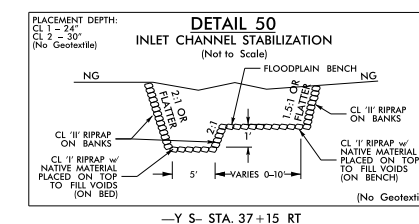

—Y S— STA. 37+15 RT

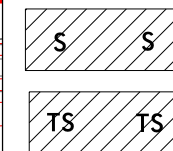DENOTES IMPACTS IN  
SURFACE WATERDENOTES TEMPORARY  
IMPACTS IN SURFACE WATER






1001 Morehead Square Dr.,  
Suite 610, Charlotte, NC 28203  
NC LIC NO. F-0165

PROJECT REFERENCE NO. I-3819B		SHEET NO. 17
RW SHEET NO.		
ROADWAY DESIGN ENGINEER		HYDRAULICS ENGINEER
DOCUMENT NOT CONSIDERED FINAL UNLESS ALL SIGNATURES COMPLETED		

NC GRID NAD 83/95

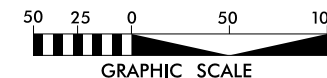


PERMIT DRAWING  
SHEET 27 OF 67  
Rev. 11/02/2020

INSET

SW

SITE #19

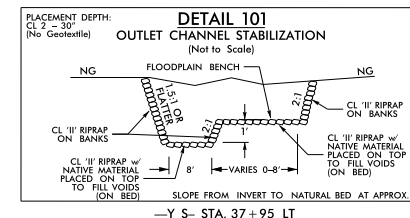

SITE #17  
SEE SHEET 17A


SITE #18  
SEE SHEET 17A

SITE #19  
SEE INSET



SITE #16  
SEE INSET

-MATCHLINE- STA 35 + 00.00 -Y S- SEE SHEET NC

-MATCHLINE- STA 49 + 00.00 -Y S- SEE SHEET NO.18

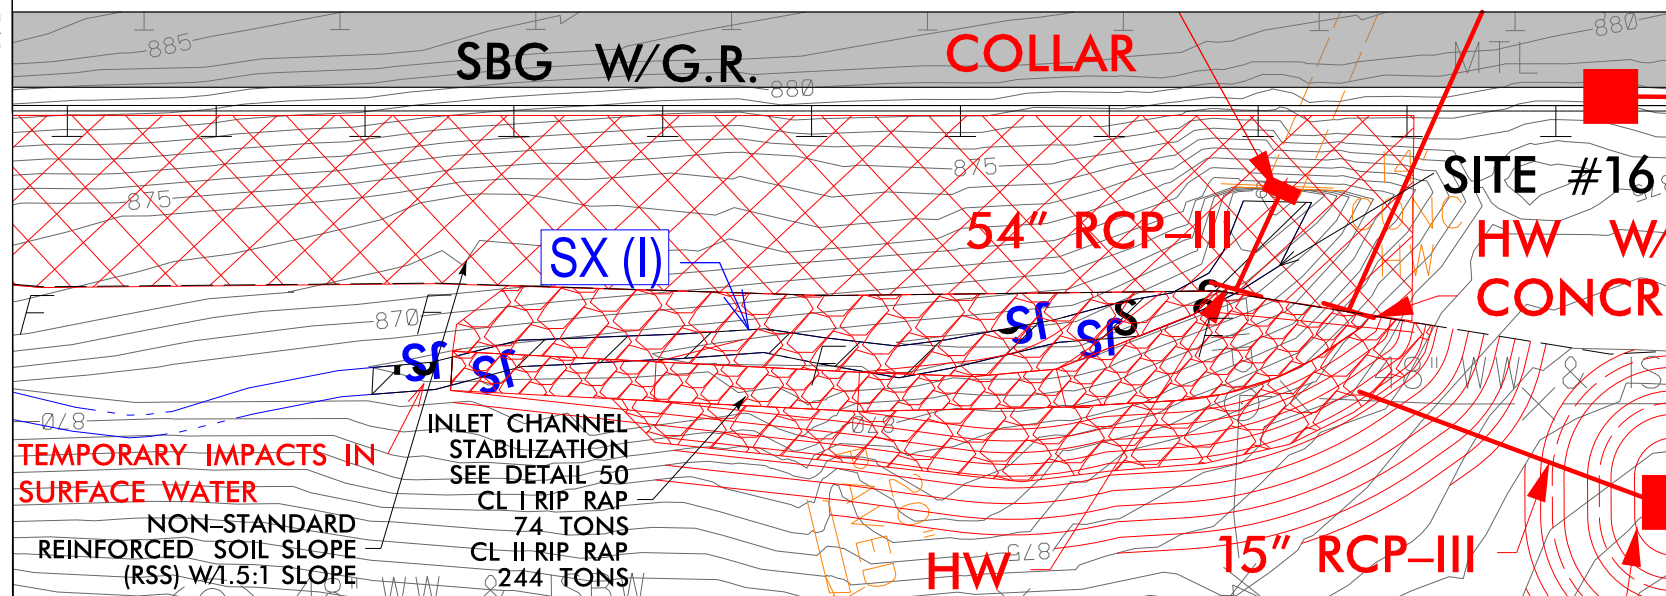

INSET

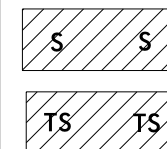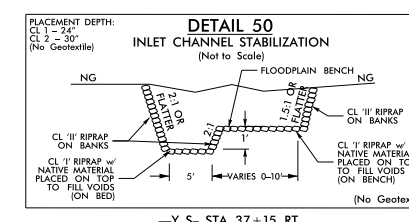

DENOTES IMPACTS IN  
SURFACE WATER


DENOTES TEMPORARY  
IMPACTS IN SURFACE WATER



10/13/2020  
GIS:\projects\wise\pb\project\wise\wsp\_victoria\kohlwey\_d0339329\13819\_hyd\_prm\_pah17\_Y3500-4900.dgn



## RIP-RAPPED ENERGY DISSIPATOR BASIN

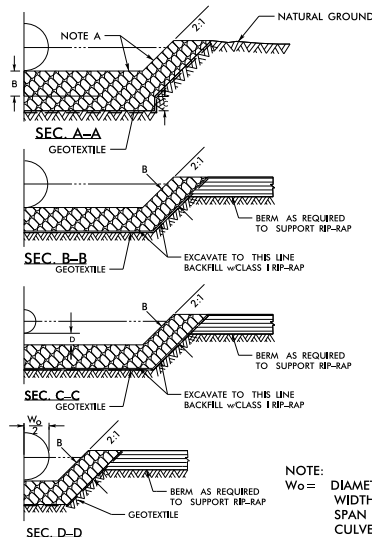


DIM.	RIP RAP BASIN #							
	1	2	3	4	5	6	7	8
A	30"	30"						
B	20"	20"						
C	16"	16"						
D	1'	1.25'						
E	3.5'	5.5'						
F	6.3'	10'						
G	10'	15'						
H								

BASIN #	LOCATION	(AT OUTLET)
1	-YRPC- 10 + 82, 127 RT	
2	-Y S= 47+61, 142 LT	
3		
4		
5		
6		
7		
8		

505

## OUTLET CHANNEL STABILIZATION

PLACEMENT DEPTH:  
CL 2 - 30"  
(No Geotextile)

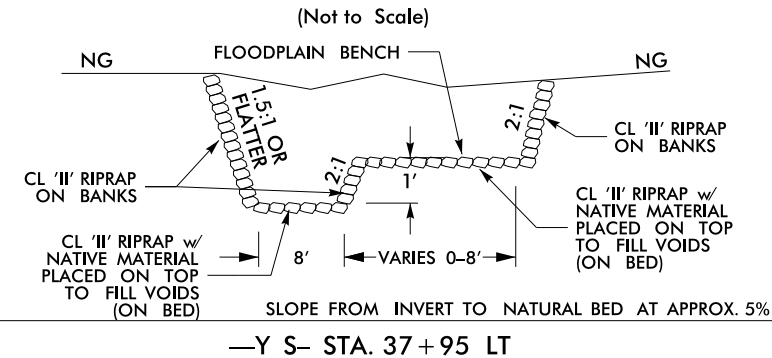

NC GRID + NAD 83/95

PERMIT DRAWING  
SHEET 28 OF 67  
Rev. 11/02/2020


 DENOTES IMPACTS IN SURFACE WATER

 DENOTES TEMPORARY  
IMPACTS IN SURFACE WATER



PROJECT REFERENCE NO.	SHEET NO.
<i>1-3819B</i>	<i>17A</i>
RW SHEET NO.	
ROADWAY DESIGN ENGINEER	HYDRAULICS ENGINEER
<p><b>DOCUMENT NOT CONSIDERED FINAL UNLESS ALL SIGNATURES COMPLETED</b></p>	


## TEMPORARY IMPACTS IN SURFACE WATER

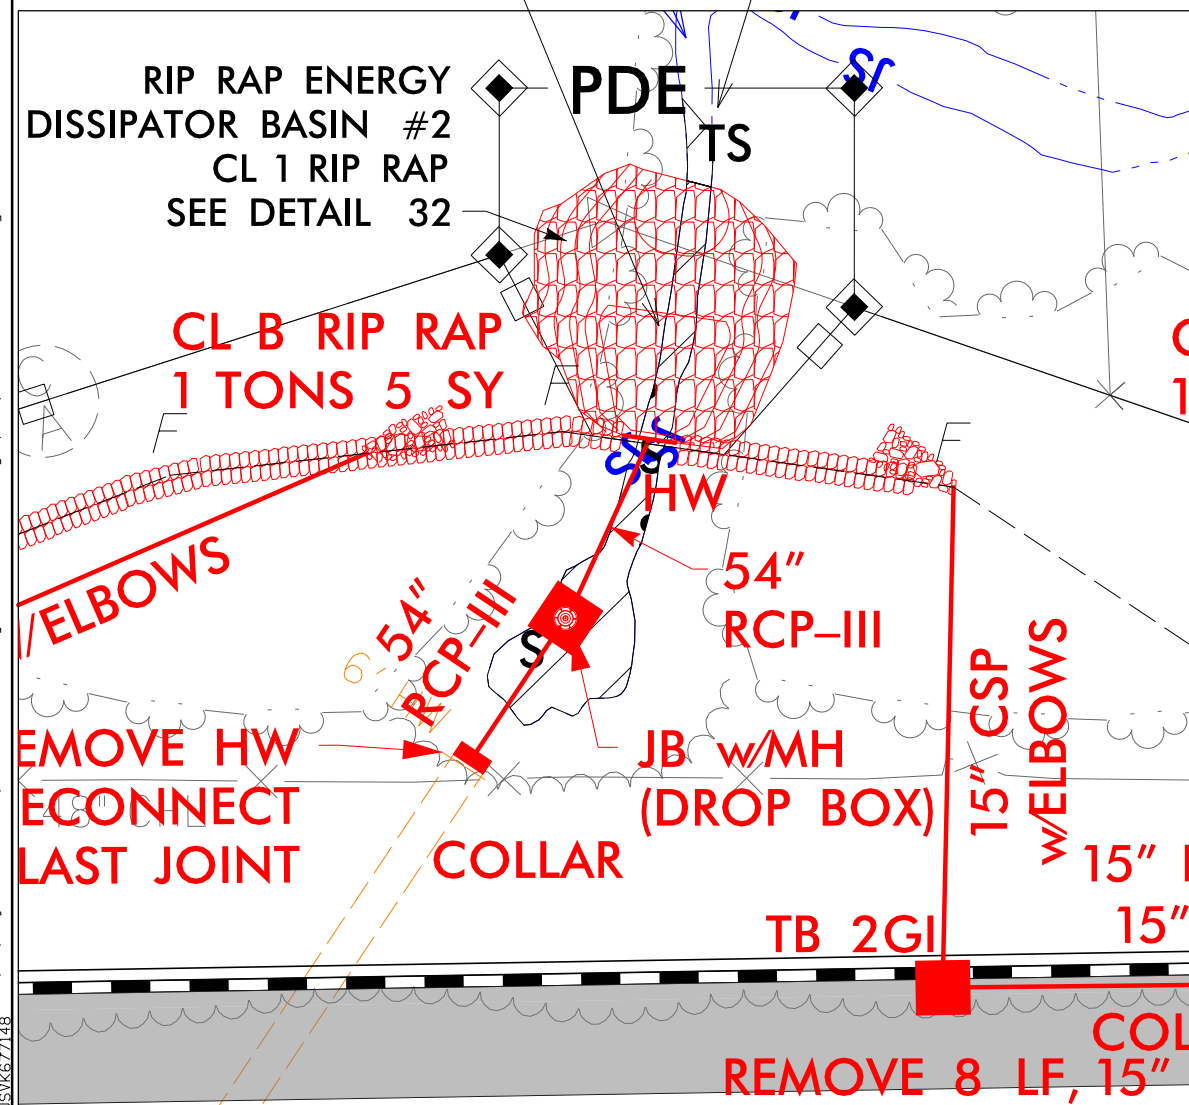

## INSET

OUTLET CHANNEL  
STABILIZATION  
SEE DETAIL 101  
CL II RIP RAP  
439 TONS

SX (P)

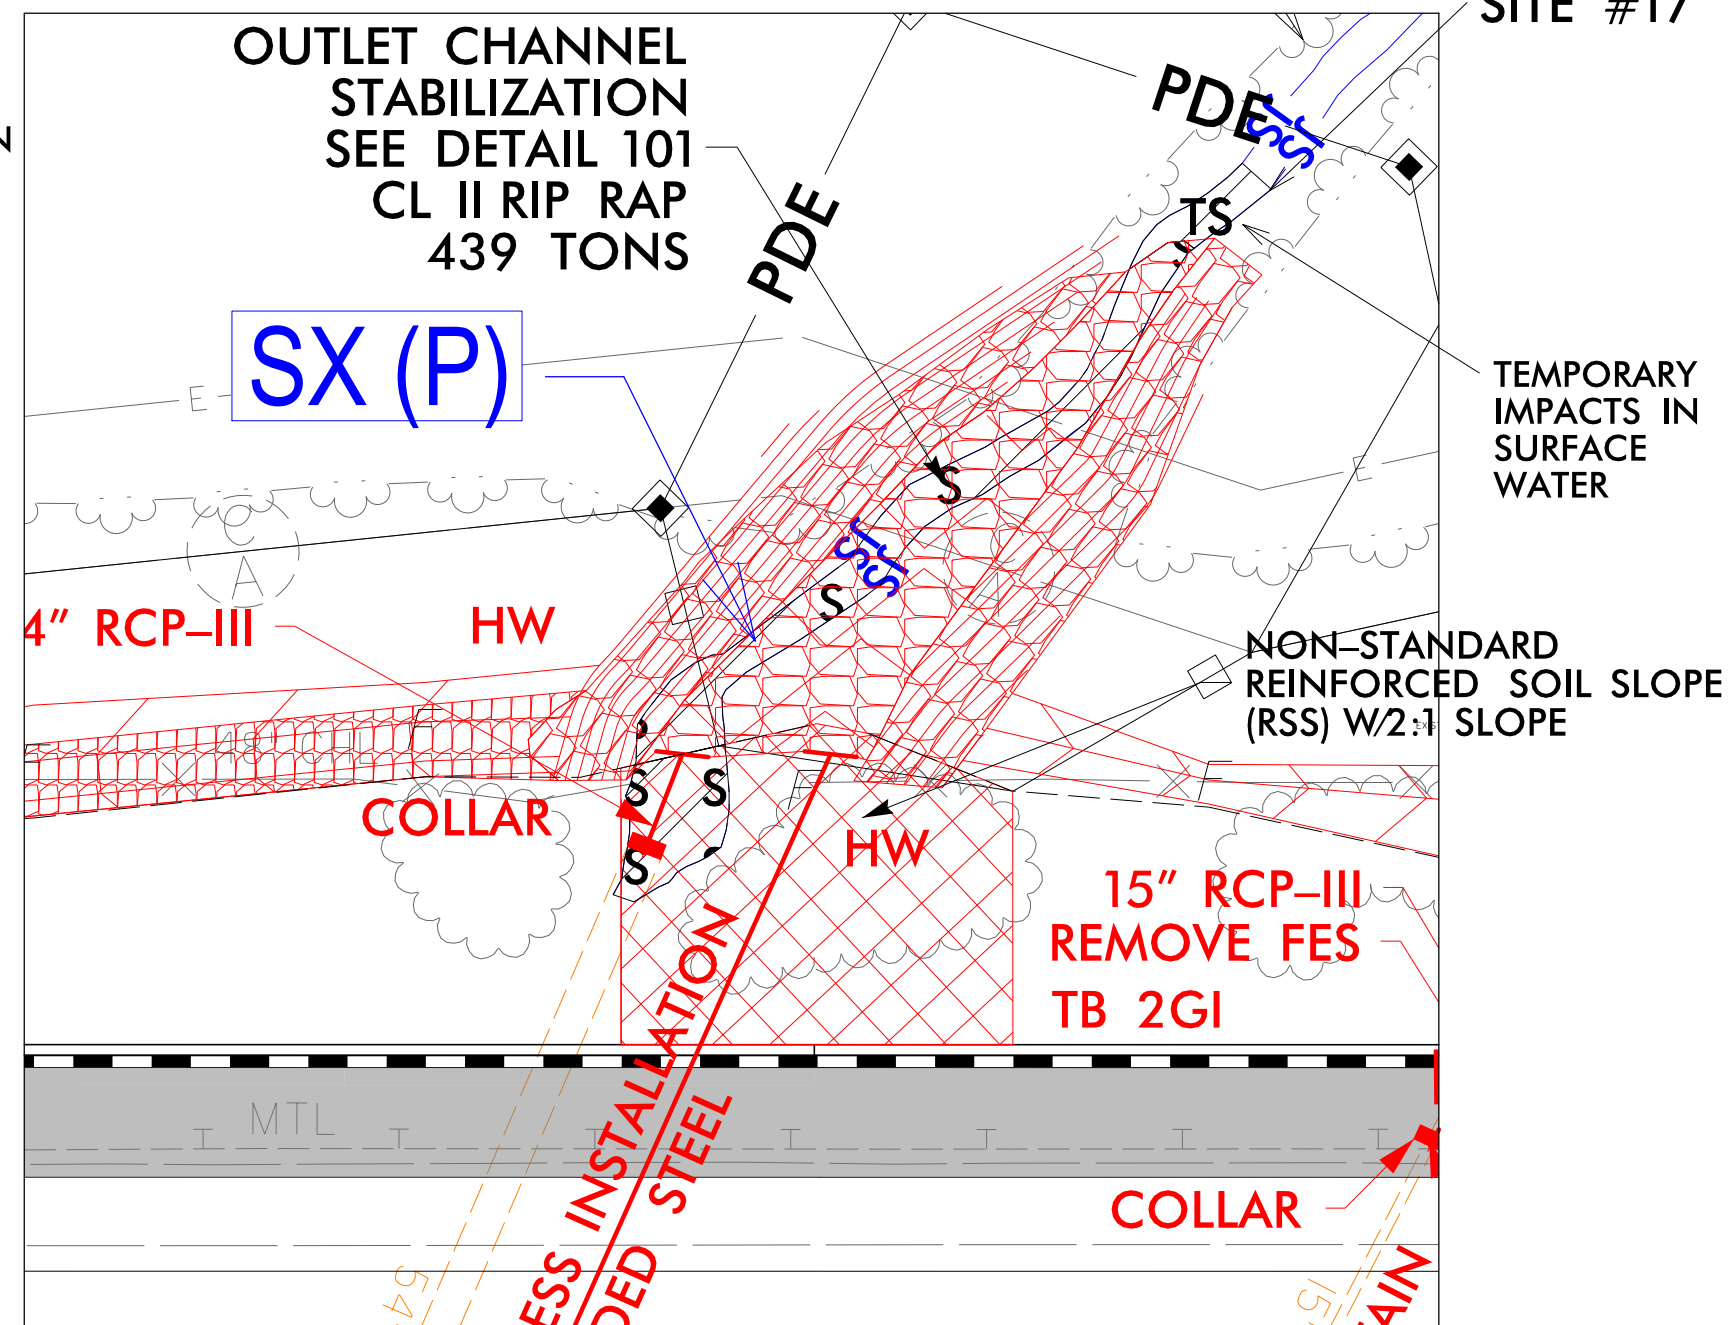

0/15/2020  
\\fs1\projectwise\wsp--victoria.kohlwey\d0339329\13819\_hyd\_prm-psl17A\_Y3500-4900.dgn  
\\fs1\projectwise\wsp--victoria.kohlwey\d0339329\13819\_hyd\_prm-psl17A\_Y3500-4900.dgn





PERMIT DRAWING  
SHEET 30 OF 67  
Rev. 11/02/2020


PROJECT REFERENCE NO. 17-3898		SHEET NO. 30
ROADWAY DESIGN ENGINEER		HYDRAULICS ENGINEER
DOCUMENT NOT CONSIDERED FINAL UNLESS ALL SIGNATURES COMPLETED		

NC GRID NAD 8395

5 5 DENOTES IMPACTS IN SURFACE WATER

15 15 DENOTES TEMPORARY IMPACTS IN SURFACE WATER

50 25 0 50 100  
GRAPHIC SCALE

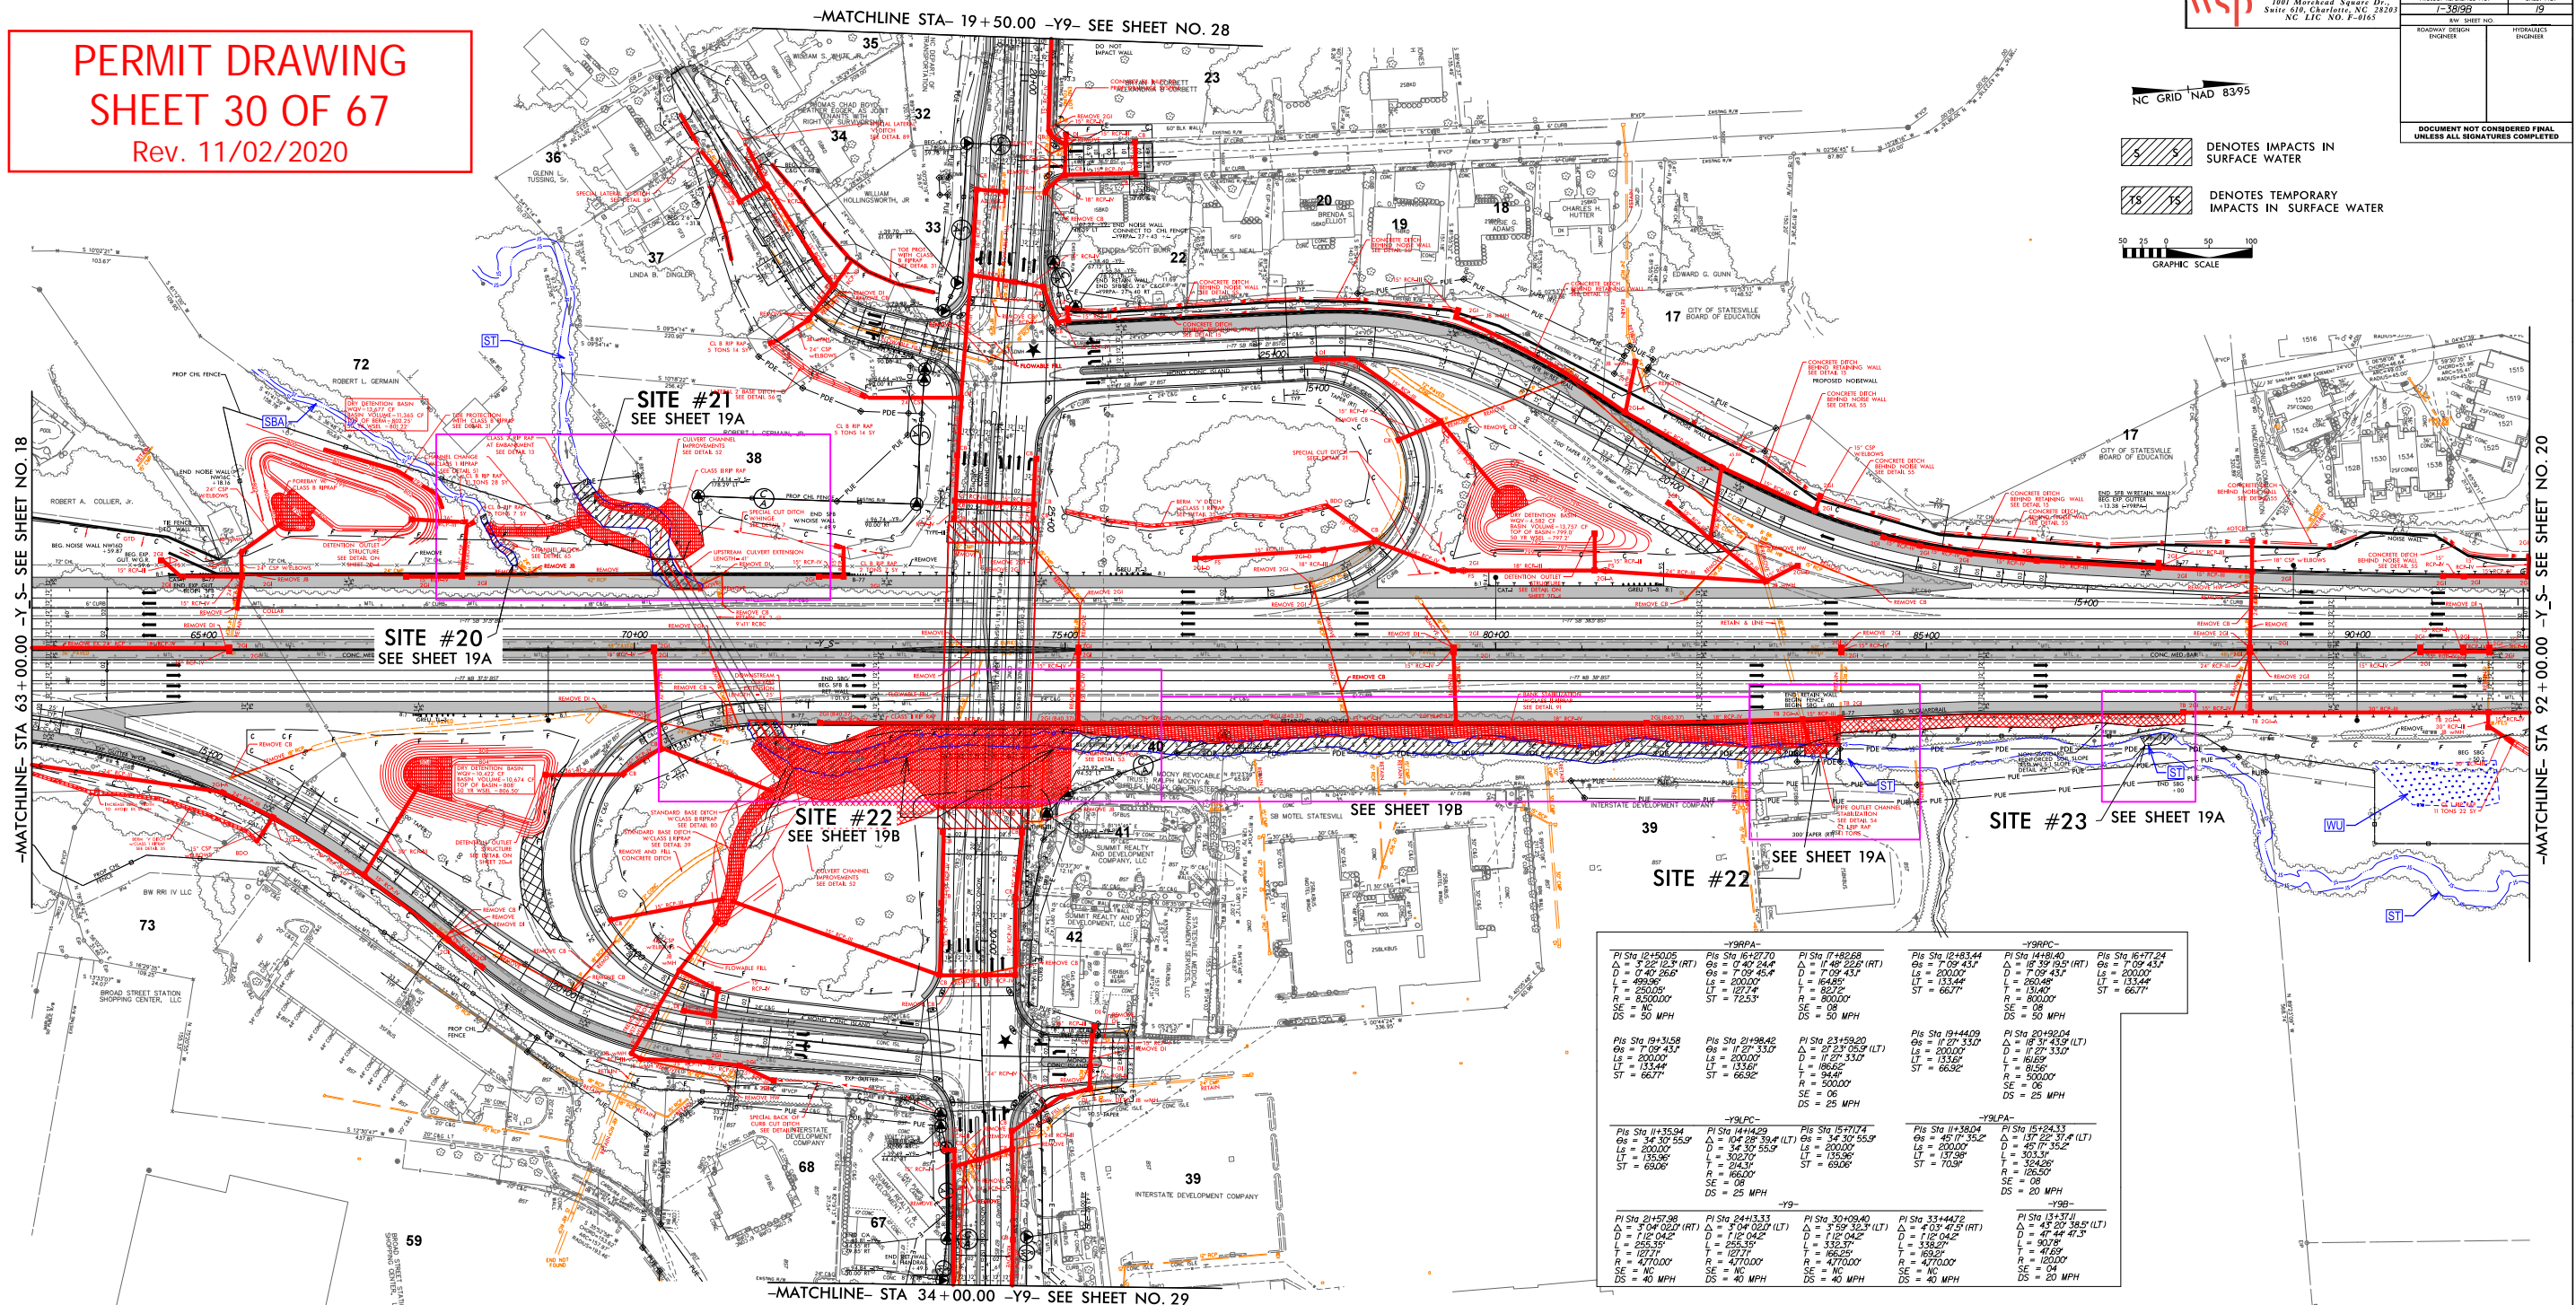

<b>-Y9RPA-</b> PI Sta 12+50.05 Δ = 3' 22" (2.3' RT) D = 7' 40" 24.4" L = 493.95' T = 250.00' R = 8200.00' SE = NC DS = 50 MPH	<b>-Y9RPA-</b> PI Sta 16+127.70 Δ = 0' 40" 24.4" D = 7' 09" 45.4" L = 200.00' T = 127.74' R = 725.3' SE = NC DS = 50 MPH	<b>-Y9RPA-</b> PI Sta 17+82.68 Δ = 1' 48" 22.6' (RT) D = 7' 09" 43.1" L = 164.95' T = 82.72' R = 800.00' SE = 08 DS = 50 MPH	<b>-Y9RPA-</b> PI Sta 12+83.44 Δ = 1' 48" 22.6' (RT) D = 7' 09" 43.1" L = 200.00' T = 133.44' R = 800.00' SE = 08 DS = 50 MPH	<b>-Y9RPA-</b> PI Sta 16+177.24 Δ = 0' 39" 19.5' (RT) D = 7' 09" 43.1" L = 200.00' T = 133.44' R = 800.00' SE = 08 DS = 50 MPH
<b>-Y9LPC-</b> PI Sta 19+31.58 Δ = 1' 09" 43.1" D = 200.00' L = 133.44' T = 66.77' R = 800.00' SE = 08 DS = 50 MPH	<b>-Y9LPC-</b> PI Sta 21+98.42 Δ = 1' 27" 33.0" D = 200.00' L = 133.44' T = 66.77' R = 800.00' SE = 08 DS = 50 MPH	<b>-Y9LPC-</b> PI Sta 23+59.20 Δ = 0' 39" 19.5' (LT) D = 1' 27" 33.0" L = 164.95' T = 82.72' R = 500.00' SE = 08 DS = 25 MPH	<b>-Y9LPC-</b> PI Sta 19+44.09 Δ = 1' 27" 33.0" D = 200.00' L = 133.44' T = 66.77' R = 800.00' SE = 08 DS = 50 MPH	<b>-Y9LPC-</b> PI Sta 20+92.04 Δ = 0' 39" 19.5' (LT) D = 1' 27" 33.0" L = 164.95' T = 82.72' R = 500.00' SE = 08 DS = 25 MPH
<b>-Y9LPC-</b> PI Sta 11+35.94 Δ = 3' 40" 55.9" D = 200.00' L = 133.44' T = 66.77' R = 800.00' SE = 08 DS = 25 MPH	<b>-Y9LPC-</b> PI Sta 14+14.29 Δ = 1' 04" 39.94' (LT) D = 3' 40" 55.9" L = 302.70' T = 151.35' R = 166.00' SE = 08 DS = 25 MPH	<b>-Y9LPC-</b> PI Sta 15+77.74 Δ = 3' 40" 55.9" D = 200.00' L = 133.44' T = 66.77' R = 800.00' SE = 08 DS = 25 MPH	<b>-Y9LPC-</b> PI Sta 11+38.04 Δ = 45' 17" 35.2" D = 200.00' L = 133.44' T = 66.77' R = 800.00' SE = 08 DS = 20 MPH	<b>-Y9LPC-</b> PI Sta 15+24.33 Δ = 1' 27" 33.0" D = 200.00' L = 133.44' T = 66.77' R = 800.00' SE = 08 DS = 20 MPH
<b>-Y9-</b> PI Sta 21+57.98 Δ = 1' 12" 04.2" D = 200.00' L = 133.44' T = 66.77' R = 477.000' SE = NC DS = 40 MPH	<b>-Y9-</b> PI Sta 24+13.33 Δ = 1' 12" 04.2" D = 200.00' L = 133.44' T = 66.77' R = 477.000' SE = NC DS = 40 MPH	<b>-Y9-</b> PI Sta 30+08.40 Δ = 1' 12" 04.2" D = 200.00' L = 133.44' T = 66.77' R = 477.000' SE = NC DS = 40 MPH	<b>-Y9-</b> PI Sta 33+44.72 Δ = 1' 12" 04.2" D = 200.00' L = 133.44' T = 66.77' R = 477.000' SE = NC DS = 40 MPH	<b>-Y9-</b> PI Sta 13+37.11 Δ = 45' 22" 38.5' (LT) D = 47' 44" 47.3" L = 90.78' T = 47.69' R = 120.00' SE = 04 DS = 20 MPH

NOTE: PER COMMENTS RECEIVED FROM NCDOT ON 10/16/20, JS LINES HAVE BEEN MODIFIED ALONG SITES 21, 22, AND 23 TO FOLLOW THE SURVEYED TOPOGRAPHY. NO RIPRAP WILL BE PLACED IN THE STREAM BED ALONG AREAS OF BANK STABILIZATION.

LOCATION: 1/7 AT E. BROAD STREET	
TP NO. 1-3898	COUNTY: BEDELL
DESIGNED BY: C. DAVE	
CHECKED BY: D. ANDREWS	DATE: 6-3-2017



[illegible]

LOCATION: 1-77 AT E. BROAD STREET


TP NO. 1-3819B COUNTY: BDELL

DESIGNED BY: C. DAVIS

CHECKED BY: D. ARNSWORTH DATE: 6-2-2019





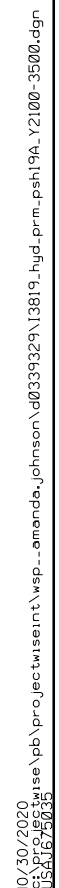




**WSP** 1001 Morehead Square Dr.,  
Suite 610, Charlotte, NC 28203  
NC LIC NO. F-0165

3	PROJECT REFERENCE NO.	SHEET NO.
	1-38/19B	19B
	RW SHEET NO.	
	ROADWAY DESIGN ENGINEER	HYDRAULICS ENGINEER
	<p align="center"><b>DOCUMENT NOT CONSIDERED FINAL UNLESS ALL SIGNATURES COMPLETED</b></p>	

## INSET




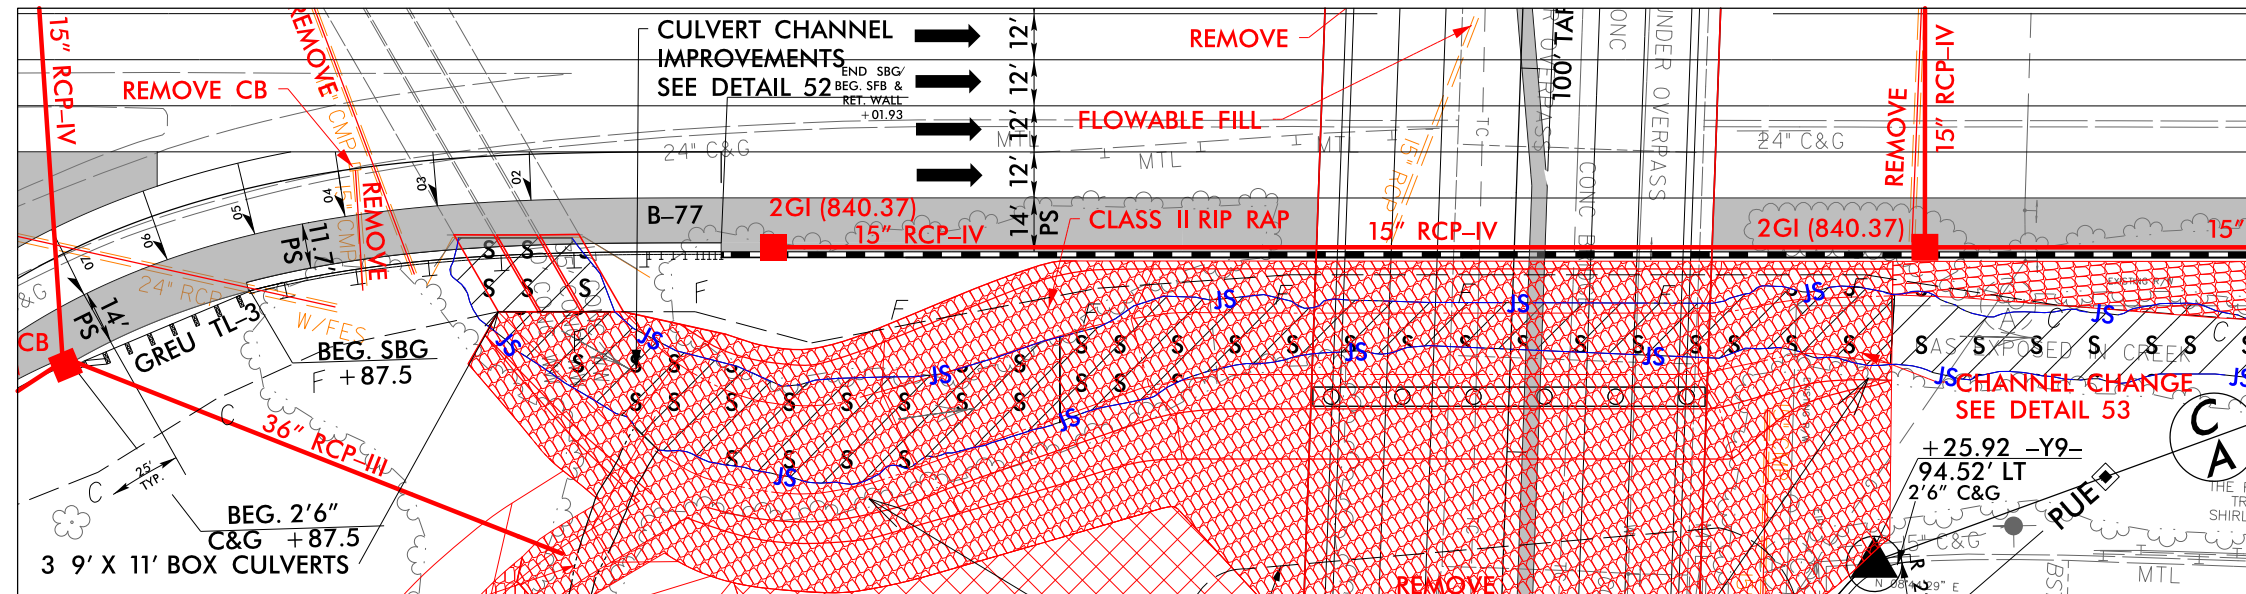


## SITE #22


## SITE #22


## INSET

BANK STABILIZATION  
SEE DETAIL 91

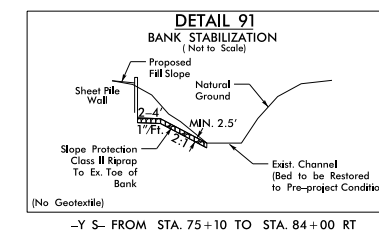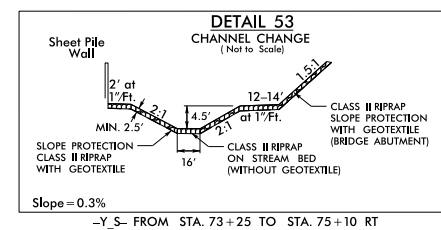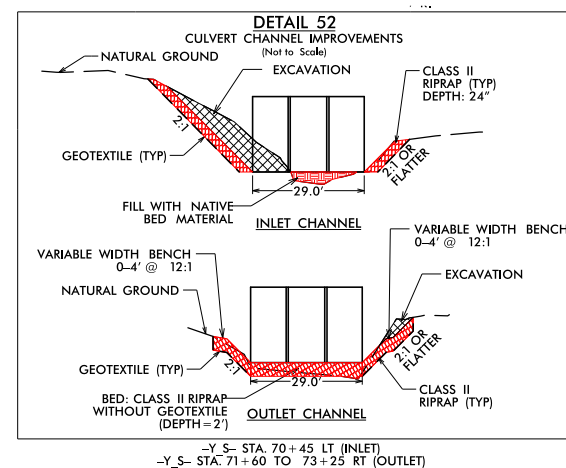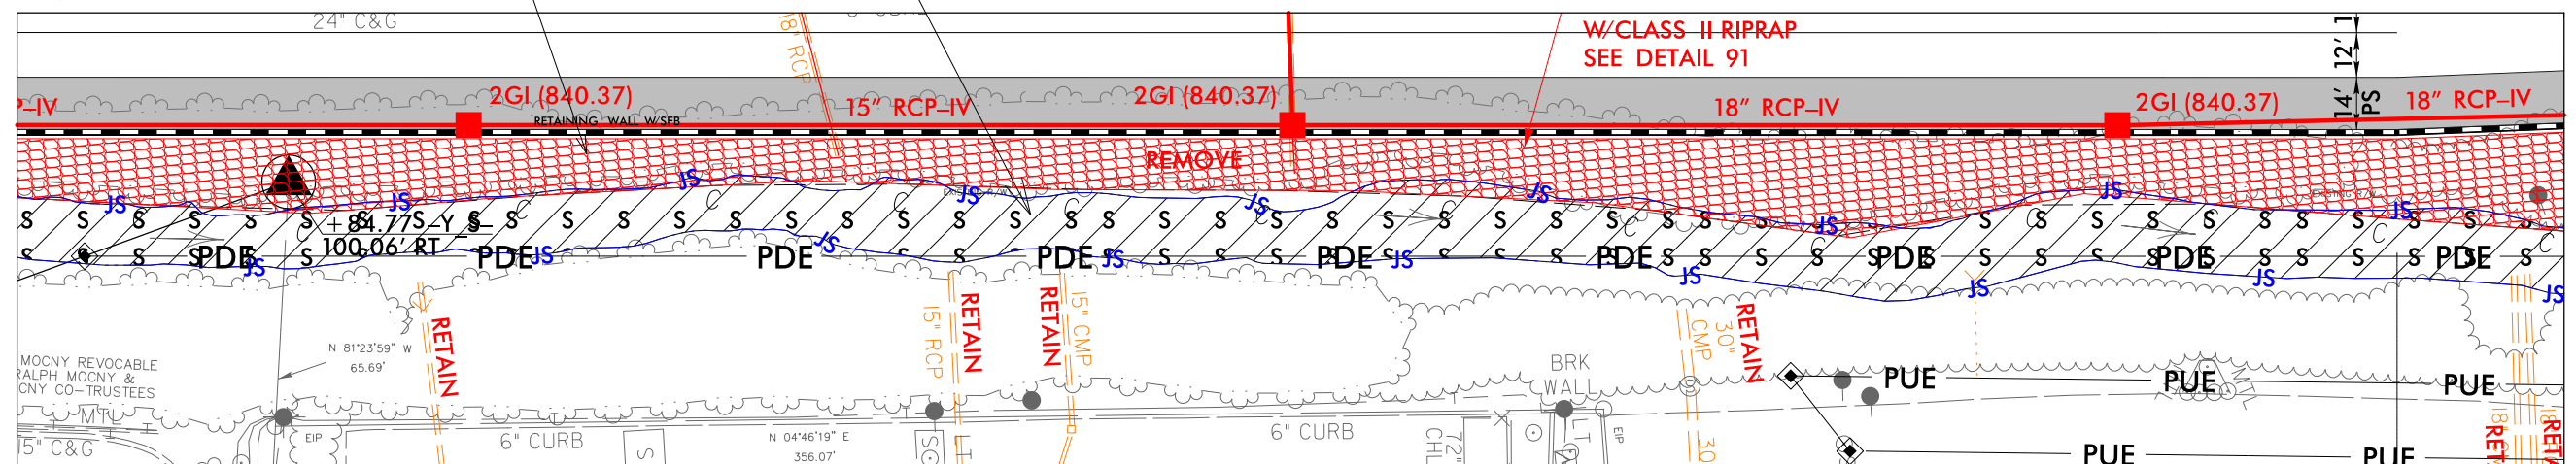

NC GRID | NAD 83/95

 DENOTES IMPACTS IN SURFACE WATER

 DENOTES TEMPORARY IMPACTS IN SURFACE WATER




10/30/2020  
c:\project\wise\wsp--amanda.johnson\d0339329\13819\_hjd\_prm\_psh198\_y2100-3500.dgn  
USAj675035



**WSP** 1001 Morehead Square Dr.,  
Suite 610, Charlotte, NC 28203  
NC LIC NO. F-0165

3	PROJECT REFERENCE NO.	SHEET NO.
	<i>1-38/19B</i>	<i>19B</i>
	R/W SHEET NO.	
	ROADWAY DESIGN ENGINEER	HYDRAULICS ENGINEER
	<p align="center"><b>DOCUMENT NOT CONSIDERED FINAL UNLESS ALL SIGNATURES COMPLETED</b></p>	

PERMIT DRAWING  
SHEET 35 OF 67  
Rev. 11/02/2020




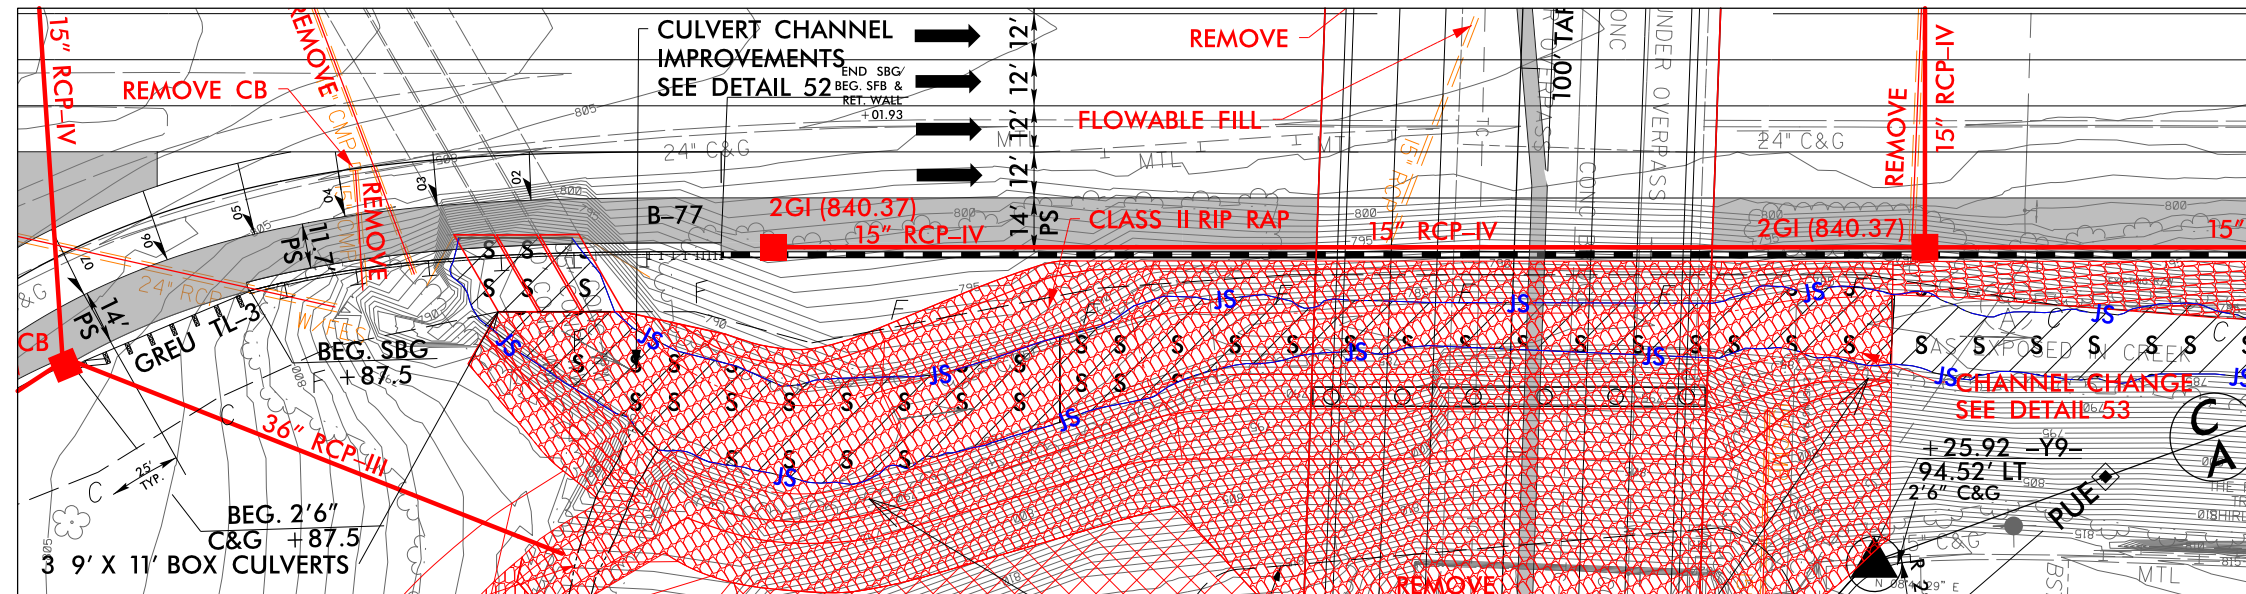


## SITE #22

## SITE #22

## INSET

BANK STABILIZATION  
SEE DETAIL 91

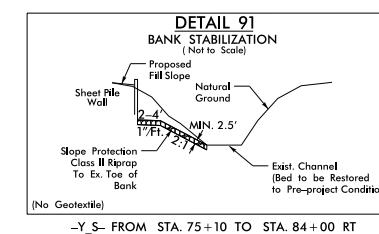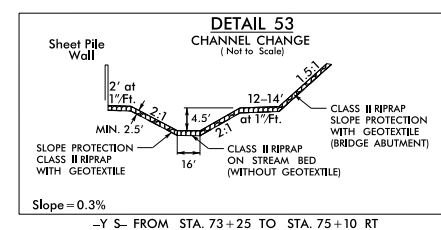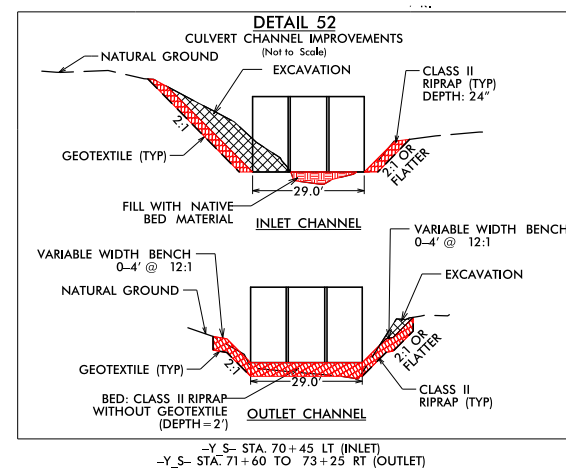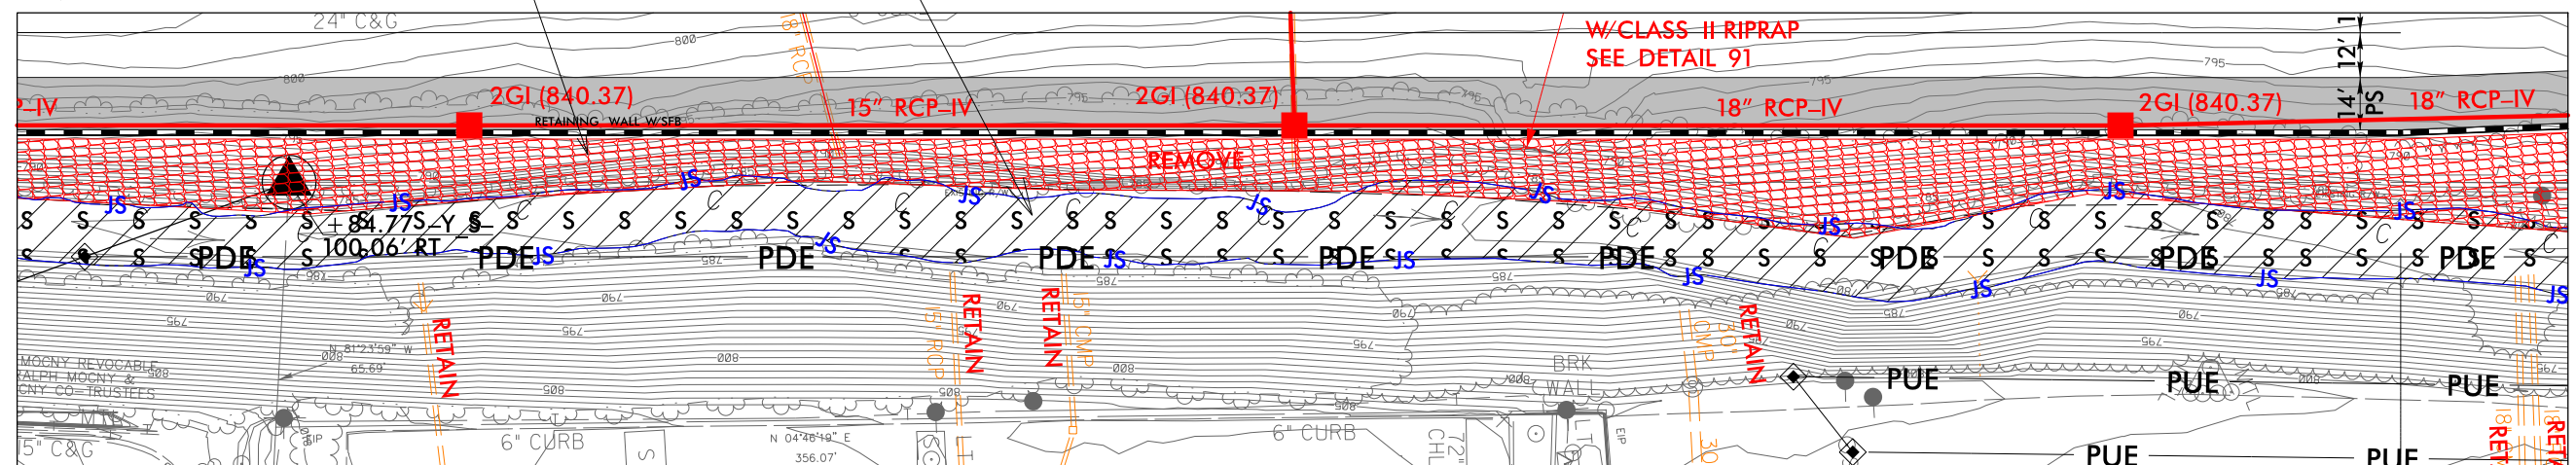

NC GRID | NAD 83/95

A rectangular region with diagonal hatching (lines from top-left to bottom-right). Inside the rectangle, there are two 'S' labels, one on the left and one on the right.

DENOTES IMPACTS IN  
SURFACE WATER

TS TS

DENOTES TEMPORARY  
IMPACTS IN SURFACE WATER

10/30/2020  
c:\project\wise\wsp--amanda.johnson\d0339329\13819\_hjd\_prm\_psh198\_y2100-3500.dgn  
USAJ675035






1001 Morehead Square Dr.,  
Suite 610, Charlotte, NC 28203  
NC LIC NO. F-0165

PROJECT REFERENCE NO. I-3819B		SHEET NO. 20
RW SHEET NO.		
ROADWAY DESIGN ENGINEER		HYDRAULICS ENGINEER
DOCUMENT NOT CONSIDERED FINAL UNLESS ALL SIGNATURES COMPLETED		

-MATCHLINE- STA 92+00.00 -Y\_S- SEE SHEET NO. 19

-MATCHLINE- STA. 106+00 -Y\_S- SEE SHEET NO. 21

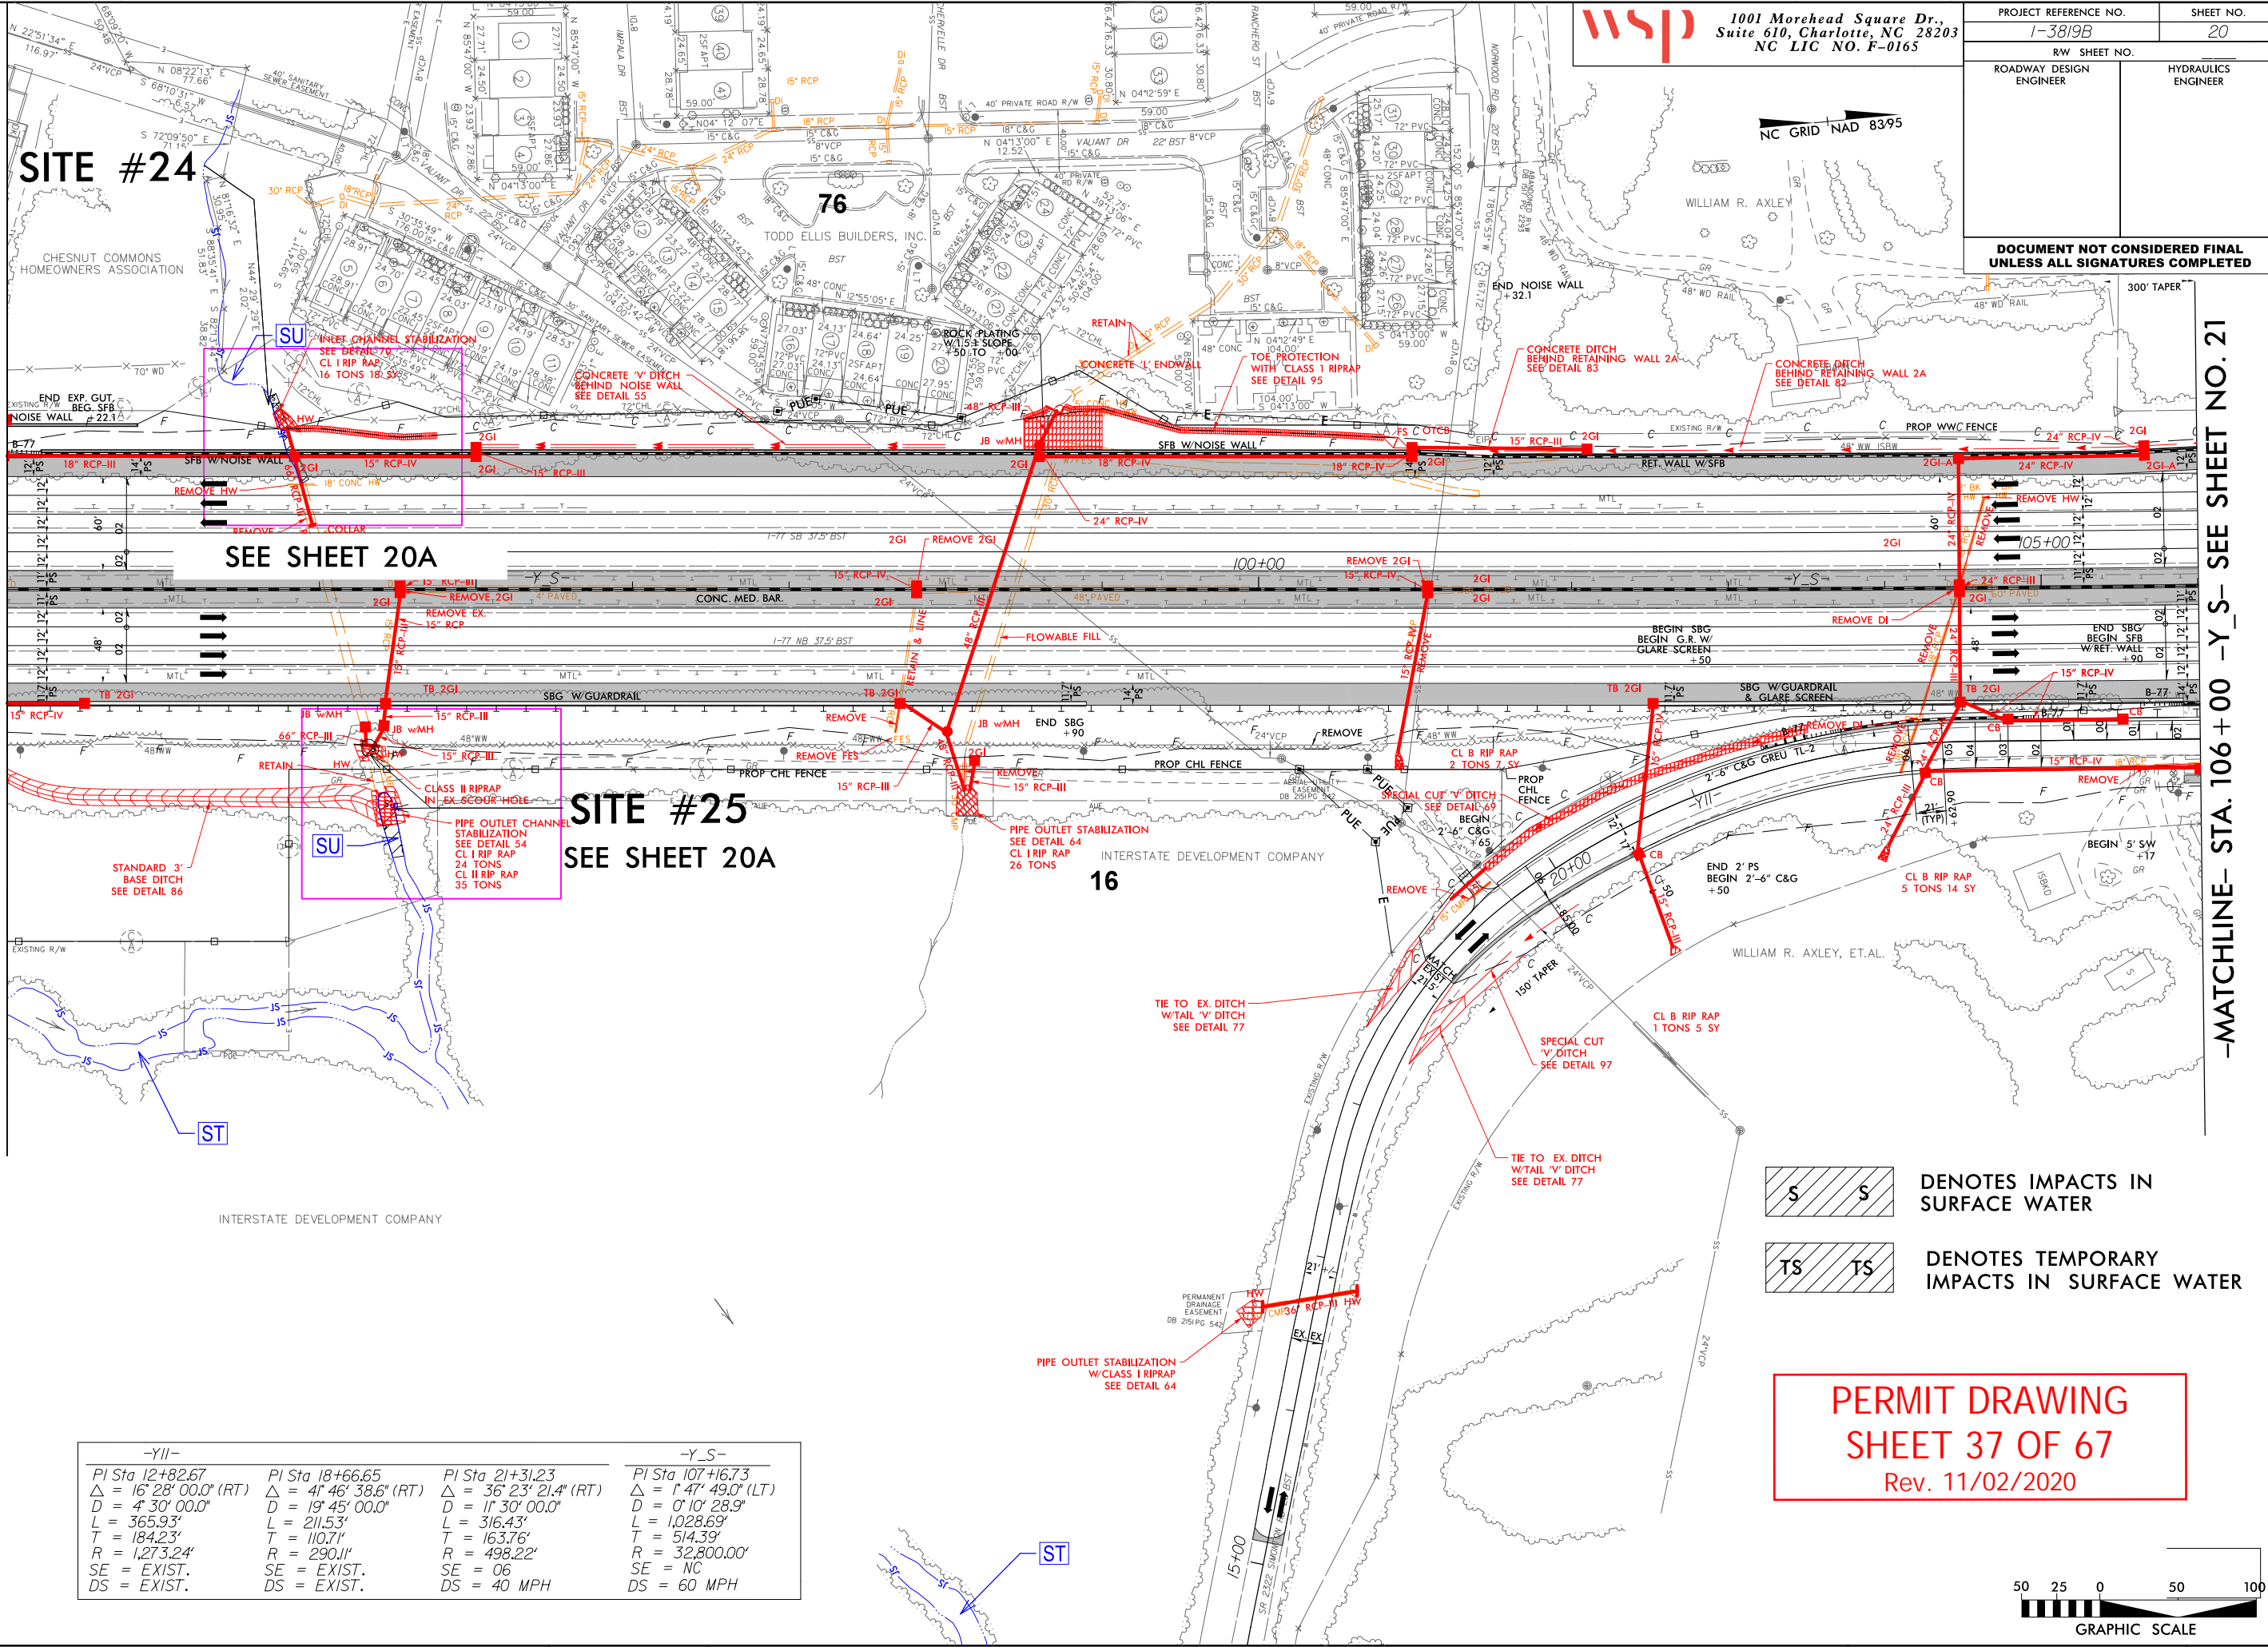

-YII-			-Y_S-		
PI Sta 12+82.67	PI Sta 18+66.65	PI Sta 21+31.23	PI Sta 107+16.73		
$\Delta = 16^{\circ} 28' 00.0''$ (RT)	$\Delta = 41^{\circ} 46' 38.6''$ (RT)	$\Delta = 36^{\circ} 23' 21.4''$ (RT)	$\Delta = 1^{\circ} 47' 49.0''$ (LT)		
$D = 4^{\circ} 30' 00.0''$	$D = 19^{\circ} 45' 00.0''$	$D = 17^{\circ} 30' 00.0''$	$D = 0^{\circ} 10' 28.9''$		
$L = 365.93'$	$L = 211.53'$	$L = 316.43'$	$L = 1,028.69'$		
$T = 184.23'$	$T = 110.71'$	$T = 163.76'$	$T = 514.39'$		
$R = 1,273.24'$	$R = 290.11'$	$R = 32,800.00'$	$R = 32,800.00'$		
SE = EXIST.	SE = EXIST.	SE = 06	SE = NC		
DS = EXIST.	DS = EXIST.	DS = 40 MPH	DS = 60 MPH		

PERMIT DRAWING  
SHEET 37 OF 67  
Rev. 11/02/2020



I/2/2020  
c:\p05\wise\pb\project\wise\wsp...amanda.johnson\d0339329\13819\_hyd\_prm\_psh20\_Y9200-10500.dgn  
13819\_hyd\_psh20\_Y9200-10500






1001 Morehead Square Dr.,  
Suite 610, Charlotte, NC 28203  
NC LIC NO. F-0165

PROJECT REFERENCE NO. 1-3819B		SHEET NO. 20	
R/W SHEET NO.			
ROADWAY DESIGN ENGINEER		HYDRAULICS ENGINEER	
<b>DOCUMENT NOT CONSIDERED FINAL UNLESS ALL SIGNATURES COMPLETED</b>			

-MATCHLINE- STA 92+00.00 -Y S- SEE SHEET NO.19

-MATCHLINE- STA. 106+00 -Y S- SEE SHEET NO. 21

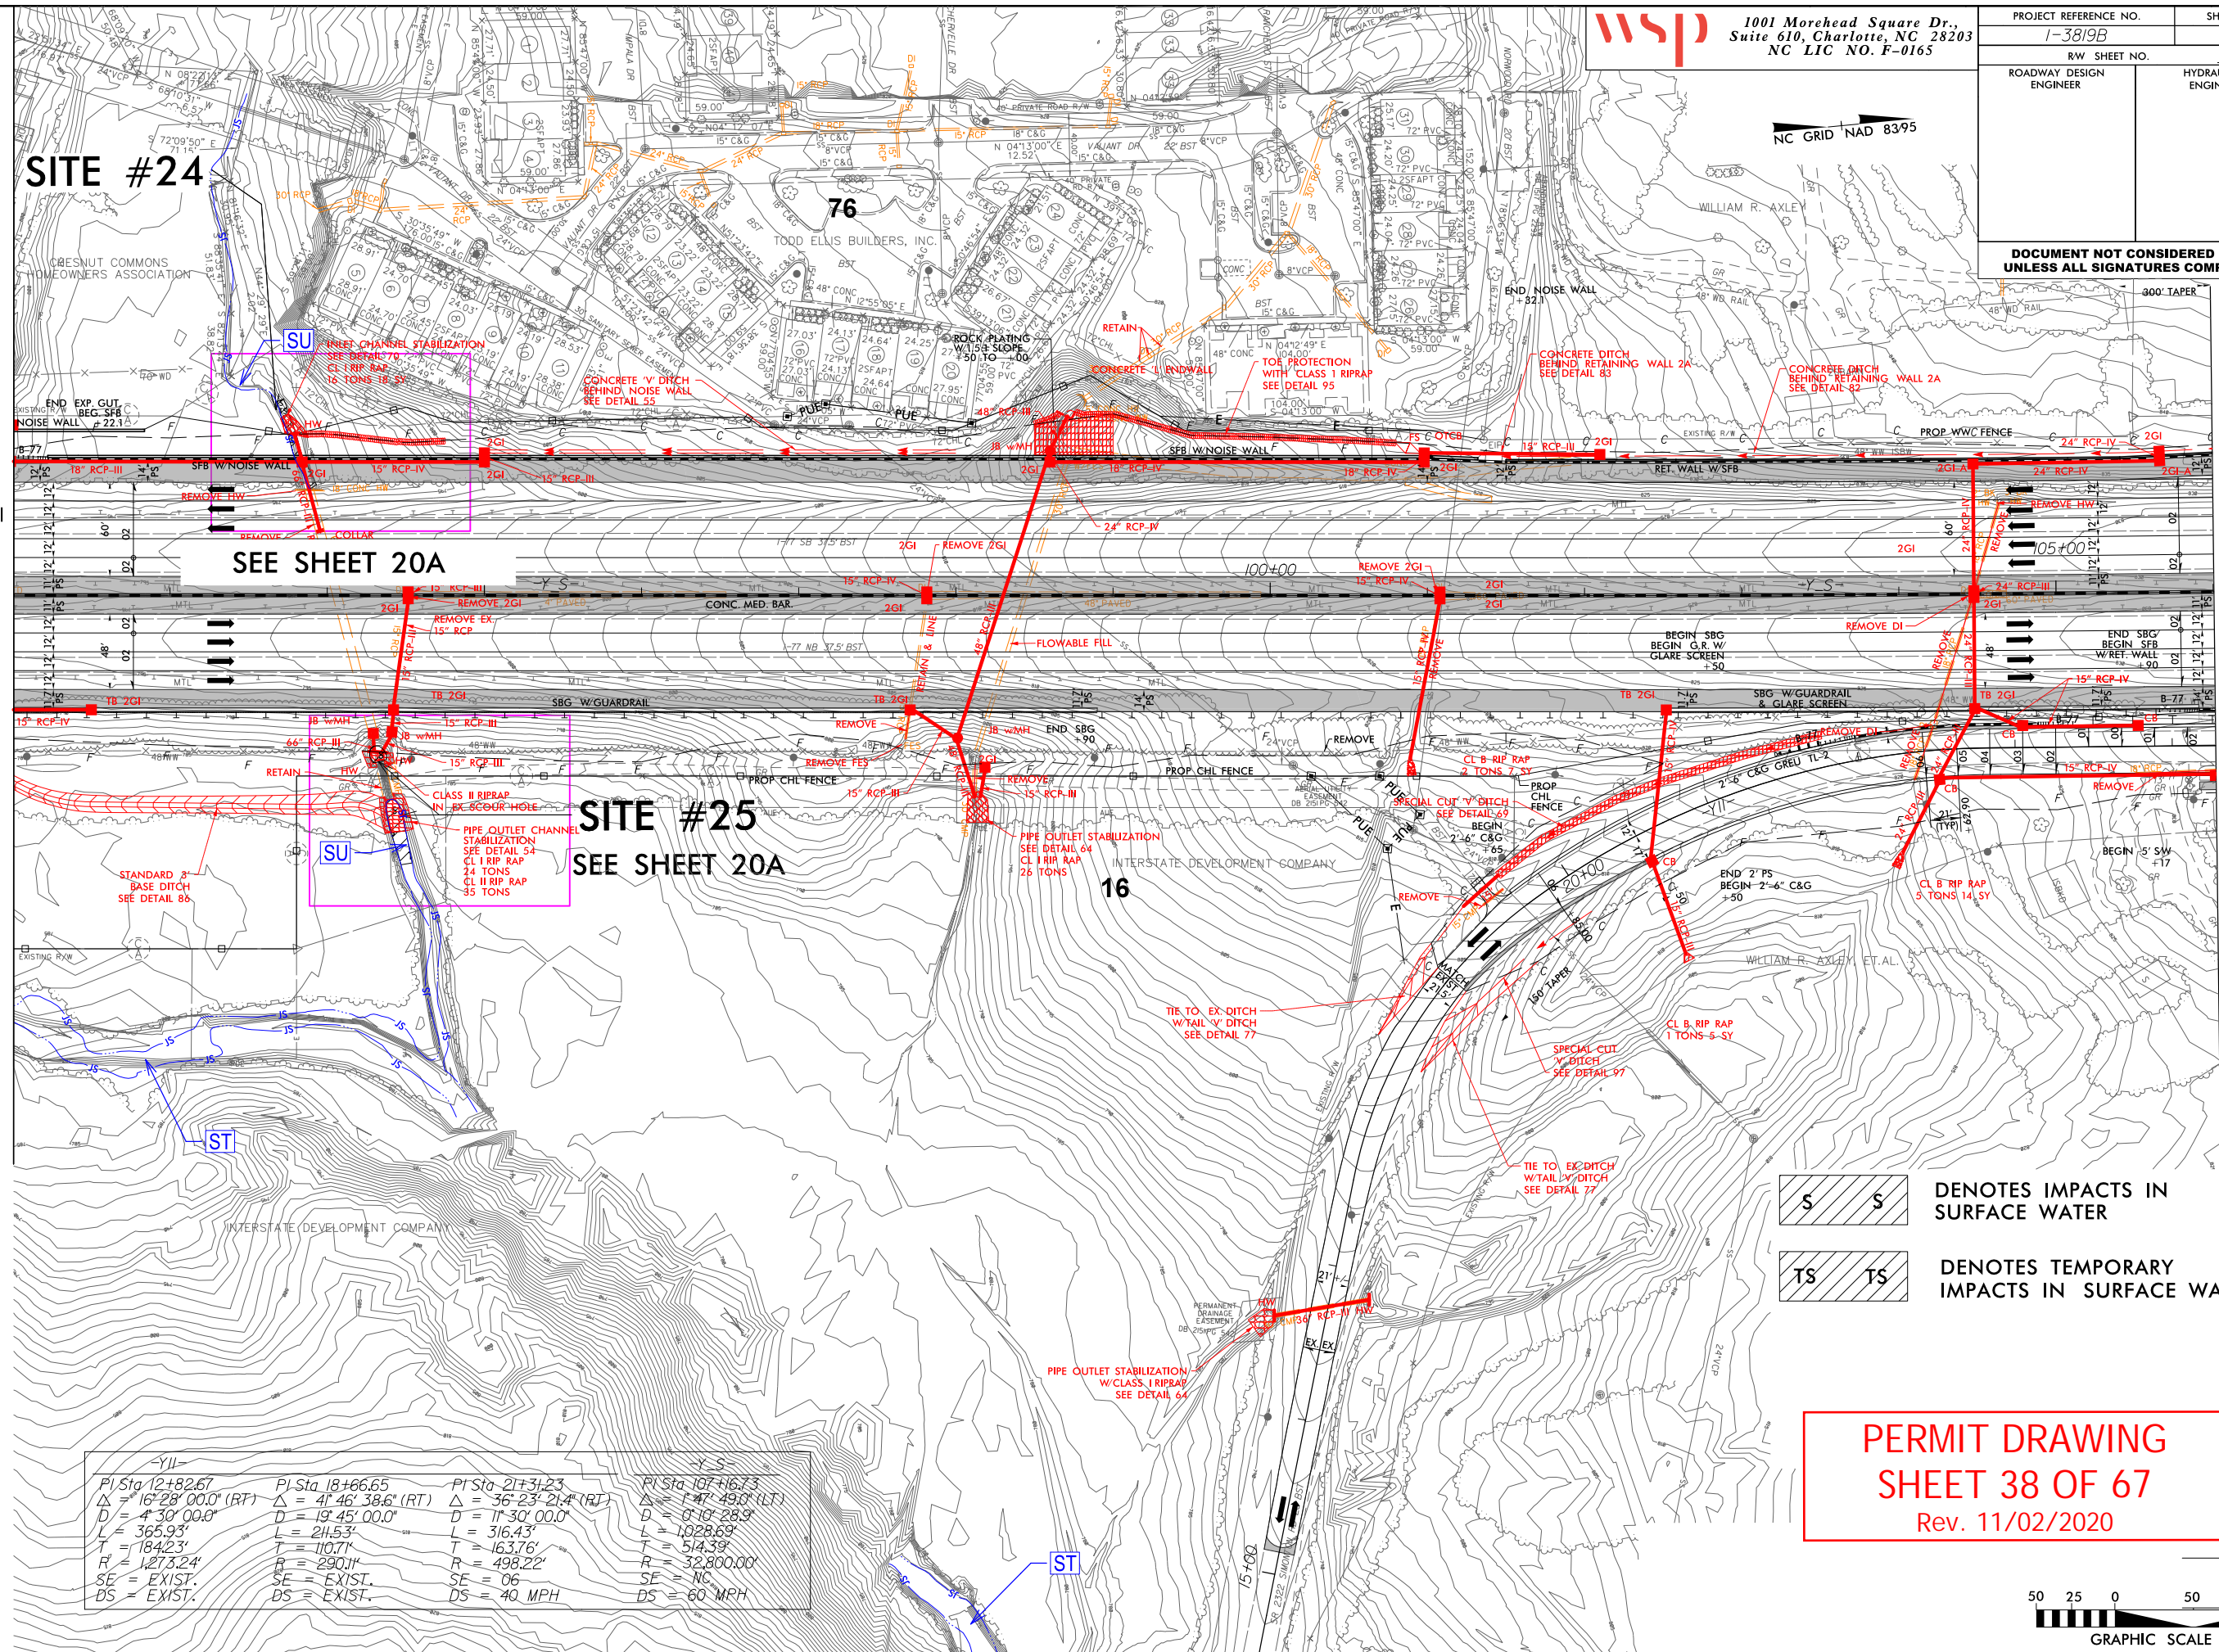


-YII-	-Y S-	-Y S-	-Y S-
PI Sta 12+82.67 Δ = 16° 28' 00.0" (RT) D = 4' 30' 00.0" L = 365.93' T = 184.23' R = 1273.24' SE = EXIST. DS = EXIST.	PI Sta 18+66.65 Δ = 41° 46' 38.6" (RT) D = 19' 45' 00.0" L = 244.53' T = 110.71' R = 290.11' SE = EXIST. DS = EXIST.	PI Sta 21+31.23 Δ = 36° 23' 21.4" (RT) D = 11' 30' 00.0" L = 316.43' T = 163.76' R = 498.22' SE = 06 DS = 40 MPH	PI Sta 107+16.73 Δ = 1° 47' 49.0" (LT) D = 0' 10' 28.9" L = 1028.69' T = 514.39' R = 32800.00' SE = NC DS = 60 MPH

DENOTES IMPACTS IN SURFACE WATER

DENOTES TEMPORARY IMPACTS IN SURFACE WATER


PERMIT DRAWING  
SHEET 38 OF 67  
Rev. 11/02/2020

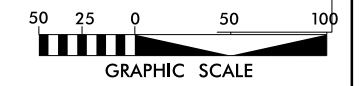


11/2/2020  
C:\p\project\wsp\amanda\_johnson\0339329\13819\_hyd\_prm\_psh20.y9200-10600.dgn  
USA1675035



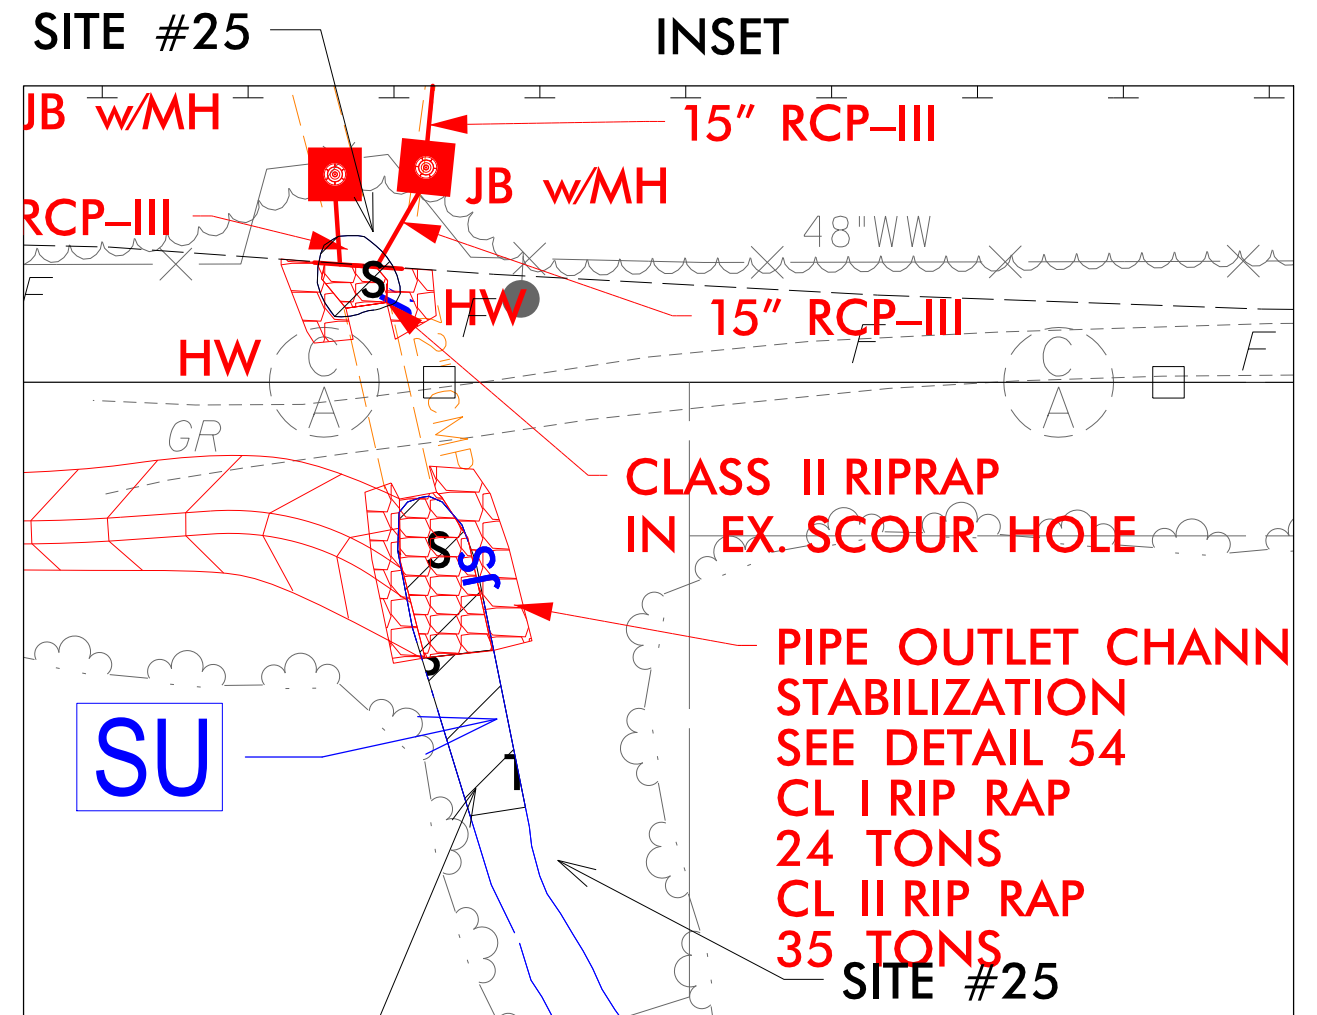

**DOCUMENT NOT CONSIDERED FINAL  
UNLESS ALL SIGNATURES COMPLETED**

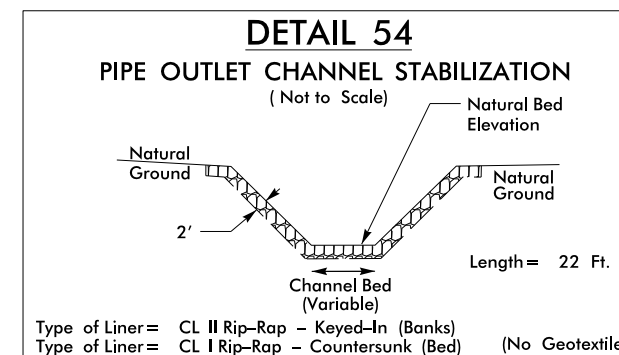

NC GRID + NAD 83/95




 DENOTES IMPACTS IN SURFACE WATER


 DENOTES TEMPORARY IMPACTS IN SURFACE WATER



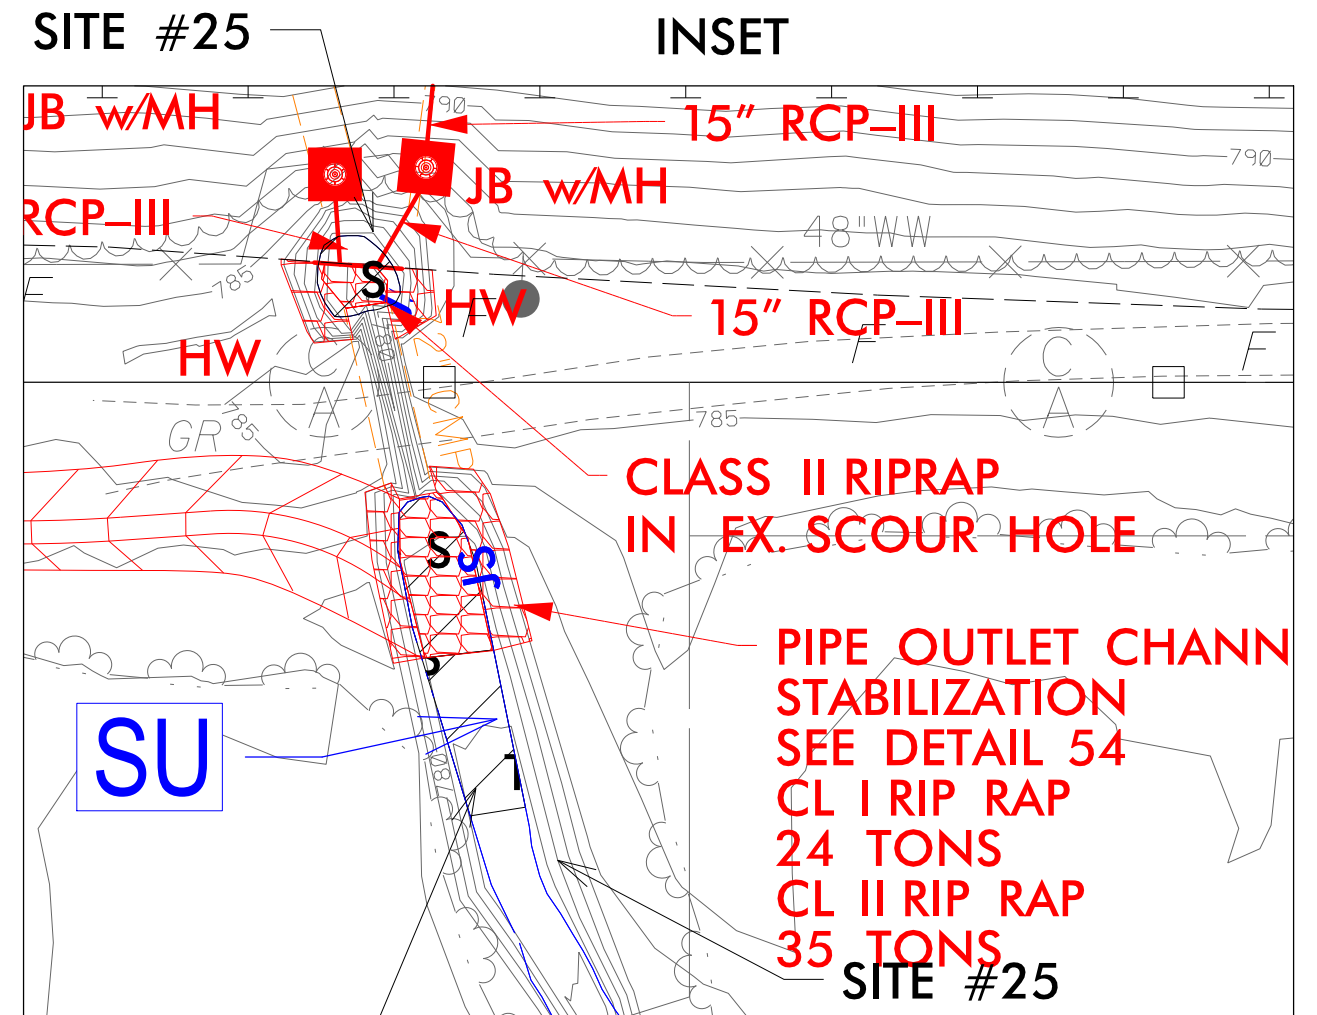

**DOCUMENT NOT CONSIDERED FINAL  
UNLESS ALL SIGNATURES COMPLETED**

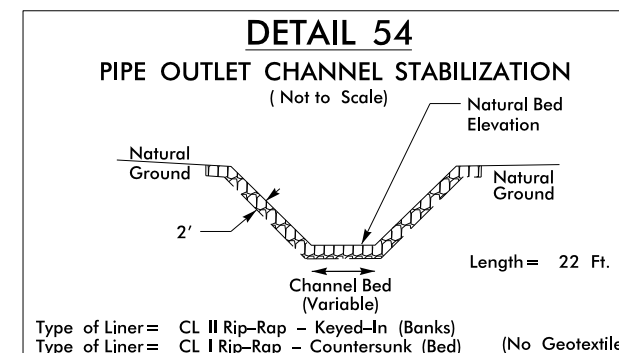

NC GRID | NAD 83/95



 DENOTES IMPACTS IN SURFACE WATER

 DENOTES TEMPORARY IMPACTS IN SURFACE WATER





PERMIT DRAWING  
SHEET 46 OF 67  
Rev. 11/02/2020

-YRPD-

Pis Sta 14+240.3	Pis Sta 23+740.0	Pis Sta 26+433.7	Pis Sta 29+033.94	Pis Sta 30+945.8
$\Delta = 2^\circ 02' 02" (RT)$	$\Delta = 4^\circ 52' 55.2"$	$\Delta = 29^\circ 54' (LT)$	$\Delta = 4^\circ 52' 55.2"$	$\Delta = 47^\circ 08' 04"$
D = 0' 38" 118"	D = 1440.0	D = 6' 46" 50.0"	D = 96.04	D = 1440.0
L = 392.87	L = 413.36	L = 96.04	L = 96.04	L = 96.04
R = 96.04	ST = 480.3	ST = 480.3	ST = 480.3	ST = 480.3
SE = NC	R = 96.0000	R = 945.00		
DS = 50 MPH	DS = 50 MPH	DS = 60 MPH		

-YSPAC-

Pis Sta 17+668.3	Pis Sta 17+012.0
$\Delta = 3^\circ 10' 10" (RT)$	$\Delta = 13^\circ 19' 38.2" (RT)$
D = 0' 29' 53.6"	D = 2' 14' 48.8"
L = 1074.43	L = 593.91
T = 537.57	T = 299.50
R = 1620.00	R = 2350.00
SE = NC	SE = 04
DS = 60 MPH	DS = 50 MPH

-Y-IT-

Pis Sta 33+147.3.81	Pis Sta 33+66.61
$\Delta = 2^\circ 52' 10.9" (LT)$	$\Delta = 2^\circ 52' 13.2" (LT)$
D = 270.00	D = 174.33
L = 180.00	L = 444.82
ST = 80.02	ST = 63.34
R = 3000.00	R = 3000.00
DS = 60 MPH	DS = 60 MPH

-Y-RT-

Pis Sta 23+626.32	Pis Sta 23+519.32
$\Delta = 1440.0$	$\Delta = 1719' 50.0" (LT)$
D = 200.3	D = 154.35
L = 525.34	L = 525.34
ST = 133.74	ST = 26.34
R = 3000.00	R = 3000.00
DS = 60 MPH	DS = 60 MPH

-YRPC-

Pis Sta 20+250.04	Pis Sta 24+66.97
$\Delta = 93^\circ 31' 29.98" (RT)$	$\Delta = 93^\circ 31' 29.98" (RT)$
D = 1440.0	D = 6' 52' 40.1"
L = 96.04	L = 736.00
ST = 96.04	ST = 833.00
R = 833.00	ST = 833.00
DS = 60 MPH	DS = 60 MPH

-YRPD-

Pis Sta 11+933.35	Pis Sta 14+07.08	Pis Sta 16+66.61	Pis Sta 22+110.0	Pis Sta 33+665.3	Pis Sta 44+82.83
$\Delta = 45^\circ 08' 04"$	$\Delta = 32^\circ 30' 36.4" (RT)$	$\Delta = 57^\circ 05' 05.0" (LT)$	$\Delta = 47^\circ 08' 04"$	$\Delta = 93^\circ 31' 29.98" (LT)$	$\Delta = 93^\circ 31' 29.98" (LT)$
D = 1440.0	D = 165.00	D = 1440.0	D = 1440.0	D = 1380.02	D = 1440.0
L = 96.04	L = 327.37	L = 96.04	L = 96.04	L = 96.04	L = 96.04
ST = 480.3	ST = 480.3	ST = 480.3	ST = 480.3	ST = 480.3	ST = 480.3
R = 833.00	R = 833.00	R = 7870.00	R = 833.00	R = 833.00	R = 833.00
DS = 60 MPH	DS = 60 MPH	DS = 60 MPH	DS = 60 MPH	DS = 60 MPH	DS = 60 MPH

- |  |  |
|--|--|
|  | DENOTES FILL IN WETLAND                    |
|  | DENOTES MECHANIZED CLEARING                |
|  | DENOTES TEMPORARY FILL IN WETLAND          |
|  | DENOTES IMPACTS IN SURFACE WATER           |
|  | DENOTES TEMPORARY IMPACTS IN SURFACE WATER |

LOCATION: \_\_\_\_\_  
\_\_\_\_\_  
\_\_\_\_\_

TP NO.: L-38108 COUNTY: BREDEL

DESIGNED BY: \_\_\_\_\_ C. DAVIS \_\_\_\_\_

CHECKED BY: D. BRISWORTH DATE: 6-2-2019



PERMIT DRAWING  
SHEET 47 OF 67  
Rev. 11/02/2020

Y-RPAC		Y-RPCA		Y-RPAC		Y-RPCA	
PI Sta 14424.03	PI Sta 23143.50	PI Sta 26443.50	PI Sta 29403.04	PI Sta 30492.94	PI Sta 30492.94	PI Sta 30492.94	PI Sta 30492.94
Δ = 28.70' (2.91 RT)	Δ = 4.52' (5.22 RT)	Δ = 29.24' (3.10 RT)	Δ = 4.52' (5.22 RT)	Δ = 4.52' (5.22 RT)	Δ = 4.52' (5.22 RT)	Δ = 4.52' (5.22 RT)	Δ = 4.52' (5.22 RT)
L = 305.80'	L = 362.0'	L = 433.6'	L = 362.0'	L = 362.0'	L = 362.0'	L = 362.0'	L = 362.0'
SE = 14.00'	SE = 14.00'	SE = 14.00'	SE = 14.00'	SE = 14.00'	SE = 14.00'	SE = 14.00'	SE = 14.00'
DS = 50 MPH	DS = 50 MPH	DS = 50 MPH	DS = 50 MPH	DS = 50 MPH	DS = 50 MPH	DS = 50 MPH	DS = 50 MPH
Y-LT		Y-LT		Y-LT		Y-LT	
PI Sta 13171.38	PI Sta 13448.61	PI Sta 13448.61	PI Sta 13448.61	PI Sta 13448.61	PI Sta 13448.61	PI Sta 13448.61	PI Sta 13448.61
Δ = 2.34' (4.52 RT)	Δ = 8.29' (4.52 RT)	Δ = 8.29' (4.52 RT)	Δ = 8.29' (4.52 RT)	Δ = 8.29' (4.52 RT)	Δ = 8.29' (4.52 RT)	Δ = 8.29' (4.52 RT)	Δ = 8.29' (4.52 RT)
L = 270.00'	L = 270.00'	L = 270.00'	L = 270.00'	L = 270.00'	L = 270.00'	L = 270.00'	L = 270.00'
SE = 14.00'	SE = 14.00'	SE = 14.00'	SE = 14.00'	SE = 14.00'	SE = 14.00'	SE = 14.00'	SE = 14.00'
DS = 50 MPH	DS = 50 MPH	DS = 50 MPH	DS = 50 MPH	DS = 50 MPH	DS = 50 MPH	DS = 50 MPH	DS = 50 MPH
Y-RPAC		Y-RPCA		Y-RPAC		Y-RPCA	
PI Sta 11493.35	PI Sta 11493.35	PI Sta 11493.35	PI Sta 11493.35	PI Sta 11493.35	PI Sta 11493.35	PI Sta 11493.35	PI Sta 11493.35
Δ = 4.52' (5.22 RT)	Δ = 4.52' (5.22 RT)	Δ = 4.52' (5.22 RT)	Δ = 4.52' (5.22 RT)	Δ = 4.52' (5.22 RT)	Δ = 4.52' (5.22 RT)	Δ = 4.52' (5.22 RT)	Δ = 4.52' (5.22 RT)
L = 362.0'	L = 362.0'	L = 362.0'	L = 362.0'	L = 362.0'	L = 362.0'	L = 362.0'	L = 362.0'
SE = 14.00'	SE = 14.00'	SE = 14.00'	SE = 14.00'	SE = 14.00'	SE = 14.00'	SE = 14.00'	SE = 14.00'
DS = 50 MPH	DS = 50 MPH	DS = 50 MPH	DS = 50 MPH	DS = 50 MPH	DS = 50 MPH	DS = 50 MPH	DS = 50 MPH



- Denotes Fill in Wetland
- Denotes Mechanized Clearing
- Denotes Temporary Fill in Wetland
- Denotes Impacts in Surface Water
- Denotes Temporary Impacts in Surface Water

LOCATION \_\_\_\_\_

TP NO. 63018 \_\_\_\_\_ COUNTY 08001

DESIGNED BY: C. DAVE \_\_\_\_\_

CHECKED BY: R. BROWNE \_\_\_\_\_ DATE: 6-3-2017

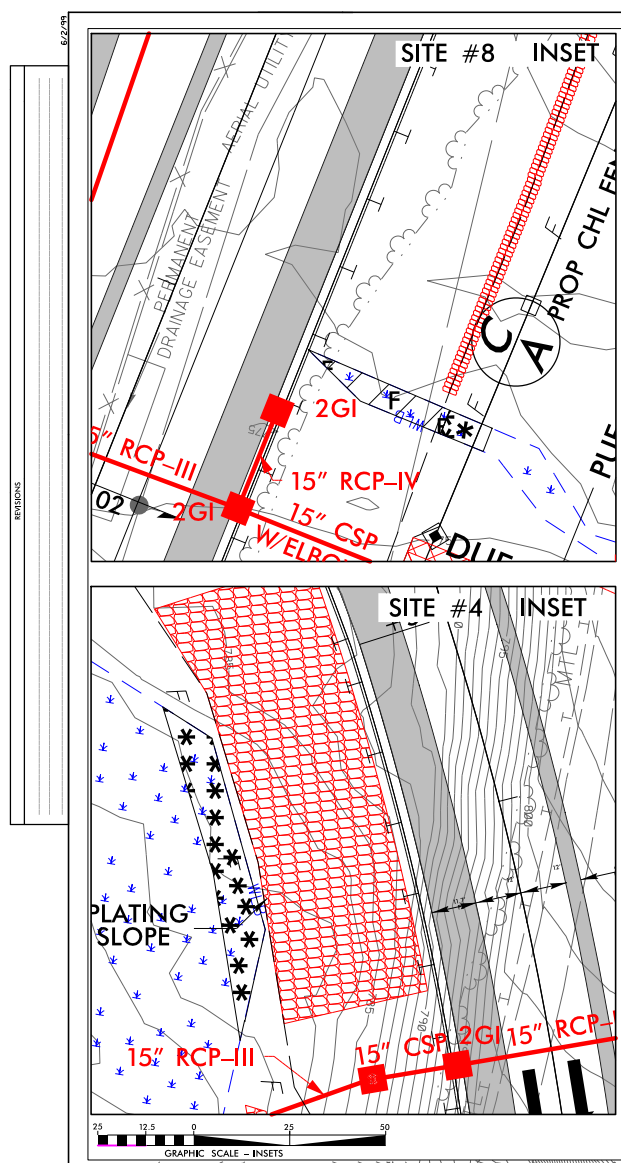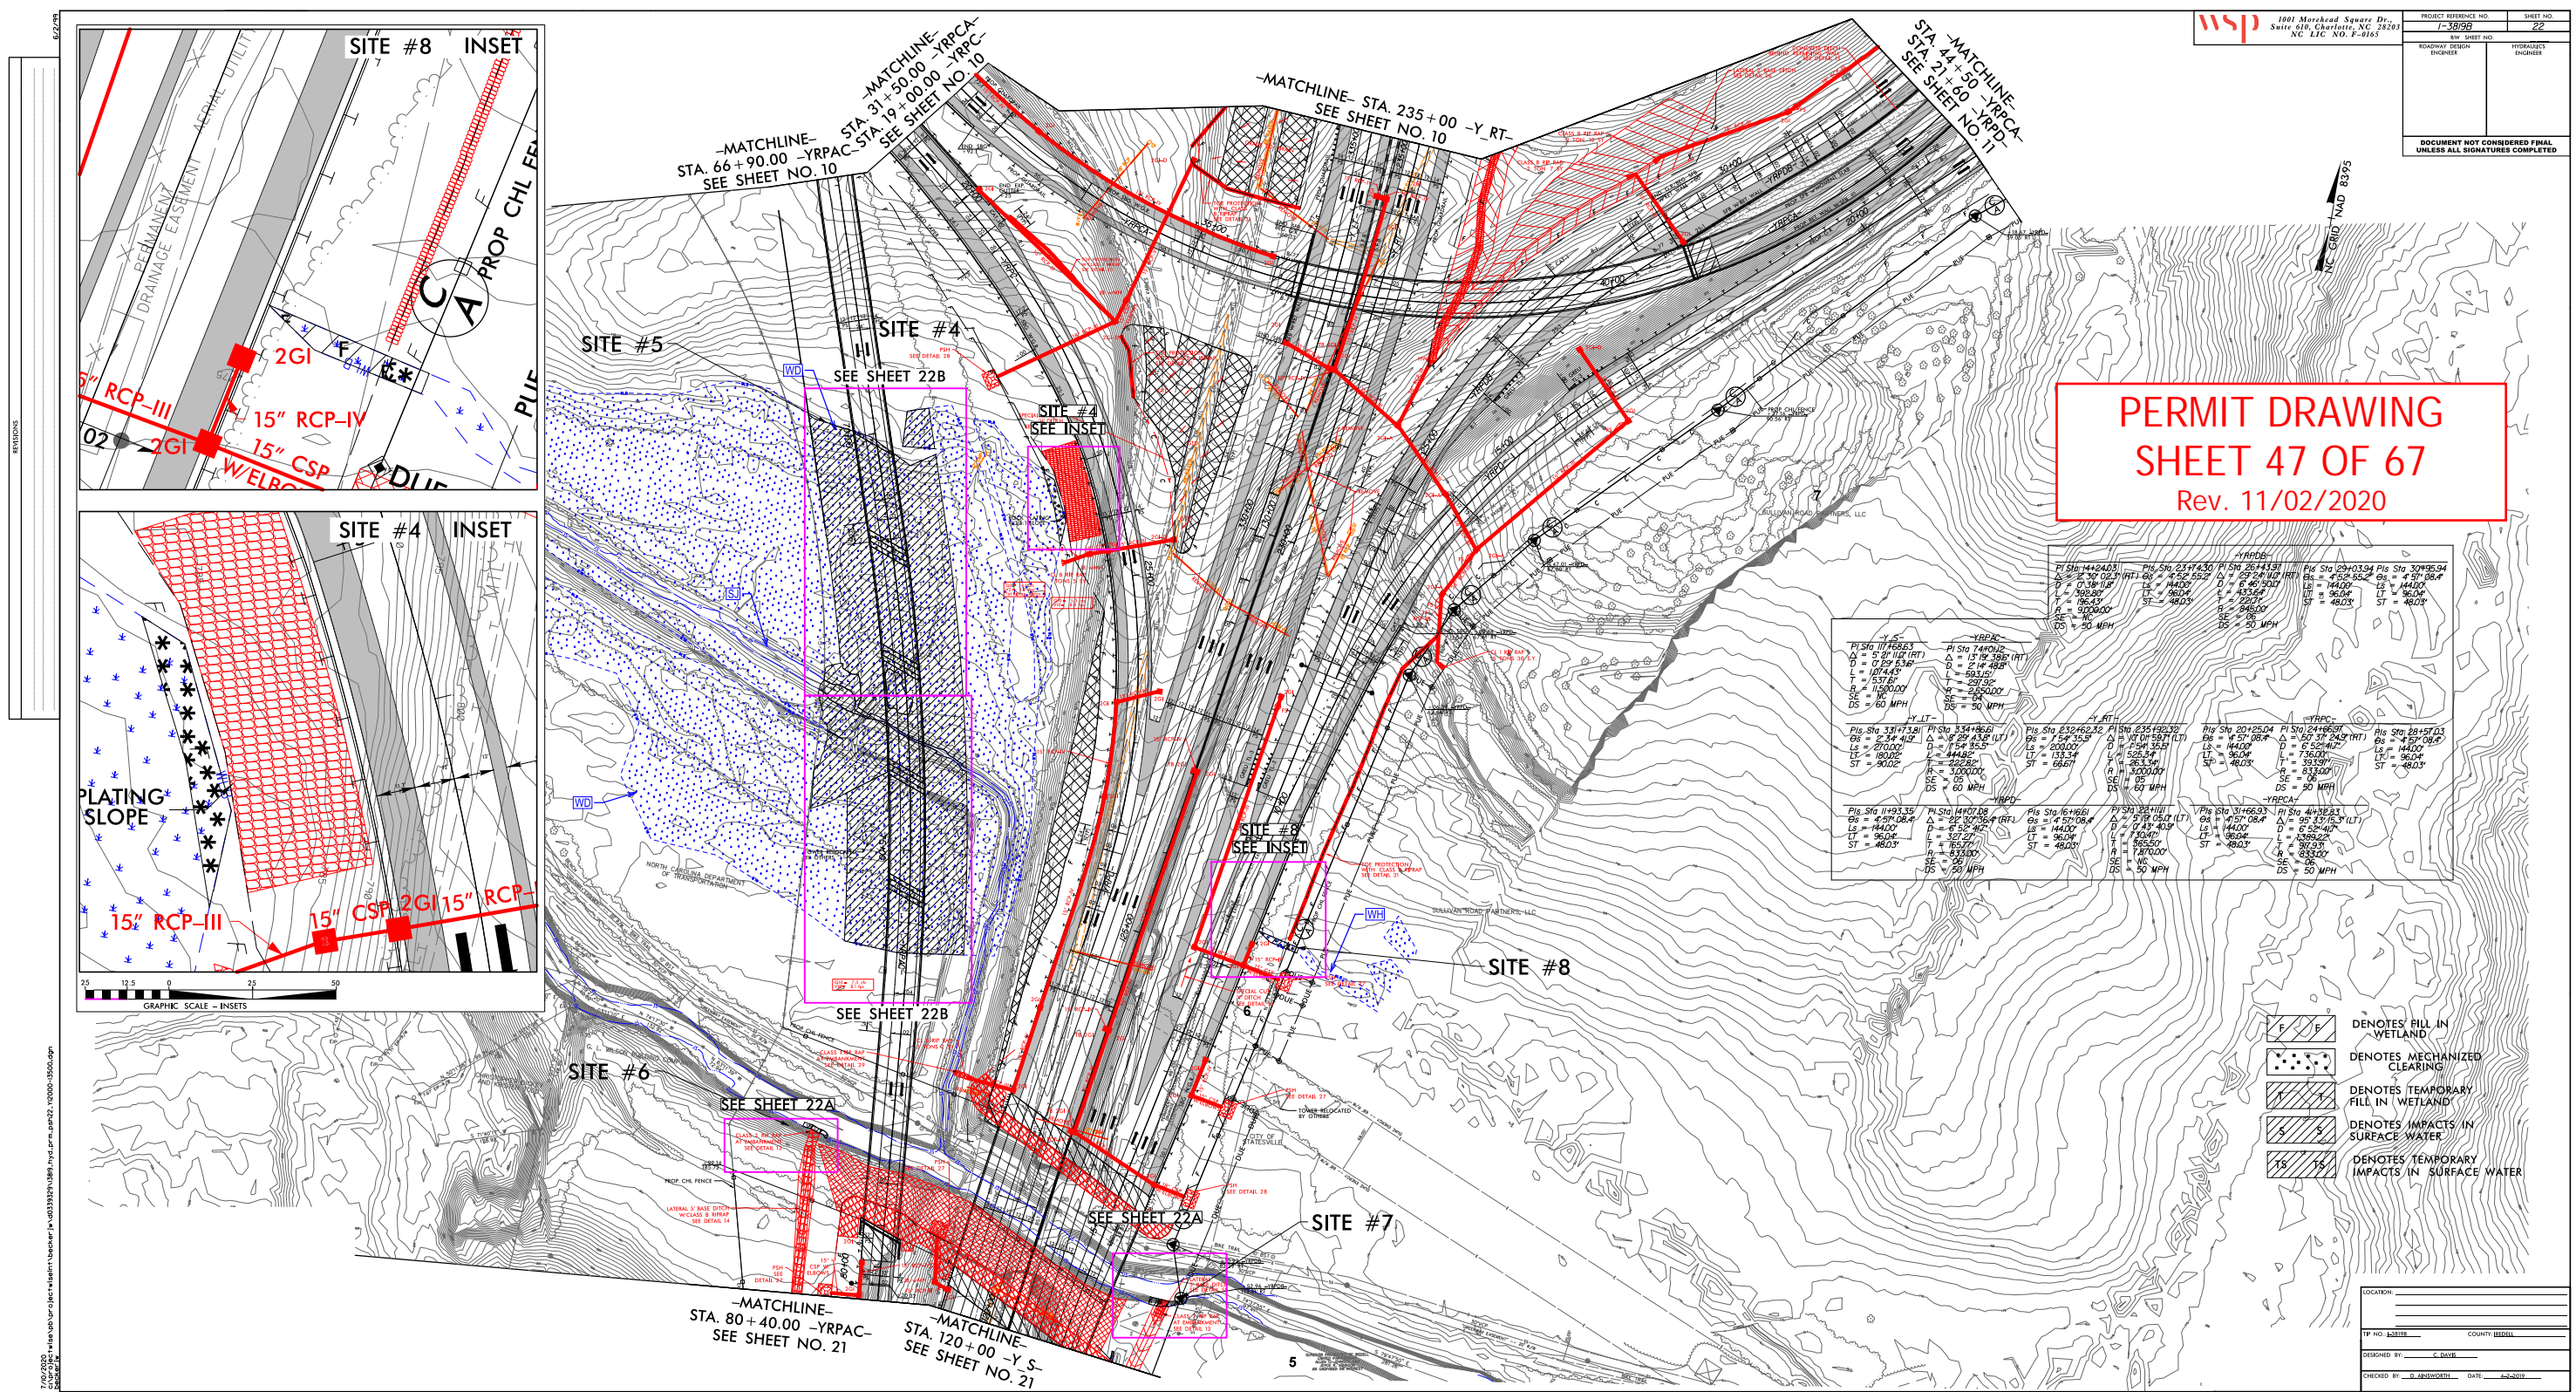


7/10/2020 10:55:15 AM C:\Users\cdaugh\OneDrive\Documents\7-3839\Drawings\7-3839-22.dwg User: cdaugh



# INSET

SITE #5

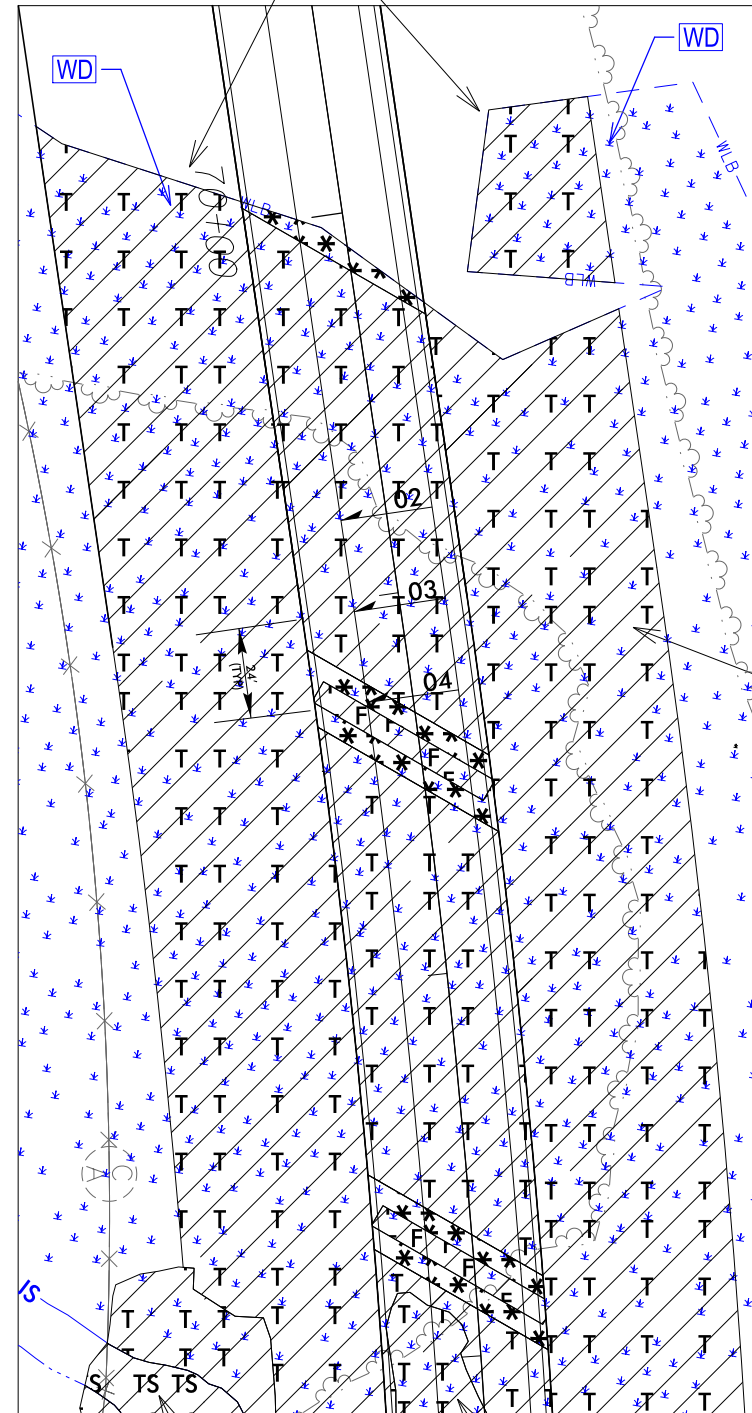

TEMPORARY IMPACTS IN  
SURFACE WATER

TEMPORARY FILL  
IN WETLAND  
(RESTORATION SITE)

TEMPORARY FILL  
IN WETLAND  
(MATTING FOR  
CONSTRUCTION  
ACCESS - BRIDGE  
STRUCTURE #10)


TEMPORARY FILL  
IN WETLAND  
(RESTORATION SITE)

TEMPORARY IMPACTS IN  
SURFACE WATER

TEMPORARY IMPACTS IN  
SURFACE WATER

SJ

WD

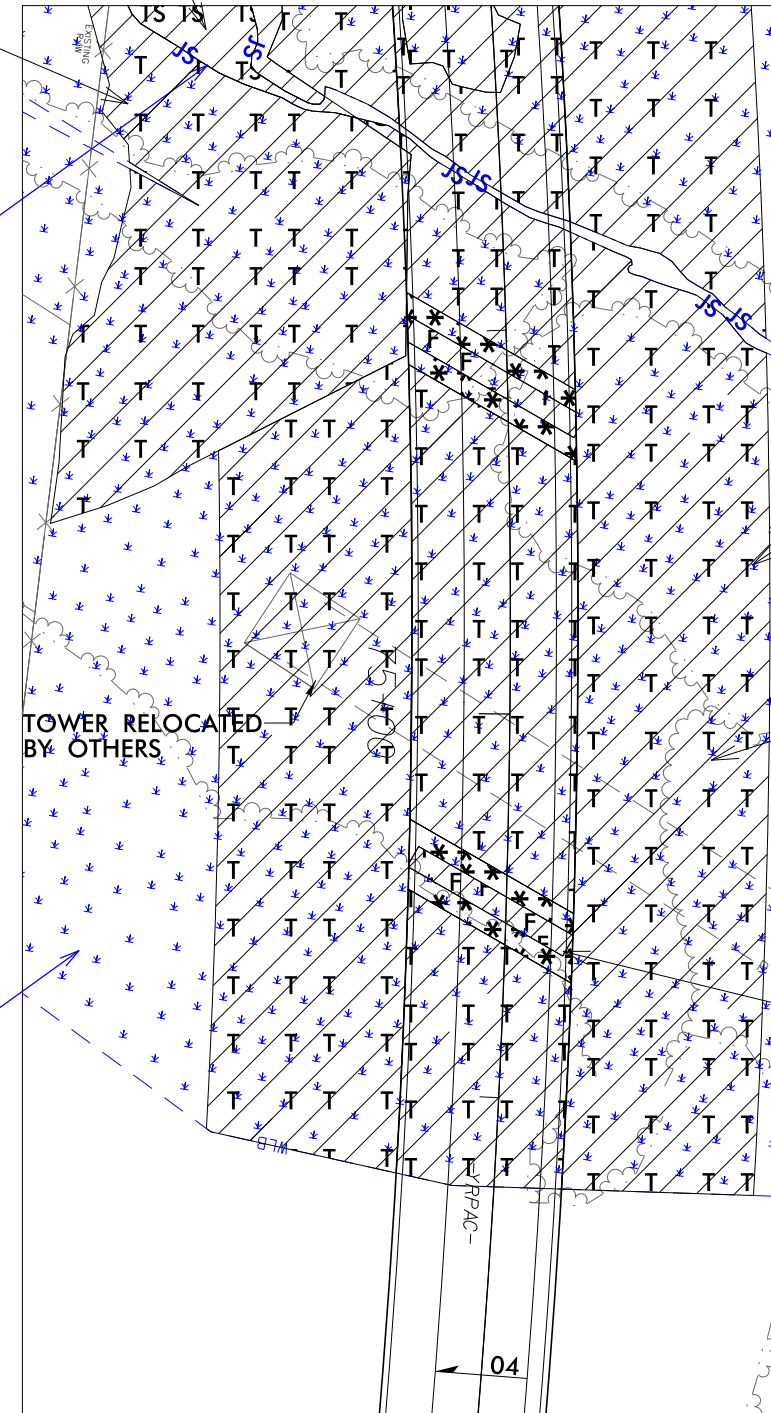

TOWER RELOCATED  
BY OTHERS

SITE #5

TEMPORARY FILL  
IN WETLAND  
(MATTING FOR  
CONSTRUCTION  
ACCESS - BRIDGE  
STRUCTURE #10)

PERMANENT FILL AND  
MECHANIZED CLEARING  
FOR PROPOSED BENT (TYP)

- TS TS DENOTES TEMPORARY IMPACTS IN SURFACE WATER
- F F DENOTES FILL IN WETLAND
- DENOTES MECHANIZED CLEARING
- T T DENOTES TEMPORARY FILL IN WETLAND

PERMIT DRAWING  
SHEET 50 OF 67  
Rev. 11/02/2020



GRAPHIC SCALE - INSETS




PROJECT REFERENCE NO.	SHEET NO.
1-3819B	22B
R/W SHEET NO.	
ROADWAY DESIGN ENGINEER	HYDRAULICS ENGINEER
DOCUMENT NOT CONSIDERED FINAL UNLESS ALL SIGNATURES COMPLETED	

NC GRID NAD 8395

INSET

SITE #5

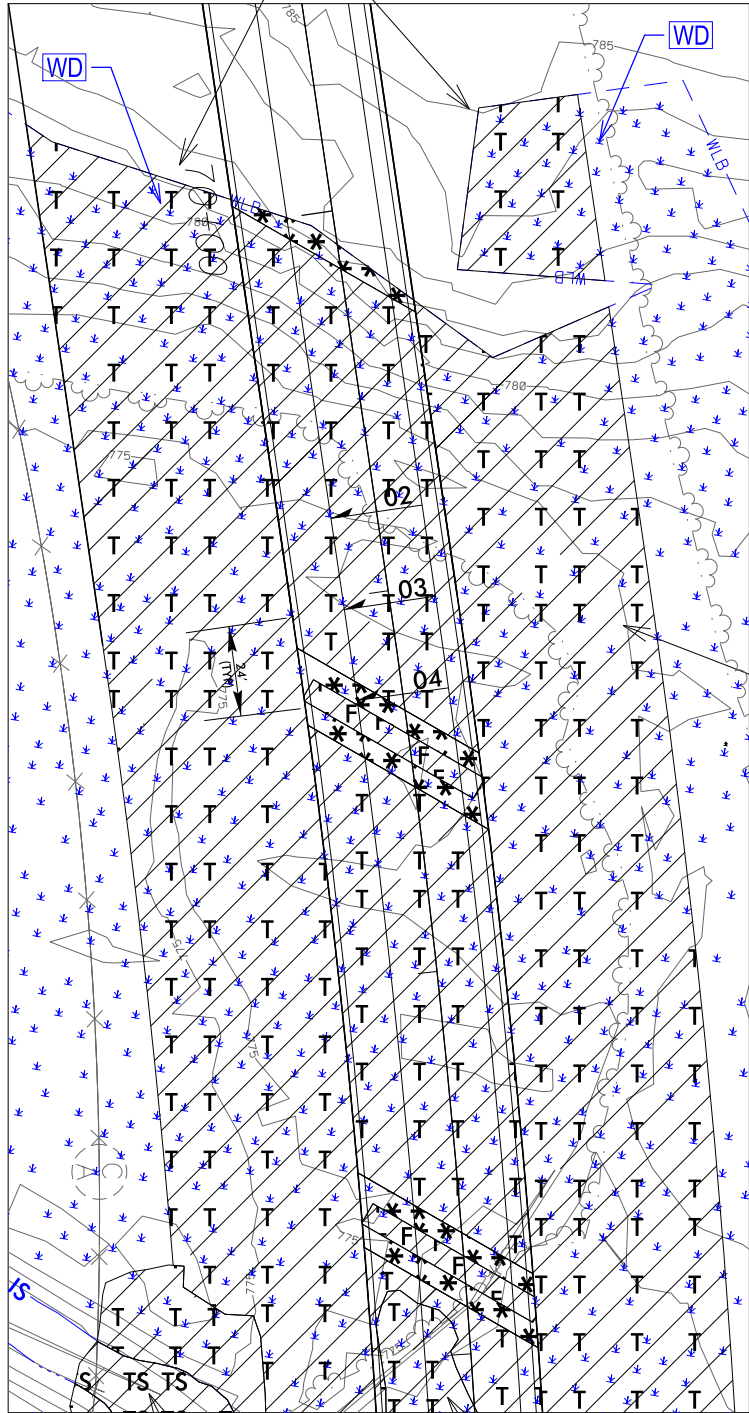


TEMPORARY IMPACTS IN  
SURFACE WATER

TEMPORARY FILL  
IN WETLAND  
(RESTORATION SITE)

TEMPORARY FILL  
IN WETLAND  
(MATTING FOR  
CONSTRUCTION  
ACCESS – BRIDGE  
STRUCTURE #10)

TEMPORARY FILL  
IN WETLAND  
(RESTORATION SITE)

TEMPORARY IMPACTS IN  
SURFACE WATER

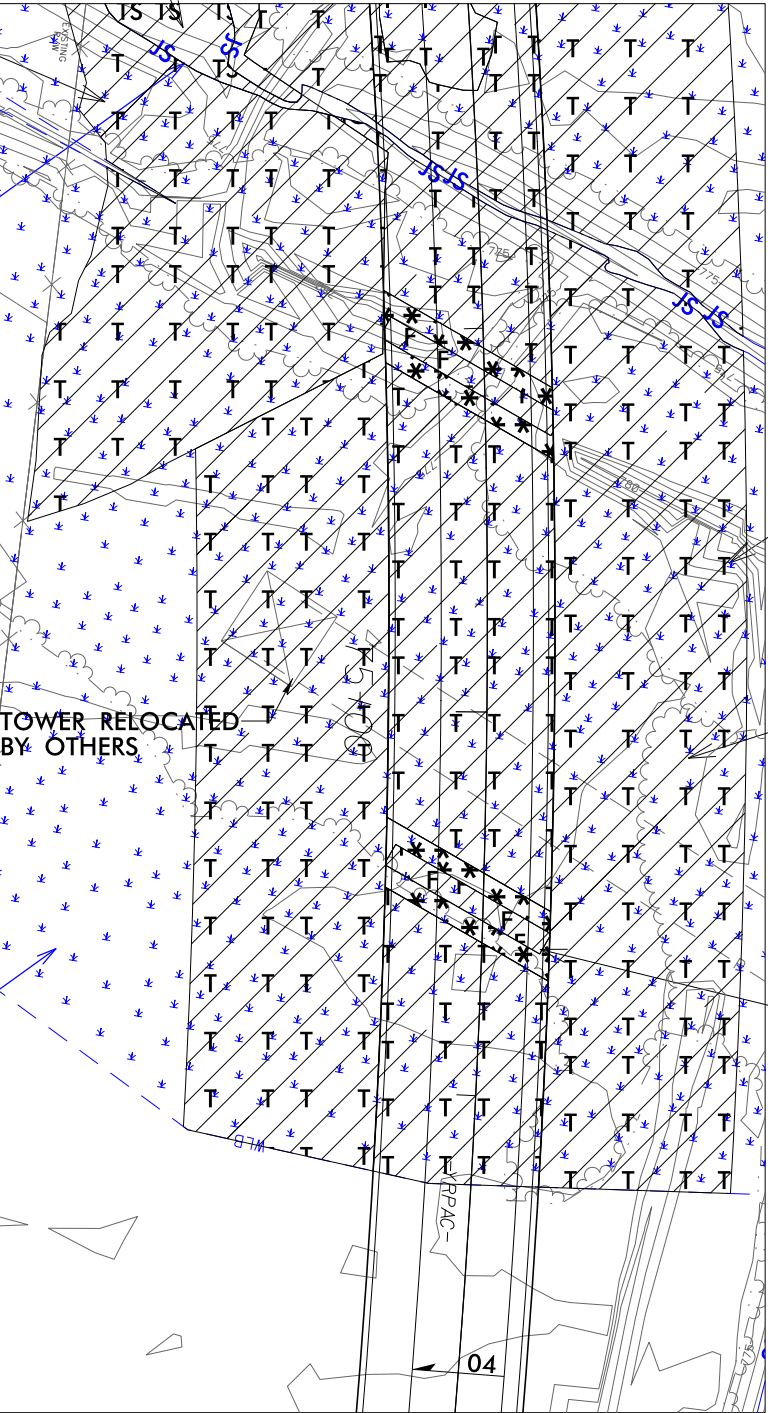

TOWER RELOCATED  
BY OTHERS

SITE #5

TEMPORARY FILL  
IN WETLAND  
(MATTING FOR  
CONSTRUCTION  
ACCESS – BRIDGE  
STRUCTURE #10)

PERMANENT FILL AND  
MECHANIZED CLEARING  
FOR PROPOSED BENT (TYP)

- TS TS DENOTES TEMPORARY IMPACTS IN SURFACE WATER
- F F DENOTES FILL IN WETLAND
- M M DENOTES MECHANIZED CLEARING
- T T DENOTES TEMPORARY FILL IN WETLAND

PERMIT DRAWING  
SHEET 51 OF 67  
Rev. 11/02/2020



GRAPHIC SCALE – INSETS



PROJECT REFERENCE NO.	SHEET NO.
1-3819B	22B
R/W SHEET NO.	
ROADWAY DESIGN ENGINEER	HYDRAULICS ENGINEER
DOCUMENT NOT CONSIDERED FINAL UNLESS ALL SIGNATURES COMPLETED	

NC GRID NAD 8395

10/22/2020  
c:\projectwise\pb\projectwise\becker\_jw\0339329\13819\_hyd-prm-psh-22B\_112000-13500.dgn  
becker\_jw



## Rev. 11/02/2020

HW

16' RCP

3' WW

CONC

MTL

D

HW

8

GOFORTH FAMILY  
REVOCABLE TRUST

PUE

S 59°25'12" W  
364.19'

**INSET**  
END NB RECONSTRUCTION  
BEG. NB WIDENING & RESURF.  
-Y N- POT STA. 209+50.00

END CONSTRUCTION  
END NB WIDENING & RESURF.  
-Y N- POT STA. 216+70.00

SEE INSET THIS SHEET

-MATCHLINE- STA. 203+00 -Y\_N- SEE SHEET NO. 26

END SB WIDENING/RESURF.  
-Y\_N- POT STA. 205+15.43

INSET

— SITE #27  
SEE SHEET 27A

DENOTES IMPACTS IN  
SURFACE WATERDENOTES TEMPORARY  
IMPACTS IN SURFACE WATER




PROJECT REFERENCE NO.	SHEET NO.
1-3819B	27
R/W SHEET NO.	
ROADWAY DESIGN ENGINEER	HYDRAULICS ENGINEER

DOCUMENT NOT CONSIDERED FINAL  
UNLESS ALL SIGNATURES COMPLETED

PERMIT DRAWING  
SHEET 63 OF 67  
Rev. 11/02/2020

MATCHLINE- STA. 217+00 -Y\_N-  
THIS SHEET

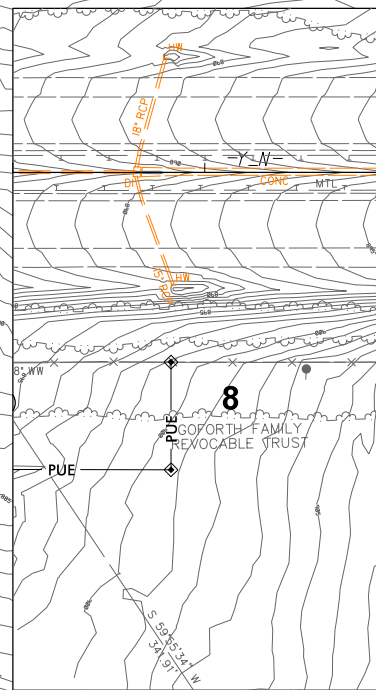


INSET  
END NB RECONSTRUCTION  
BEG. NB WIDENING & RESURF.  
-Y\_N- POT STA. 209+50.00

END CONSTRUCTION  
END NB WIDENING & RESURF.  
-Y\_N- POT STA. 216+70.00


MATCHLINE- STA. 217+00 -Y\_N-  
SEE INSET THIS SHEET

MATCHLINE- STA. 203+00 -Y\_N- SEE SHEET NO. 26

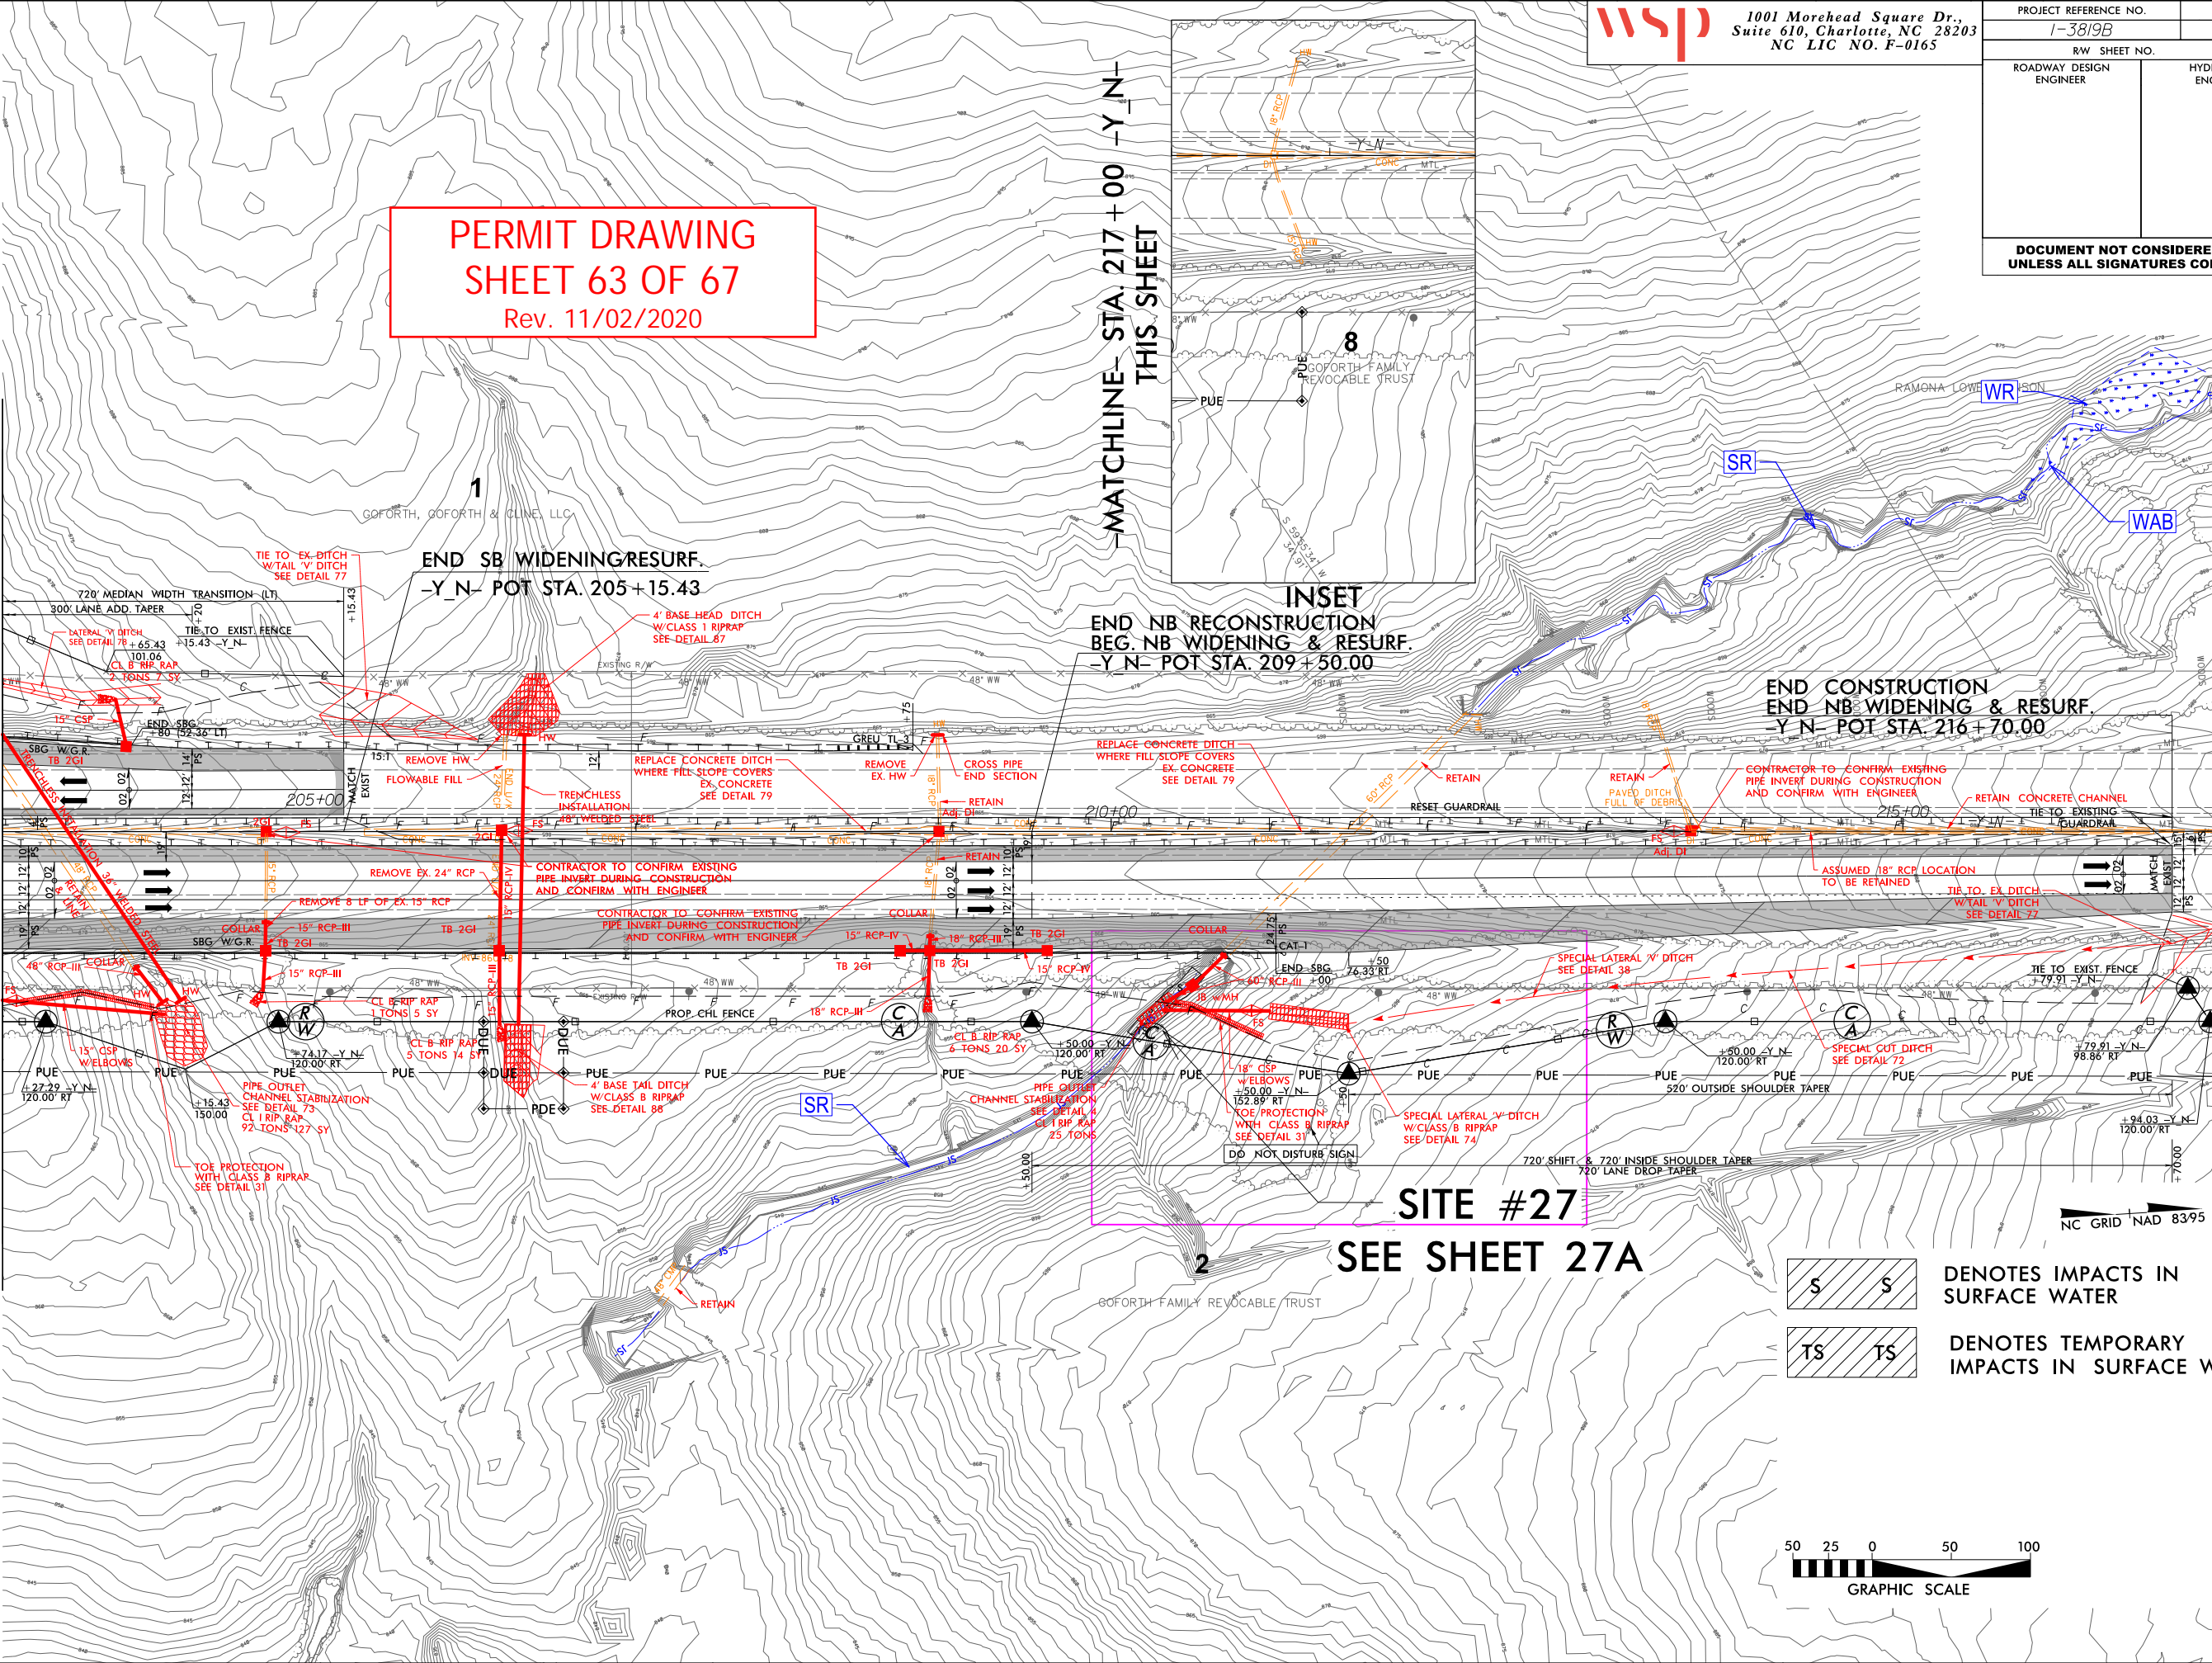

SITE #27

SEE SHEET 27A

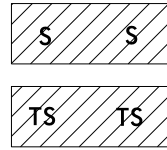



DENOTES IMPACTS IN  
SURFACE WATER

DENOTES TEMPORARY  
IMPACTS IN SURFACE WATER








PROJECT REFERENCE NO.	SHEET NO.
1-3819B	27A
R/W SHEET NO.	
ROADWAY DESIGN ENGINEER	HYDRAULICS ENGINEER
DOCUMENT NOT CONSIDERED FINAL UNLESS ALL SIGNATURES COMPLETED	

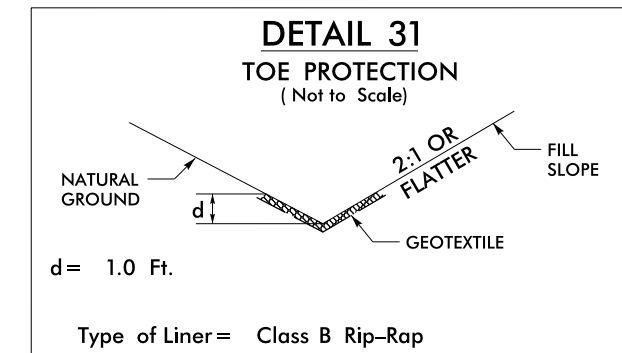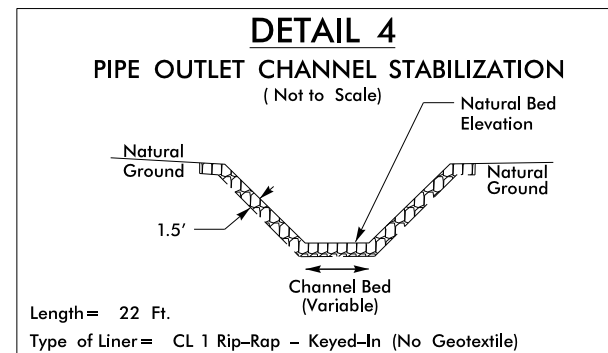



INSET

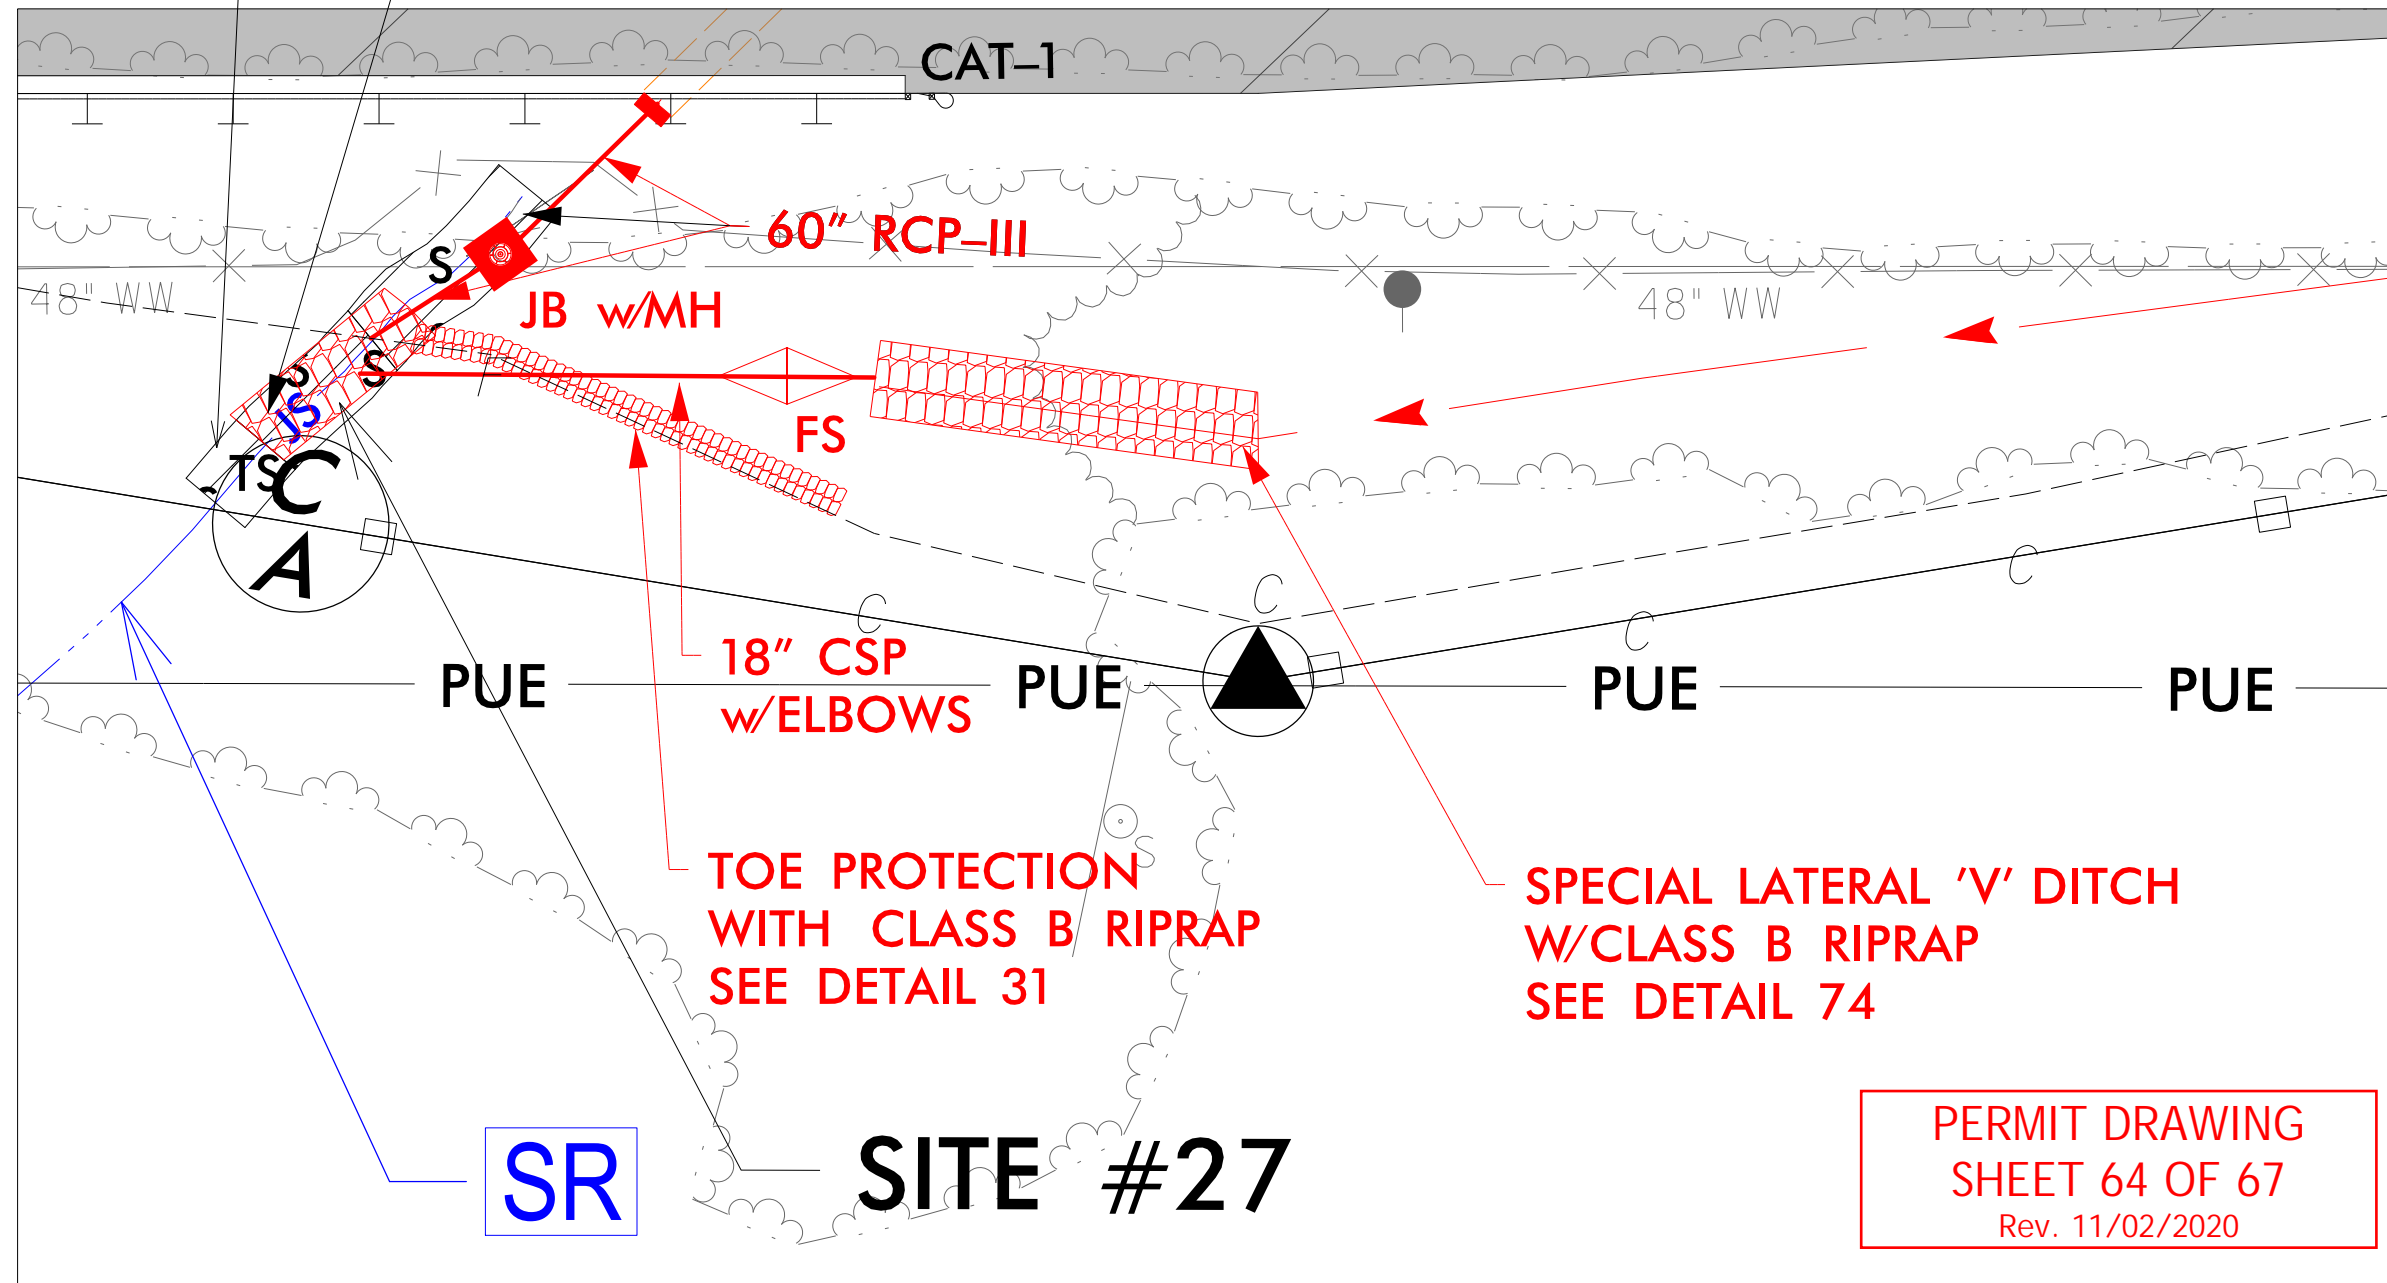




PERMIT DRAWING  
SHEET 64 OF 67  
Rev. 11/02/2020

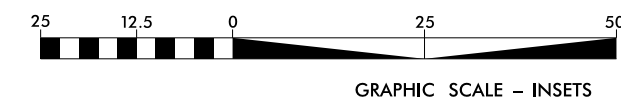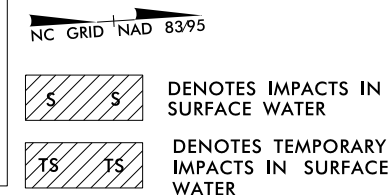

PROJECT REFERENCE NO.	SHEET NO.
1-3819B	27A
R/W SHEET NO.	
ROADWAY DESIGN ENGINEER	HYDRAULICS ENGINEER
DOCUMENT NOT CONSIDERED FINAL UNLESS ALL SIGNATURES COMPLETED	

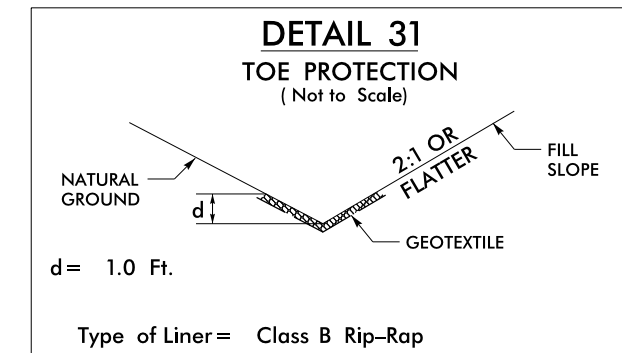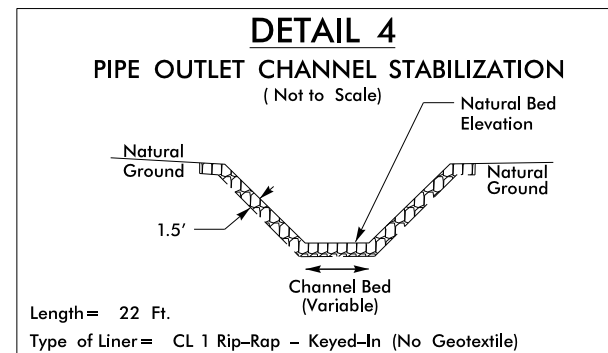

INSET

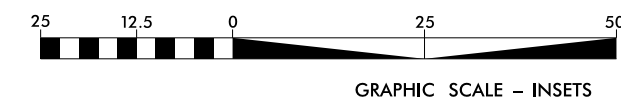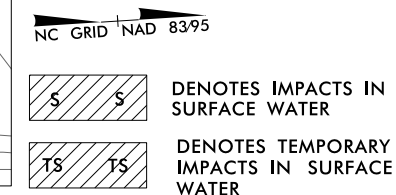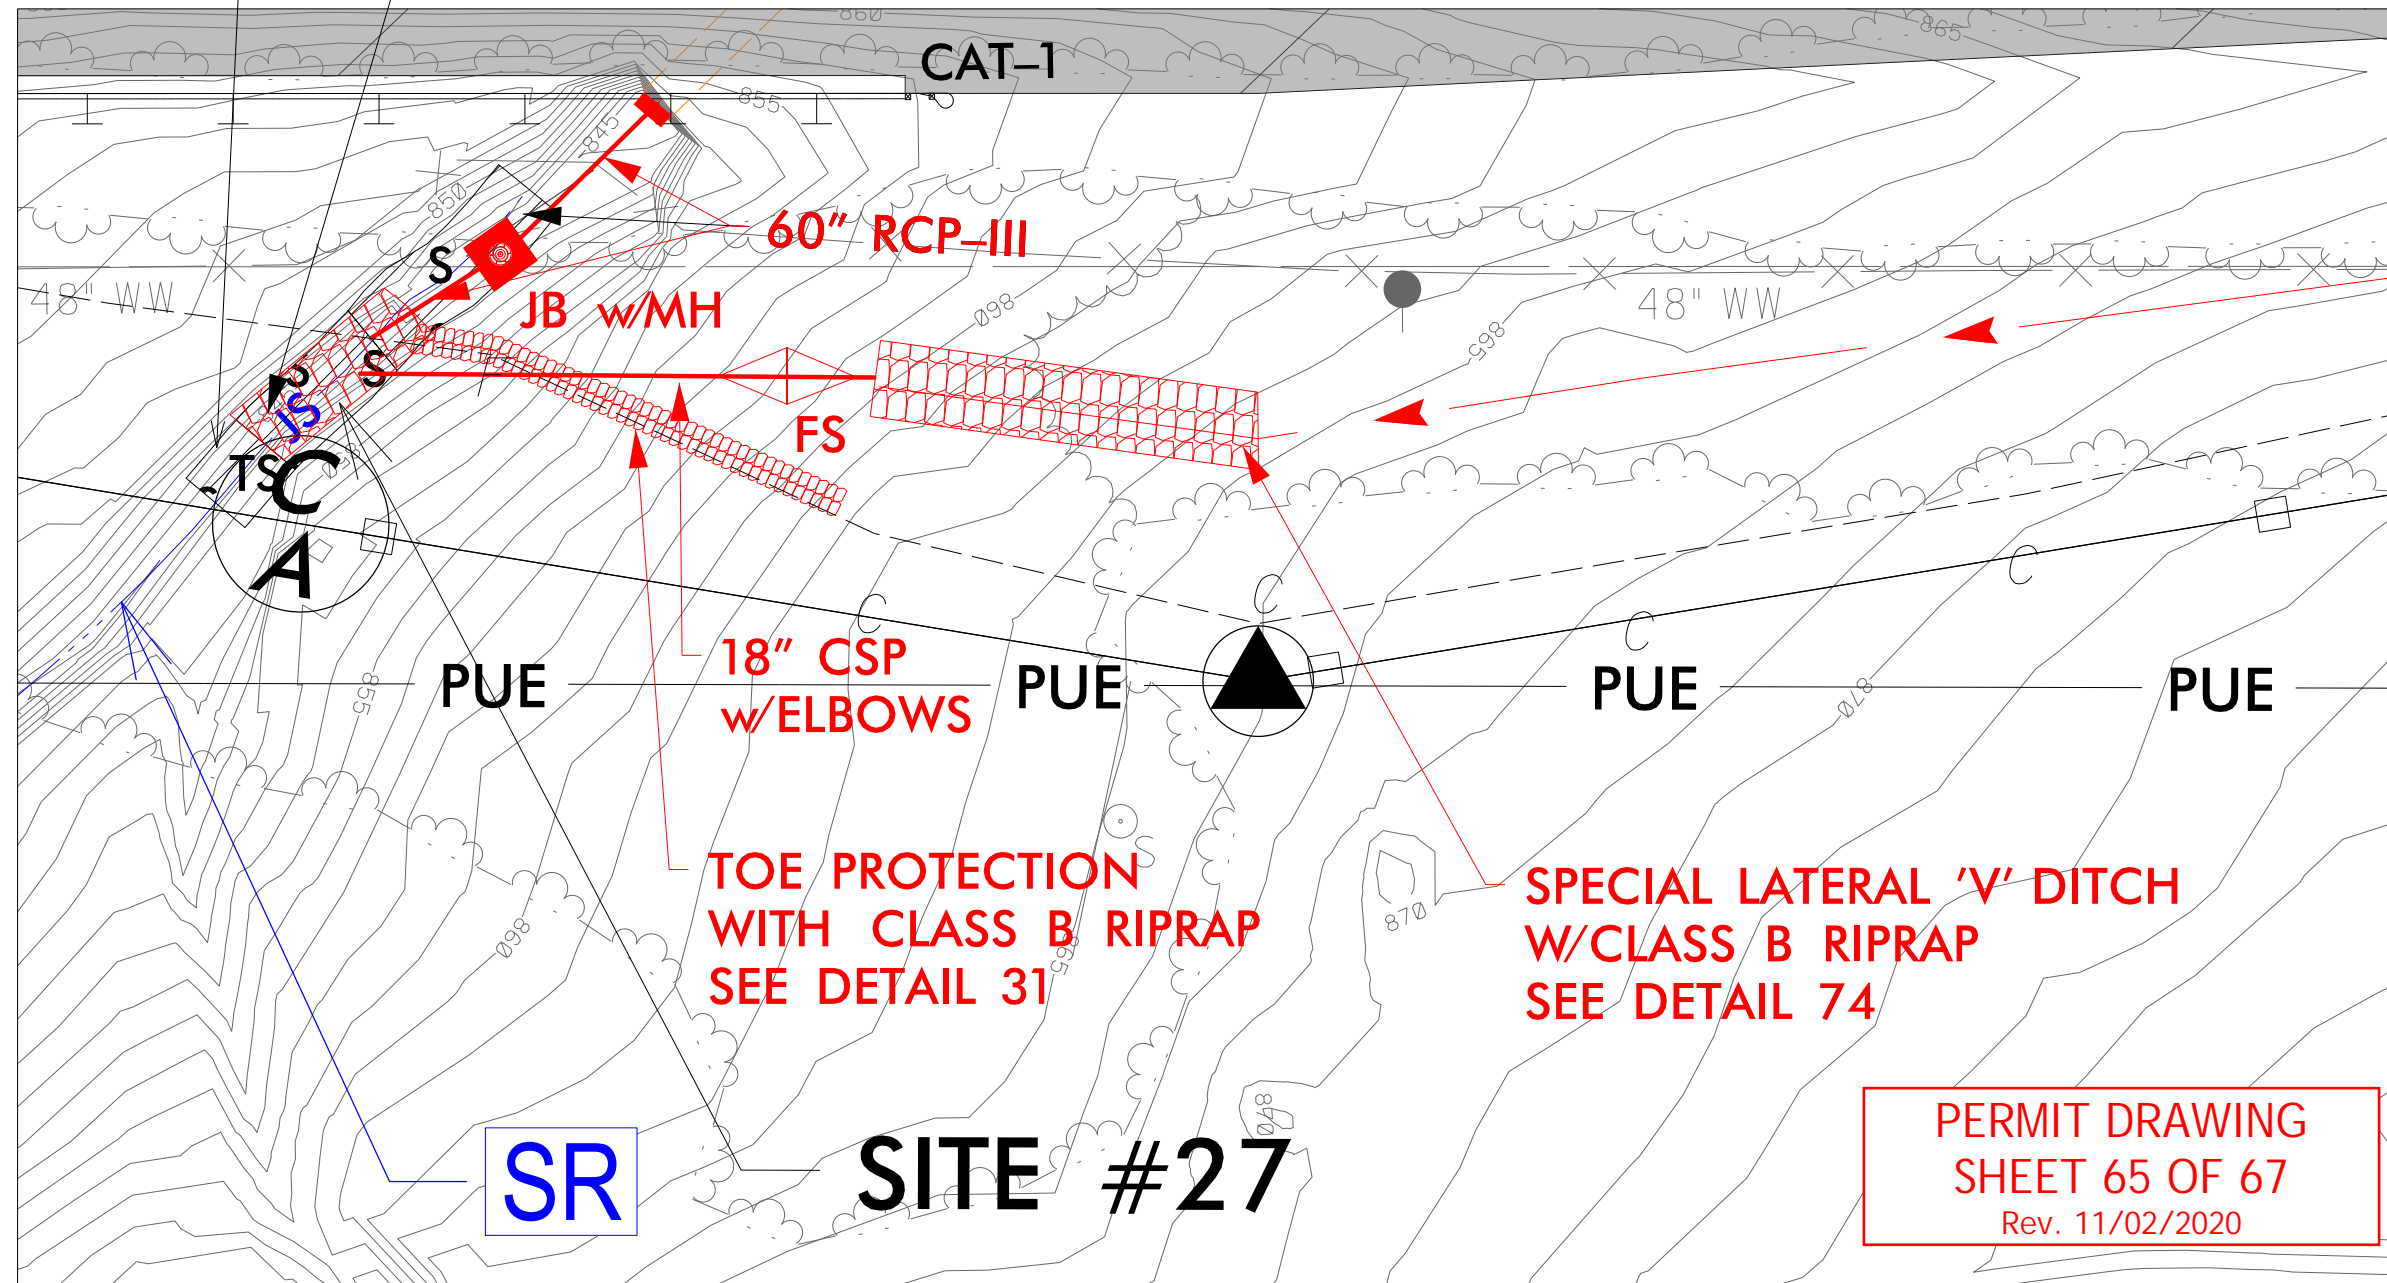



WETLAND AND SURFACE WATER IMPACTS SUMMARY												
			WETLAND IMPACTS					SURFACE WATER IMPACTS				
Site No.	Station (From/To)	Structure Size / Type	Permanent Fill In Wetlands (ac)	Temp. Fill In Wetlands (ac)	Excavation in Wetlands (ac)	Mechanized Clearing in Wetlands (ac)	Hand Clearing in Wetlands (ac)	Permanent SW impacts (ac)	Temp. SW impacts (ac)	Existing Channel Impacts Permanent (ft)	Existing Channel Impacts Temp. (ft)	Natural Stream Design (ft)
1	Site 1 Eliminated											
2	14+00 -21+50-YRPCA-	Roadway Fill	0.32			0.09						
2	16+70 - 21+50-YRPCA-	Bridge/Stream Bank Stabilization**	0.02	0.62		0.02		< 0.01	< 0.01	42	20	
3	15+75-YRPC-	Roadway Fill	< 0.01			0.01		0.02	< 0.01	206	10	
4	24+00-YRPC-	Roadway Fill				0.02						
5	70+00 - 76+25 -YRPAC-	Bridge**	0.03	1.81		0.05						
5	72+70 - 74+50 -YRPAC-	Construction Access		0.23					0.02		77	
6	121+50-Y_LT-	Stream Bank Stabilization						< 0.01	< 0.01	12	20	
7	120+90-Y_RT-	Stream Bank Stabilization						< 0.01	< 0.01	12	20	
8	19+00-YRPDB-	Roadway Fill	< 0.01			< 0.01						
9	28+50 - 34+00-YRPAC-	Roadway Fill	0.40			0.08		0.07	< 0.01	747	10	
9A	28+10 - 28+30-YRPAC-	Construction Access							0.01		50	
10	28+00-YRPAC-	Stream Bank Stabilization						< 0.01	< 0.01	25	20	
11	27+50 - 26+50-YRPAC	Roadway Fill	0.19			0.02						
12	149+00-150+00-L-	Bridge						< 0.01	0.01	10	54	
13	167+00-Y_RT-	Stream Bed Stabilization						< 0.01		17		
13	167+00-Y_RT-	Stream Bank Stabilization						< 0.01	< 0.01	44	10	
14	28+50-Y-	Stream Bed Stabilization						< 0.01	< 0.01	17	10	
15	33+75-Y-	Stream Bank Stabilization						< 0.01	< 0.01	11	20	
16	37+10-37+20-Y-	54" RCP Extension						< 0.01		15		
16	35+90-37+10-Y-	Stream Bed Stabilization						< 0.01	< 0.01	98	10	
17	37+70-37+80-Y-	54" RCP Extension						< 0.01		20		
17	37+80-38+50-Y-	Stream Bed Stabilization						0.01	< 0.01	94	14	
18	47+50-Y-	54" RCP Extension						< 0.01		39		
SHEET 66 SUBTOTALS*:			0.97	2.66	0.00	0.29	0.00	0.16	0.07	1409	345	0.00

\*Rounded totals are sum of actual impacts for sites listed on Sheet 66. See Sheet 67 for project total.

\*\*Temporary fill in wetlands includes impacts previously classified as hand clearing, changed per NCDEQ comment (matting for construction access)

WETLAND AND SURFACE WATER IMPACTS SUMMARY												
			WETLAND IMPACTS					SURFACE WATER IMPACTS				
Site No.	Station (From/To)	Structure Size / Type	Permanent Fill In Wetlands (ac)	Temp. Fill In Wetlands (ac)	Excavation in Wetlands (ac)	Mechanized Clearing in Wetlands (ac)	Hand Clearing in Wetlands (ac)	Permanent SW impacts (ac)	Temp. SW impacts (ac)	Existing Channel Impacts Permanent (ft)	Existing Channel Impacts Temp. (ft)	Natural Stream Design (ft)
18	47+50-Y-	Stream Bed Stabilization						< 0.01	< 0.01	33	10	
19	46+00-Y-	Roadway Fill						< 0.01		34		
20	68+50-Y-	New Channel						< 0.01	< 0.01	13	10	
20	68+50-Y-	Roadway Fill						< 0.01		48		
21	70+20-Y-	3@9'X11" RCBC Extension						0.02		39		
21	69+20-70+20-Y-	Stream Bed Stabilization						0.08	< 0.01	137	21	
22	71+30-71+90-Y-	3@9'X11" RCBC Extension						0.02		45		
22	71+90-72+89-Y-	Stream Bed Stabilization						0.08		160		
22	72+89-75+10-Y-	New Channel						0.08		225		
22	75+10-84+00-Y-	Stream Bank Stabilization						0.34		901		
22	83+59-83+85-Y-	Stream Bed Stabilization						< 0.01		25		
23	87+70-Y-	Roadway Fill							< 0.01		33	
24	93+75-Y-	66" RCP Extension						< 0.01	< 0.01	49	10	
25	94+50-Y-	66" RCP Extension						< 0.01		10		
25	94+50-Y-	Stream Bed Stabilization						< 0.01	< 0.01	21	21	
26	116+70-120+10-Y-	Roadway Fill	0.09			0.04						
27	210+00-Y-	60" RCP Extension						< 0.01		29		
27	210+00-Y-	Stream Bed Stabilization						< 0.01	< 0.01	19	10	
28	24+00-Y15RPB-	Stream Bed Stabilization						< 0.01	< 0.01	16	11	
SHEET 66 SUBTOTAL			0.97	2.66	0.00	0.29	0.00	0.16	0.07	1409	345	0.00
SHEET 67 SUBTOTAL			0.09	0.00	0.00	0.04	0.00	0.67	0.03	1804	126	0.00
PROJECT TOTALS*:			1.06	2.66	0.00	0.33	0.00	0.83	0.10	3213	471	0.00


\*Rounded totals are sum of actual impacts for entire project area



9/17/2020 c:\projectwise\pb\projectwise\becker\jw\3819BU-6039\hyd\_prm\_TSH\_Utility.dgn becker\jw


TIP PROJECT: I-3819BU-6039

PROJECT: 34192.1.2

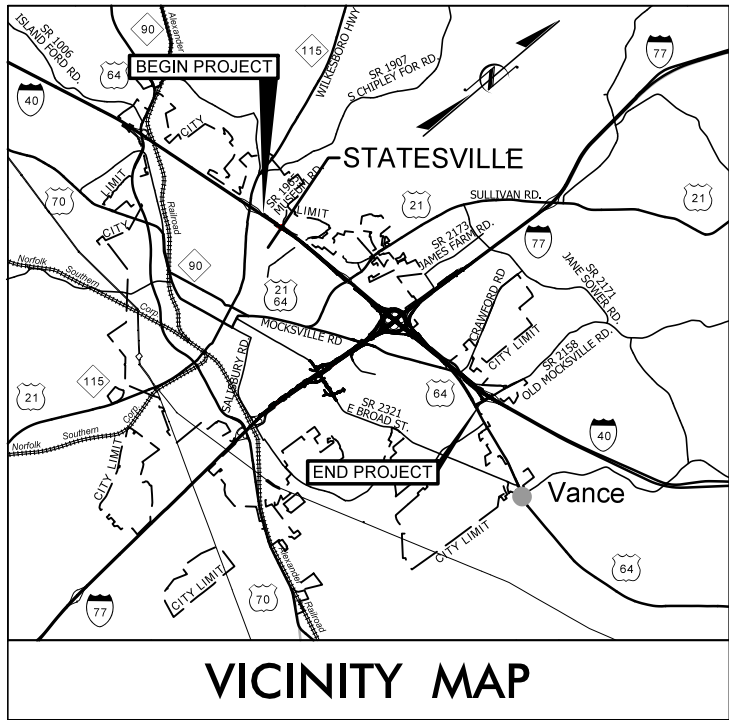

VICINITY MAP

THIS PROJECT IS WITHIN THE MUNICIPAL BOUNDARIES OF THE CITY OF STATESVILLE AND THE TOWNSHIP OF BETHANY

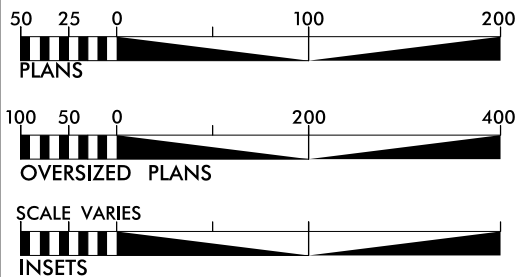

UTILITY PERMIT  
DRAWING  
SHEET 1 OF 8  
Rev. 11/02/2020

CLEARING ON THIS PROJECT SHALL BE PERFORMED TO THE LIMITS ESTABLISHED BY METHOD III.

THIS IS A CONTROLLED ACCESS PROJECT WITH ACCESS BEING LIMITED TO INTERCHANGES

GRAPHIC SCALES

SEE ABOVE

DESIGN DATA


	I-40	I-77
ADT 2018	= 57,300	62,900
ADT 2040	= 72,500	77,500
DHV	= 5,800	6,200
D	= 55 %	55 %
T	= 16 % *	19 % **
V	= 60 MPH	60 MPH
* TTST 13	+ DUAL 3 (I-40)	
** TTST 16	+ DUAL 3 (I-77)	
CLASSIFICATION:	INTERSTATE	

STATE OF NORTH CAROLINA  
DIVISION OF HIGHWAYS

IREDELL COUNTY

LOCATION: I-40/I-77 INTERCHANGE INCLUDING I-40 FROM WEST OF SR 2003 (RADIO RD.) TO SR 2158 (OLD MOCKSVILLE RD.) & I-77 FROM SOUTH OF SR 2321 (EAST BROAD ST.) TO SOUTH OF SR 2171 (JANE SOWERS RD.)

TYPE OF WORK: GRADING, DRAINAGE, PAVING, STRUCTURES, RETAINING WALLS, NOISE WALLS, AND TRAFFIC CONTROL

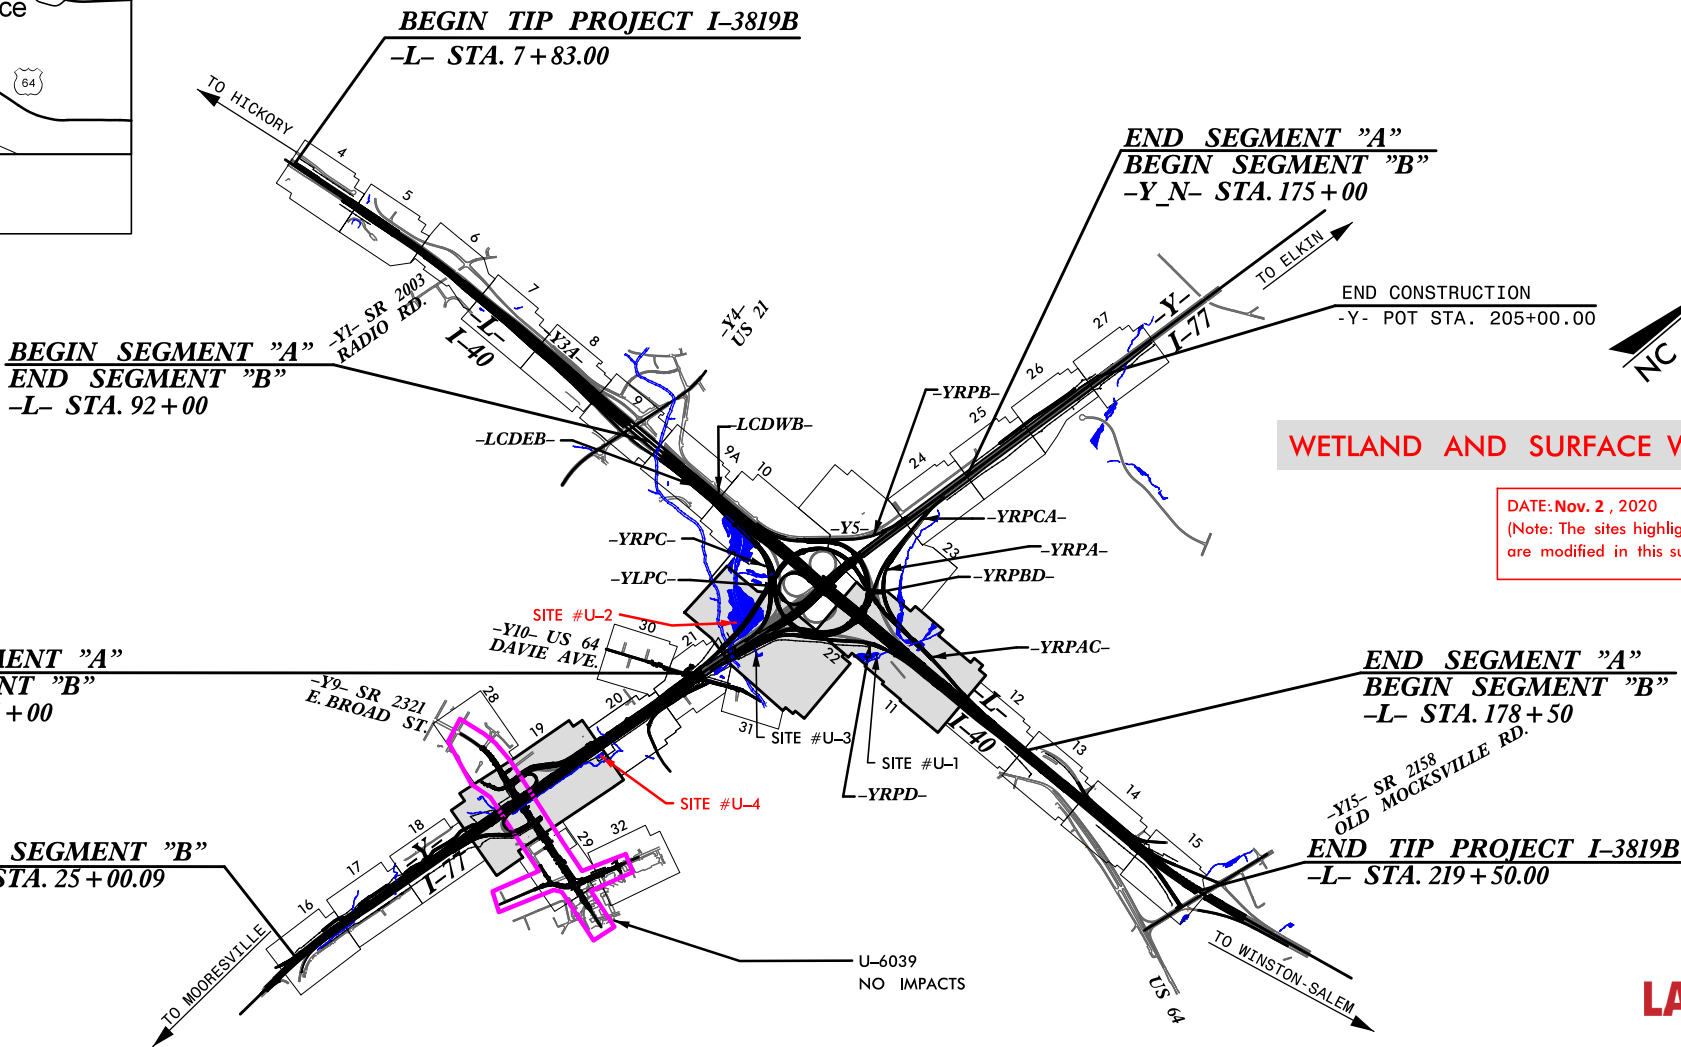

WETLAND AND SURFACE WATER IMPACT PERMITS

DATE: Nov. 2, 2020  
(Note: The sites highlighted in RED are modified in this submittal.)

LANE

INCOMPLETE PLANS  
DO NOT USE FOR R/W ACQUISITION

Prepared In the Office of:

WSP

1001 Morehead Square Dr., Suite 610, Charlotte, NC 28203  
NC LIC. NO. F-0165

2018 STANDARD SPECIFICATIONS

RIGHT OF WAY DATE:  
OCTOBER 30, 2018

LETTING DATE:  
OCTOBER 30, 2018

CHRISTOPHER D. DAVIS, P.E.  
PROJECT ENGINEER

ERIC W. SECKINGER, P.E.  
PROJECT DESIGN ENGINEER


HYDRAULICS ENGINEER

SIGNATURE: P.E.

ROADWAY DESIGN  
ENGINEER

SIGNATURE: P.E.

DIVISION OF HIGHWAYS  
STATE OF NORTH CAROLINA

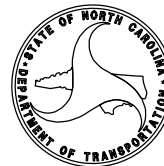


STATE HIGHWAY DESIGN ENGINEER



UTILITY PERMIT  
DRAWING  
SHEET 3a OF 8  
Rev. 11/02/2020

-MATCHLINE STA- 19 + 50.00 -Y9- SEE SHEET NO. 28





1801 Morehead Square Dr.,  
Suite 410, Charlotte, NC 28203  
NC LIC. NO. F-0165

PROJECT REFERENCE NO. 17-36398  
SHEET NO. 19  
ROADWAY DESIGN ENGINEER  
HYDRAULICS ENGINEER  
DOCUMENT NOT CONSIDERED FINAL  
UNLESS ALL SIGNATURES COMPLETED

NET GRID NAD 8395

..... DENOTES MECHANIZED  
CLEARING

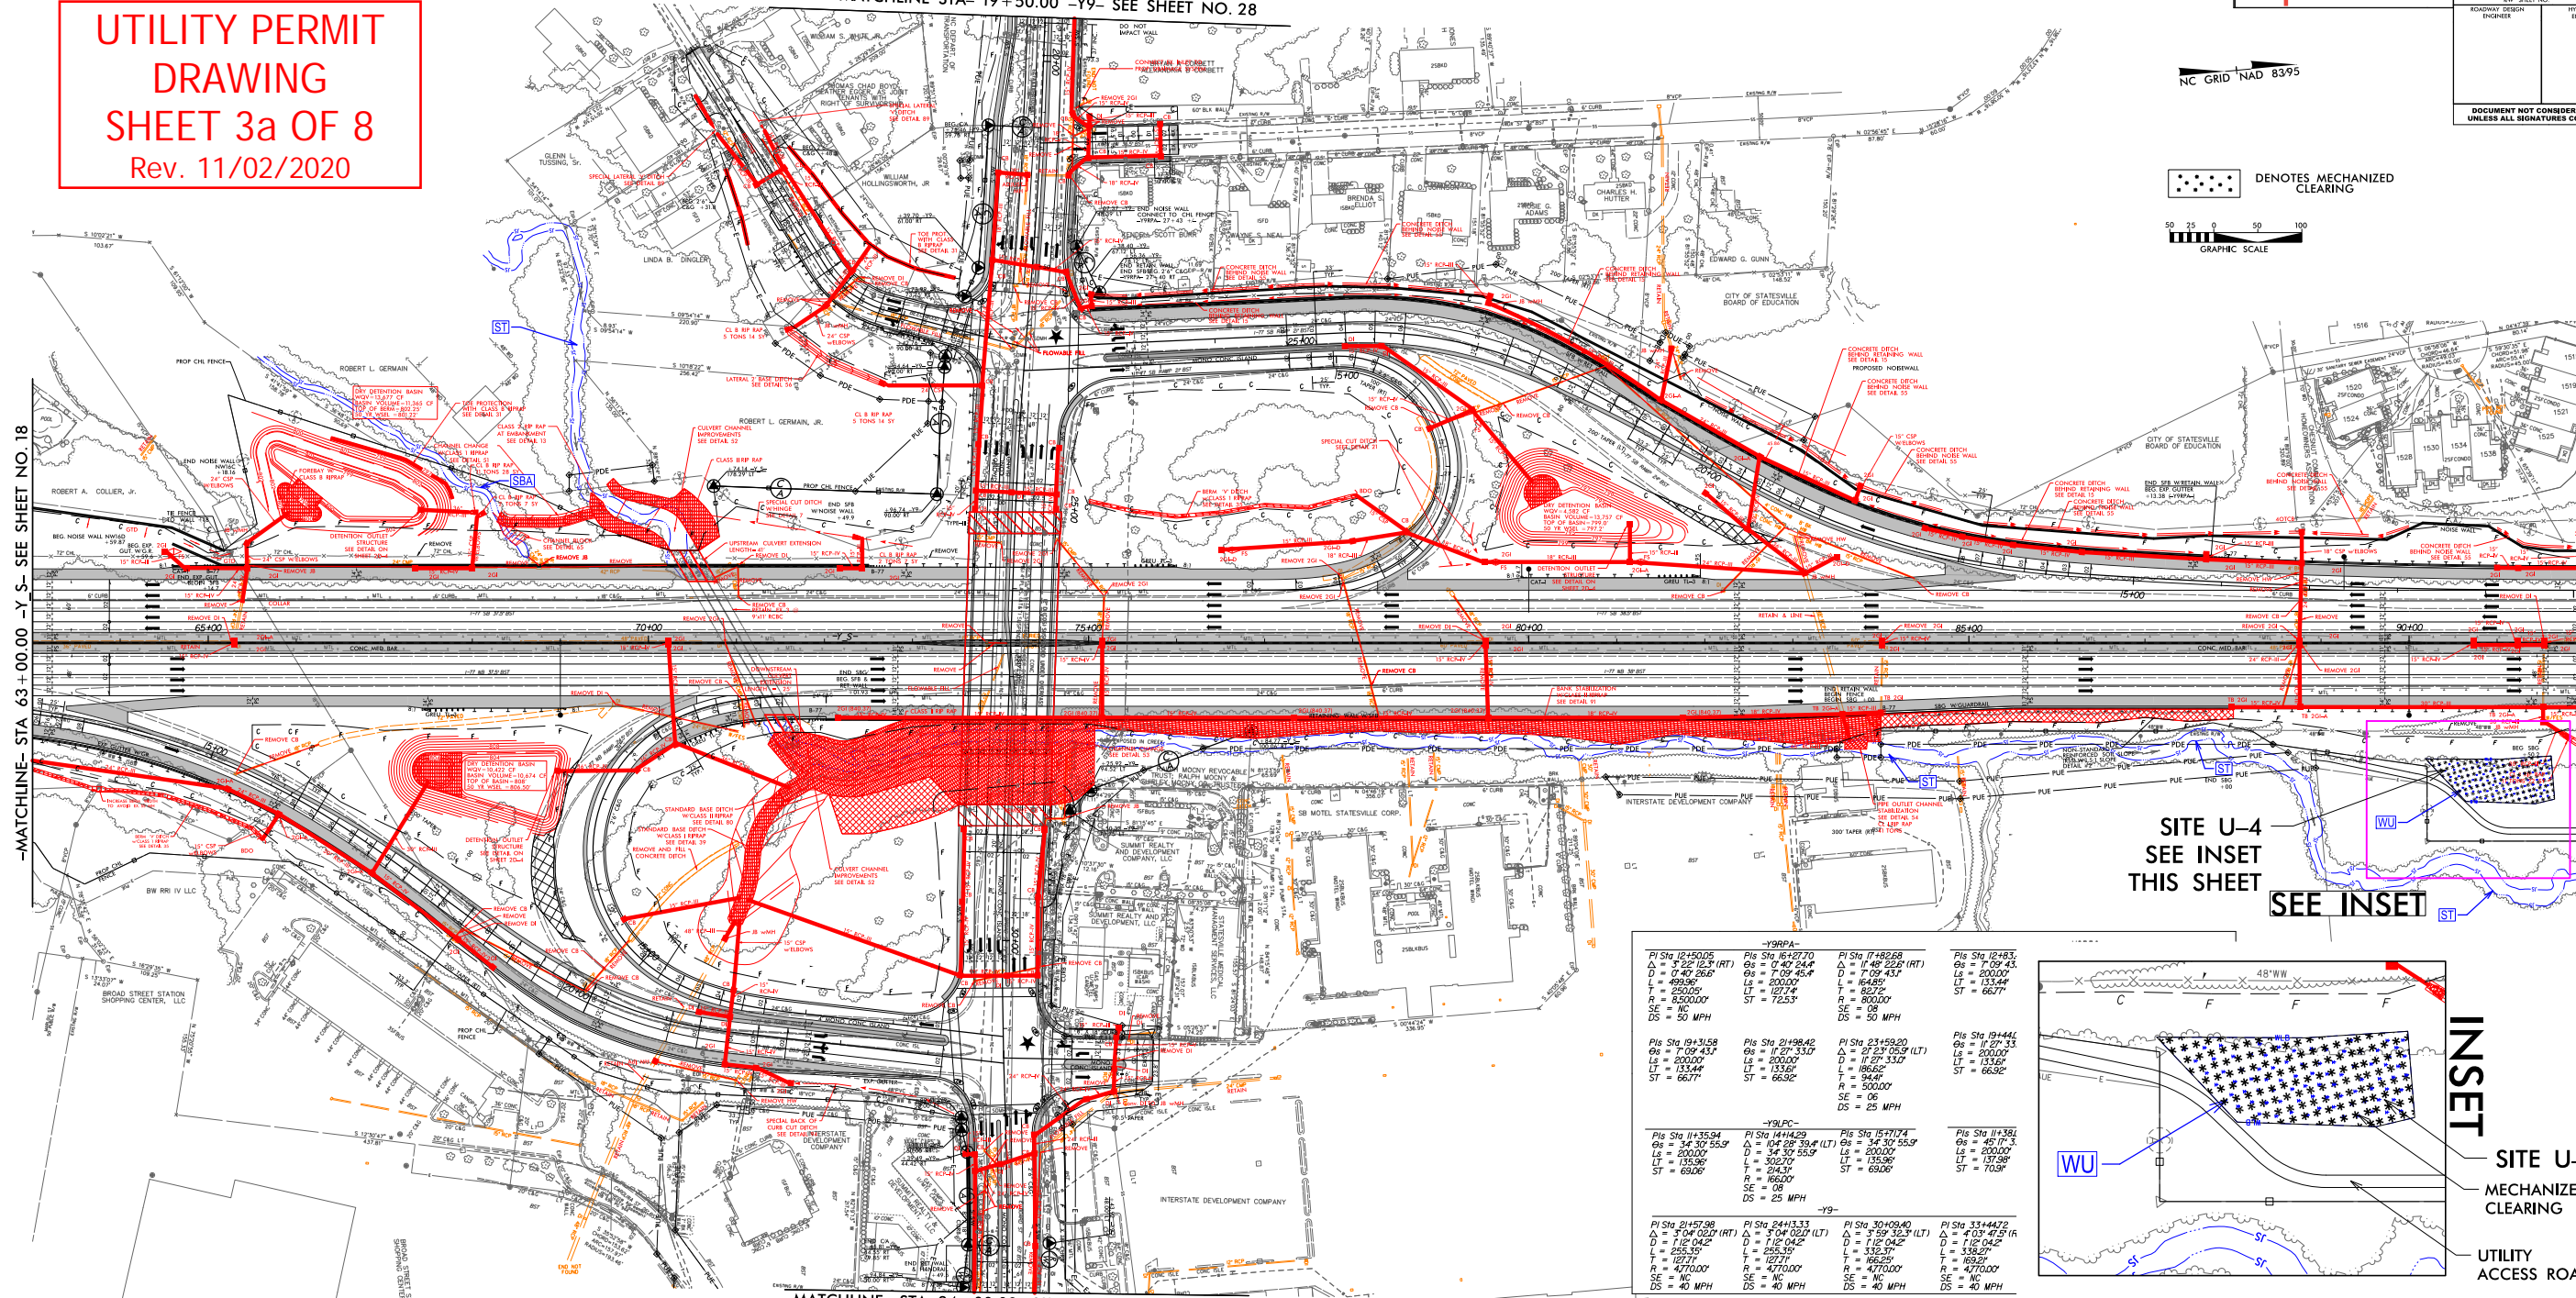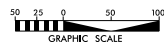

-MATCHLINE- STA 63 + 00.00 -Y S- SEE SHEET NO. 18


-MATCHLINE- STA 92 + 00.00 -Y S- SEE SHEET NO. 20

-MATCHLINE- STA 34 + 00.00 -Y9- SEE SHEET NO. 29

SITE U-4  
SEE INSET  
THIS SHEET

SEE INSET

-Y9RPA-			
Pls Sta 12+50.05 Δ = 3° 22' 12.3" (RT) D = 164.95' L = 164.95' T = 250.00' SE = 08 DS = 50 MPH	Pls Sta 16+21.70 Δ = 0° 40' 24.4" D = 200.00' L = 200.00' T = 127.74' SE = 08 DS = 25 MPH	Pls Sta 17+82.68 Δ = 1° 48' 22.6" (RT) D = 173.41' L = 164.95' T = 82.72' SE = 08 DS = 50 MPH	Pls Sta 12+83.3 Δ = 7° 09' 43.3" D = 200.00' L = 133.44' T = 66.71' SE = 08 DS = 25 MPH
-Y9LPC-			
Pls Sta 19+31.58 Δ = 1° 04' 05.2" (RT) D = 200.00' L = 133.44' T = 66.71' SE = 08 DS = 40 MPH	Pls Sta 21+98.42 Δ = 1° 27' 33.0" D = 200.00' L = 133.44' T = 66.71' SE = 08 DS = 25 MPH	Pls Sta 23+59.20 Δ = 2° 39' 53.9" (LT) D = 172.73' L = 164.95' T = 82.72' SE = 08 DS = 25 MPH	Pls Sta 19+44.6 Δ = 1° 27' 33.3" D = 200.00' L = 133.44' T = 66.71' SE = 08 DS = 25 MPH
-Y9-			
Pls Sta 21+57.96 Δ = 1° 04' 05.2" (RT) D = 112° 04' 2" L = 255.15' T = 127.74' SE = 08 DS = 40 MPH	Pls Sta 24+13.33 Δ = 1° 04' 05.2" (LT) D = 112° 04' 2" L = 255.15' T = 127.74' SE = 08 DS = 40 MPH	Pls Sta 30+08.40 Δ = 3° 59' 53.9" (LT) D = 112° 04' 2" L = 255.15' T = 127.74' SE = 08 DS = 40 MPH	Pls Sta 33+44.72 Δ = 1° 04' 05.2" (RT) D = 112° 04' 2" L = 255.15' T = 127.74' SE = 08 DS = 40 MPH

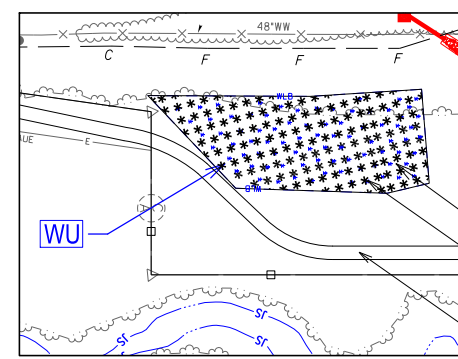

INSET

SITE U-4  
MECHANIZED  
CLEARING

UTILITY  
ACCESS ROAD



LOCATION: 1/7 AT E. BROAD STREET

TP NO. 1-38198 COUNTY: BURL


DESIGNED BY: C. DAVE

CHECKED BY: D. ANDREWS DATE: 6-3-2019



UTILITY PERMIT  
DRAWING  
SHEET 3b OF 8  
Rev. 11/02/2020

-MATCHLINE STA- 19+50.00 -Y9- SEE SHEET NO. 28




1801 Morehead Square Dr.,  
Suite 510, Charlotte, NC 28203  
NC LIC. NO. F-0165

PROJECT REFERENCE NO. 17-38398  
SHEET NO. 19  
ROADWAY DESIGN ENGINEER  
HYDRAULICS ENGINEER  
DOCUMENT NOT CONSIDERED FINAL  
UNLESS ALL SIGNATURES COMPLETED

NC GRID NAD 8395

..... DENOTES MECHANIZED  
CLEARING

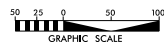


-MATCHLINE- STA 63+00.00 -Y- SEE SHEET NO. 18

-MATCHLINE- STA 92+00.00 -Y- SEE SHEET NO. 20

SITE U-4  
SEE INSET  
THIS SHEET  
SEE INSET

-Y9P1-			
PI Sta 12150.05 Δ = 3°22'12.3" (RT) L = 0.40 24.0 T = 64.96 R = 200.00 SE = 0 DS = 50 MPH	PI Sta 12167.40 Δ = 0°42'24.4" L = 7.09 45.4 T = 200.00 ST = 72.53 SE = 0 DS = 50 MPH	PI Sta 12182.68 Δ = 1°48'28.6" (RT) L = 7.09 45.4 T = 64.96 R = 200.00 SE = 0 DS = 50 MPH	PI Sta 12183.3 Δ = 1°48'28.6" (RT) L = 7.09 45.4 T = 64.96 ST = 66.77 SE = 0 DS = 50 MPH
-Y9P2-			
PI Sta 19+31.58 Δ = 1°27'33.0" L = 200.00 T = 133.44 ST = 66.77 SE = 0 DS = 50 MPH	PI Sta 21+98.42 Δ = 1°27'33.0" L = 200.00 T = 133.44 ST = 66.77 SE = 0 DS = 50 MPH	PI Sta 23+59.20 Δ = 1°27'33.0" (LT) L = 186.66 T = 64.96 R = 200.00 SE = 0 DS = 50 MPH	PI Sta 24+44.4 Δ = 1°27'33.0" L = 186.66 T = 64.96 ST = 66.77 SE = 0 DS = 50 MPH
-Y9LPC-			
PI Sta 11+35.94 Δ = 3°34'55.9" (RT) L = 200.00 T = 133.44 ST = 66.77 SE = 0 DS = 50 MPH	PI Sta 14+14.29 Δ = 1°04'39.4" (LT) L = 34.30 55.9 T = 302.71 R = 133.44 SE = 0 DS = 25 MPH	PI Sta 15+71.74 Δ = 3°34'55.9" (RT) L = 200.00 T = 133.44 ST = 66.77 SE = 0 DS = 50 MPH	PI Sta 17+38.1 Δ = 1°04'39.4" (LT) L = 34.30 55.9 T = 302.71 R = 133.44 SE = 0 DS = 25 MPH
-Y9-			
PI Sta 21+57.96 Δ = 1°12'04.2" L = 166.25 T = 127.71 SE = 0 DS = 40 MPH	PI Sta 24+13.33 Δ = 1°12'04.2" L = 166.25 T = 127.71 SE = 0 DS = 40 MPH	PI Sta 30+08.40 Δ = 1°12'04.2" (LT) L = 166.25 T = 127.71 SE = 0 DS = 40 MPH	PI Sta 33+44.78 Δ = 1°12'04.2" L = 166.25 T = 127.71 SE = 0 DS = 40 MPH

-MATCHLINE- STA 34+00.00 -Y9- SEE SHEET NO. 29

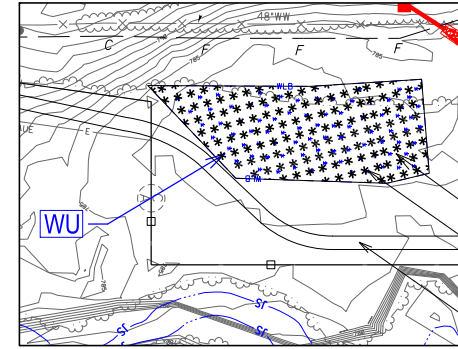

INSET  
SITE U-4  
MECHANIZED  
CLEARING  
UTILITY  
ACCESS ROAD



LOCATION: 1/17 AT E. BROAD STREET

TP NO. 1-38398 COUNTY: MEDELL

DESIGNED BY: C. DAVE

CHECKED BY: D. BARNWORTH DATE: 6-3-2019



UTILITY PERMIT  
DRAWING  
SHEET 4 OF 8  
Rev. 11/02/2020

1801 Morehead Square Dr.,  
Suite 510, Charlotte, NC 28203  
NC LIC. NO. F-0165

WSP

WSP

PROJECT REFERENCE NO.

7-38398

SHEET NO.

22

ROADWAY DESIGN  
ENGINEER

HYDRAULICS  
ENGINEER

DOCUMENT NOT CONSIDERED FINAL  
UNLESS ALL SIGNATURES COMPLETED

-YRPD-			
PI Sta 14+24.03 Δ = 2° 30' 00.3" (RT) D = 0° 39' 18.5" L = 392.80' T = 196.43' R = 3000.00' SE = 06 DS = 50 MPH	PI Sta 23+14.30 Δ = 4° 52' 55.2" D = 6° 40' 50.0" L = 433.64' T = 223.17' R = 845.00' SE = 06 DS = 50 MPH	PI Sta 26+14.59 Δ = 2° 30' 00.3" (RT) D = 0° 39' 18.5" L = 392.80' T = 196.43' R = 3000.00' SE = 06 DS = 50 MPH	PI Sta 29+03.94 Δ = 4° 52' 55.2" D = 6° 40' 50.0" L = 433.64' T = 223.17' R = 845.00' SE = 06 DS = 50 MPH
-YRPC-			
PI Sta 17+68.63 Δ = 2° 30' 00.3" (RT) D = 0° 39' 18.5" L = 392.80' T = 196.43' R = 3000.00' SE = 06 DS = 50 MPH	PI Sta 23+14.30 Δ = 4° 52' 55.2" D = 6° 40' 50.0" L = 433.64' T = 223.17' R = 845.00' SE = 06 DS = 50 MPH	PI Sta 26+14.59 Δ = 2° 30' 00.3" (RT) D = 0° 39' 18.5" L = 392.80' T = 196.43' R = 3000.00' SE = 06 DS = 50 MPH	PI Sta 29+03.94 Δ = 4° 52' 55.2" D = 6° 40' 50.0" L = 433.64' T = 223.17' R = 845.00' SE = 06 DS = 50 MPH
-YRT-			
PI Sta 13+17.38 Δ = 2° 30' 00.3" (RT) D = 0° 39' 18.5" L = 392.80' T = 196.43' R = 3000.00' SE = 06 DS = 50 MPH	PI Sta 23+14.30 Δ = 4° 52' 55.2" D = 6° 40' 50.0" L = 433.64' T = 223.17' R = 845.00' SE = 06 DS = 50 MPH	PI Sta 26+14.59 Δ = 2° 30' 00.3" (RT) D = 0° 39' 18.5" L = 392.80' T = 196.43' R = 3000.00' SE = 06 DS = 50 MPH	PI Sta 29+03.94 Δ = 4° 52' 55.2" D = 6° 40' 50.0" L = 433.64' T = 223.17' R = 845.00' SE = 06 DS = 50 MPH
-YRPC-			
PI Sta 14+24.03 Δ = 2° 30' 00.3" (RT) D = 0° 39' 18.5" L = 392.80' T = 196.43' R = 3000.00' SE = 06 DS = 50 MPH	PI Sta 23+14.30 Δ = 4° 52' 55.2" D = 6° 40' 50.0" L = 433.64' T = 223.17' R = 845.00' SE = 06 DS = 50 MPH	PI Sta 26+14.59 Δ = 2° 30' 00.3" (RT) D = 0° 39' 18.5" L = 392.80' T = 196.43' R = 3000.00' SE = 06 DS = 50 MPH	PI Sta 29+03.94 Δ = 4° 52' 55.2" D = 6° 40' 50.0" L = 433.64' T = 223.17' R = 845.00' SE = 06 DS = 50 MPH

- Denotes Fill in Wetland
- Denotes Temporary Fill in Wetland
- Denotes Mechanized Clearing
- Denotes Hand Clearing

LOCATION

TP NO. 1-30318

COUNTY 10000

DESIGNED BY C. DAVE

CHECKED BY D. ANDREWS DATE 6-3-2019



UTILITY PERMIT  
DRAWING  
SHEET 5 OF 8  
Rev. 11/02/2020

1801 Morehead Square Dr.,  
Suite 510, Charlotte, NC 28203

NC LIC. NO. F-0165

WSP

11/02/2020

PROJECT REFERENCE NO.  
7-3639

SHEET NO.  
22

NEW SHEET NO.

ROADWAY DESIGN  
ENGINEER

HYDRAULICS  
ENGINEER

DOCUMENT NOT CONSIDERED FINAL  
UNLESS ALL SIGNATURES COMPLETED

Y-RPAC		Y-RPAC		Y-RPAC		Y-RPAC	
PI Sta 11+68.63	PI Sta 17+46.63	PI Sta 23+14.30	PI Sta 26+44.31	PI Sta 29+03.94	PI Sta 30+92.94	PI Sta 31+44.31	PI Sta 32+92.94
Δ = 5° 30' 00" (RT)	Δ = 5° 30' 00" (RT)	Δ = 4° 52' 52" (RT)	Δ = 5° 30' 00" (RT)	Δ = 4° 52' 52" (RT)	Δ = 4° 52' 52" (RT)	Δ = 4° 52' 52" (RT)	Δ = 4° 52' 52" (RT)
D = 0° 00' 00" (RT)	D = 0° 00' 00" (RT)	D = 0° 00' 00" (RT)	D = 0° 00' 00" (RT)	D = 0° 00' 00" (RT)	D = 0° 00' 00" (RT)	D = 0° 00' 00" (RT)	D = 0° 00' 00" (RT)
L = 0° 00' 00" (RT)	L = 0° 00' 00" (RT)	L = 0° 00' 00" (RT)	L = 0° 00' 00" (RT)	L = 0° 00' 00" (RT)	L = 0° 00' 00" (RT)	L = 0° 00' 00" (RT)	L = 0° 00' 00" (RT)
SE = 0° 00' 00" (RT)	SE = 0° 00' 00" (RT)	SE = 0° 00' 00" (RT)	SE = 0° 00' 00" (RT)	SE = 0° 00' 00" (RT)	SE = 0° 00' 00" (RT)	SE = 0° 00' 00" (RT)	SE = 0° 00' 00" (RT)
DS = 50 MPH	DS = 50 MPH	DS = 50 MPH	DS = 50 MPH	DS = 50 MPH	DS = 50 MPH	DS = 50 MPH	DS = 50 MPH

- Denotes Fill in Wetland
- Denotes Temporary Fill in Wetland
- Denotes Mechanized Clearing
- Denotes Hand Clearing

SITE #U-3

HAND CLEARING

LOCATION

TP NO. 1-3018

COUNTY 10000

DESIGNED BY C. DAVE

CHECKED BY D. BROWN DATE 1-3-2017




PROJECT REFERENCE NO.	SHEET NO.
1-3819B	22A
R/W SHEET NO.	
ROADWAY DESIGN ENGINEER	HYDRAULICS ENGINEER

DOCUMENT NOT CONSIDERED FINAL  
UNLESS ALL SIGNATURES COMPLETED

UTILITY PERMIT  
DRAWING  
SHEET 6 OF 8  
Rev. 11/02/2020

# SITE U-2 INSET

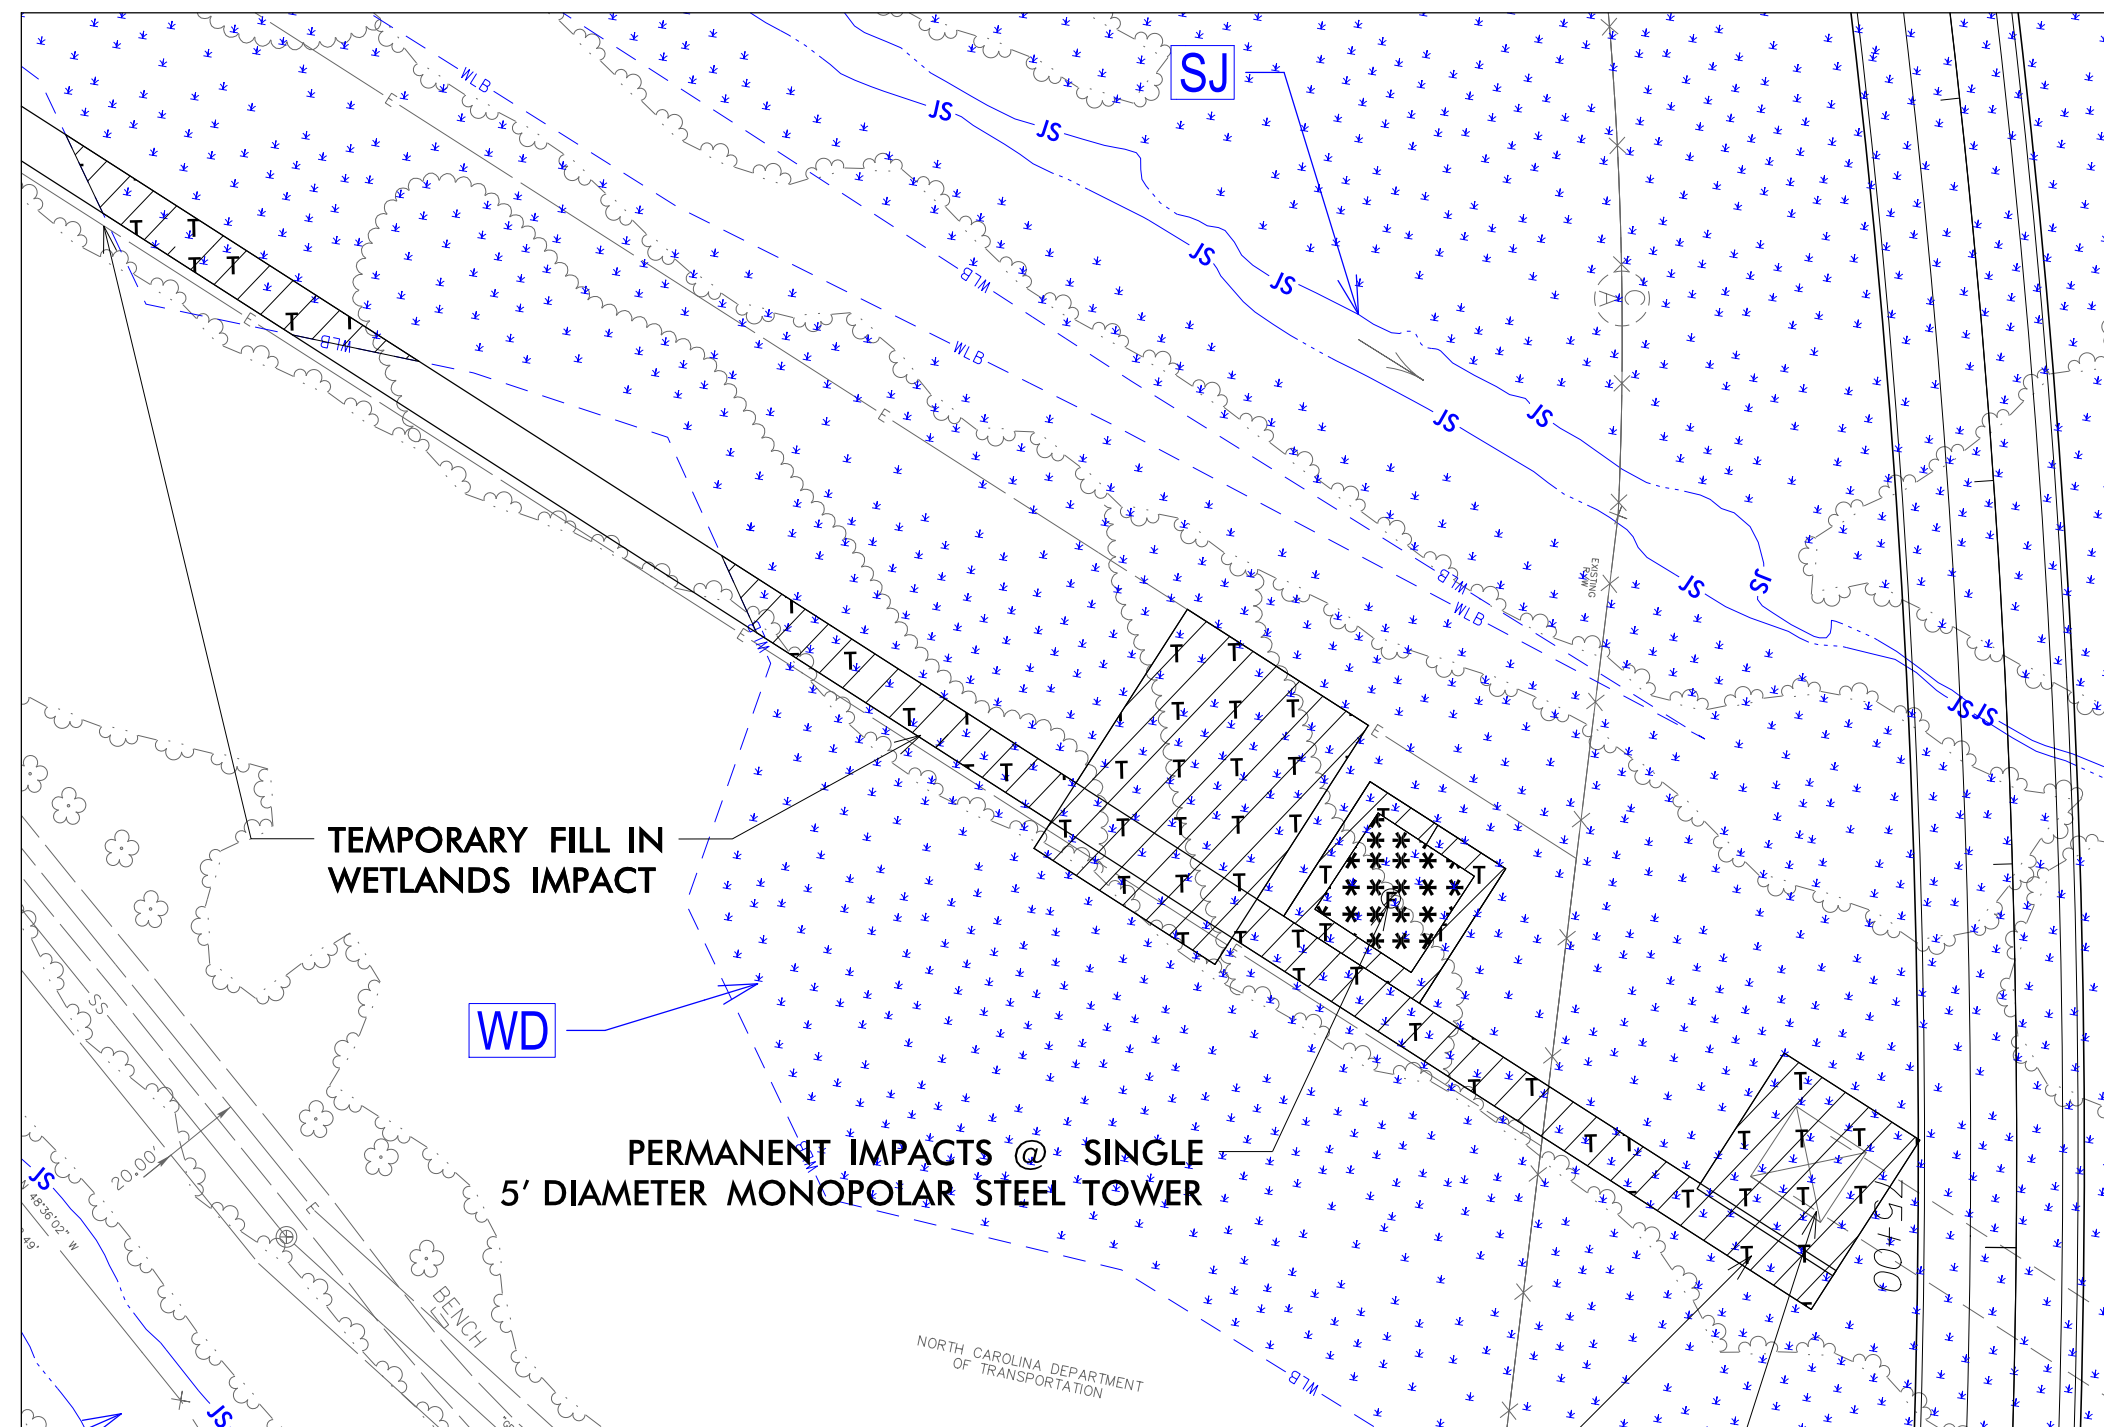

NC GRID NAD 8395

- DENOTES FILL IN WETLAND
- DENOTES TEMPORARY FILL IN WETLAND
- DENOTES MECHANIZED CLEARING




GRAPHIC SCALE - INSETS



UTILITY PERMIT  
DRAWING  
SHEET 7 OF 8  
Rev. 11/02/2020

SITE U-2

INSET

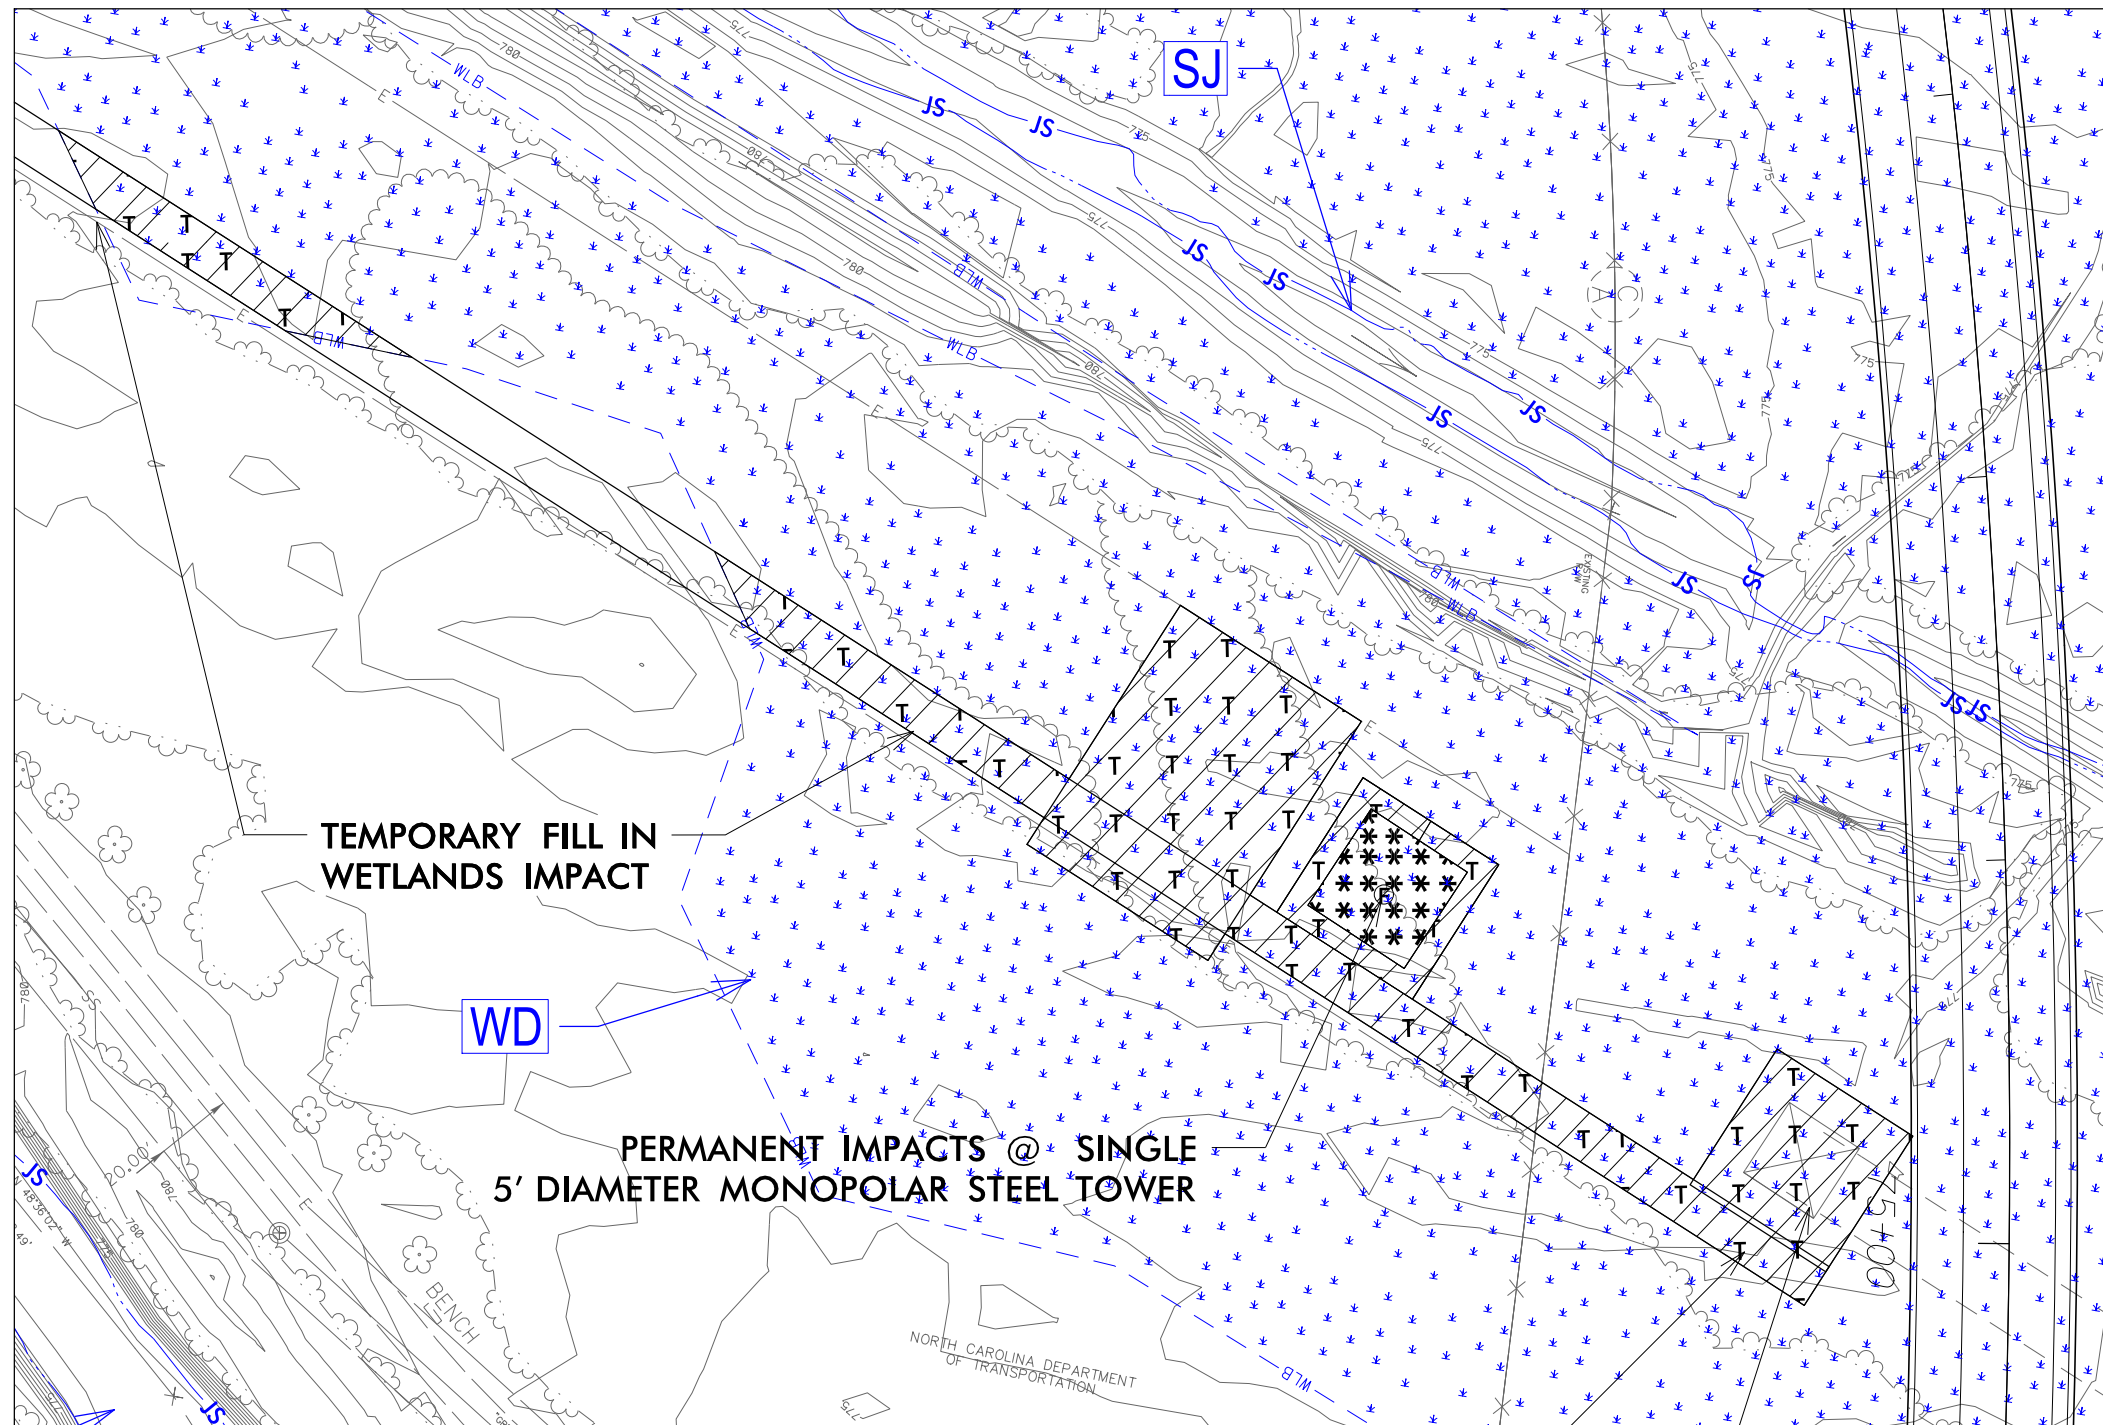

- F

F

DENOTES FILL IN WETLAND
- T

T
- DENOTES TEMPORARY FILL IN WETLAND

\*

\*

WETLAND AND SURACE WATER IMPACTS SUMMARY												
			WETLAND IMPACTS					SURFACE WATER IMPACTS				
Site No.	Station (From/To)	Structure Size / Type	Permanent Fill In Wetlands (ac)	Temp. Fill In Wetlands (ac)	Excavation in Wetlands (ac)	Mechanized Clearing in Wetlands (ac)	Hand Clearing in Wetlands (ac)	Permanent SW impacts (ac)	Temp. SW impacts (ac)	Existing Channel Impacts Permanent (ft)	Existing Channel Impacts Temp. (ft)	Natural Stream Design (ft)
U-1	31+50-YRPD-	Utility		0.02								
U-2	75+00-YRPAC-**	Utility	< 0.01	0.25		0.02						
U-3	18+92-YRPDB-	Utility					< 0.01					
U-4	91+00-Y_S-	Utility				0.14						
TOTALS*:			< 0.01	0.27		0.16	< 0.01					

\*Rounded totals are sum of actual impacts for entire project area

\*\*Permanent Impact from a single 5 ft diameter monopole foundation for new transmission tower location.


NC DEPARTMENT OF TRANSPORTATION  
DIVISION OF HIGHWAYS  
11/02/2020  
IREDELL  
TIP NO. I-3819B  
WBS NO.  
SHEET 8 OF 8







1. REVISION: 11/2/20  
2. REVISION: 11/2/20  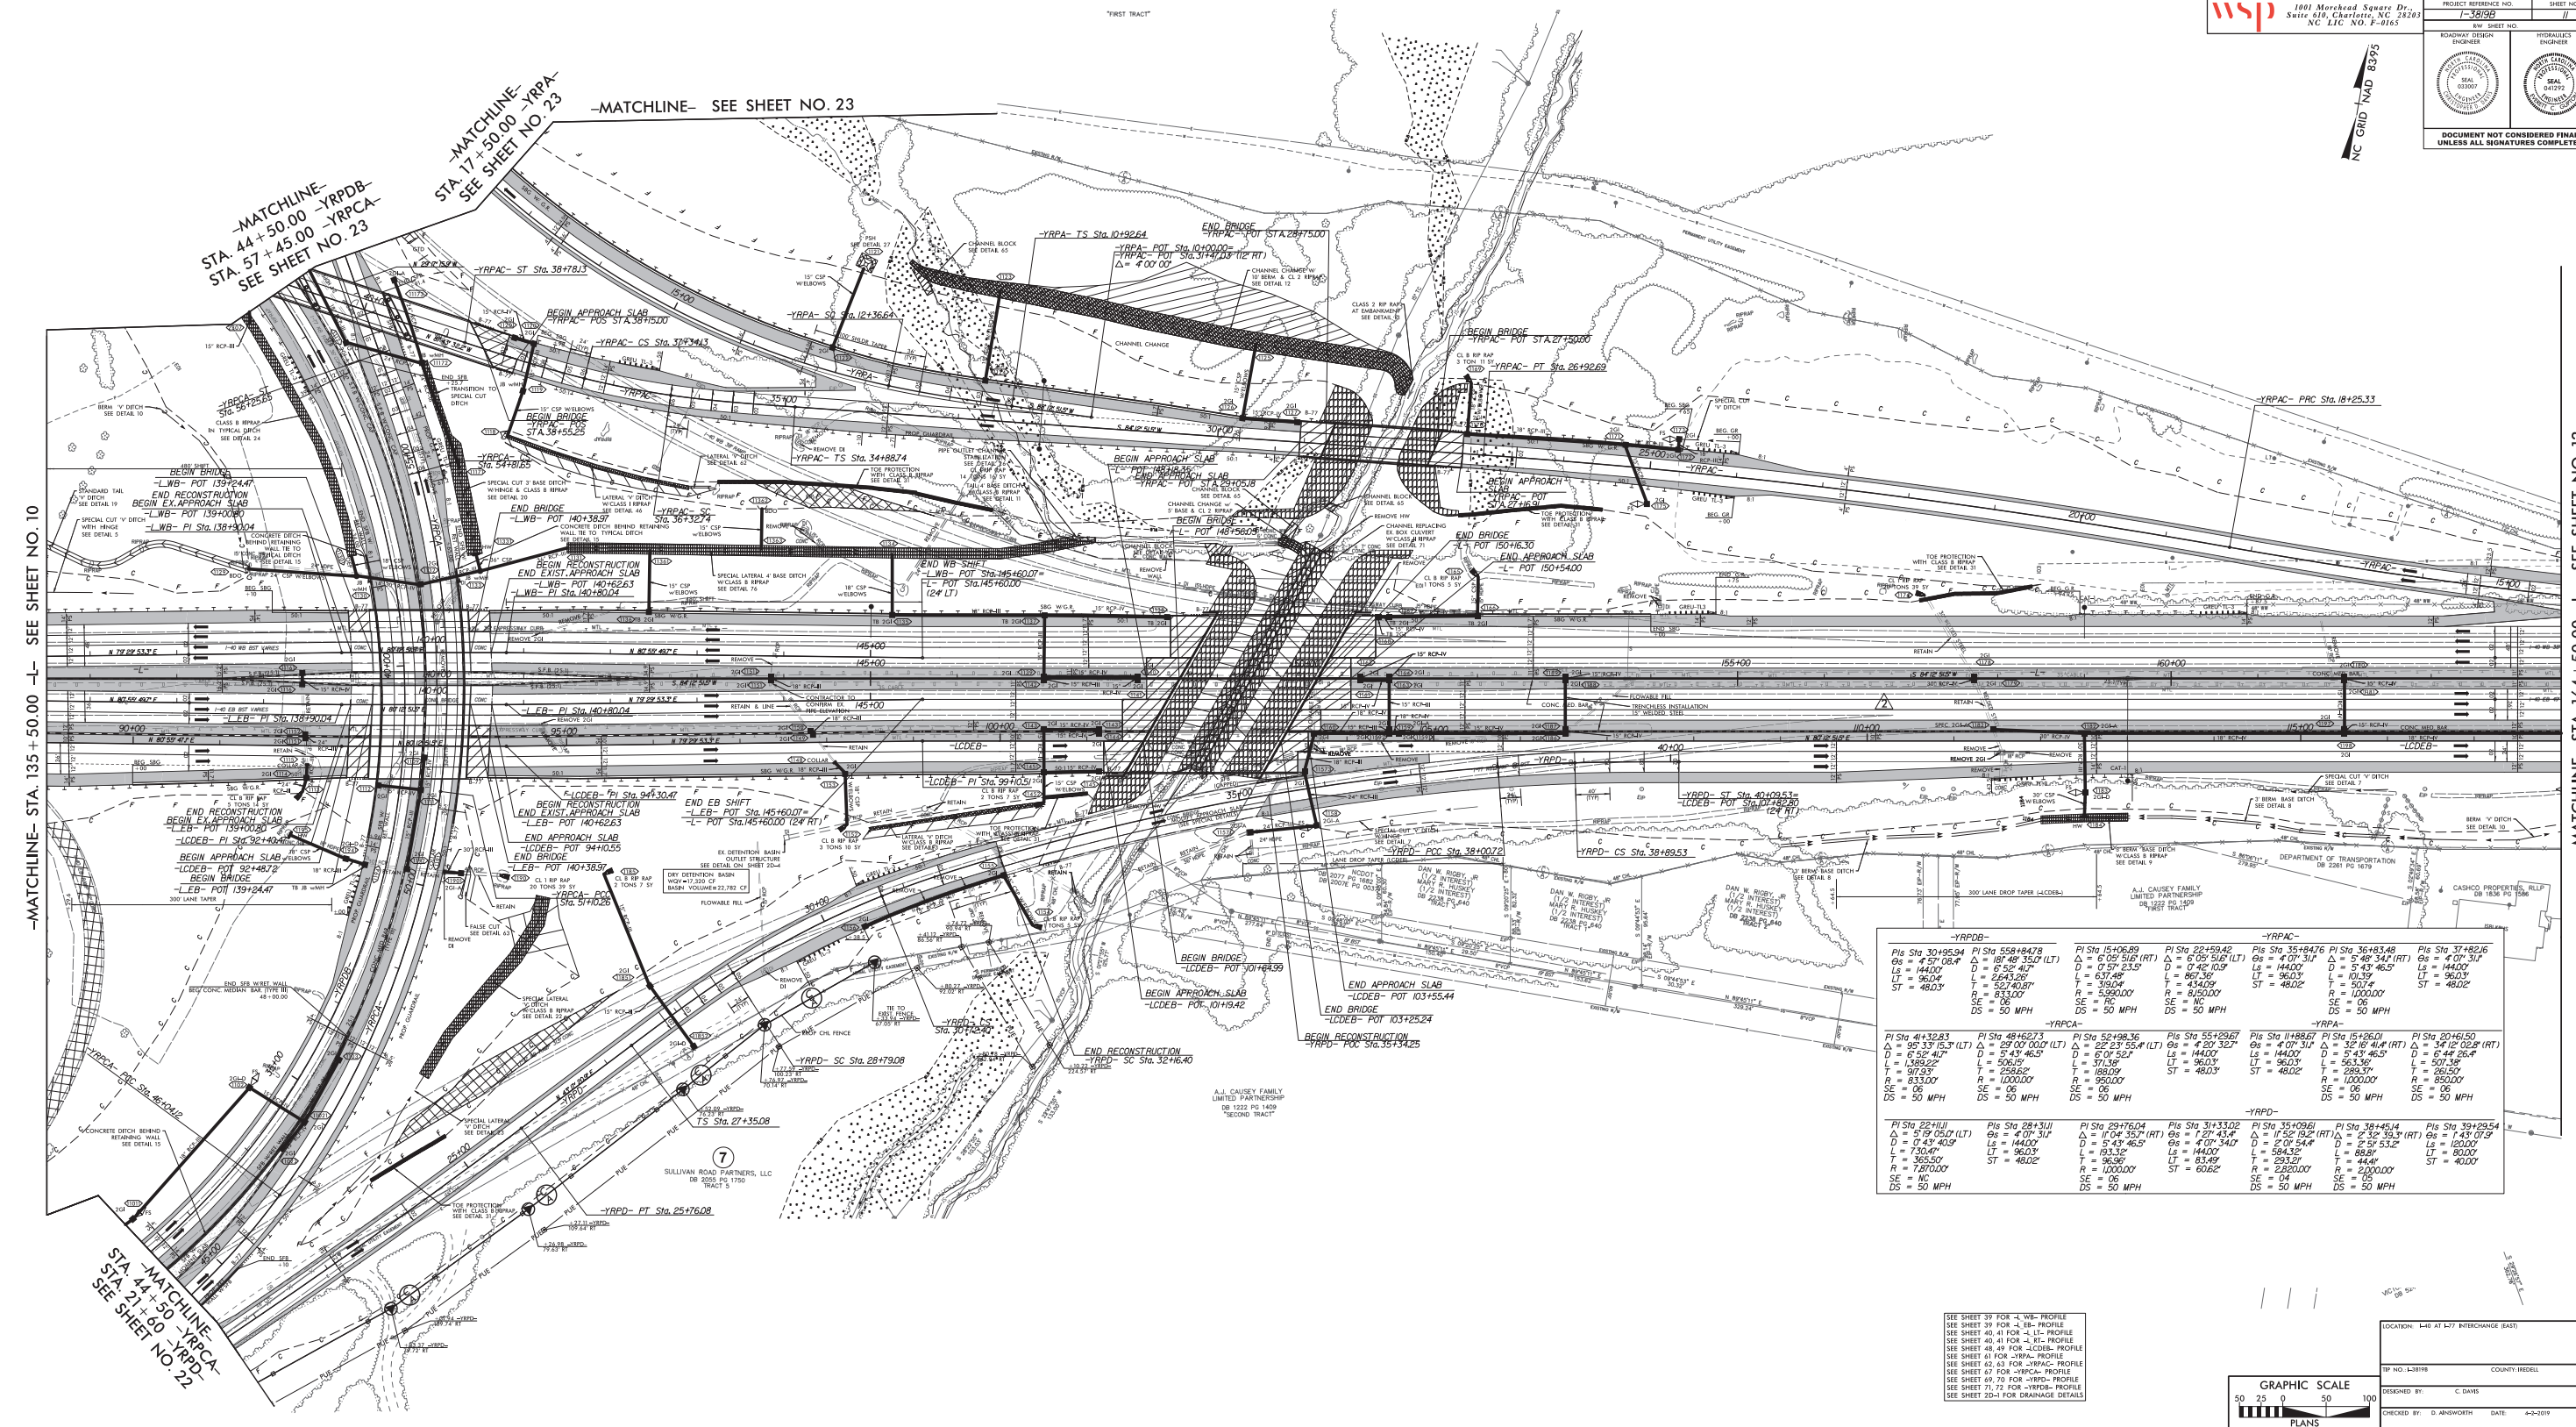
1001 Marshfield Square Dr.  
Suite 610, Charlotte, NC 28203  
NC LIC. NO. F-8165

PROJECT REFERENCE NO. 1-3819B  
SHEET NO. 11

ROADWAY DESIGN  
ENGINEER

HYDRAULICS  
ENGINEER

DOCUMENT NOT CONSIDERED FINAL  
UNLESS ALL SIGNATURES COMPLETED

NC GRID NAD 83/95

<p>-YRPDB-</p> <p>PI Sta 30+95.94 Δ = 4° 57' 08.4" Ls = 144.00' LT = 96.03' ST = 48.02'</p> <p>PI Sta 41+32.83 Δ = 9° 33' 15.3" Ls = 144.00' LT = 96.03' ST = 48.02'</p> <p>PI Sta 22+11.11 Δ = 5° 19' 05.0" Ls = 144.00' LT = 96.03' ST = 48.02'</p>	<p>-YRPCA-</p> <p>PI Sta 15+06.89 Δ = 6° 09' 50.8" Ls = 144.00' LT = 96.03' ST = 48.02'</p> <p>PI Sta 22+59.42 Δ = 6° 09' 50.8" Ls = 144.00' LT = 96.03' ST = 48.02'</p> <p>PI Sta 15+46.23 Δ = 2° 23' 55.4" Ls = 144.00' LT = 96.03' ST = 48.02'</p>	<p>-YRPAC-</p> <p>PI Sta 35+94.76 Δ = 4° 07' 31.1" Ls = 144.00' LT = 96.03' ST = 48.02'</p> <p>PI Sta 36+83.48 Δ = 5° 43' 46.5" Ls = 144.00' LT = 96.03' ST = 48.02'</p> <p>PI Sta 37+82.65 Δ = 4° 07' 31.1" Ls = 144.00' LT = 96.03' ST = 48.02'</p>	<p>-YRPD-</p> <p>PI Sta 29+76.04 Δ = 1° 04' 35.7" Ls = 144.00' LT = 96.03' ST = 48.02'</p> <p>PI Sta 31+33.02 Δ = 1° 04' 35.7" Ls = 144.00' LT = 96.03' ST = 48.02'</p> <p>PI Sta 33+09.61 Δ = 1° 04' 35.7" Ls = 144.00' LT = 96.03' ST = 48.02'</p>
---	---	---	--

GRAPHIC SCALE

50 25 0 50 100

PLANS

LOCATION: I-40 at I-77 INTERCHANGE (EAST)

TIP NO. 1-3819B COUNTY: REDELL

DRAWN BY: C. DAVIS

CHECKED BY: D. ARNSWORTH DATE: 4-2-2019

Rev. 11/2/20



DOCUMENT NOT CONSIDERED FINAL  
UNLESS ALL SIGNATURES COMPLETED

-MATCHLINE- STA. 206 + 50.00 -L- SEE SHEET NO. 14

-MATCHLINE- STA. 220 + 50.00 -L- SEE SHEET NO. 15A

-Y15RPB-			-SR-Y15-		
Pls Sta 11+23.95	PI Sta 13+73.31	Pls Sta 16+12.37	PI Sta 25+32.96		
$\Delta = 0^{\circ} 29' 34.4"$	$\Delta = 10^{\circ} 22' 10.8" (LT)$	$\Delta = 2^{\circ} 59' 59.2"$	$\Delta = 36^{\circ} 39' 10.6" (LT)$		
$\Theta_s = 2^{\circ} 59' 59.9"$	$D = 2^{\circ} 59' 59.2"$	$L_s = 200.00'$	$D = 9^{\circ} 32' 57.5"$		
$L_s = 200.00'$	$L = 345.68'$	$LT = 133.35'$	$L = 383.83'$		
$LT = 123.95'$	$T = 173.31'$	$ST = 66.68'$	$T = 198.74'$		
$ST = 76.10'$	$R = 1,910.00'$		$R = 600.00'$		
	$SE = 06$		$SE = EXIST.$		
	$DS = 50 \text{ MPH}$		$DS = EXIST.$		
-Y15RPC-			-L-		
Pls Sta 12+01.61	PI Sta 14+95.94	Pls Sta 17+88.82	PI Sta 214+81.51	Pls Sta 225+30.99	
$\Delta = 2^{\circ} 29' 28.0"$	$\Delta = 11^{\circ} 18' 24.2" (RT)$	$\Delta = 9^{\circ} 39' 55.0" (LT)$	$\Delta = 9^{\circ} 39' 55.0" (LT)$	$\Theta_s = 0^{\circ} 29' 26.0"$	
$L_s = 200.00'$	$D = 2^{\circ} 29' 28.0"$	$L_s = 200.00'$	$D = 0^{\circ} 29' 26.0"$	$L_s = 200.00'$	
$LT = 133.35'$	$L = 453.88'$	$LT = 133.35'$	$L = 1,970.31'$	$LT = 133.33'$	
$ST = 66.68'$	$T = 227.68'$	$ST = 66.68'$	$T = 987.50'$	$ST = 66.67'$	
	$R = 2,300.00'$		$R = 11,680.00'$		
	$SE = 05$		$SE = 02$		
	$DS = 50 \text{ MPH}$		$DS = 60 \text{ MPH}$		

SEE SHEET 44, 45 FOR -L-(LT) PROFILE  
SEE SHEET 44, 45 FOR -L-(RT) PROFILE  
SEE SHEET 87 FOR -Y15RPB- PROFILE  
SEE SHEET 88 FOR -Y15RPC- PROFILE

Rev. 11/2/20





Rev. 11/2/20

1/2/2020  
\\wsp004\cs\_pdf\_work\_dir\85618\282440\_1506788\13819\_rdy\_psh17\_Y3500-4900.dgn  
\\wsp004\cs\_pdf\_work\_dir\85618\282440\_1506788\13819\_rdy\_psh17\_Y3500-4900.dgn










**DOCUMENT NOT CONSIDERED FINAL  
UNLESS ALL SIGNATURES COMPLETED**

-MATCHLINE- STA 92 + 00.00 -Y S- SEE SHEET NO. 19

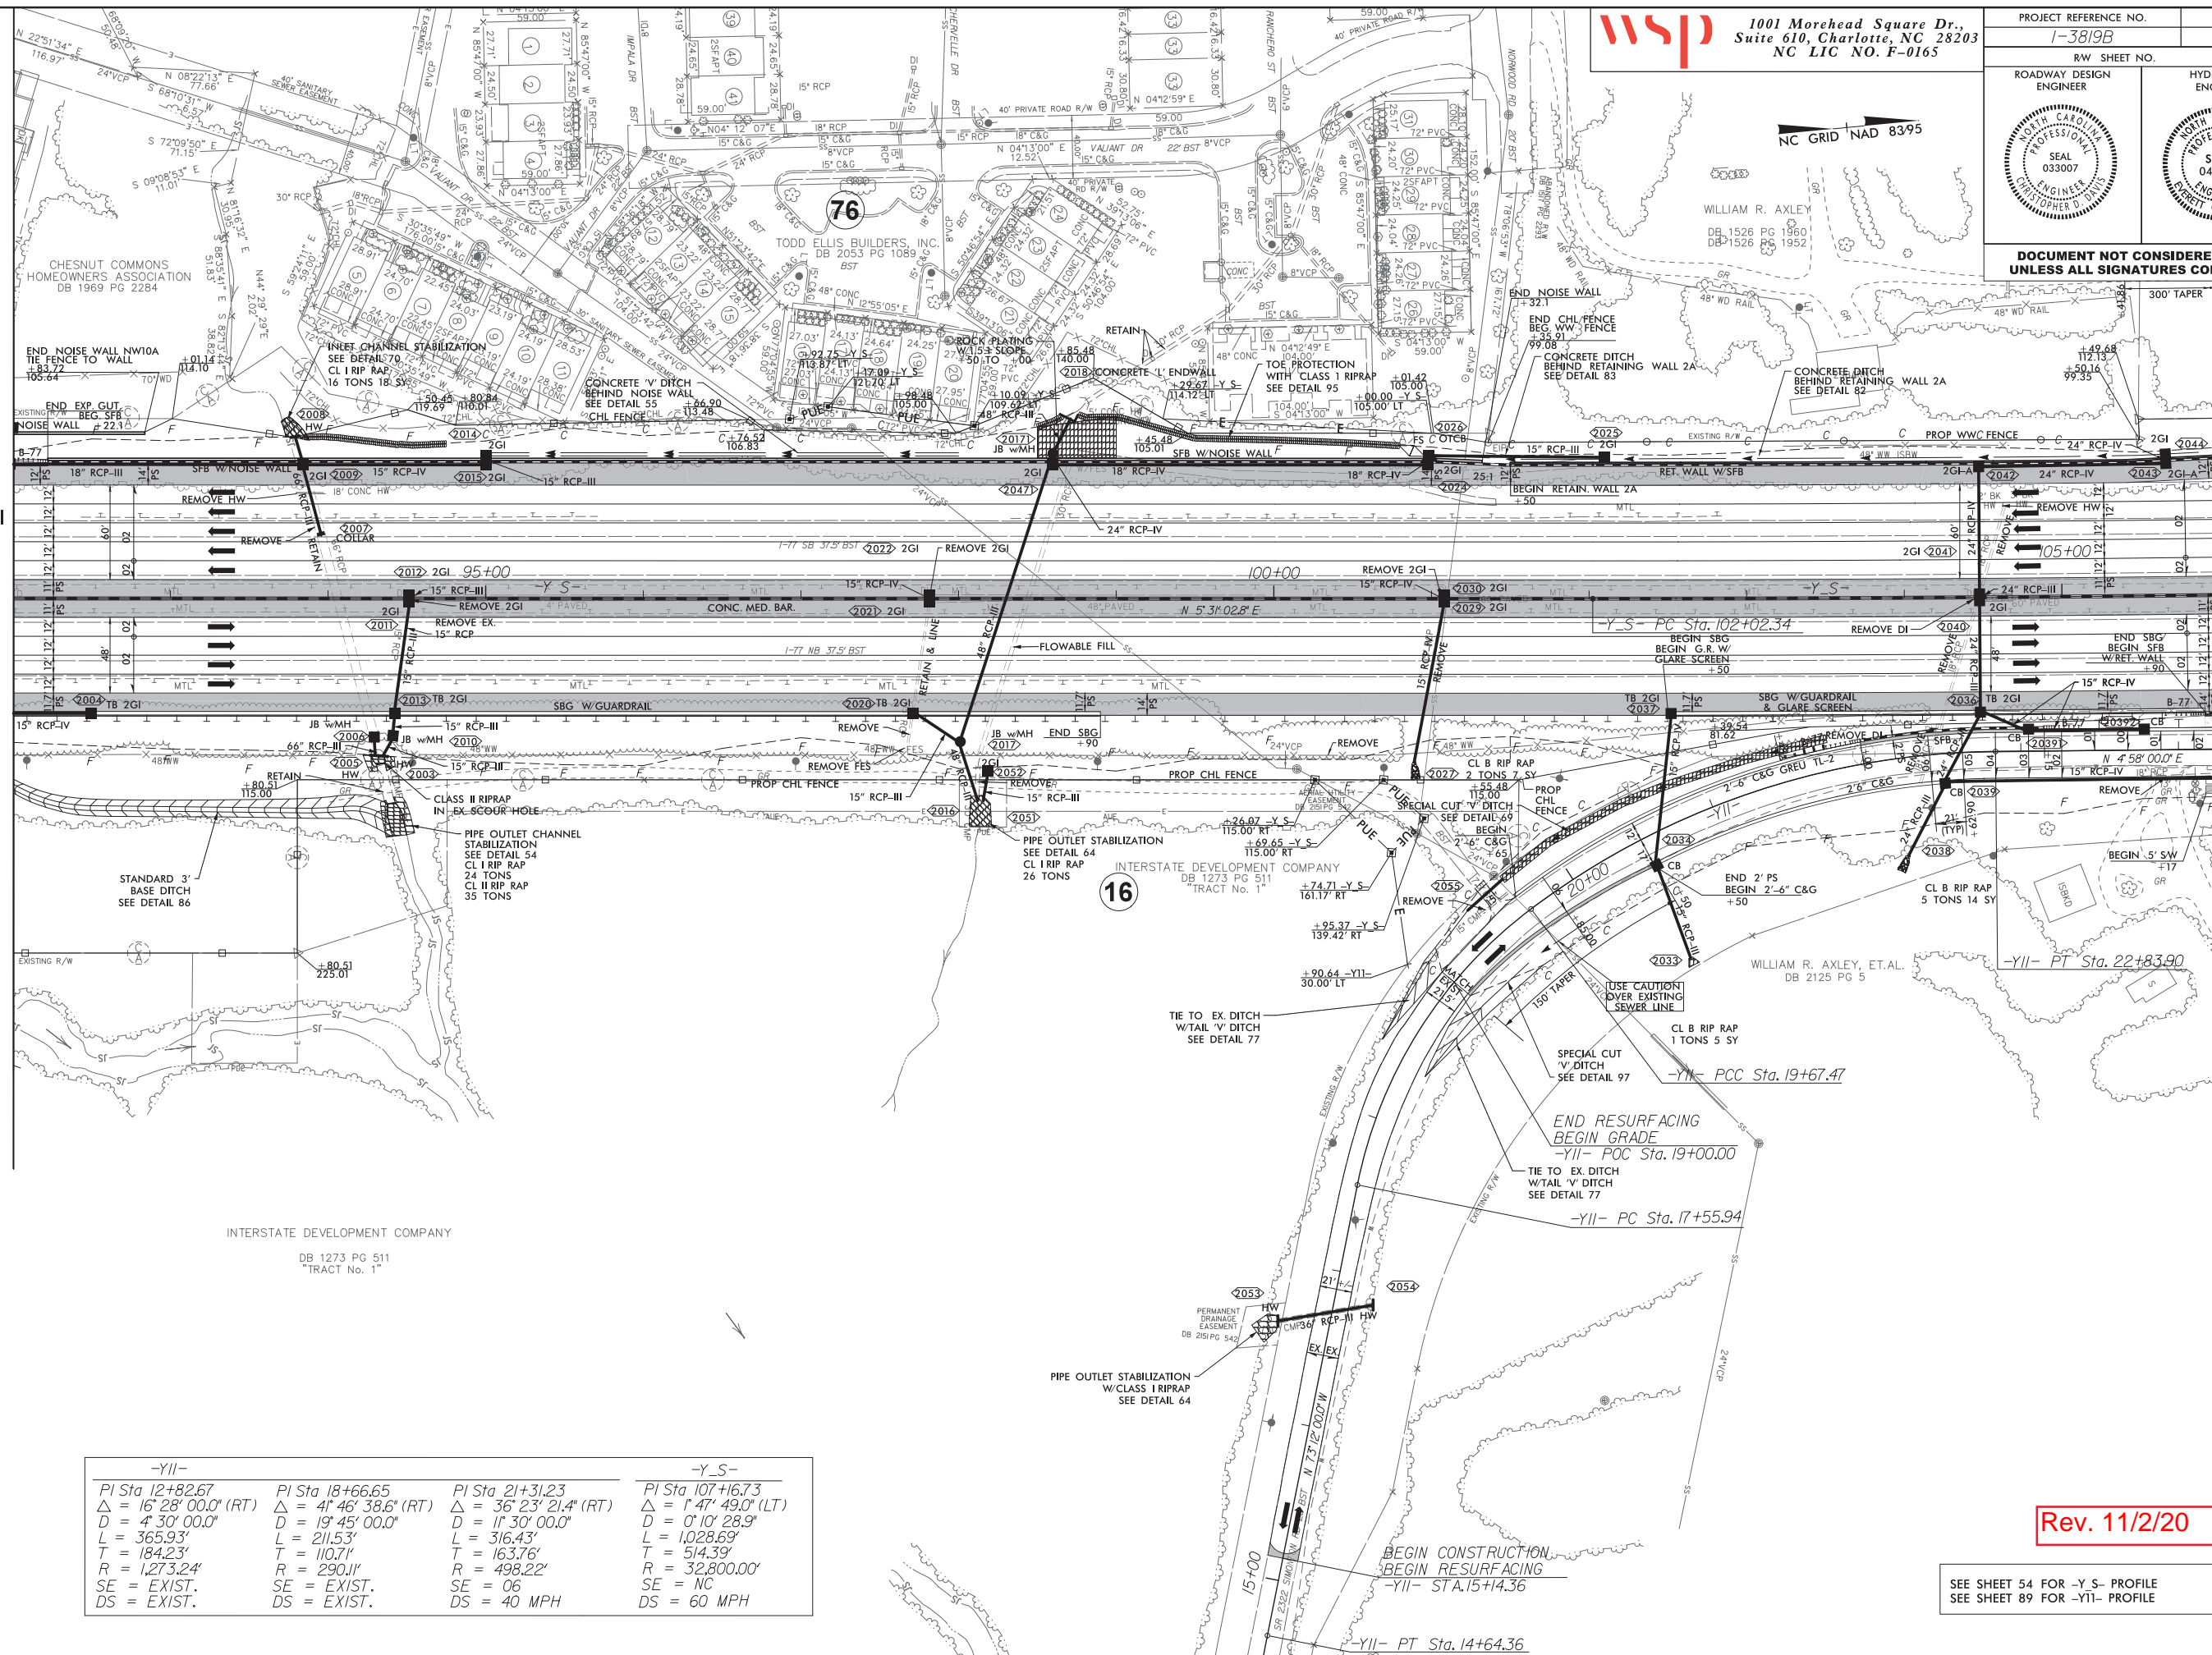

Rev. 11/2/20

SEE SHEET 54 FOR -Y<sub>S</sub>- PROFILE  
SEE SHEET 89 FOR -Y<sub>11</sub>- PROFILE

MATCHLINE- STA. 106+00 -Y S- SEE SHEET NO. 21

1/2/2020  
\\wspw04cs01\CS\_pdf\_work\_dir\85618\282440\_150678A\13819\_rdy\_psh20\_y9200\_10600.dgn  
wspw04cs01\$





6/2/20


1. REVISED DRAINAGE OUTFALL IN QUADRANT C 6/4/2020  
2. CHANGE STRUCTURE 2205 TO 201 FROM 18 W/MT 10/24/2020

6/2/2020  
\\nas001\hudson\GIS\staff\wpf\wpf\640\28446\_504780\3089\_75\_20122\_70000-15000.dgn

1001 Marshhead Square Dr.  
Suite 610, Charlotte, NC 28203  
NC LIC NO. F-8165


PROJECT REFERENCE NO.	SHEET NO.
1-3819B	22
ROADWAY DESIGN ENGINEER	HYDRAULICS ENGINEER
	
DOCUMENT NOT CONSIDERED FINAL UNLESS ALL SIGNATURES COMPLETED	

NC GRID NAD 83 995

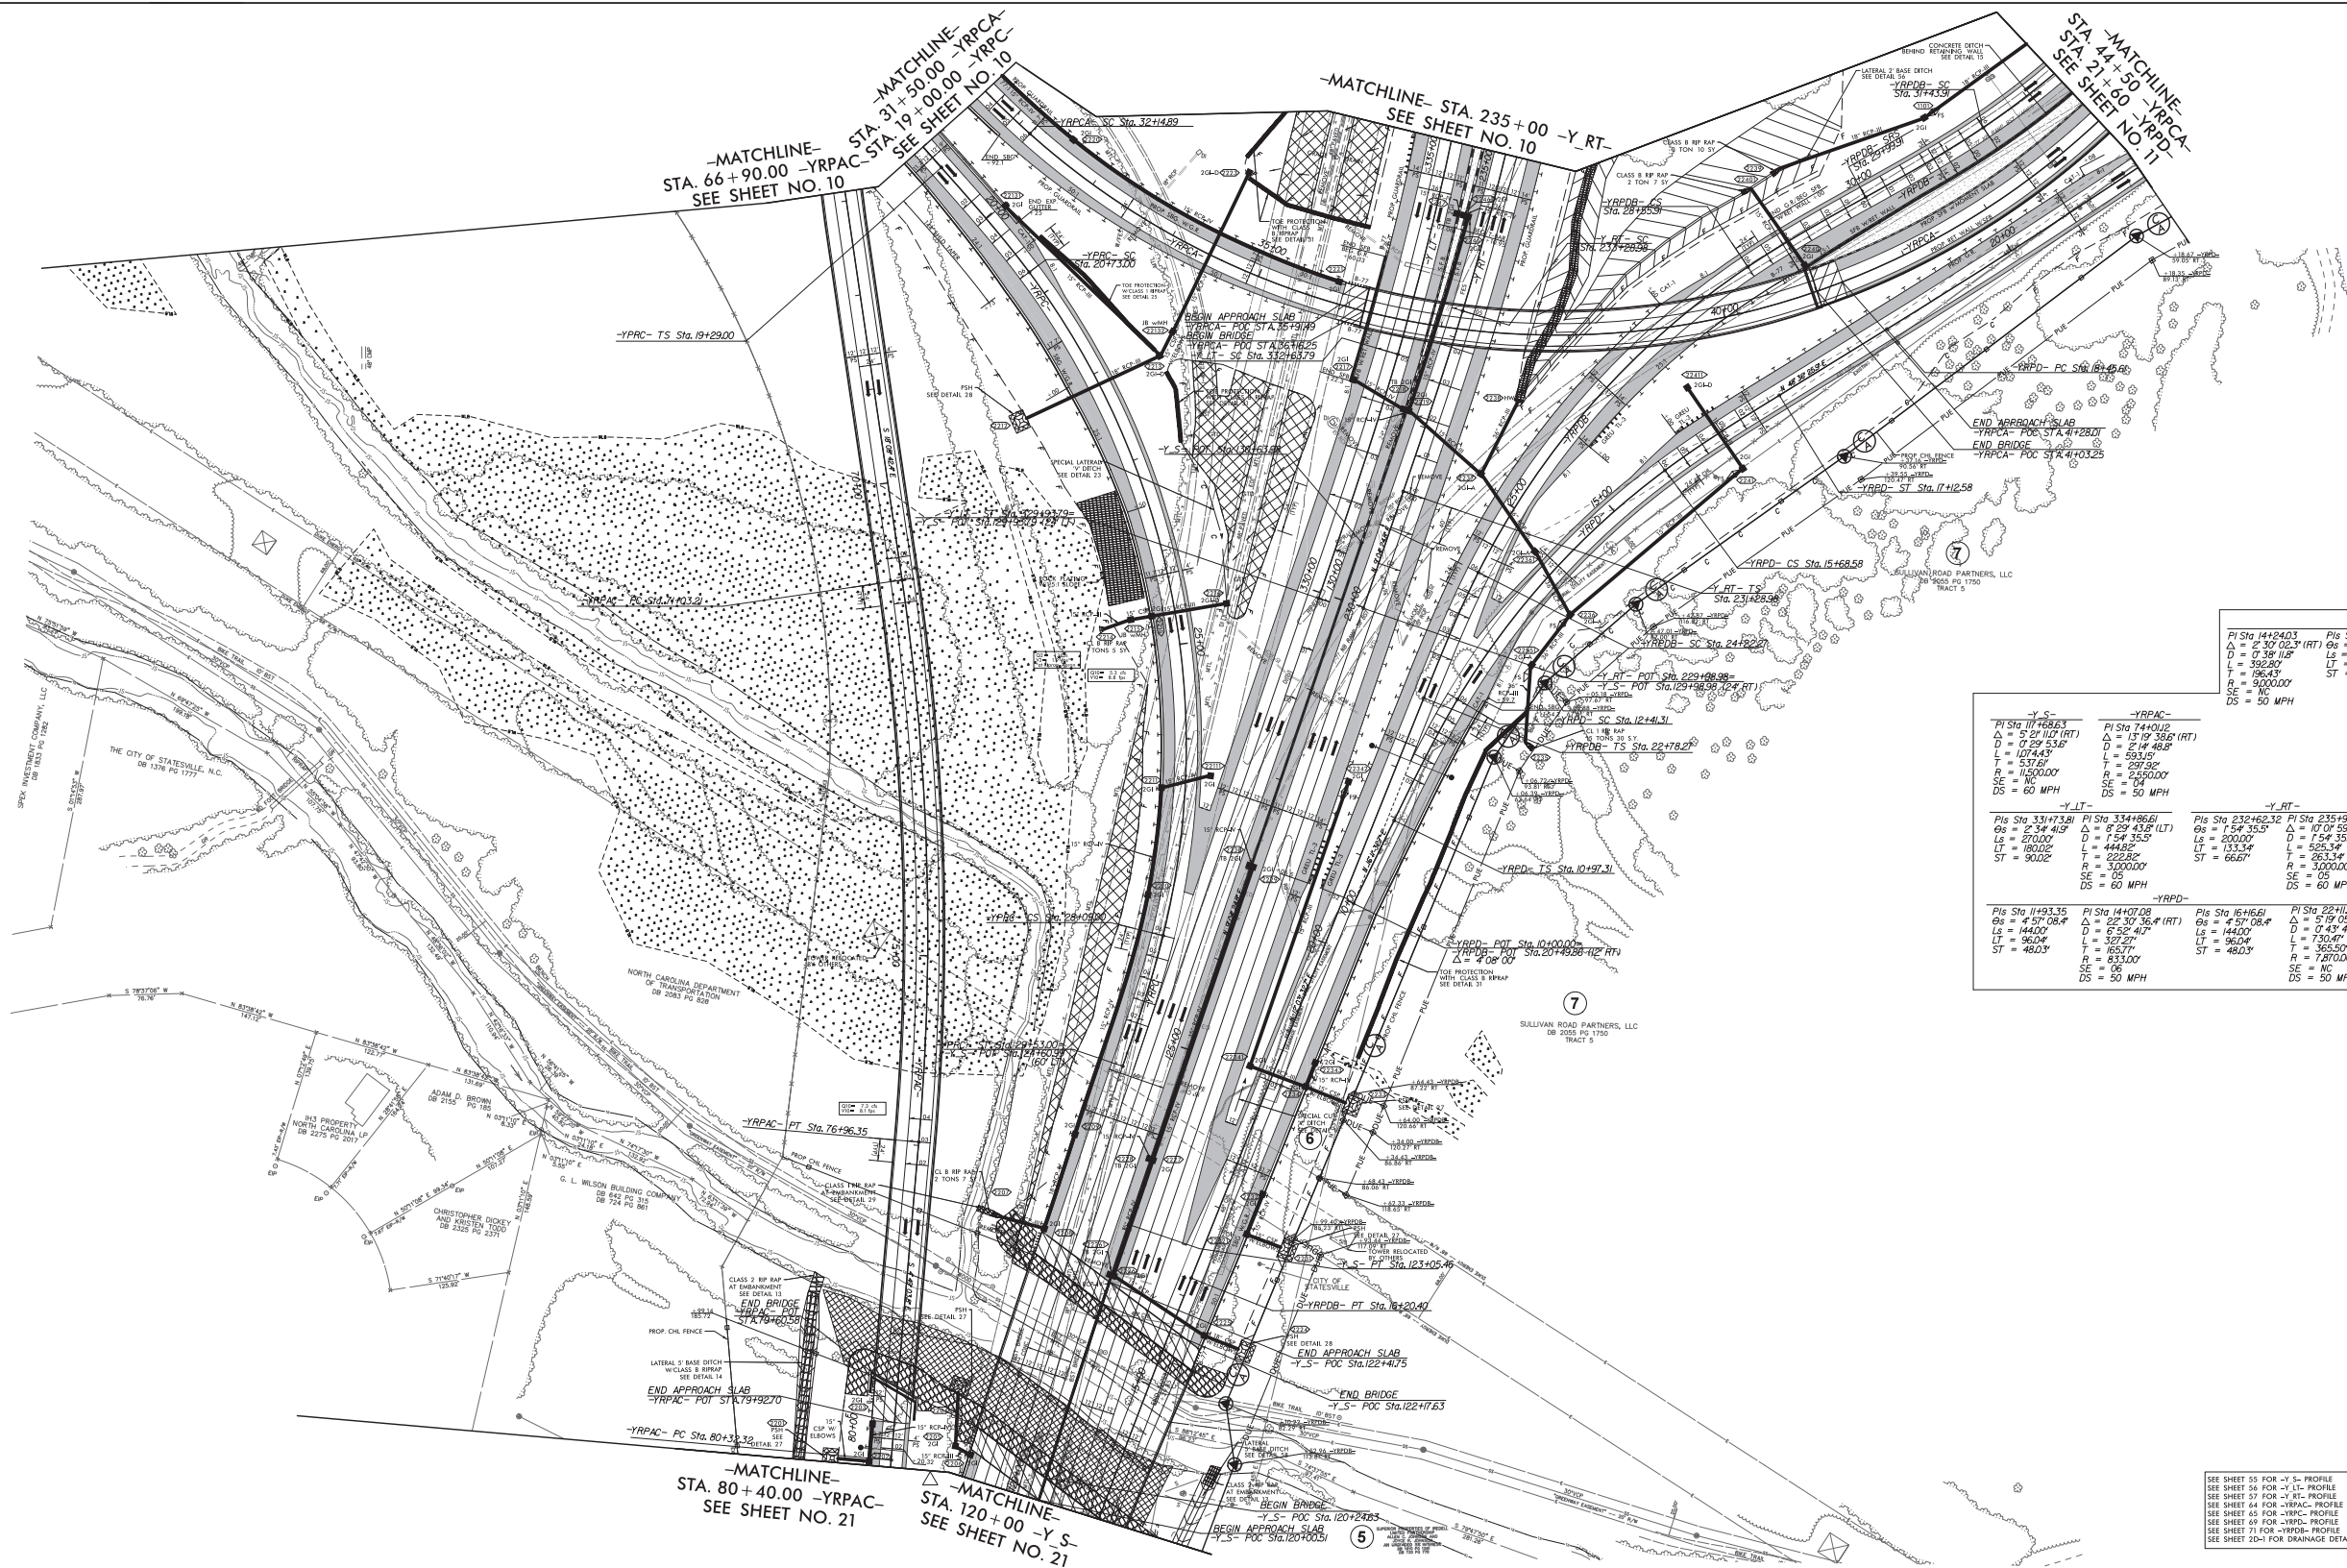

-YRPC-			
PI Sta 14+24.03 $\Delta = 2^\circ 30' 02.3''$ (RT) $D = 0^\circ 38' 10.8''$ $L = 107.443'$ $T = 537.61'$ $R = 11500.00'$ $SE = NC$ $DS = 60$ MPH	PI Sta 23+74.30 $\Delta = 4^\circ 52' 55.2''$ (RT) $D = 0^\circ 38' 10.8''$ $L = 107.443'$ $T = 537.61'$ $R = 11500.00'$ $SE = NC$ $DS = 60$ MPH	PI Sta 26+43.39 $\Delta = 2^\circ 24' 10.7''$ (RT) $D = 0^\circ 38' 10.8''$ $L = 107.443'$ $T = 537.61'$ $R = 11500.00'$ $SE = NC$ $DS = 60$ MPH	PI Sta 29+03.94 $\Delta = 4^\circ 52' 55.2''$ (RT) $D = 0^\circ 38' 10.8''$ $L = 107.443'$ $T = 537.61'$ $R = 11500.00'$ $SE = NC$ $DS = 60$ MPH
-Y-RT-			
PI Sta 11+68.63 $\Delta = 5^\circ 31' 10.7''$ (RT) $D = 0^\circ 29' 53.6''$ $L = 107.443'$ $T = 537.61'$ $R = 11500.00'$ $SE = NC$ $DS = 60$ MPH	PI Sta 14+01.2 $\Delta = 1^\circ 19' 58.6''$ (RT) $D = 2^\circ 14' 48.8''$ $L = 593.15'$ $T = 287.32'$ $R = 25500.00'$ $SE = NC$ $DS = 50$ MPH	PI Sta 23+462.32 $\Delta = 10^\circ 07' 59.7''$ (LT) $D = 1^\circ 54' 35.5''$ $L = 2000.00'$ $T = 133.54'$ $ST = 66.67'$ $R = 3000.00'$ $SE = NC$ $DS = 60$ MPH	PI Sta 24+66.97 $\Delta = 50^\circ 37' 24.9''$ (RT) $D = 1^\circ 54' 35.5''$ $L = 1440.00'$ $T = 7.52' 40.7''$ $ST = 393.97'$ $R = 833.00'$ $SE = NC$ $DS = 50$ MPH
-YRPC-			
PI Sta 11+93.35 $\Delta = 2^\circ 34' 4.9''$ $D = 0^\circ 38' 10.8''$ $L = 107.443'$ $T = 537.61'$ $R = 11500.00'$ $SE = NC$ $DS = 60$ MPH	PI Sta 14+07.08 $\Delta = 2^\circ 30' 36.4''$ (RT) $D = 0^\circ 38' 10.8''$ $L = 107.443'$ $T = 537.61'$ $R = 11500.00'$ $SE = NC$ $DS = 60$ MPH	PI Sta 16+6.61 $\Delta = 4^\circ 57' 08.4''$ $D = 0^\circ 38' 10.8''$ $L = 107.443'$ $T = 537.61'$ $R = 11500.00'$ $SE = NC$ $DS = 60$ MPH	PI Sta 21+11.1 $\Delta = 5^\circ 19' 05.0''$ (LT) $D = 0^\circ 38' 10.8''$ $L = 107.443'$ $T = 537.61'$ $R = 11500.00'$ $SE = NC$ $DS = 60$ MPH
-YRPC-			
PI Sta 31+66.93 $\Delta = 4^\circ 57' 08.4''$ $D = 0^\circ 38' 10.8''$ $L = 107.443'$ $T = 537.61'$ $R = 11500.00'$ $SE = NC$ $DS = 60$ MPH	PI Sta 41+32.83 $\Delta = 95^\circ 33' 15.3''$ (LT) $D = 0^\circ 38' 10.8''$ $L = 1440.00'$ $T = 7.52' 40.7''$ $ST = 393.97'$ $R = 833.00'$ $SE = NC$ $DS = 50$ MPH		

SEE SHEET 55 FOR -Y-S- PROFILE  
SEE SHEET 56 FOR -Y-RT- PROFILE  
SEE SHEET 57 FOR -Y-RT- PROFILE  
SEE SHEET 64 FOR -YRPC- PROFILE  
SEE SHEET 65 FOR -YRPC- PROFILE  
SEE SHEET 66 FOR -YRPC- PROFILE  
SEE SHEET 71 FOR -YRPC- PROFILE  
SEE SHEET 72 FOR -YRPC- PROFILE

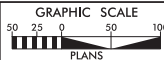


LOCATION: I-77 AT I-40 INTERCHANGE (SOUTH)	
TIP NO. 1-3819B	COUNTY: REDELL
DESIGNED BY: C. DAVIS	
CHECKED BY: D. ARNSWORTHY	DATE: 6-2-2019

Rev. 11/2/20




I:\2020\wsp\041gs01\CS\_pdf\_work\_dir\85618\282440\_1506794\13819\_rdy\_psh27\_Y20300-21700.dgn  
MSDOW41GS01\$

-MATCHLINE- STA. 203+00 -Y\_N- SEE SHEET NO. 26

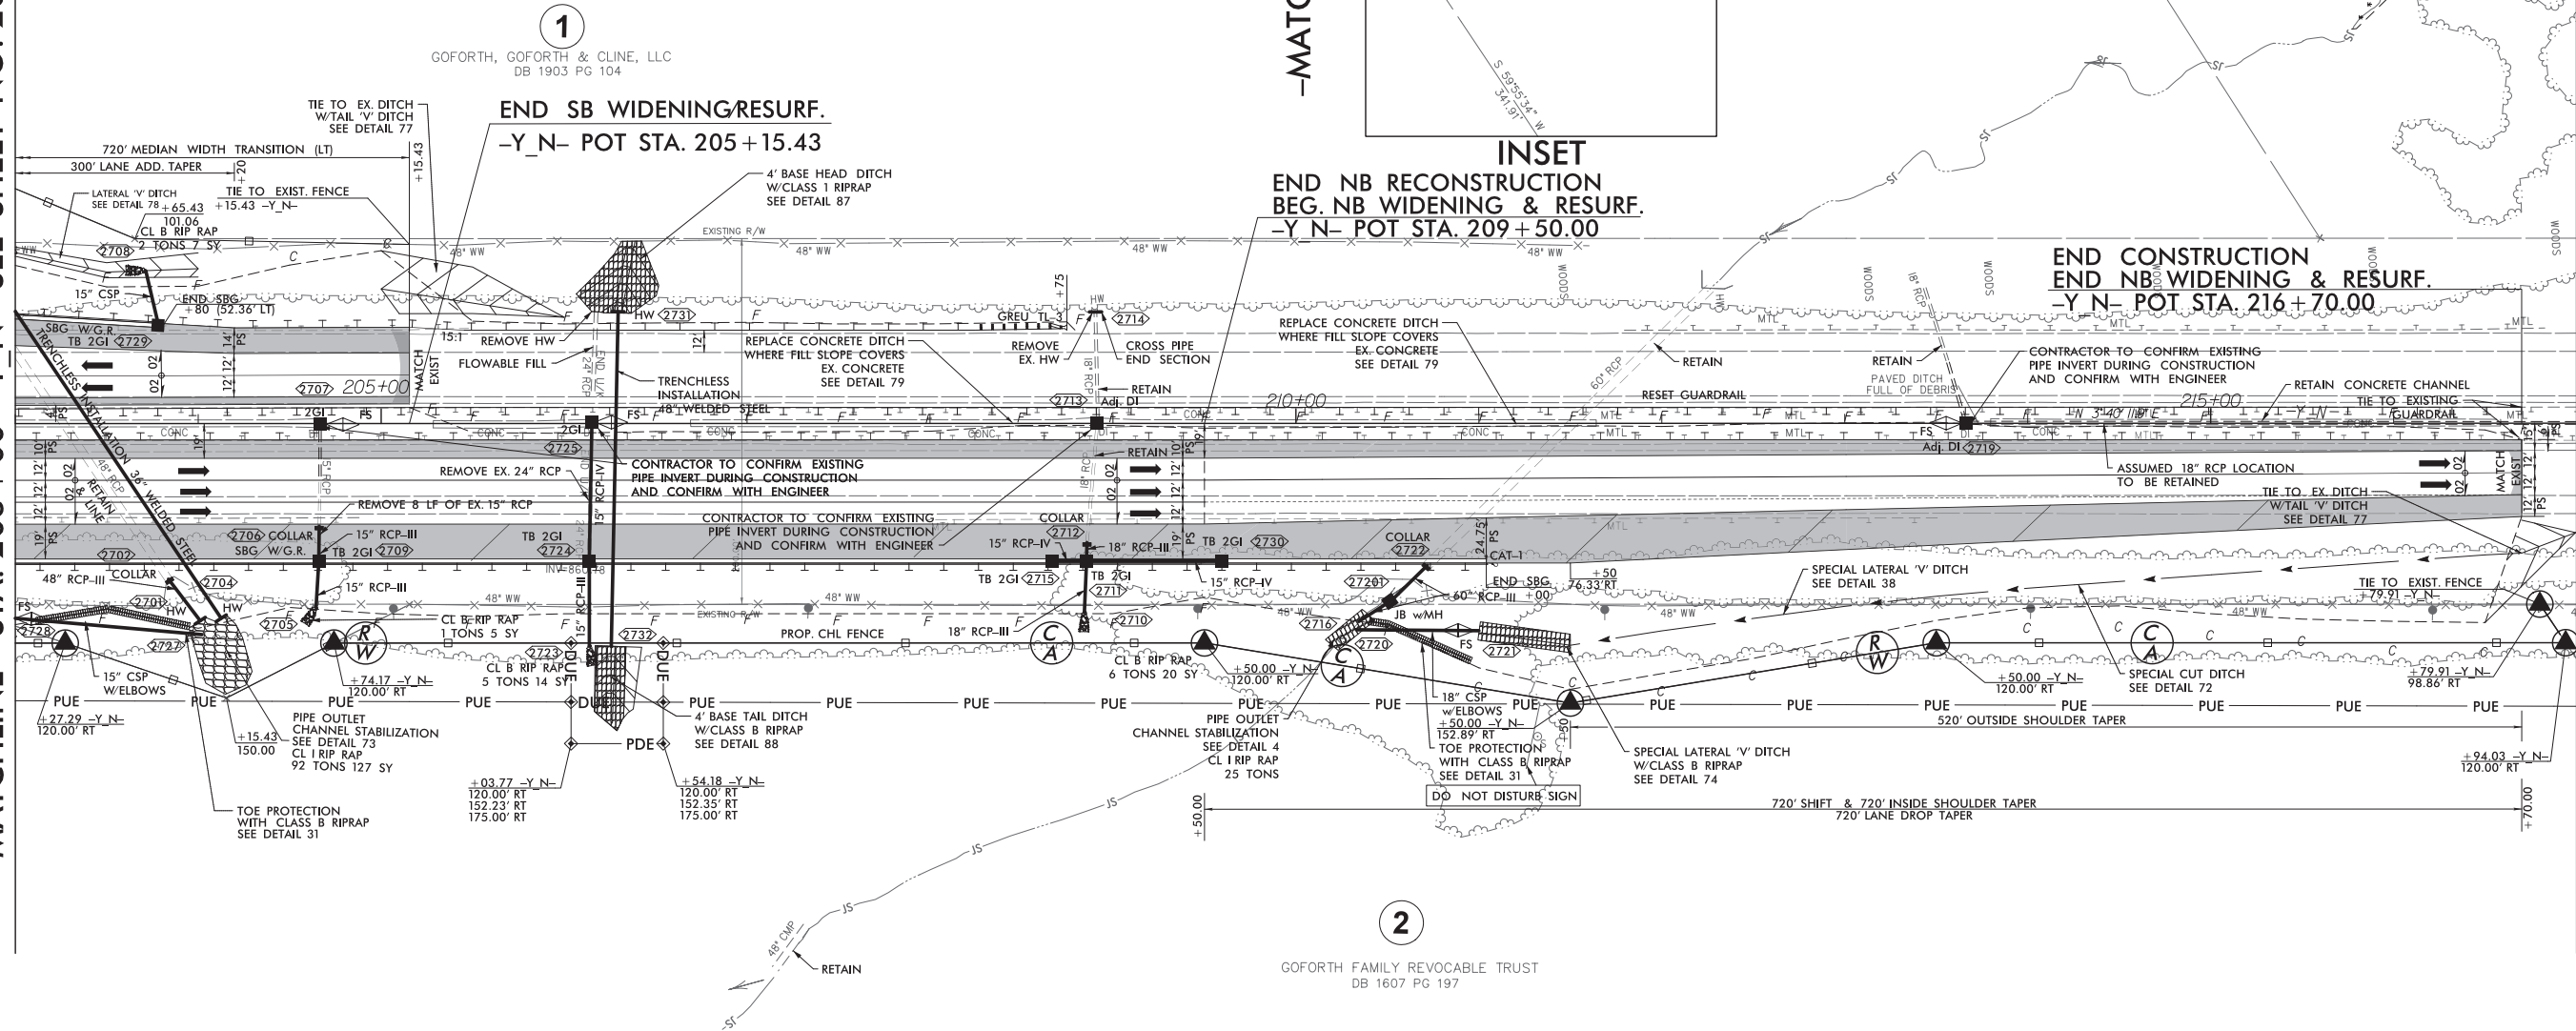

-MATCHLINE- STA. 217+00 -Y\_N- THIS SHEET

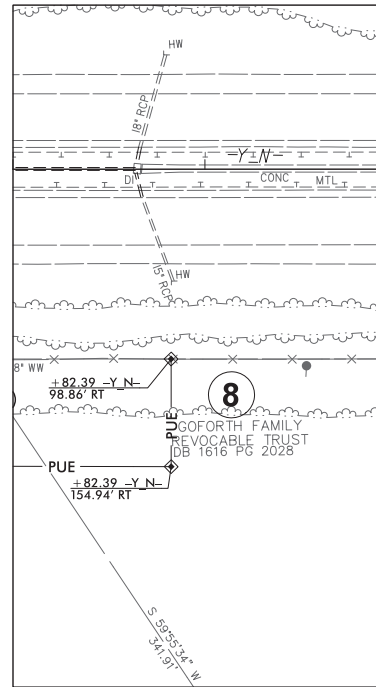

INSET  
END NB RECONSTRUCTION  
BEG. NB WIDENING & RESURF.  
-Y\_N- POT STA. 209+50.00

END CONSTRUCTION  
END NB WIDENING & RESURF.  
-Y\_N- POT STA. 216+70.00



-MATCHLINE- STA. 217+00 -Y\_N- SEE INSET THIS SHEET

SEE SHEET 59,60 FOR -Y\_N- PROFILE

Rev. 11/2/20



1001 Morehead Square Dr.,  
Suite 610, Charlotte, NC 28203  
NC LIC NO. F-0165

PROJECT REFERENCE NO.		SHEET NO.	
1-3819B		27	
R/W SHEET NO.			
ROADWAY DESIGN ENGINEER		HYDRAULICS ENGINEER	
			
<b>DOCUMENT NOT CONSIDERED FINAL UNLESS ALL SIGNATURES COMPLETED</b>			