DocuSign Envelope ID: 683A808E-0B0B-4CC7-833E-E2247A5302C8

F.A. PROJECT No. BRSTP-0024(33)

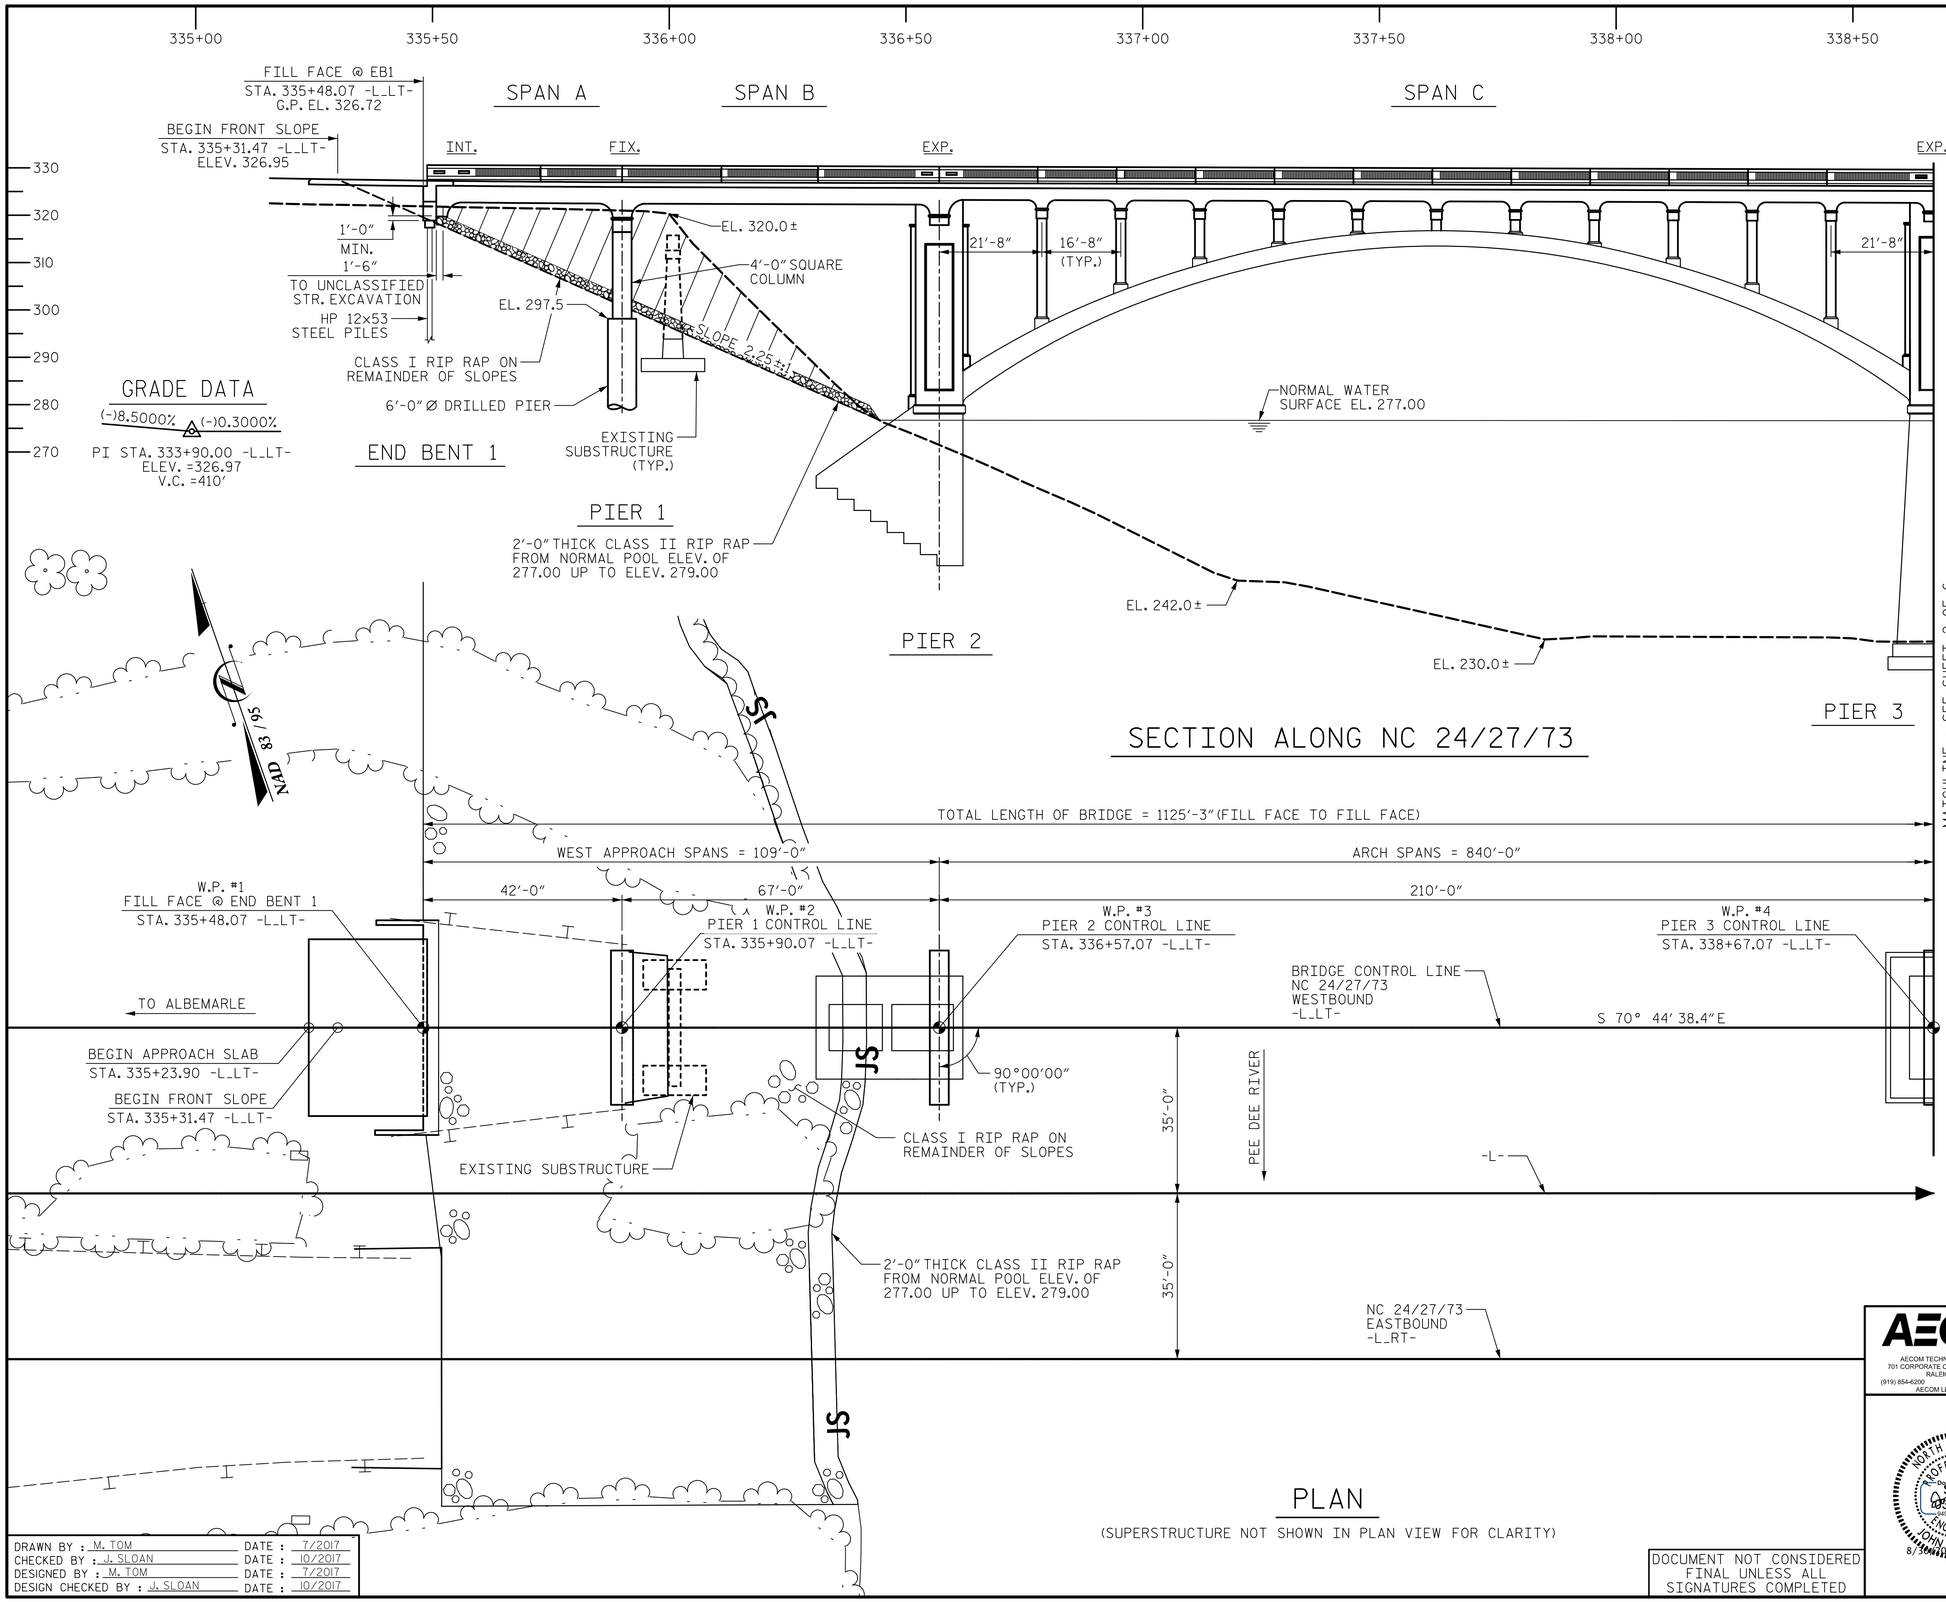

LEGEND

- UNCLASSIFIED STRUCTURE EXCAVATION
- PROPOSED
- EXISTING TO REMAIN
- EXISTING TO BE REMOVED

THE MATERIAL SHOWN IN THE CROSS-HATCHED AREA SHALL BE EXCAVATED FOR A DISTANCE OF 27FT. EACH SIDE OF CENTERLINE ROADWAY AS DIRECTED BY THE ENGINEER. SEE SECTION 412 OF THE STANDARD SPECIFICATIONS.

I HEREBY CERTIFY THESE PLANS ARE THE AS-BUILT PLANS

PLAN

(SUPERSTRUCTURE NOT SHOWN IN PLAN VIEW FOR CLARITY)

DRAWN BY : M. TOM DATE : 7/2017
CHECKED BY : J. SLOAN DATE : 10/2017
DESIGNED BY : M. TOM DATE : 7/2017
DESIGN CHECKED BY : J. SLOAN DATE : 10/2017

DOCUMENT NOT CONSIDERED FINAL UNLESS ALL SIGNATURES COMPLETED

AECOM
AECOM TECHNICAL SERVICES, INC.
701 CORPORATE CENTER DRIVE, SUITE 475
RALEIGH, NC 27607
(919) 854-6200 www.aecom.com
AECOM License No. F-0342

NORTH CAROLINA PROFESSIONAL SEAL 035062 ENGINEER JOHN E. SLOAN
DocuSign envelope ID: 683A808E-0B0B-4CC7-833E-E2247A5302C8
8/30/2018

STATE OF NORTH CAROLINA
DEPARTMENT OF TRANSPORTATION
RALEIGH

GENERAL DRAWING

BRIDGE ON NC 24/27/73
WESTBOUND OVER
PEE DEE RIVER

REVISIONS						SHEET NO.
NO.	BY:	DATE:	NO.	BY:	DATE:	S-1
1			3			TOTAL SHEETS
2			4			148

PROJECT NO. B-4974
STANLY/MONTGOMERY COUNTY
STATION: 339+86.39 -L-
WIDENING AND REHABILITATION OF BRIDGE NO. 830051
SHEET 1 OF 6

DATE: 8/29/2018
TIME: 1:35:06 PM

USER: matt.tom
DGN: \\USRAL3\p00\aecomnet.com\Data\Projects\60536253\900_Work\910_CADD\70_NCDOT_TIP\Structures\04_Drawings\40_003_B4974_SMU_GD1.dgn