KCI Associates of North Carolina, P.A.
SUITE 200, LANDMARK CENTER I, 4601 SIX FORKS RD.
RALEIGH, NC 27609-5210 (919) 783-9214
• ENGINEERS • PLANNERS • ECOLOGISTS

METRIC

PROJECT REFERENCE NO.	SHEET NO.
R-2562C	16
R/W SHEET NO.	
ROADWAY DESIGN ENGINEER	HYDRAULICS ENGINEER

CONST. REV.

R/W REV.

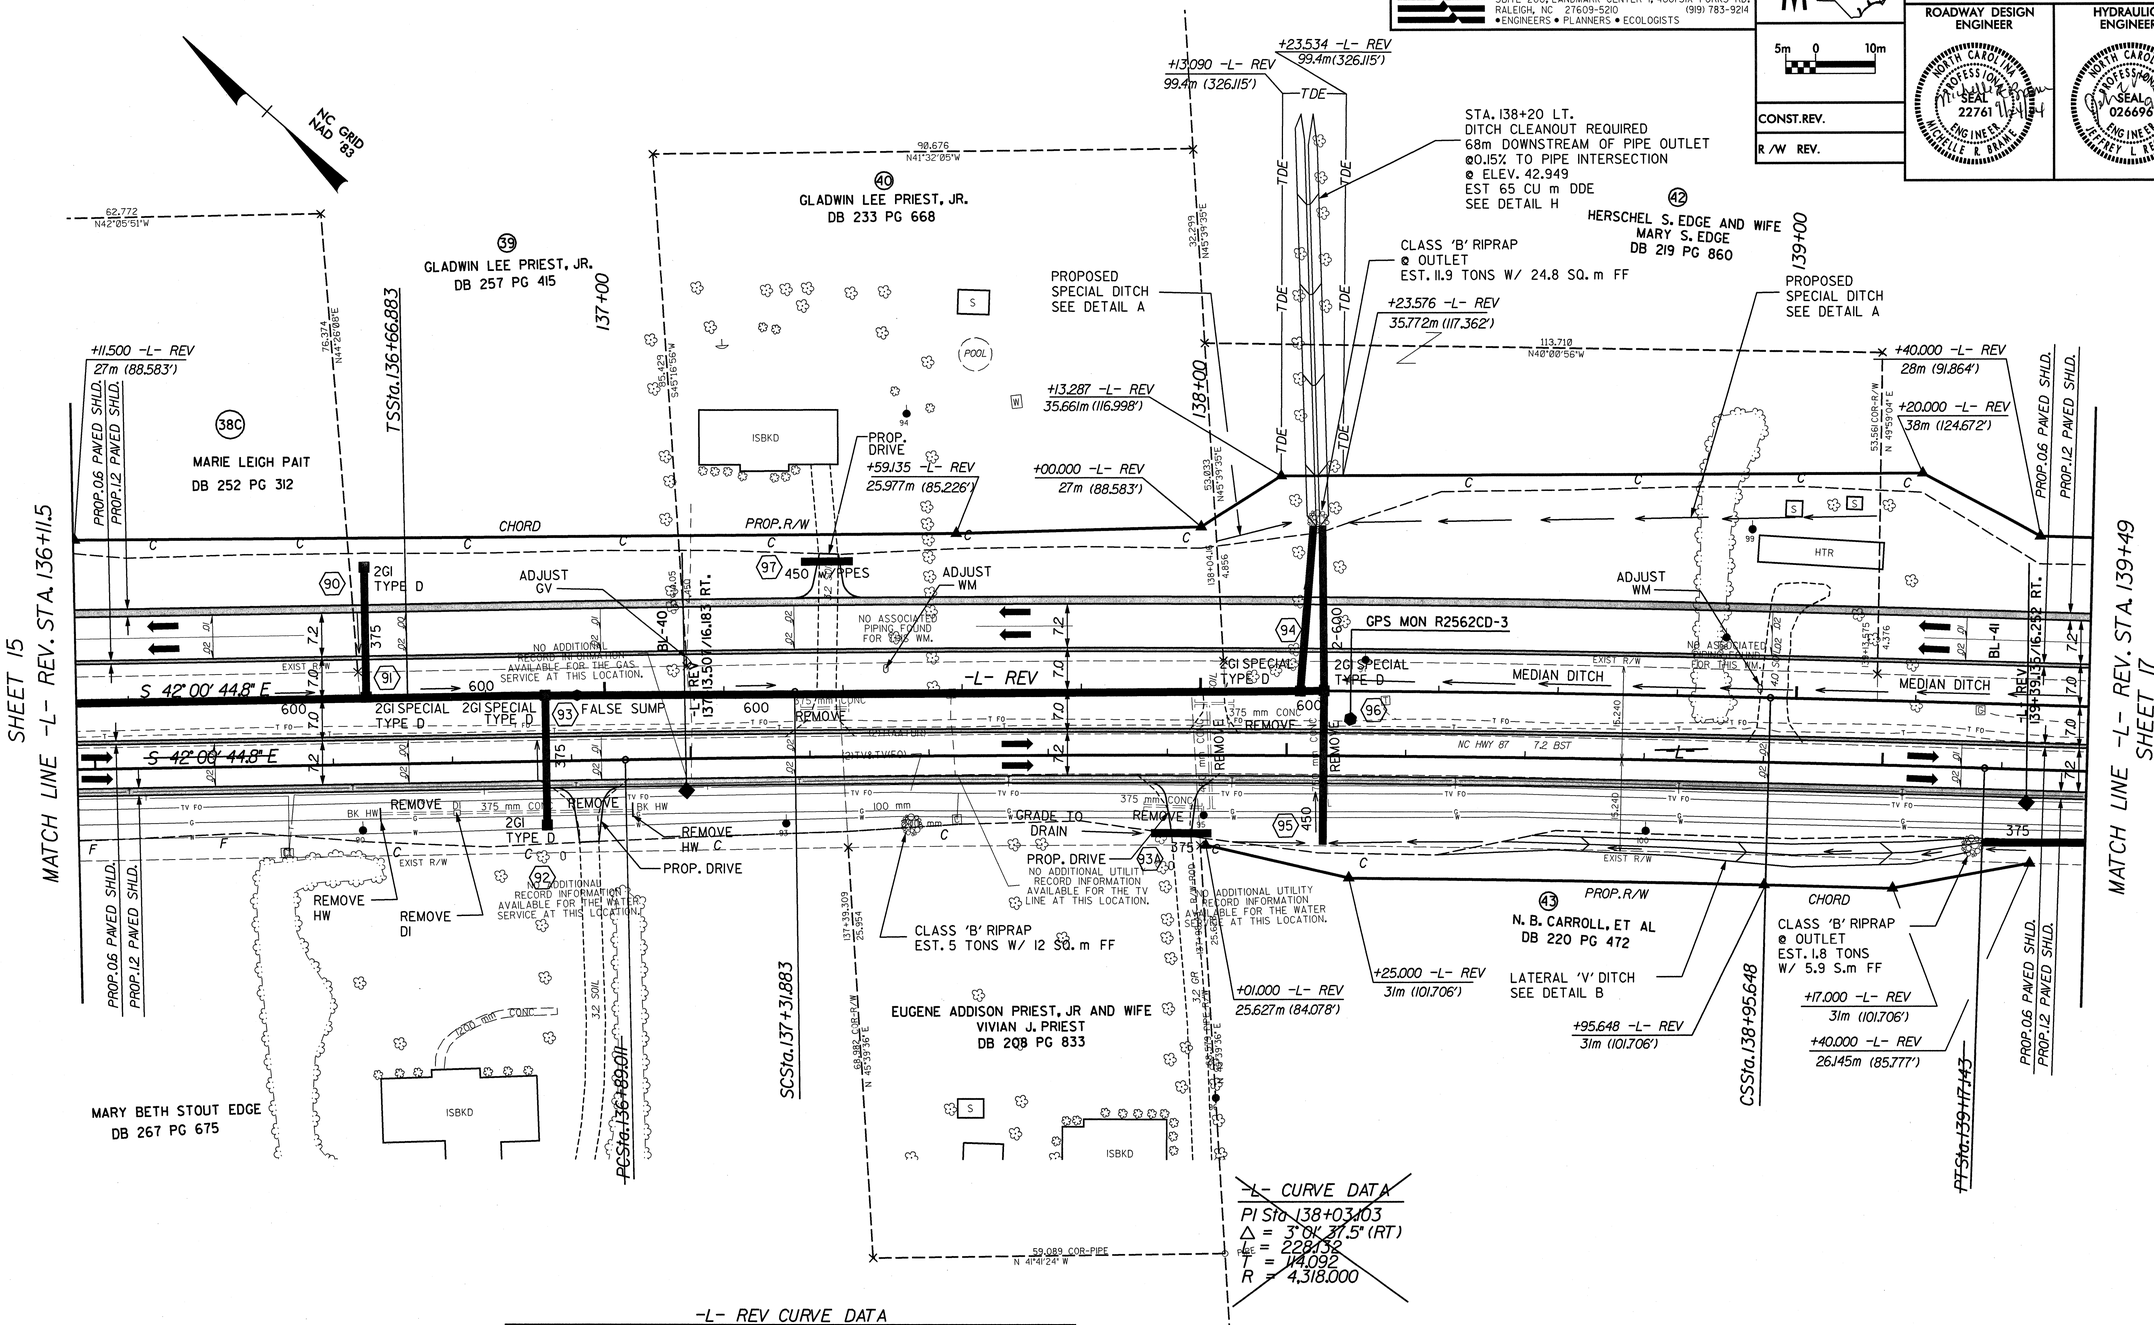

~~-L- CURVE DATA~~
~~PI Sta 138+03.103~~
~~Δ = 3° 01' 37.5" (RT)~~
~~L = 228.132~~
~~T = 114.092~~
~~R = 4,318.000~~

-L- REV CURVE DATA

PIs Sta 137+10.217	PI Sta 138+13.776	PIs Sta 139+17.315
Θs = 0° 25' 48.2"	Δ = 2° 10' 01.1" (RT)	Θs = 0° 25' 48.2"
Ls = 65.000	L = 163.765	Ls = 65.000
LT = 43.333	T = 81.892	LT = 43.333
ST = 21.667	R = 4,330.000	ST = 21.667
	SE = 0.02	

DRIVEWAY NOTES:
1. ALL PROP. DRIVEWAY RADII 3.0m UNLESS OTHERWISE SHOWN.
2. PROP. DRIVEWAY WIDTHS AT END OF RADII SHALL BE 4.9m MIN. UNLESS OTHERWISE SHOWN. TAPER DRIVEWAY TO EXISTING DRIVEWAY WIDTH.

SEE SHEET 38 FOR -L- REV. PROFILE