DocuSign Envelope ID: A0F31B21-C5F4-45F4-B784-C987A4757EC9

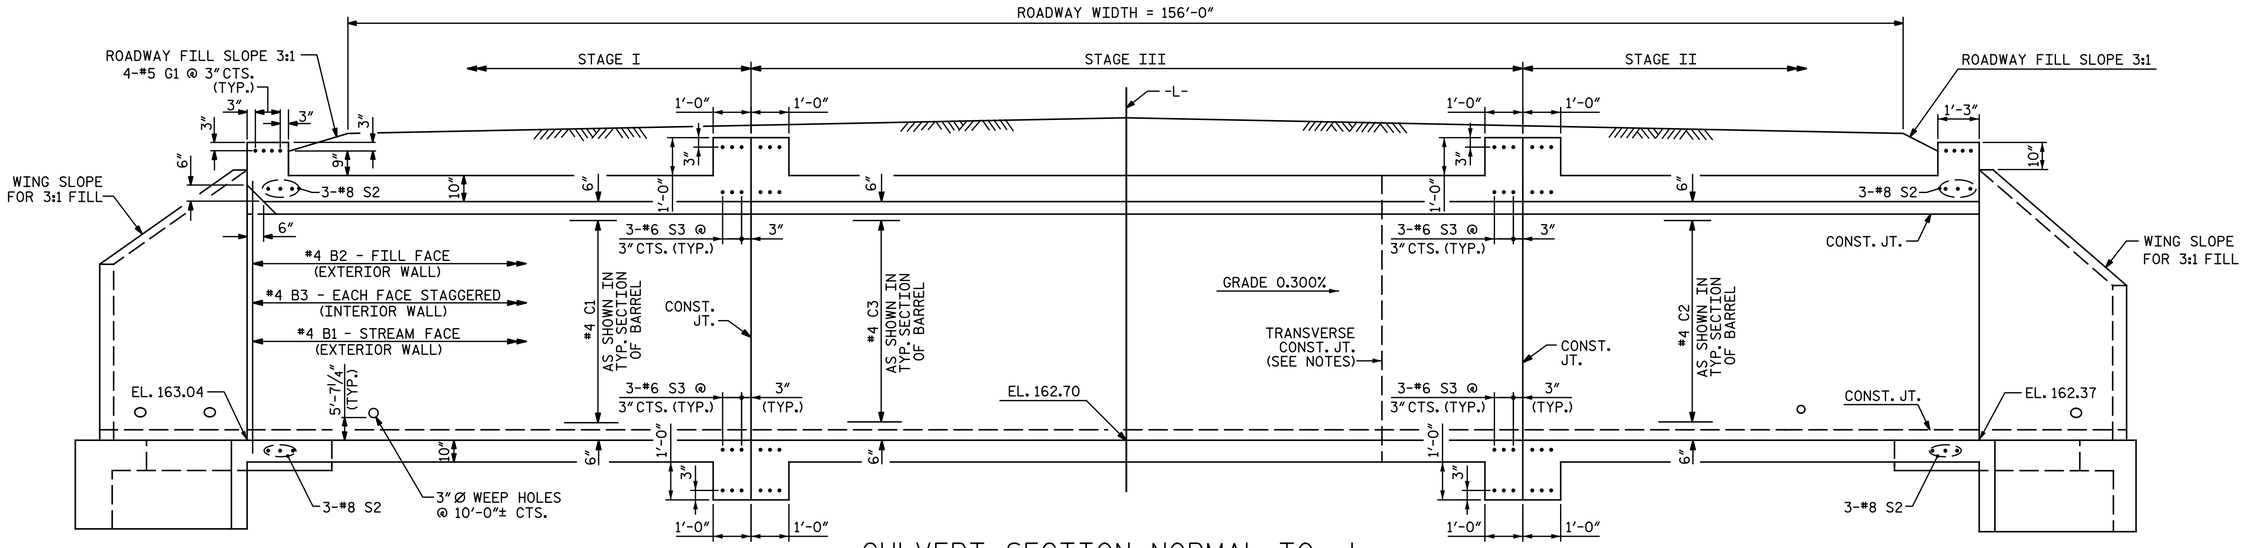

CULVERT SECTION NORMAL TO -L-

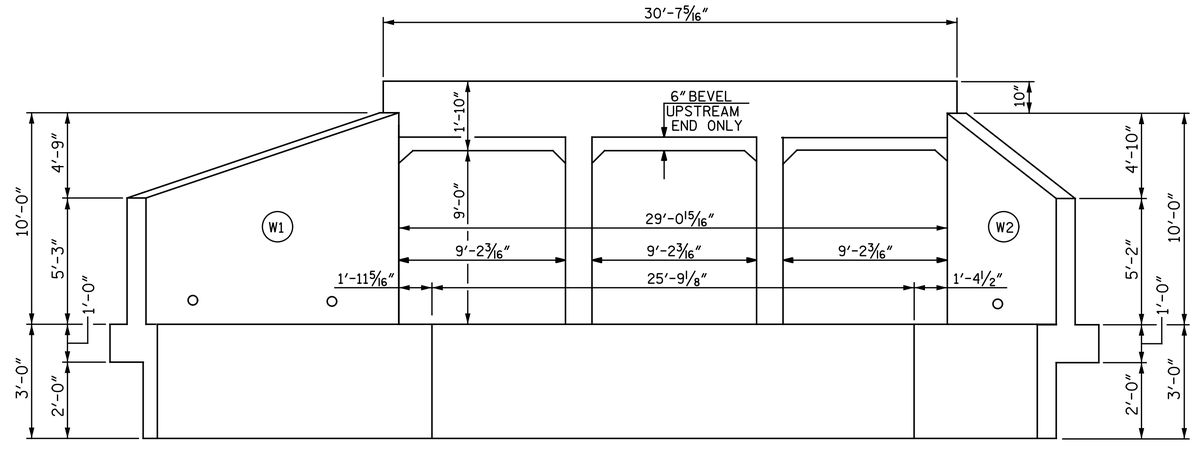

END ELEVATION NORMAL TO SKEW

(INLET END OF CULVERT SHOWN)

I HEREBY CERTIFY THESE PLANS ARE THE AS-BUILT PLANS.

PROJECT NO. I-5878

HARNETT COUNTY

STATION: 1042+08.93 -L-

SHEET 2 OF 6

STATE OF NORTH CAROLINA
DEPARTMENT OF TRANSPORTATION
RALEIGH

NORTH CAROLINA PROFESSIONAL SEAL 043878 ENGINEER AMANDA H. SHARPE

DocuSigned by: Amanda H. Sharpe 81D8FFF4ECEF4D2... 4/9/2020

TRIPLE 8 FT. X 9 FT.
CONCRETE BOX CULVERT
119°-24'-07" SKEW

DOCUMENT NOT CONSIDERED FINAL UNLESS ALL SIGNATURES COMPLETED

Michael Baker INTERNATIONAL

Michael Baker Engineering
8000 Regency Parkway, Suite 600
Cary, North Carolina 27518
NC License No.: F-1084

REVISIONS						SHEET NO.
NO.	BY:	DATE:	NO.	BY:	DATE:	C2-2
1			3			TOTAL SHEETS
2			4			8

DRAWN BY : M. D. MAYHEW DATE : 1-28-20
CHECKED BY : A. H. SHARPE DATE : 4-7-20