DocuSign Envelope ID: EC552B2E-4A88-4DE7-956B-6EED75D6B3A2

I, Toynia E.S. Gibbs, a Professional Land Surveyor in the state of North Carolina hereby certify to the best of my knowledge and belief that the following work item(s) (R/W Staking) performed under my responsible charge meet NCDOT Survey Standards as directed in the NCDOT Location & Surveys guidelines and procedures.

I further certify that the right of way and permanent easement points shown herein and outlined in the tables shown hereon (localized coordinates, station/offset) have been checked and are accurate representations of the right of way and permanent easement points depicted on the corresponding highway plans. I also certify that the right of way and permanent easement points shown herein have been field monumented under my supervision from existing survey control provided by others; that the depicted property data shown herein were surveyed by others; and these monuments denote the right of way and easement boundaries at the time of staking which may be subject to change due to right of way revisions (See deeds for final determination).

Witness my original signature, registration number and seal this date 10/31/2019.

DocuSigned by: Toynia Gibbs — 2E3F85AA8EC840A... — 10/31/2019

Professional Land Surveyor — L-3866 PLS # — Seal

PROJECT REFERENCE NO.	SHEET NO.
U-5826	RW06

Location and Surveys

ESP ASSOCIATES, INC.
2200 GATEWAY CENTRE BLVD. SUITE 216
MORRISVILLE, NC 27560

PROJECT SURVEYOR

NORTH CAROLINA PROFESSIONAL SEAL L-3866 LAND SURVEYOR TOYNIA E.S. GIBBS

DocuSigned by: Toynia Gibbs — 2E3F85AA8EC840A... — 10/31/2019

DOCUMENT NOT CONSIDERED FINAL UNLESS ALL SIGNATURES COMPLETED

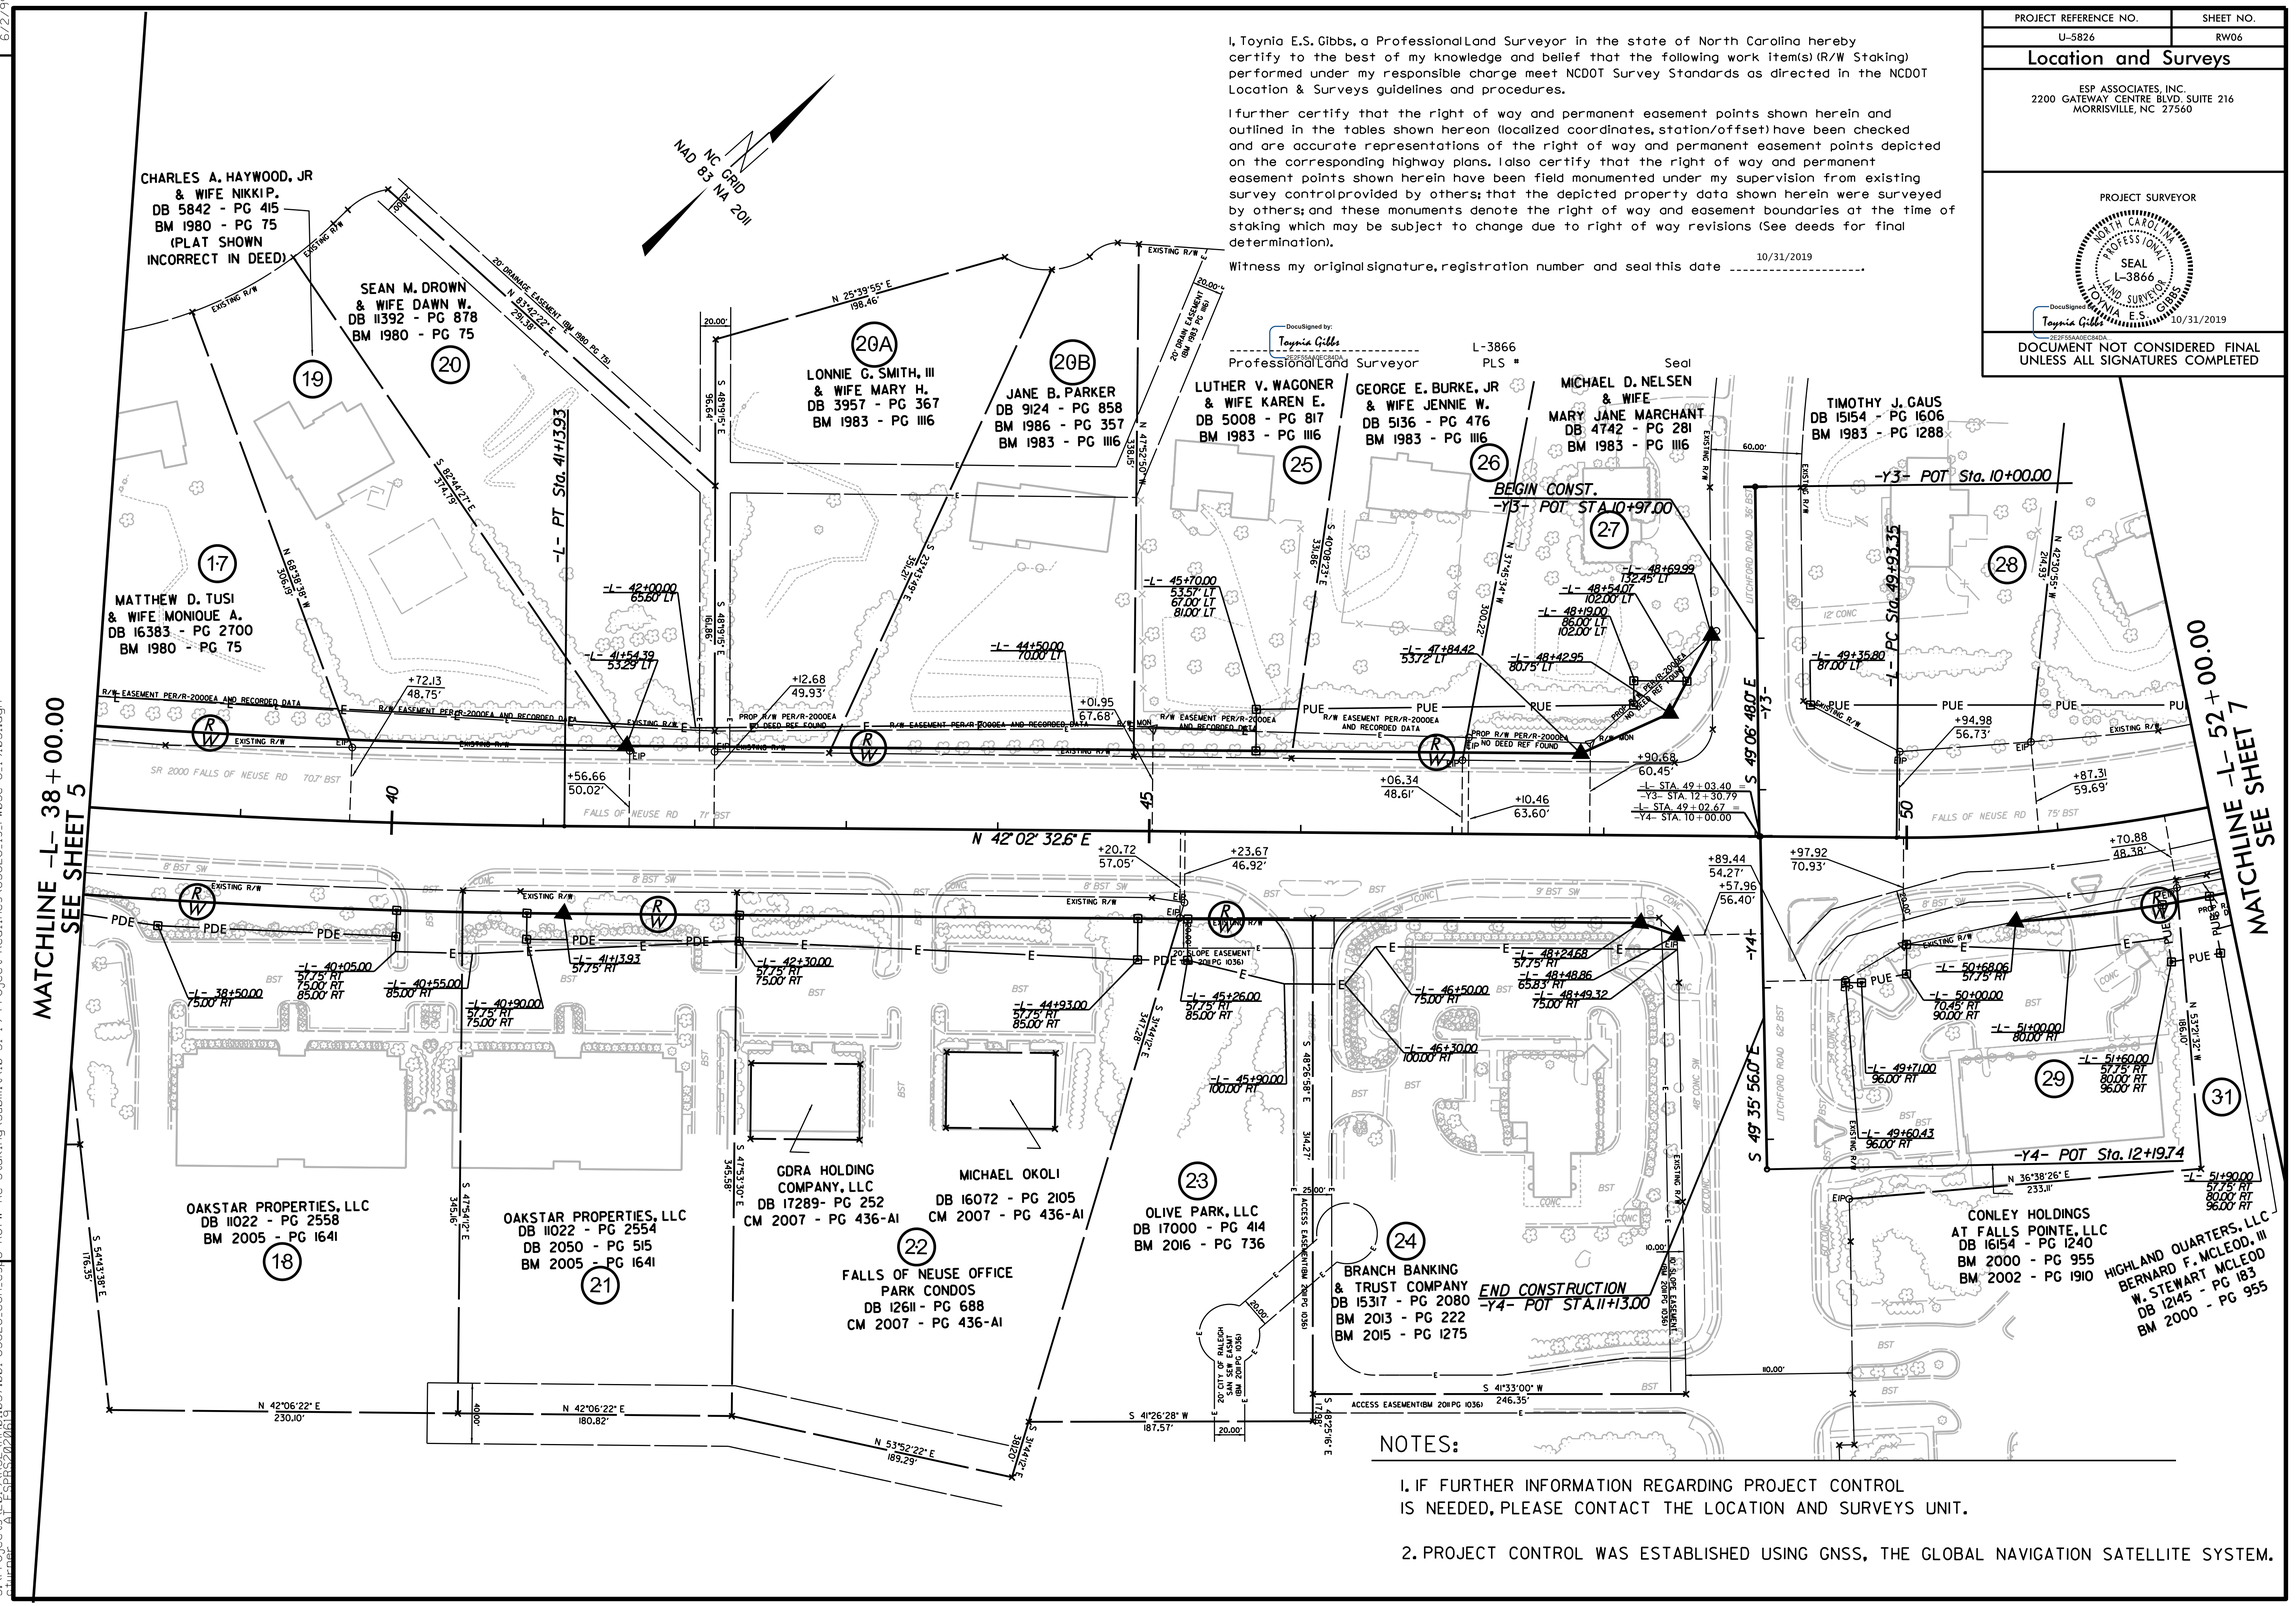

NOTES:

1. IF FURTHER INFORMATION REGARDING PROJECT CONTROL IS NEEDED, PLEASE CONTACT THE LOCATION AND SURVEYS UNIT.

2. PROJECT CONTROL WAS ESTABLISHED USING GNSS, THE GLOBAL NAVIGATION SATELLITE SYSTEM.

REVISIONS

6/2/99

31-OCT-2019 09:53
C:\Projects\2019\U5826\RS2\HM01_037_001_U5826_con.esri\6 RofW Re-Staking\Submit\10-31-19 Project Redlines\U5826_ls_rw03e-6_191031.dgn
ALT ESPRS2020019